

REQUEST FOR PROPOSALS

ADDENDUM 1

Pre-Bid Meeting Minutes and Questions From Site Walk and Emails

DESIGN, PROCURE, AND INSTALLATION FOR ONE SOLAR AND BATTERY STORAGE MICROGRID

June 10, 2025

Key Project Milestones

Milestone	Date
RFP Announced	May 15, 2025
Optional Pre-Bid Walkthrough	May 28, 2025, 1 PM
Deadline for Questions	June 4, 2025, 1 PM
Proposals Due	June 13, 2025, 4:30 PM
Award Announcement	June 19, 2025
Contract Negotiations	June 20, 2025
Estimated Contract Approval	July 11, 2025
Substantial Completion Target	June 30, 2026



The Tulalip Tribes of Washington
6406 Marine Drive, Tulalip, WA 98271

Bids are due Friday, June 13, 2025 at 4:30pm

PRE-BID MEETING Agenda

Project: GATHERING HALL: DESIGN, PROCURE, AND INSTALLATION FOR ONE SOLAR AND BATTERY STORAGE MICROGRID

Date: 5/28/2025

Time: 1:00 pm

Location: 7512 Totem Beach Road, Tulalip, WA 98271

- Sign in
- Advisement: Whatever is said during the meeting is meant to be helpful but does not and cannot change the Bid Documents. Bidders must rely on published Addenda for official answers to questions that are not currently covered by Bid Documents.
- Introduce all parties present who are involved in the Project, see attendee sheet.
- Substantial completion target date June 30, 2026.
- Lay down/staging areas: The primary objective is to stay out of the way of normal operations while maintaining a safe working area. Specific areas will be identified with the selected contractor.

Questions Provided for RFP

1. What is the desired end date of the project?

- a. The targeted Substantial Completion is June 30, 2026.

2. What is the estimated start date?

- a. The targeted contract approval date for the contractor is July 11, 2025.

3. Are you currently working with a General Contractor or Electrical Contractor on this project? Or is that selection part of that bidding process?

- a. The Tulalip Tribes are not currently working with a General or Electrical Contractor on this project. It is up to the bidders to develop their team to complete all tasks associated with this RFP.

4. Who will be the assuming the role as Architect for the project, as identified in the contract responsible for review and approval of the document?

- a. The template contract was provided as reference. No Architect is assigned for this project.

5. What is the official TERO requirement (%)?

- a. There is a 1.75% TERO fee for projects over \$10,000.

6. What % of employees must be native?

- a. Please refer to Exhibit D for further details about native employment requirements.

7. Does Tulalip have preferred vendor list for any other work beyond Tulalip Data Services and Salish Networks?

- a. Please refer to this link Tulalip Tribes Native American Owned Business Registry. Contact the TERO office with any further questions.
<https://www.tulaliptero.com/Contractors/NAOBRegistry>

8. As we continue to assess workforce development opportunities for the Tulalip Microgrid Project, I wanted to ask if there are any members of the Tulalip Tribe who are currently familiar with the existing PV system infrastructure that could potentially be involved in this project and further trained as part of a Clean Energy Workforce initiative. Additionally, are you aware of any Tribe members currently enrolled in—or on the waitlist for—the IBEW apprenticeship program? This information would be helpful as we evaluate strategies to promote local engagement and capacity-building within the community.

- a. Currently unknown. It is recommended to contact the Tribes' TERO office and the local Northwest Indian College Campus with specific trainee

questions. The owner has previously worked with Remote Energy, Spark Northwest, and GRID Alternatives for engagement opportunities.

9. Will proposals that include detailed assumptions and exclusions on labor productivity, procurement risk, and subcontractor contingencies be viewed more favorably in evaluation?

- a. Bids will be scored based on the scoring criteria as identified in Section 5 of the RFP.

10. Will the bids be scored based on the scoring criteria as identified in the RFP or based on lowest bid?

- a. Bids will be scored based on the scoring criteria as identified in Section 5 of the RFP.

11. Can the Owner confirm whether the evaluation will be based on best-value per the scoring criteria identified in the RFP or lowest cost, as mentioned in the optional site walk? Specifically, how will pricing be weighted against technical qualifications, tribal experience, and proposed project approach in the final decision-making process?

- a. Bids will be scored based on the scoring criteria as identified in Section 5 of the RFP.

12. Are there any Buy America Build America requirements?

- a. No.

13. Is the project contingent on federal investment tax credits?

- a. No.

14. Will ITC be an additional scope?

- a. The Federal Investment Tax Credit is not a requirement of this project.

15. Can the Owner clarify whether utility interconnection fees, service upgrade costs, transformer replacement, or other SnoPUD-imposed fees will be paid directly by the Owner or should they be included in the Contractor's fixed price? Given the potential variability of these fees based on final system design, should proposers include contingency allowances, or will the Owner assume cost responsibility for utility-imposed changes?

- a. These fees and potential unknown utility infrastructure changes will be paid for by the Tribes.

16. Attachment B indicates that 15% of the available budget has been allocated to Milestone A for RFP development. Could you confirm the total remaining budget available for execution?

- a. No. Grant funding is only part of the project funding available.

17. How should we account for the associated costs of Tulalip Data Services and Salish Networks if the scope of work is currently undefined? Should this be considered an owner-controlled budget line item during a bidding stage? If so, what value should we carry for this item?

- a. Tulalip Tribes will be responsible for any fees related to interconnection to Tulalip Data Services and Salish Networks.

18. What are the net metering requirements?

- a. Solar-only systems that are under 200 kW AC are eligible to participate in SnoPUD's Net Billing Program. Please refer to SnoPUD's net billing requirements for additional information.
(<https://www.snopud.com/account/services/connecting-generation/>). If the system is not eligible for Net Billing, other options may include entering a PPA or full interconnection agreement with SnoPUD.

19. Is there a new generator in the scope? What is the plan for the existing generator?

- a. A new generator is in the scope as a bid alternative. The existing generator can remain in place. The existing generator controls do not require retrofit or modification for parallel operation like the bid alternate generator. The selected contractor will not be held responsible for any operational issues with the existing generator. For more details, please refer to Section 4. Contractor Requirements.

20. The RFP states the existing generator is oversized and unreliable. Can the Owner clarify whether the new generator (bid alternate) is expected to integrate fully with the proposed microgrid to allow for parallel operation, BESS charging, and grid export as part of a multi-node microgrid?

- a. Yes. Please refer to Section 1. Introduction – Detailed Project Description of the RFP. Note that SnoPUD currently does not allow back feeding from the generator to their grid. A multi-node microgrid is a future possibility and not a part of this project scope.

21. Does the current generator have synching capabilities for islanding/interconnection?

- a. No.

22. Availability and reliability of the existing 1,500kW GenSet will play a significant role in the design and cost structure of the project. Is the intention to keep it within the project or replace it with the 500kW GenSet in the plan set?

- a. Please refer to the answers provided in questions 19 and 20.

23. Can the Owner clarify what degree of future multi-node microgrid integration is anticipated and how that should inform current controller design, generator sizing, and fiber termination planning?

- a. Please refer to Section 1. Introduction – Detailed Project Description of the RFP. There are no existing systems to integrate with, and that future system is outside of this scope. Microgrid control equipment is required to have fiberoptic communication capability.

24. In bid alternates, should the generator and controller be sized and scoped to support adjacent facilities or future community-wide microgrid nodes?

- a. Generator sizing in bid alternates is only expected to support the Gathering Hall.

25. What are the existing solar array details?

- a. The DC nameplate capacity is 20kW. Please see Exhibit J of the RFP Addendum for additional details.

26. Are the SILFab modules required for the RFP?

- a. No.

27. Can you provide context for the selection of the specified PV solar equipment? Is this based on available spare material, existing inventory, or organizational familiarity? Alternatively, would equivalent equipment be acceptable?

- a. Predesign equipment selection was determined during RFP development based on a previous feasibility study. Prospective bidders are responsible for identifying their proposed design and equipment meeting the RFP requirements.

28. Are the PV inverters oversized with the intention of future expansion, and should this be carried forward in the design if we specify alternate materials?

- a. Prospective bidders are responsible for identifying their proposed design and equipment meeting the RFP requirements.

29. Are S-5 clamps considered an acceptable attachment method for mounting the solar array or is there a preferred alternate method that should be implemented?

- a. Tulalip Tribes desire to minimize roof penetrations. S-5 brand products are acceptable. Prospective bidder responsible for identifying their proposed design and equipment meeting the RFP requirements.

30. Where do conduits come out of the electrical room? Are these able to be used in the design?

- a. Unknown. If there are existing spare conduits, they may be used in the design.

31. Is there an existing one-line diagram?

- a. Please refer to the Exhibit J in the RFP.

32. What is the planned location for the battery?

- a. Please refer to the Pre-design drawings in RFP.

33. What are the laydown areas?

- a. Laydown areas for construction will be coordinated with the selected contractor during the project kickoff meeting. Areas will be made available on site and nearby for staging and equipment storage to facilitate construction.

34. What is the roof's structural capacity?

- a. Please see Exhibit J of the RFP Addendum.

35. What are additional roof details (seam width?)?

- a. Please see Exhibit J of the RFP Addendum.

36. Are structural drawings available for the main building to determine whether the PV solar system was considered in the initial construction?

- a. Please see Exhibit J of the RFP Addendum.

37. Are there roofing drawings or specifications available for the building where the PV system is intended to be installed?

- a. Please see Exhibit J of the RFP Addendum.

38. Will the project consider using the ESPC Performance Contract instead of the AIA contract?

- a. No.

39. Could you clarify why the contract is structured as "open book" despite being identified as a fixed-cost agreement? Open book contracts are typically associated with cost-plus arrangements, whereas fixed-cost contracts generally place the responsibility on the contractor to manage pricing and procurement.

- a. It is the Tribes preference to structure the contract as "Open Book," see Proposal Requirements section of the RFP.

40. Can the Owner confirm that the open-book pricing requirement applies only to invoicing for the awarded firm, and will not be used for bid evaluation or shared with other proposers?

- a. Yes. Open book pricing will not be used for bid evaluation or shared with other proposers.

41. Can the Owner confirm whether a bid bond or proposal security is required? The RFP references a requirement for a performance and payment bond, but on the optional site walk, a bid bond was also mentioned. If a bid bond is not strictly required, will a form of proposal surety be evaluated favorably, particularly in the event of shortlisted contractor interviews?

- a. A bid bond is not required to submit a proposal. Please see Section 5. Submittal Requirements and Section 1. Introduction for Bonding Requirements.

42. What are the hours (days, time) that contractors can work?

- a. 7AM to 8PM, 7 days a week. Event schedules vary and construction during events must be coordinated with the facility manager to avoid impacts.

43. Could you please provide the specifications for Divisions 1 through 32, as referenced in the contract documents? (Ref: Supplementary Conditions, Page 1 of 4 / RFP Page 24)

- a. The template contract was provided as reference. The RFP contains the project specifications and requirements.

44. Note 9.8.1.1 in the supplementary conditions appears to include punch list items within substantial completion. How does this differ from Final Completion? Could you clarify this? Additionally, would a Temporary Certificate of Occupancy (TCO) fulfill the substantial completion requirement, or is a Final Certificate required?

- a. The template contract was provided as reference. Please see Section 4 of the RFP for contractor requirements.

45. The special conditions attachments stipulates ~9 months or 270 calendar days for completion from issuance of NTP. However, delivery times for 1 MW BESS equipment will likely extend beyond one year after the material is selected, incorporated into the design, and finally approved by the planning department. Can this be negotiated based upon the permit approval schedule and material delivery times?

- a. The template contract was provided as reference. Target substantial completion date is June 30, 2026. Project schedule will be negotiated with the selected contractor.

46. If long-lead equipment such as transformers or BESS containers delay construction, will extensions to the substantial completion date be granted without penalty? Please clarify the enforceability of the \$750/day liquidated damages clause and whether it applies to causes beyond contractor control (e.g. supply chain disruption, utility delays, AHJ review, TERO coordination, etc).

- a. Tulalip Tribes understands that there are circumstances beyond the contractor's control and will work with the selected contractor to revise substantial completion date targets and enforceability in accordance with the negotiated contract based on expected delays.


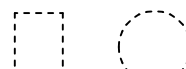
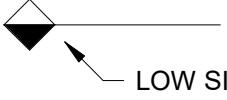





47. Liquidated Damages: What is the reasoning behind the reasoning for \$750/day? Is there a financial burden to the Tribe for its timely completion or is this strictly punitive?

- a. The template contract was provided as reference. The owner may work with the selected contractor to renegotiate, if desired.


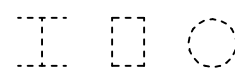
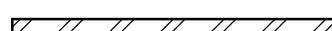
Exhibit J.2.1. Structural Drawings


AB	ANCHOR BOLT	IE	INVERT ELEVATION
ADDL	ADDITIONAL	IF	INSIDE FACE
ADH	ADHESIVE	IN	INCH
ADJ	ADJUSTABLE	INFO	INFORMATION
AESS	ARCHITECTURALLY EXPOSED STRUCTURAL STEEL	INT	INTERIOR
		JST	JOIST
AFF	ABOVE FINISH FLOOR	JT	JOINT
AGG	AGGREGATE	K	KIP (1,000 LBS.)
ANCH	ANCHOR	KSF	KIPS PER SQUARE FOOT
ARCH	ARCHITECTURAL	LF	LINEAL FOOT
ARD	ADHESIVE REINFORCING DOWEL	LFH	LONG LEG HORIZONTAL
B/	BOTTOM OF	LLH	LONG LEG HORIZONTAL
BLDG	BUILDING	LLV	LONG LEG VERTICAL
BLKG	BLOCKING	LP	LOW POINT
BM	BEAM	LSL	LAMINATED STRAND LUMBER
BI	DIAPHRAGM BOUNDARY NAILING	LVL	LAMINATED VENEER LUMBER
BOT	BOTTOM	MAX	MAXIMUM
BRG	BEARING	MECH	MECHANICAL
BSMT	BASEMENT	MFR	MANUFACTURER
BTWN	BETWEEN	MIN	MINIMUM
BUR	BUILT-UP ROOF	MISC	MISCELLANEOUS
C	CAMBER	MOM	MOMENT
CAP	CAPACITY	NIC	NOT IN CONTRACT
CC	CENTER TO CENTER	NO	NUMBER
CDF	CONTROLLED DENSITY FILL	NOM	NOMINAL
CIP	CAST-IN-PLACE	NS	NEAR SIDE
CJ	CONSTRUCTION OR CONTROL JOINT	NS	NONSHRINK
CJP	COMPLETE JOINT PENETRATION	NTS	NOT TO SCALE
CL	CENTRAL	OC	ON CENTER
CLG	CEILING	OD	OUTSIDE DIAMETER
CLR	CLEAR	OF	OUTSIDE FACE
COL	COLUMN	OPNG	OPENING
CONC	CONCRETE	OPP	OPPOSITE
CONN	CONNECTION	OWT	OPEN WEB TRUSS
CONST	CONSTRUCTION	P	POST
CONT	CONTINUOUS	PAF	POWER ACTUATED FASTENER
CONTR	CONTRACTOR	PC	PIECE
COORD	COORDINATE	PC	PILE CAP
CTR	CENTER	PEN	PENETRATION
CY	CUBIC YARD	PJP	PARTIAL JOINT PENETRATION
DB	DIVIDER BEAM	PL	PLATE
DBA	DEFORMED BAR ANCHOR	PL	PROPERTY LINE
DBL	DOUBLE	PLWD	PLYWOOD
DCW	DEMAND CRITICAL WELD	PNL	PANEL
DEMO	DEMOLISH	PSF	POUNDS PER SQUARE FOOT
DET	DETAIL	PSI	POUNDS PER SQUARE INCH
DF	DOUGLAS FIR	PT	PRESERVATIVE-TREATED
DIA	DIAMETER	R	RADIUS
DIAG	DIAGONAL	RD	ROOF DRAIN
DKG	DECKING	REINF	REINFORCING
DN	DOWN	REM	REMAIN(DER)
DO	DITTO	REQ'D	REQUIRED
DWF	DEFORMED WIRE FABRIC	RND	ROUND
DWG	DRAWING	RO	ROUGH OPENING
DWL	DOWEL	RTN	RETURN
EA	EACH	SC	SLIP CRITICAL
EF	EACH FACE	SCHED	SCHEDULE
EL	ELEVATION	SDQ	SPECIAL DUCTILE QUALITY
ELECT	ELECTRICAL	SECT	SECTION
ELEV	ELEVATOR	SFRS	SEISMIC FORCE-RESISTING SYSTEM
EN	PANEL EDGE NAILING	SHT	SHEET
EQ	EQUAL	SHTG	SHEATHING
EQUIP	EQUIPMENT	SIM	SIMILAR
ES	EACH SIDE	SOG	SLAB-ON-GRADE
EW	EACH WAY	SP	SPACE
EX	EXISTING	SPEC	SPECIFICATION
EXP	EXPANSION	SQ	SQUARE
EXT	EXTERIOR	SS	STAINLESS STEEL
F	FAHRENHEIT	ST	SUSTAINED TENSION ANCHOR
FD	FLOOR DRAIN	STD	STANDARD
FDN	FOUNDATION	STIFF	STIFFENER
FF	FINISH FLOOR	STIRR	STIRRUP
FIN	FINISH	STL	STEEL
FLG	FLANGE	STRUCT	STRUCTURAL
FLR	FLOOR	SUPP	SUPPORT
FOB	FACE OF BUILDING	SYM	SYMMETRICAL
FS	FAR SIDE	T&B	TOP AND BOTTOM
FT	FEET	T&G	TONGUE AND GROOVE
FTG	FOOTING	TJ	TOP OF
GA	GAUGE	TB	TABLE
GALV	GALVANIZED	THK	THICK(NESS)
GEN	GENERAL	THRU	THROUGH
GL	GLUED LAMINATED TIMBER	TRANS	TRANSVERSE
GOV	GOVERNMENT	TYP	TYPICAL
GRD	GRADE	UNO	UNLESS NOTED OTHERWISE
GNB	GYPSSUM WALL BOARD	UL	ULTRASONIC TESTING
HF	HEM-FIR	VERT	VERTICAL
HGR	HANGER	VIF	VERIFY IN FIELD
HK	HOOK	W/	WITH
HORIZ	HORIZONTAL	W/O	WITHOUT
HP	HIGH POINT	WD	WOOD
HSS	HOLLOW STRUCTURAL SECTION	WHS	WELDED HEADED STUD
IBC	INTERNATIONAL BUILDING CODE	WL	WATER LINE
ID	INSIDE DIAMETER	WP	WORK POINT
		WRC	WESTERN RED CEDAR

CONCRETE SYMBOLS

	CONCRETE COLUMN ABOVE OR PASSING THRU THIS LEVEL
	CONCRETE COLUMN BELOW
	STEPPED FOOTING
	CONCRETE WALL ABOVE OR PASSING THRU LEVEL
	PARTIAL HEIGHT CONCRETE WALL
	MASONRY WALLS
	CONCRETE IN CROSS SECTION
	EXISTING CONCRETE IN CROSS SECTION


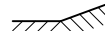

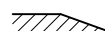
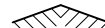






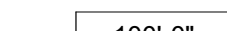
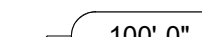


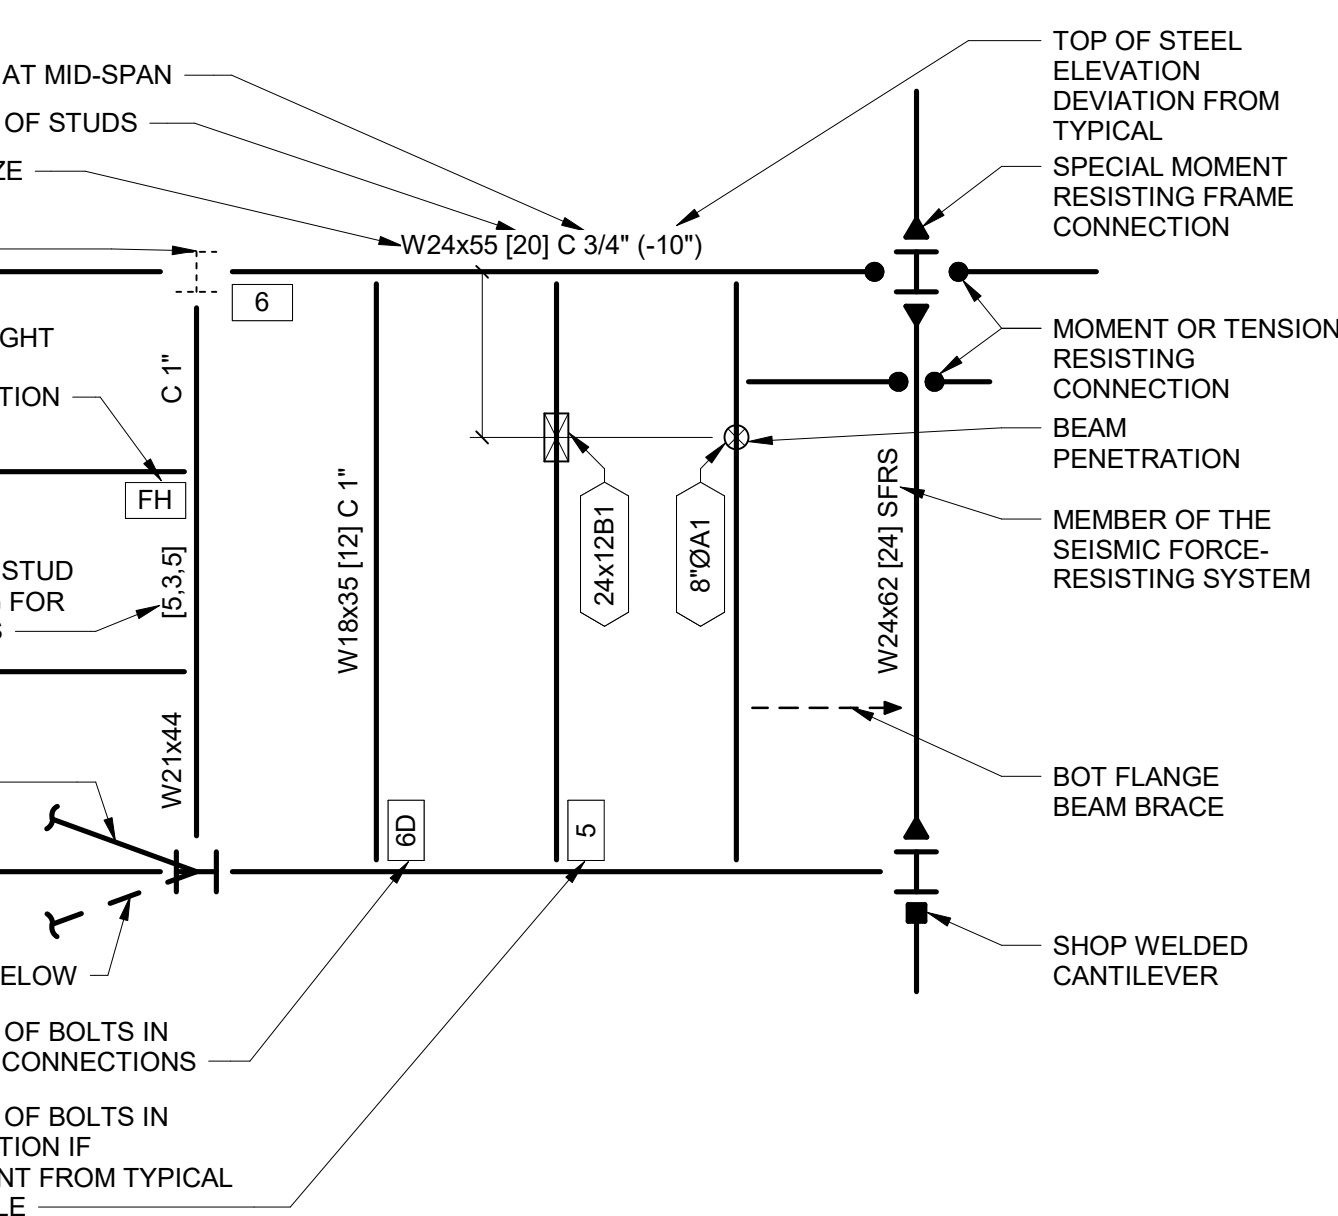



STEEL SYMBOLS

	STEEL COLUMN ABOVE OR PASSING THRU THIS LEVEL
	STEEL COLUMN BELOW THIS LEVEL
	STEEL IN CROSS SECTION

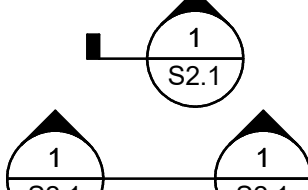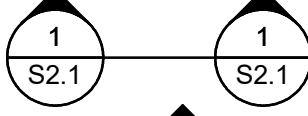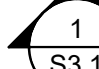




 



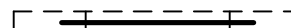

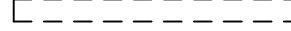


Labels in diagram include: AT MID-SPAN, OF STUDS, E, W24x55 [20] C 3/4" (-10"), W18x55 [12] C 1", 24x12B1, 8"OA1, W24x62 [24] SFPS, BOT FLANGE BEAM BRACE, SHOP WELDED CANTILEVER, TOP OF STEEL ELEVATION DEVIATION FROM TYPICAL, SPECIAL MOMENT RESISTING FRAME CONNECTION, MOMENT OR TENSION RESISTING CONNECTION, BEAM PENETRATION, MEMBER OF THE SEISMIC FORCE-RESISTING SYSTEM, T/SLAB, LEVEL 01 100'-0", WP, DIRECTION OF DOWNWARD SLOPE, DIRECTION OF SPAN, EXISTING OR FUTURE FRAMING.

GENERAL SYMBOLS

	GRID BUBBLE
	SURFACE - SLOPE UP
	SURFACE - STEPPED
	SURFACE - SLOPE DOWN
	SURFACE - SLOPE TWO WAYS
	UNDISTURBED SOIL, COMPACTED SOIL, BACKFILL, OR ANY PREPARED SUBGRADE. SEE SPECIFICATIONS FOR TYPE OF MATERIAL AND PREPARATION METHOD.
	NORTH ARROW
	STANDARD SECTION CUTS
	BUILDING SECTION CUTS
	ELEVATION OF WALL OR FRAME
	SPOT ELEVATION: TOP OF PLYWOOD TOP OF CONCRETE TOP OF STEEL
	TOP OF CONCRETE ELEVATION
	TOP OF STEEL ELEVATION
	REFERENCE ELEVATION. REFER TO PLAN UNLESS NOTED OTHERWISE.
	ELEVATION OF LEVEL
	WORKPOINT
	DIRECTION OF DOWNWARD SLOPE
	DIRECTION OF SPAN
	EXISTING OR FUTURE FRAMING

WOOD SYMBOLS

	HINGE CONNECTION
	GLULAM SECTION
	ENGINEERED LUMBER SECTION (PSL, LSL, LVL)
	SOLID WOOD SECTION
	SOLID WOOD BLOCKING SECTION
	BUNDLED STUDS, WOOD POST
	PLYWOOD SECTION
	BEAM / GIRDER / JOIST
	WALL ABOVE THIS LEVEL WITH HEADER BELOW
	WALL BELOW THIS LEVEL WITH HEADER BELOW
	WALL ABOVE THIS LEVEL
	WALL BELOW THIS LEVEL



STATEMENT OF STRUCTURAL SPECIAL INSPECTIONS AND TESTING

TABLE 1 - REQUIRED GEOTECHNICAL SPECIAL INSPECTIONS					
SYSTEM OR MATERIAL	INSPECTION			REMARKS	
	IBC CODE REFERENCE	CODE OR STANDARD REFERENCE	FREQUENCY (NOTE 6) CONTINUOUS PERIODIC		
SOILS					
VERIFY MATERIALS BELOW SHALLOW FOUNDATIONS ARE ADEQUATE TO ACHIEVE THE DESIGN BEARING CAPACITY.	TB 1705.6 1705.6	GEOTECHNICAL REPORT	-	X	BY THE GEOTECHNICAL ENGINEER
VERIFY EXCAVATIONS ARE EXTENDED TO PROPER DEPTH AND HAVE REACHED PROPER MATERIAL.			-	X	
PERFORM CLASSIFICATION AND TESTING OF COMPACTED FILL MATERIALS.			-	X	
VERIFY USE OF PROPER MATERIALS, DENSITIES AND LIFT THICKNESSES DURING PLACEMENT AND COMPACTION OF COMPACTED FILL.			X	-	
PRIOR TO PLACEMENT OF COMPACTED FILL, OBSERVE SUBGRADE AND VERIFY THAT SITE HAS BEEN PREPARED PROPERLY.			-	X	

SYSTEM OR MATERIAL		IBC CODE REFERENCE	INSPECTION		REMARKS		
			CODE OR STANDARD REFERENCE	FREQUENCY (NOTE 6)			
FABRICATION							
INSPECTION IN FABRICATION SHOP	1704.2.5	-	-	-	WHERE FABRICATION OF STRUCTURAL LOAD-BEARING MEMBERS AND ASSEMBLIES IS BEING PERFORMED ON THE PREMISES OF A FABRICATOR'S SHOP, SPECIAL INSPECTION OF THE FABRICATED ITEMS SHALL BE AS REQUIRED BY TABLE 2 AND AS REQUIRED ELSEWHERE IN THE STATEMENT OF SPECIAL INSPECTIONS. REFERENCE SECTION 1704.2.5.2 FOR APPROVED FABRICATOR EXCEPTION.		
CONCRETE							
INSPECTION OF REINFORCING STEEL, INCLUDING PRESTRESSING TENDONS, AND PLACEMENT.	TB 1705.3(1) 1705.3 1910.4	ACI 318: 1.3.2 ACI 318: 3.5 ACI 318: 7.1-7.7	-	X	TOLERANCE AND REINFORCING PLACEMENT PER ACI 318: 7.5		
INSPECTION OF REINFORCING STEEL WELDING	TB 1705.3(2) 1705.2.2.1.2	ACI 318: 3.5.2 AWS D1.4: 7	-	-	EXCEPT AS NOTED OTHERWISE		
MATERIAL VERIFICATION OF WELD FILLER METALS	1705.2.2.1.2	ACI 318: 3.5.2 AWS D1.4: 7	-	X	MANUFACTURER'S CERTIFIED TEST REPORTS		
VERIFYING USE OF PROPER WELDING PROCEDURE SPECIFICATIONS			-	X	COPY OF WELDING PROCEDURE SPECIFICATIONS		
VERIFYING WELDER QUALIFICATIONS			-	X	COPY OF QUALIFICATION CARDS		
VERIFICATION OF WELDABILITY OF REINFORCING STEEL OTHER THAN ASTM A 706.	TB 1705.2.2 (2.b.1)	AWS D1.4 ACI 318: 3.5.2	-	X	CERTIFIED MILL TEST REPORTS		
SHEAR REINFORCEMENT	TB 1705.2.2 (2.b.3)		X	-	-		
OTHER REINFORCING STEEL	TB 1705.2.2 (2.b.4)		-	X	-		
INSP ECT.		WAC 51-50-1705	ACI 318 D.9.2	-	X	ALL ANCHORS SHALL BE VISUALLY INSPECTED	
INSPECTION OF ANCHORS POST-INSTALLED IN HARDENED CONCRETE MEMBERS:							
ADHESIVE ANCHORS INSTALLED IN HORIZONTALLY OR UPWARDLY INCLINED ORIENTATIONS TO RESIST SUSTAINED TENSION LOADS.	WAC 51-50-1705	ICC/ACI/MO EVALUATION REPORT ACI 318: D.9.2.4	X	-	REFER TO ANCHOR CALLOUTS FOR SUSTAINED TENSION (ST) DESIGNATION		
MECHANICAL ANCHORS AND ADHESIVE ANCHORS NOT DEFINED ABOVE.	WAC 51-50-1705	ICC/ACI/MO EVALUATION REPORT ACI 318: D.9.2	-	X (NOTE 7)	ALL ANCHORS SHALL BE VISUALLY INSPECTED		
VERIFYING USE OF REQUIRED DESIGN MIX.	TB 1705.3(5) 1705.3 1904 1910.2 1910.3	ACI 318: 1.3.2 ACI 318: 4 ACI 318: 5.2-5.4	-	X	-		
AT THE TIME FRESH CONCRETE IS SAMPLED TO FABRICATE SPECIMENS FOR STRENGTH TEST, PERFORM SLUMP AND AIR CONTENT TESTS, AND DETERMINE THE TEMPERATURE OF THE CONCRETE.	TB 1705.3(6) 1910.10	ASTM C 172 ASTM C 31 ACI 318: 5.6,5.8	X	-	-		
INSPECTION OF CONCRETE AND SHOTCRETE PLACEMENT FOR PROPER APPLICATION TECHNIQUES.	TB 1705.3(7) 1705.3 1910.6-8	ACI 318: 5.9-5.10	X	-	-		
INSPECTION FOR MAINTENANCE OF SPECIFIED CURING TEMPERATURE AND TECHNIQUES.	TB 1705.3(8) 1705.3 1910.9	ACI 318: 1.3.2 ACI 318: 5.11-5.13	-	X	-		
INSPECT FORMWORK FOR SHAPE, LOCATION AND DIMENSIONS OF THE CONCRETE MEMBER BEING FORMED.	TB 1705.3(12) 1705.3	ACI 318: 6.1.1, 6.2	-	X	-		
STEEL							
INSPECTION TASKS PRIOR TO WELDING:							
WELDING PROCEDURE SPECIFICATIONS (WPS'S) AVAILABLE	1705.2	AISC 360: TB N5.4-1 AISC 360: N5.4	-	X	-		
MANUFACTURER CERTIFICATIONS FOR WELDING CONSUMABLES AVAILABLE			-	X	-		
MATERIAL IDENTIFICATION (TYPE/GRADE)			X	-	-		
WELDER IDENTIFICATION SYSTEM			X	-	-		
FIT-UP OF GROOVE WELDS (INCLUDING JOINT GEOMETRY), JOINT PREPARATION, DIMENSIONS (ALIGNMENT, ROOT OPENING, ROOT FACE, BEVEL), CLEANLINESS (CONDITION OF STEEL SURFACES), TACKING (TACK WELD QUALITY AND LOCATION), BACKING TYPE AND FIT (IF APPLICABLE)			X	-	-		
CONFIGURATION AND FINISH OF ACCESS HOLES			X	-	-		
FIT-UP OF FILLET WELDS: DIMENSIONS (ALIGNMENT, GAPS AT ROOT), CLEANLINESS (CONDITION OF STEEL SURFACES), TACKING (TACK WELD QUALITY AND LOCATION), BACKING TYPE AND FIT (IF APPLICABLE)			X	-	-		
CHECK WELDING EQUIPMENT			-	-	FABRICATOR OR ERECTOR SHALL OBSERVE		

SYSTEM OR MATERIAL	INSPECTION				REMARKS
	IBC CODE REFERENCE	CODE OR STANDARD REFERENCE	FREQUENCY (NOTE 8)		
OBSERVE					
PERFORM					
INSPECTION TASKS DURING WELDING:					
USE OF QUALIFIED WELDERS	1705.2	AISC 360: TB N5.4-2 AISC 360: N5.4	X	-	-
CONTROL AND HANDLING OF WELDING CONSUMABLES: PACKAGING, EXPOSURE CONTROL			X	-	-
NO WELDING OVER CRACKED TACK WELDS			X	-	-
ENVIRONMENTAL CONDITIONS: WIND SPEED WITHIN LIMITS, PRECIPITATION AND TEMPERATURE			X	-	-
WP'S FOLLOWED: SETTINGS ON WELDING EQUIPMENT, TRAVEL SPEED, SELECTED WELDING MATERIALS, SHIELDING GAS TYPE/FLOW RATE, PREHEAT APPLIED, INTERPASS TEMPERATURE MAINTAINED (MIN/MAX.), PROPER POSITION (F, V, H, OH)			X	-	-
WELDING TECHNIQUES: INTERPASS AND FINAL CLEANING, EACH PASS WITHIN PROFILE LIMITATIONS, EACH PASS MEETS QUALITY REQUIREMENTS			X	-	-
INSPECTION TASKS AFTER WELDING:					
WELDS CLEANED	1705.2	AISC 360: TB N5.4-3 AISC 360: N5.4	X	-	-
SIZE, LENGTH AND LOCATION OF WELDS			-	X	-
WELDS MEET VISUAL ACCEPTANCE CRITERIA: CRACK PROHIBITION, WELD/BASE-METAL FUSION, CRATER CROSS SECTION, WELD PROFILES, WELD SIZE, UNDERCUT, POROSITY			-	X	-
ARC STRIKES			-	X	-
K-AREA			-	X	-
BACKING REMOVED AND WELD TABS REMOVED (IF REQUIRED)			-	X	-
REPAIR ACTIVITIES			-	X	-
DOCUMENT ACCEPTANCE OR REJECTION OF WELDED JOINT OR MEMBER			-	X	-
INSPECTION TASKS PRIOR TO BOLTING:					
MANUFACTURER'S CERTIFICATIONS AVAILABLE FOR FASTENER MATERIALS	1705.2	AISC 360: TB N5.6-1 AISC 360: N5.6	-	X	-
FASTENERS MARKED IN ACCORDANCE WITH ASTM REQUIREMENTS			X	-	-
PROPER FASTENERS SELECTED FOR THE JOINT DETAIL (GRADE, TYPE, BOLT LENGTH IF THREADS ARE TO BE EXCLUDED FROM SHEAR PLANE)			X	-	-
PROPER BOLTING PROCEDURE FOR JOINT DETAIL			X	-	-
CONNECTING ELEMENTS, INCLUDING THE APPROPRIATE FACE SURFACE CONDITION AND HOLE PREPARATION, IF SPECIFIED, MEET APPLICABLE REQUIREMENTS			X	-	-
PRE-INSTALLATION VERIFICATION TESTING BY INSTALLATION PERSONNEL OBSERVED AND DOCUMENTED FOR FASTENER ASSEMBLIES AND METHODS USED			X	-	-
PROPER STORAGE PROVIDED FOR BOLTS, NUTS, WASHERS AND OTHER FASTENER COMPONENTS			X	-	-
INSPECTION TASKS DURING BOLTING:					
FASTENER ASSEMBLIES, OF SUITABLE CONDITION, PLACED IN ALL HOLES AND WASHERS (IF REQUIRED) ARE POSITIONED AS REQUIRED	1705.2	AISC 360: TB N5.6-2 AISC 360: N5.6	X	-	-
JOINT BROUGHT TO SNUG-TIGHT CONDITION PRIOR TO THE PRETENSIONING OPERATION			X	-	-
FASTENER COMPONENT NOT TURNED BY THE WRENCH PREVENTED FROM ROTATING			X	-	-
FASTENERS ARE PRETENSIONED IN ACCORDANCE WITH THE RCSC SPECIFICATION, PROGRESSING SYSTEMATICALLY FROM THE MOST RIGID POINT TOWARD THE FREE EDGES			X	-	-
INSPECTION TASKS AFTER BOLTING:					
DOCUMENT ACCEPTANCE OR REJECTION OF BOLTED CONNECTIONS	1705.2	AISC 360: TB N5.6-3	-	X	-
INSPECTION OF STEEL ELEMENTS OF COMPOSITE CONSTRUCTION PRIOR TO CONCRETE PLACEMENT:					
PLACEMENT AND INSTALLATION OF STEEL DECK	1705.2	AISC 360: TB N6.1 AISC 360: N6.1	-	X	-
PLACEMENT AND INSTALLATION OF STEEL HEADED STUD ANCHORS			-	X	-
DOCUMENT ACCEPTANCE OR REJECTION OF STEEL ELEMENTS			-	X	-
WOOD					
FABRICATION OF PREFABRICATED STRUCTURAL ELEMENTS	1704.2.5	-	-	X	REFER TO INSPECTION IN FABRICATION SHOP REQUIREMENTS
FABRICATION OF HIGH-LOAD DIAPHRAGMS	AF&PA SDPWS TB 4.2 1705.5.1 2306.2	-	-	X	VERIFY STRUCTURAL PANEL GRADE AND THICKNESS. VERIFY NOMINAL SIZE OF FRAMING MEMBERS AT ADJOINING PANEL EDGES. VERIFY NAIL OR STAPLE DIAMETER AND LENGTH. NUMBER OF FASTENER LINES AND SPACING BETWEEN FASTENERS IN EACH LINE AND AT EDGE MARGINS
PREFABRICATED WOOD SHEAR PANELS	1703.4 1705.1.1(3)	ICC/AFPMO EVALUATION REPORT	-	X	SPECIAL INSPECTIONS APPLY TO HOLD-DOWN ANCHOR SIZE AND PLACEMENT, INCLUDING EMBEDMENT LENGTH, SPACING, AND EDGE DISTANCE

TABLE 2A - REQUIRED STRUCTURAL SPECIAL INSPECTIONS FOR SEISMIC RESISTANCE					
SYSTEM OR MATERIAL	IBC CODE REFERENCE	INSPECTION			REMARKS
		CODE OR STANDARD REFERENCE	FREQUENCY (NOTE 6) CONTINUOUS PERIODIC		
GENERAL					
SEISMIC FORCE-RESISTING SYSTEMS (SFRS) IN STRUCTURES ASSIGNED TO SEISMIC DESIGN CATEGORY C, D, E OR F	1704.3.2 1705.11	-	X	-	REFERENCE GENERAL STRUCTURAL NOTES FOR OUTLINE OF SFRS SYSTEM. REFERENCE TABLE 2A FOR MATERIAL SPECIFIC INSPECTION REQUIREMENTS.
WOOD					
CONNECTIONS FOR DIAPHRAGM CHORDS, COLLECTORS, BRACING, AND SHEAR WALL ANCHORAGE AND HOLD-DOWNS		-	-	X	ALL CONNECTIONS VISUALLY INSPECTED
FASTENING OF DIAPHRAGM AND SHEAR WALL SHEATHING WITH EDGE NAILING 4 INCHES ON CENTER OR LESS		-	-	X	ALL FASTENING VISUALLY INSPECTED. NOT REQUIRED WHERE THE FASTENER SPACING IS MORE THAN 4 INCHES ON CENTER

TABLE 2B - REQUIRED STRUCTURAL SPECIAL INSPECTIONS FOR WIND RESISTANCE						
SYSTEM OR MATERIAL	IBC CODE REFERENCE	INSPECTION			REMARKS	
		CODE OR STANDARD REFERENCE	FREQUENCY (NOTE 6)			
			CONTINUOUS	PERIODIC		
GENERAL						
ROOF CLADDING AND WALL CLADDING	1705.10.3	-	-	X	-	
WOOD						
CONNECTIONS FOR DIAPHRAGM CHORDS, COLLECTORS, BRACING AND SHEAR WALL ANCHORAGE AND HOLD-DOWNS		-	-	X	ALL CONNECTIONS VISUALLY INSPECTED	
FASTENING OF DIAPHRAGM AND SHEAR WALL SHEATHING WITH EDGE NAILING 4 INCHES ON CENTER OR LESS		-	-	X	ALL FASTENING VISUALLY INSPECTED NOT REQUIRED WHERE THE FASTENER SPACING IS MORE THAN 4 INCHES ON CENTER	

TABLE 3 - REQUIRED STRUCTURAL TESTING						
SYSTEM OR MATERIAL	IBC CODE REFERENCE	TESTING		FREQUENCY		REMARKS
		CODE OR STANDARD REFERENCE		CONTINUOUS	PERIODIC	
GEOTECHNICAL						
FILL IN-PLACE DENSITY OR PREPARED SUB GRADE DENSITY	1705.6	VARIABLE: MINIMUM PER IBC APPENDIX J107.5	-	X	BY THE GEOTECHNICAL ENGINEER	
MATERIAL VERIFICATION		VARIABLE: CLASSIFICATION AND TESTING OF CONTROLLED FILL MATERIALS	-	X	BY THE GEOTECHNICAL ENGINEER	
CONCRETE						
COMPOSITE SAMPLES	1903 1705.3	ASTM C 172 ACI 318: 5.6	ONE SAMPLE FOR EA 150 CY NOR LESS THAN 5,000 SQ FT OF SLABS AND WALLS, ONE SET PER DAY MIN	OBTAIN WHEN FRESH CONCRETE IS PLACED FOR EACH MIX DESIGN USED		
CONCRETE STRENGTH, UNO		ASTM C 39	EACH SAMPLE: 1 CYL - 7 DAYS 3 CYL - TEST AGE 1 CYL - HOLD	(NOTE 9) REFER TO GENERAL NOTES FOR TEST AGE. FOR 6 BY 12-INCH CYLINDERS, 2 CYLINDERS AT TEST AGE IS PERMITTED. CYL = CYLINDER		
CONCRETE SLUMP		ASTM C 143	ONE TEST PER COMPOSITE SAMPLE	AT POINT OF PLACEMENT		
CONCRETE AIR CONTENT		ASTM C 231	ONE TEST PER COMPOSITE SAMPLE	MIN ONE PER DAY		
CONCRETE TEMPERATURE		ASTM C 1064	ONE TEST PER COMPOSITE SAMPLE	ONE TEST PER HOUR WHEN AIR TEMP IS BELOW 40 DEG F OR ABOVE 80 DEG F		
STEEL						
RADIOGRAPHIC (RT) MAGNETIC PARTICLE (MT) AND ULTRASONIC (UT) TESTING OF WELDS	AISC 360 5.5	RT- AWS D1.1: 6.16 MT- AWS D1.1: 6.14 & 6.14.3 UT- AWS D1.1: 6.13 & 6.14.3	PER DRAWINGS	ALL CJP WELDS IN MATERIALS 5/16" OR GREATER REQUIRE UT TESTING		
PRE-CONSTRUCTION TESTING OF WELDED STUDS	1705.2.2.1	AWS D1.1: 7.7.1	EACH SIZE AND TYPE OF STUD EACH SHIFT	-		
PRE-INSTALLATION TESTING OF WELDED STUDS WELDED THROUGH DECKING	1705.2.2.1	AWS D1.1: 7.6	EACH STUD SIZE AND DECK GAUGE COMBINATION	-		
PRE-INSTALLATION VERIFICATION OF PRETENSIONED HIGH STRENGTH BOLTS	1705.2.1 AISC 360: TB N5.6-1	RCSC SPECIFICATION FOR STRUCTURAL JOINTS USING HIGH-STRENGTH BOLTS, SECTION 7	EACH COMBINATION OF DIAMETER, LENGTH, GRADE, AND LOT TO BE USED IN THE WORK	-		

STATEMENT OF SPECIAL INSPECTION AND TESTING NOTES:

3. SPECIAL INSPECTIONS SHALL CONFORM TO CHAPTER 17 OF THE INTERNATIONAL BUILDING CODE (IBC). REFER TO TABLES 1 AND 2 FOR SPECIAL INSPECTION AND TABLES 3 AND 4 FOR TESTING REQUIREMENTS.
2. REFERENCE CODES AND STANDARDS ARE AS FOLLOWS:
- IBC 2012
ACI 318-11
AWS CURRENT EDITION
ASTM CURRENT EDITION
AISC 360-10
344-10
RCSC 2009
3. SPECIAL INSPECTIONS AND ASSOCIATED TESTING SHALL BE PERFORMED BY AN APPROVED QUALIFIED TESTING AND INSPECTING AGENCY MEETING THE REQUIREMENTS OF ASTM E 329 (MATERIALS), ASTM D 3740 (SOLS), ASTM C 1077 (CONCRETE), ASTM A 880 (STEEL), AND ASTM E 543 (NON-DESTRUCTIVE). THE TESTING AND INSPECTING AGENCY SHALL FURNISH TO THE ARCHITECT A COPY OF THEIR SCOPE OF ACCREDITATION. SPECIAL INSPECTORS SHALL BE CERTIFIED BY THE BUILDING OFFICIAL. WELDING INSPECTIONS SHALL BE QUALIFIED PER SECTION 6.1.4.1.1 OF AWS D-1 AND WABO.
4. THE SPECIAL INSPECTOR SHALL OBSERVE THE INDICATED WORK FOR COMPLIANCE WITH THE APPROVED CONSTRUCTION DOCUMENTS. ALL DISCREPANCIES SHALL BE BROUGHT TO THE ATTENTION OF THE CONTRACTOR FOR CORRECTION AND NOTED IN THE INSPECTION REPORTS. ISSUES REQUIRING IMMEDIATE CORRECTIVE ACTIONS OR ENGINEERING INPUT ARE TO BE BROUGHT TO THE ENGINEER'S ATTENTION IMMEDIATELY UPON DISCOVERY.
5. THE SPECIAL INSPECTOR SHALL FURNISH INSPECTION REPORTS FOR EACH INSPECTION TO THE BUILDING OFFICIAL, ARCHITECT, CONTRACTOR, AND OWNER. THE TESTING AND INSPECTING AGENCY SHALL SUBMIT A FINAL REPORT STATING THAT THE WORK REQUIRING SPECIAL INSPECTION WAS INSPECTED AND IS IN CONFORMANCE WITH THE APPROVED CONSTRUCTION DOCUMENTS AND THAT ALL DISCREPANCIES NOTED IN THE INSPECTION REPORTS HAVE BEEN CORRECTED.
6. CONTINUOUS SPECIAL INSPECTION: SPECIAL INSPECTION BY THE SPECIAL INSPECTOR WHO IS PRESENT WHEN AND WHERE THE WORK IS TO BE INSPECTED IS BEING PERFORMED. PERIODIC SPECIAL INSPECTION: SPECIAL INSPECTION BY THE SPECIAL INSPECTOR WHO IS INTERMITTENTLY PRESENT WHERE THE WORK TO BE INSPECTED HAS BEEN OR IS BEING PERFORMED.
7. WHERE PERIODIC INSPECTION IS ALLOWED IN ACCORDANCE WITH THE ANCHOR ICC/ACIAPMO EVALUATION REPORT, INSPECTIONS SHALL:
- FOR ALL ANCHORS, PRIOR TO CONCEALMENT, VERIFY: ANCHOR TYPE, ANCHOR DIMENSIONS, ANCHOR SPACING AND EDGE...
- FOR EACH ANCHOR TYPE AND SIZE, INSPECTOR SHALL BE ONSITE TO CONTINUOUSLY INSPECT A MINIMUM OF THE FIRST 10 ANCHORS INSTALLED BY EACH INSTALLER FOR CONFORMANCE WITH ICC/ACIAPMO EVALUATION REPORT. PROVIDED ALL ANCHORS ARE INSTALLED CORRECTLY PER MANUFACTURER'S INSTRUCTIONS, PROVIDE PERIODIC INSPECTION ON A MINIMUM OF 10% OF THE NEXT 1000 ANCHORS BY EACH INSTALLER AND A MINIMUM OF 5% OF THE REMAINING ANCHORS BY EACH INSTALLER. INSPECTIONS SHALL OCCUR A MINIMUM OF ONCE PER WEEK AT A RANDOM TIME WHILE ANCHOR INSTALLATION IS ONGOING. ANY NON-COMPLIANCE ISSUES SHALL RESET THE INSPECTION REQUIREMENTS TO TEN (10) CONTINUOUS INSPECTIONS. NON-COMPLIANT ANCHORS SHALL BE BROUGHT TO THE ATTENTION OF THE ENGINEER OF RECORD FOR REVIEW AND SHALL BE BROUGHT INTO COMPLIANCE BY EITHER TESTING OR RE-INSTALLATION.
 - INSPECTION REPORTS SHALL IDENTIFY NAMES OF INSTALLERS.
 - SPECIAL INSPECTOR SHALL PROVIDE DOCUMENTATION AT THE END OF ANCHOR INSTALLATIONS STATING THAT THE MINIMUM NUMBER OF ANCHORS WERE INSPECTED.
8. OBSERVE: OBSERVE THESE ITEMS ON A RANDOM BASIS. OPERATIONS NEED NOT BE DELAYED PENDING THESE INSPECTIONS. PERFORM: PERFORM THESE TASKS FOR EACH ELEMENT.
9. INDICATED CONCRETE TESTING MEETS MINIMUM REQUIREMENTS FOR STRUCTURAL TESTING TO BE PROVIDED BY THE APPROVED QUALIFIED TESTING AND INSPECTING AGENCY. ADDITIONAL TESTING FOR CONSTRUCTION CONSIDERATIONS ARE NOT INDICATED AND SHALL BE DETERMINED BY THE CONTRACTOR AND PROVIDED AT CONTRACTOR'S EXPENSE.



t 425.778.1530 21911 76th Ave W. Ste 210
f 425.774.7803 Edmonds WA 98026
info@tgbarchitects.com
www.tgbarchitects.com

kpff

1601 5th Avenue, Suite 1600
Seattle, WA 98101

206.622.5822
www.kpff.com

**TULALIP TRIBES
GATHERING HALL**

7512 TOTEM BEACH RD
TULALIP, WA 98271

PHASE 2 - BUILDING AND LANDSCAPING

STATEMENT OF SPECIAL INSPECTIONS

[illegible]

PROJECT INFORMATION	
PROJECT NUMBER:	17031
PROJECT LEAD:	
DRAWN BY:	

SHEET NO


S0.11

7512 TOTEM BEACH RD
TULALIP, WA 98271

LOAD MAP PLANS

PROJECT INFORMATION	
PROJECT NUMBER:	17031
PROJECT LEAD:	GMH
DRAWN BY:	BLE


SHEET NO

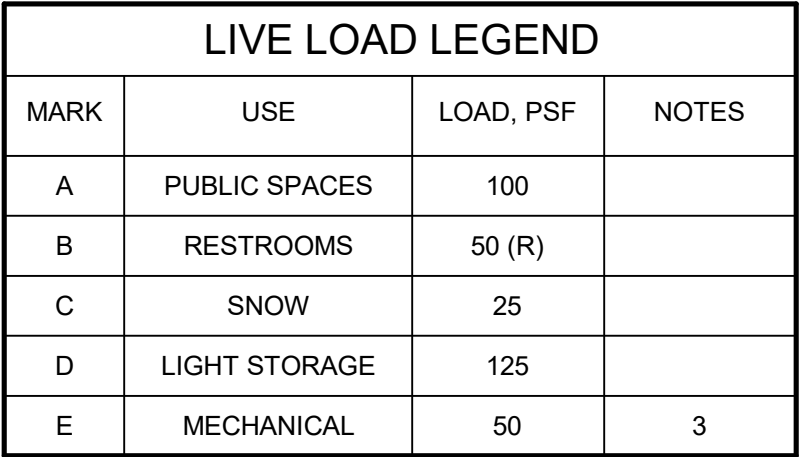

SUPERIMPOSED DEAD LOAD LEGEND			
MARK	TYPE	LOAD, PSF	NOTES
1	GATHERING HALL	15	
2	PUBLIC SPACES	10	
3	RISERS	25	
4	PITCHED ROOF	30	5
5	ROOF	25	
6	CANOPIES	15	5

LOAD LEGEND NOTES:

1. **A-1** INDICATES LIVE LOAD AND SUPERIMPOSED LOAD PER LEGENDS. LOADING OCCURS WITHIN REGIONS BOUND BY BOLD LINES. SUPERIMPOSED DEAD LOAD
LIVE LOAD
2. **(R)** INDICATES REDUCIBLE LIVE LOAD IN ACCORDANCE WITH BUILDING CODE PROVISIONS.
3. WHERE EQUIPMENT WEIGHTS EXCEED 50 PSF, DESIGN LOAD IS ACTUAL EQUIPMENT WEIGHT INDICATED ON LOAD PLAN + 4" HOUSEKEEPING PAD + 25 PSF IN OPEN AREAS.
4. REFER TO TABLE 1607.1 IN THE IBC FOR RELEVANT CONCENTRATED LIVE LOADS.
5. SDI INCLUDES 5 PSF FOR PV PANELS.
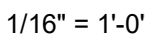
$$1/16'' = 1'-0''$$


7512 TOTEM BEACH RD
TULALIP, WA 98271


FOUNDATION PLAN - PHASE 2

[illegible]

PROJECT INFORMATION	
PROJECT NUMBER:	17031
PROJECT LEAD:	GMH
DRAWN BY:	BLE

SHEET NO

S2.11B

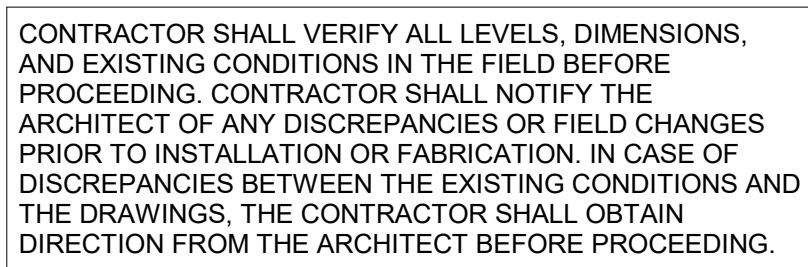

GENERAL PLAN NOTES:

- | | |
|-----|--|
| G1. | <p>REFERENCE DRAWINGS:</p> <p>S0.0X - STRUCTURAL NOTES, SYMBOLS AND ABBREVIATIONS</p> <p>S0.1X - SPECIAL INSPECTION SCHEDULE</p> <p>S0.21 - LOAD MAPS</p> <p>S4.0X - TYPICAL CONCRETE DETAILS</p> <p>S5.0X - TYPICAL STEEL DETAILS</p> <p>S6.0X - TYPICAL WOOD DETAILS</p> |
| G2. | <p>VERIFY ALL DIMENSIONS AND ELEVATIONS WITH ARCHITECTURAL DRAWINGS.</p> |

FOUNDATION PLAN NOTES:

- F1. TOP OF SLAB-ON-GRADE ELEVATIONS PER ARCHITECTURAL DRAWINGS.
- F2. SLAB-ON-GRADE SHALL BE 6" THICK WITH #4 @ 15" OC EW. UNO. BASE FOR SLAB-ON-GRADE SHALL CONSIST OF VAPOR RETARDER OVER 6" COMPACTED GRAVEL FILL.
- F3. INDICATES COLUMN ABOVE AND BASE PLATE PER 9/S.01

PLAN
NORTH

$$1/8'' = 1'-0''$$

TULALIP TRIBES
GATHERING HALL

7512 TOTEM BEACH RD
TULALIP, WA 98271

PHASE 2 - BUILDING AND
LANDSCAPING


MAIN LEVEL
FRAMING PLAN -
PHASE 2

ISSUANCE		
No.	Description	Date
1	PHASE 2 PERMIT SET	08/20/18
2	PHASE 2 BID SET	10/08/18
3	ADDENDUM 3	11/14/18
4	PHASE 2 CONSTRUCTION SET	03/13/19
5	PHASE 2 CCD #2	04/30/19
6	PHASE 2 ASI 1	05/22/19
7	PH 2 RECORD SET	06/02/20

PROJECT INFORMATION
PROJECT LEAD: 17031
PROJECT LEAD: GMH
DRAWN BY: BJE

SHEET NO

S2.12B

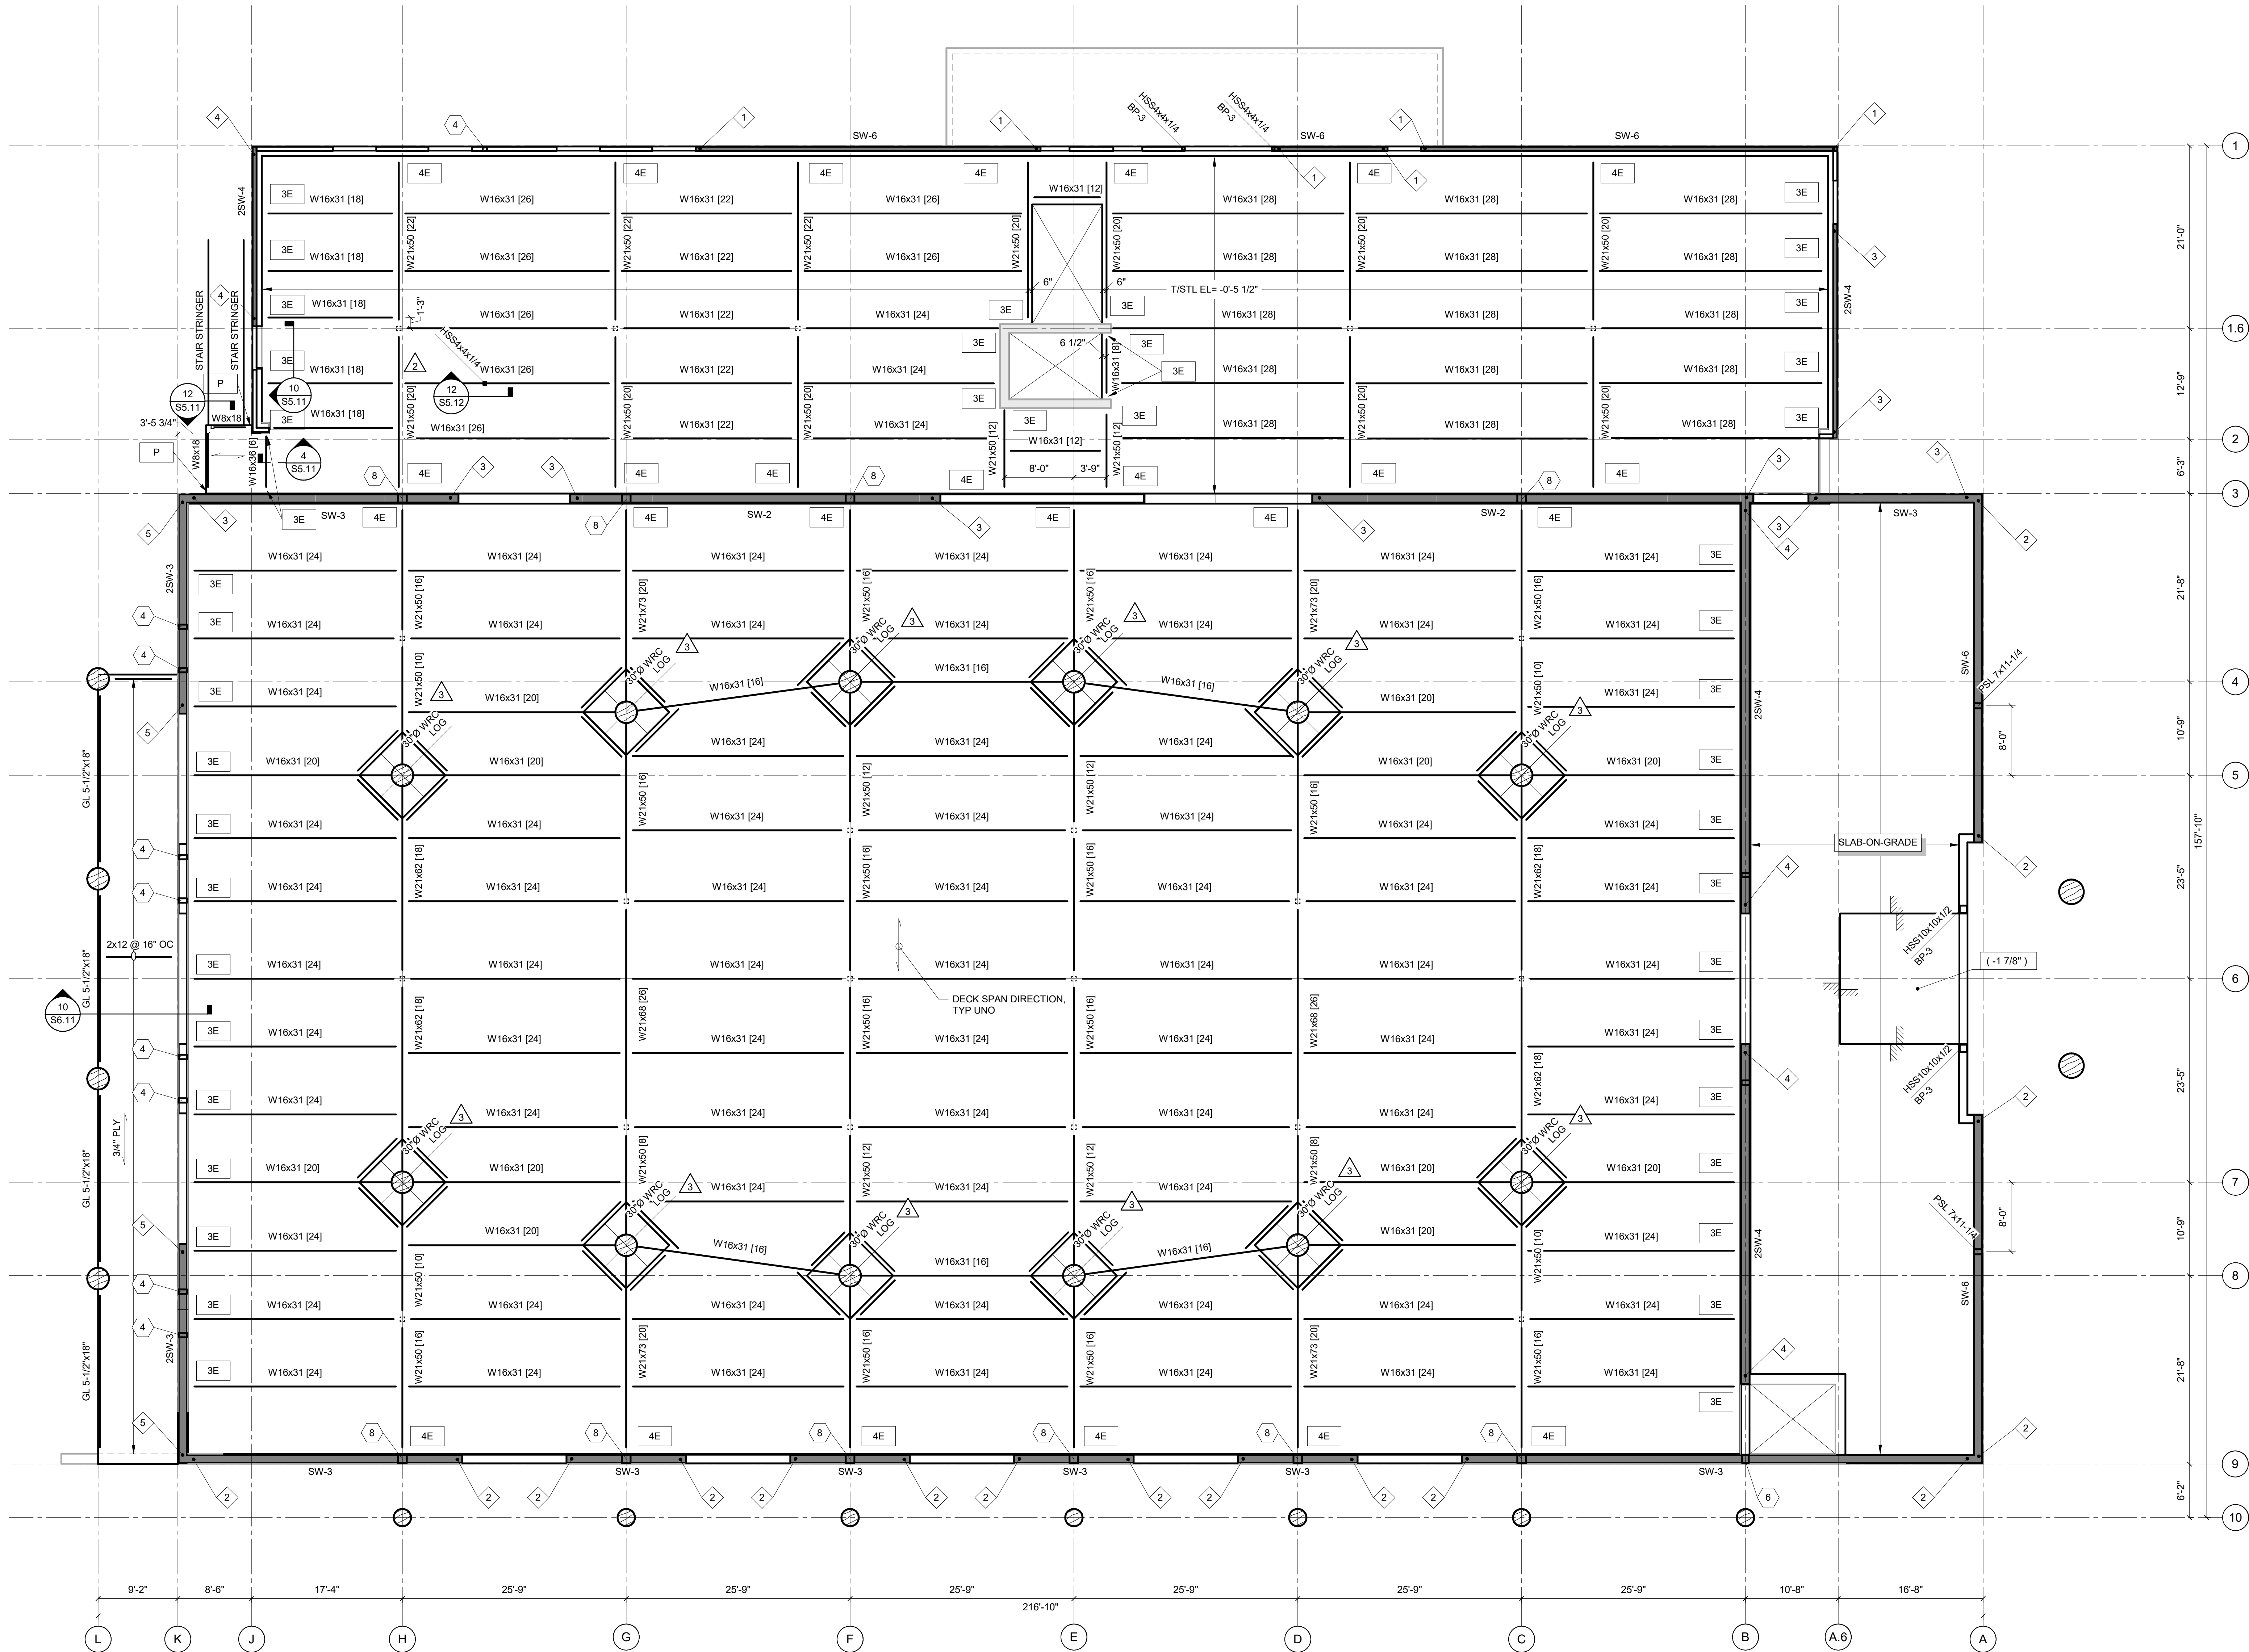

7512 TOTEM BEACH RD
TULALIP, WA 98271

LOW ROOF FRAMING PLAN

[illegible]






PROJECT INFORMATION	
PROJECT NUMBER:	17031
PROJECT LEAD:	GMH
DRAWN BY:	BLE

SHEET NO



- | | |
|-----|---|
| G1. | <p>REFERENCE DRAWINGS:</p> <ul style="list-style-type: none"> S0.0X - STRUCTURAL NOTES, SYMBOLS AND ABBREVIATIONS S0.1X - SPECIAL INSPECTION SCHEDULE S0.21 - LOAD MAPS S4.0X - TYPICAL CONCRETE DETAILS S5.0X - TYPICAL STEEL DETAILS S6.0X - TYPICAL WOOD DETAILS |
| G2. | <p>VERIFY ALL DIMENSIONS AND ELEVATIONS WITH ARCHITECTURAL DRAWINGS.</p> |

- WOOD FRAMING PLAN NOTES:

- | | | |
|-----|---|--|
| W1. | | SEE THE ARCHITECTURAL DRAWINGS FOR WALL TYPES AND FOR NON-BEARING WALL LOCATIONS |
| W2. |  | INDICATES HOLD-DOWN PER 12/S6.04.
FIELD VERIFY EXISTING ANCHOR LOCATIONS. |
| W3. |  | INDICATES NUMBER OF BUNDLED STUDS,
MATCH WALL STUD SIZE |
| W4. |  | INDICATES SIMPSON HARDWARE
PER 4/S6.01. |
| W5. |  | INDICATES WOOD SHEAR WALL ABOVE
PER 7/S6.01. |
| W6. |  | INDICATES TOP PLATE SPLICE
PER 11/6.01, UNO. |
| W7. | H1 | INDICATES HEADER FRAMING PER 10/S6.01. |

PLAN
NORTH

$$1/8'' = 1'-0''$$

7512 TOTEM BEACH RD
TULALIP, WA 98271


ROOF FRAMING PLAN

[illegible]

PROJECT INFORMATION	
PROJECT NUMBER:	17031
PROJECT LEAD:	GMH
DRAWN BY:	BLE

SHEET NO

7/10/2020 3:12:17 PM C:\Revit Models\2018\1700600 - Tulalip Gathering Hall_Struc_GHensley.rvt

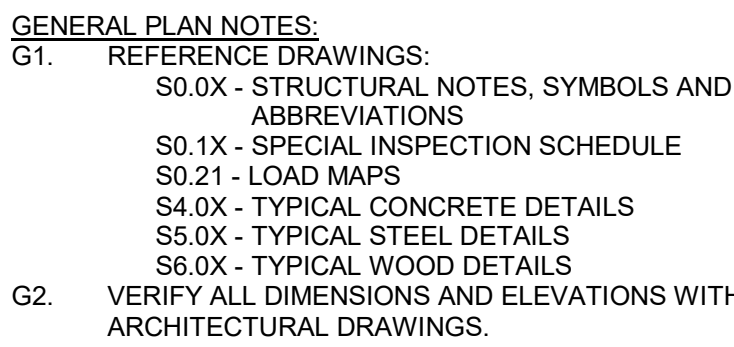


WOOD ROOF FRAMING PLAN NOTES:

W1.		TOP OF SHEATHING SHALL BE INDICATED ON AS PLAN.
W2.	TPS-2	INDICATES TOP PLATE SPLICE PER 11/6.01, UNO.
W3.	H1	INDICATES HEADER FRAMING PER 10/S6.01.


PLAN
NORTH

$$1/8" = 1'-0"$$

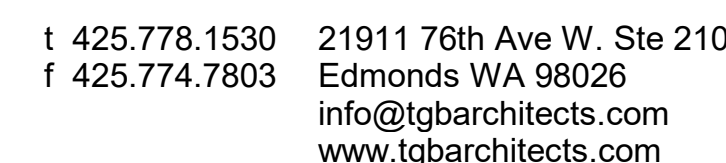


206.622.5822
www.kpff.com

1/4" = 1'-0"

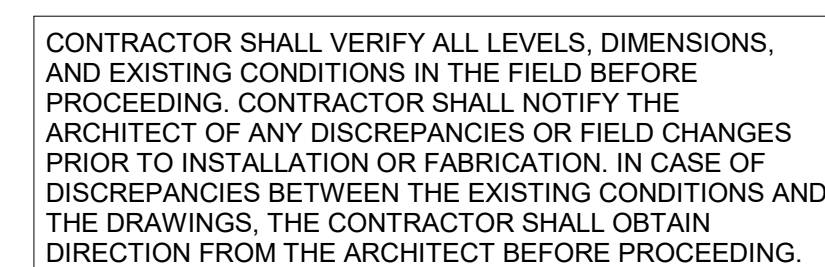

1/4" = 1'-0"

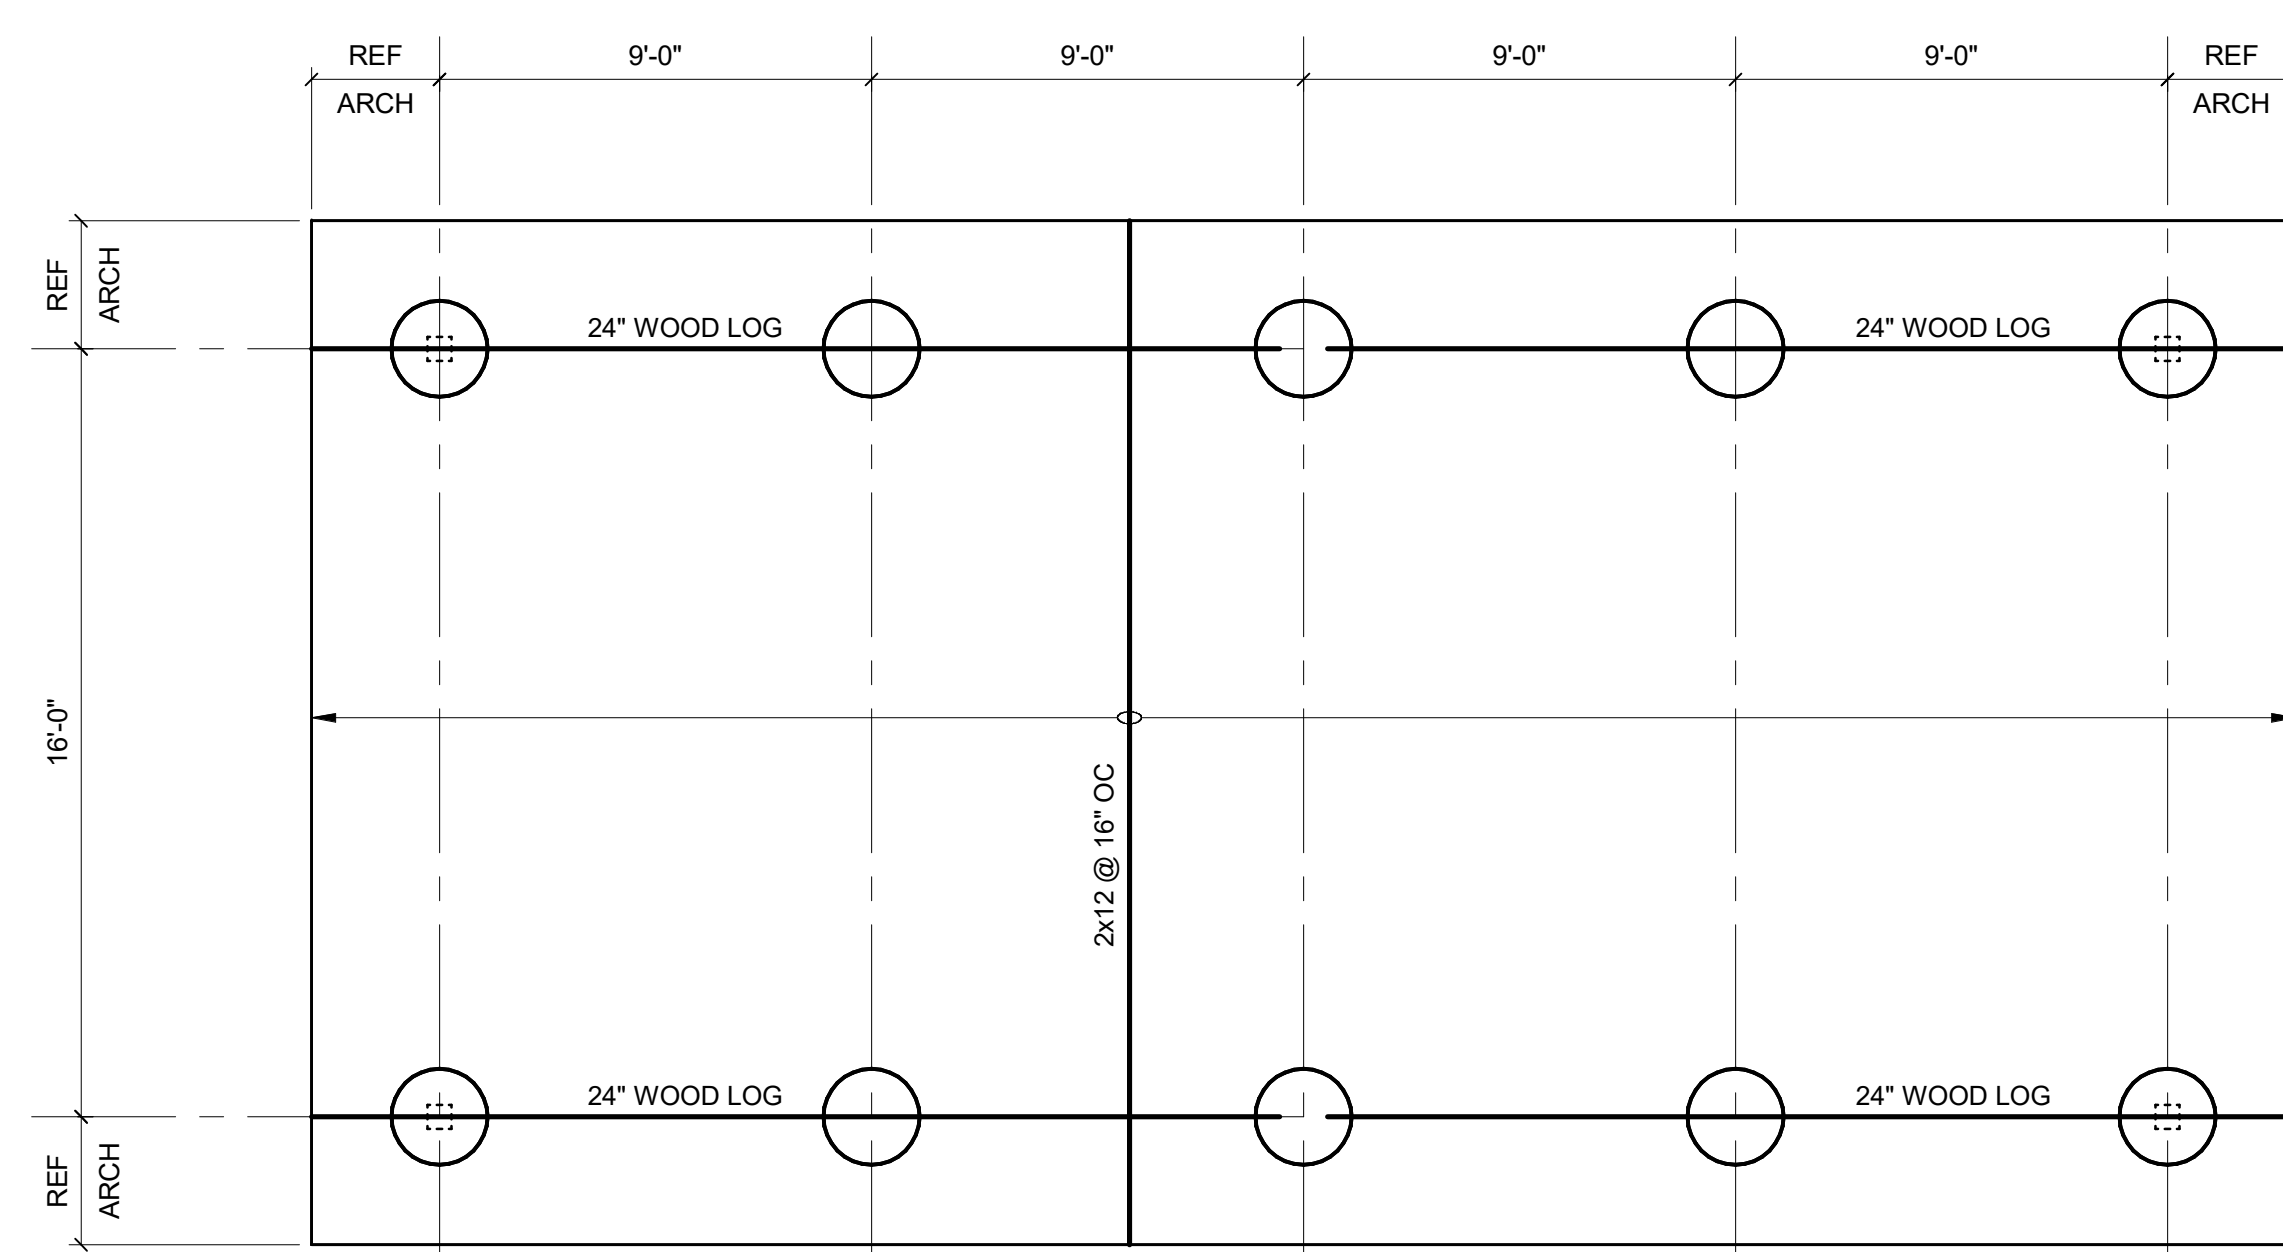

1/4" = 1'-0"

FOUNDATION PLAN NOTES:	
F1.	TOP OF SLAB-ON-GRADE ELEVATION PER ARCHITECTURAL DRAWINGS
F2.	SLAB-ON-GRADE SHALL BE 6" THICK WITH @ #4 15" OC EW. UNO BASE FOR FLOOR FINISH SHALL BE CONSIST OF VAPOR RETARDER OVER 6" COMPACTED GRAVEL FILL.
F3.	FOOTINGS SHALL BEAR ON COMPETENT SOIL WITH DESIGN BEARING CAPACITY PER THE STRUCTURAL ENGINEER. ALL VERTICAL LOADS BELOW FOOTINGS & SLABS SHALL BE REMOVED PER THE REFERENCED GEOTECHNICAL REPORT.
F4.	F10.0 (99'-0") INDICATES SPREAD FOOTING TYPE AND BOTTOM OF FOOTING ELEVATION. SEE 6/54.11.
F5.	FWS (99'-0") INDICATES CONTINUOUS FOOTING TYPE AND BOTTOM OF FOOTING ELEVATION. SEE 10/54.11.
F6.	CS (99'-0") INDICATES CONCRETE PLINTH TYPE. SEE 7/54.11.
	3/60 INDICATES ANCHOR RODS FOR PHASE 2 COLUMN BASE PLATE. SEE 3/54.11.

WOOD ROOF FRAMING PLAN NOTES:
W1. TOP OF SHEATHING SHALL BE INDICATED ON AS PLAN.
W2. TPS-2 INDICATES TOP PLATE SPLICE
PER 11/6.01, UNO.
W3. H1 INDICATES HEADER FRAMING PER 10/S6.01

7512 TOTEM BEACH RD
TULALIP, WA 98271

PHASE 2 - BUILDING AND LANDSCAPING

[illegible]



PROJECT INFORMATION	
PROJECT NUMBER:	17031
PROJECT LEAD:	Designer
DRAWN BY:	Author

SHEET NO

S2.21


1. ALL BOLTED CONNECTIONS TO BE TYPE N WITH FULLY PRETENSION ASTM A325-N BOLTS PER AISI STANDARDS EXCEPT WHERE "SNUG TIGHT" OR "SLIP CRITICAL" CONNECTIONS ARE INDICATED.
2. BOLTS IN BEAM TO BEAM CONNECTIONS MAY BE TIGHTENED TO AISI "SNUG TIGHT" CONDITION UPON APPROVAL OF ENGINEER AND OWNER.
3. CONNECTIONS TO HAVE AISI STANDARD ROUND HOLES EXCEPT AS NOTED OTHERWISE.
4. BEAM CONNECTIONS TO BE PER THE STANDARD BOLTED BEAM CONNECTION DETAIL UNLESS NOTED OTHERWISE.

8. ALTERNATE CONNECTION DETAILS MAY BE SUBMITTED TO THE ENGINEER FOR REVIEW AND SHALL BE ACCOMPANIED BY CALCULATIONS BEARING THE SEAL AND SIGNATURE OF THE WASHINGTON STATE STRUCTURAL ENGINEER WHO IS RESPONSIBLE FOR THE DESIGN. ALTERNATE CONNECTIONS SHALL HAVE EQUAL OR GREATER CAPACITY THAN THE CONNECTIONS SHOWN ON THE DRAWINGS.
9. FOR MEMBERS DESIGNATED AS PART OF THE SFRS, WELD TABS SHALL BE REMOVED UPON COMPLETION AND COOLING OF THE WELD, AND THE ENDS OF THE WELD SHALL BE MADE SMOOTH AND FLUSH WITH THE EDGES OF ABUTTING PARTS.

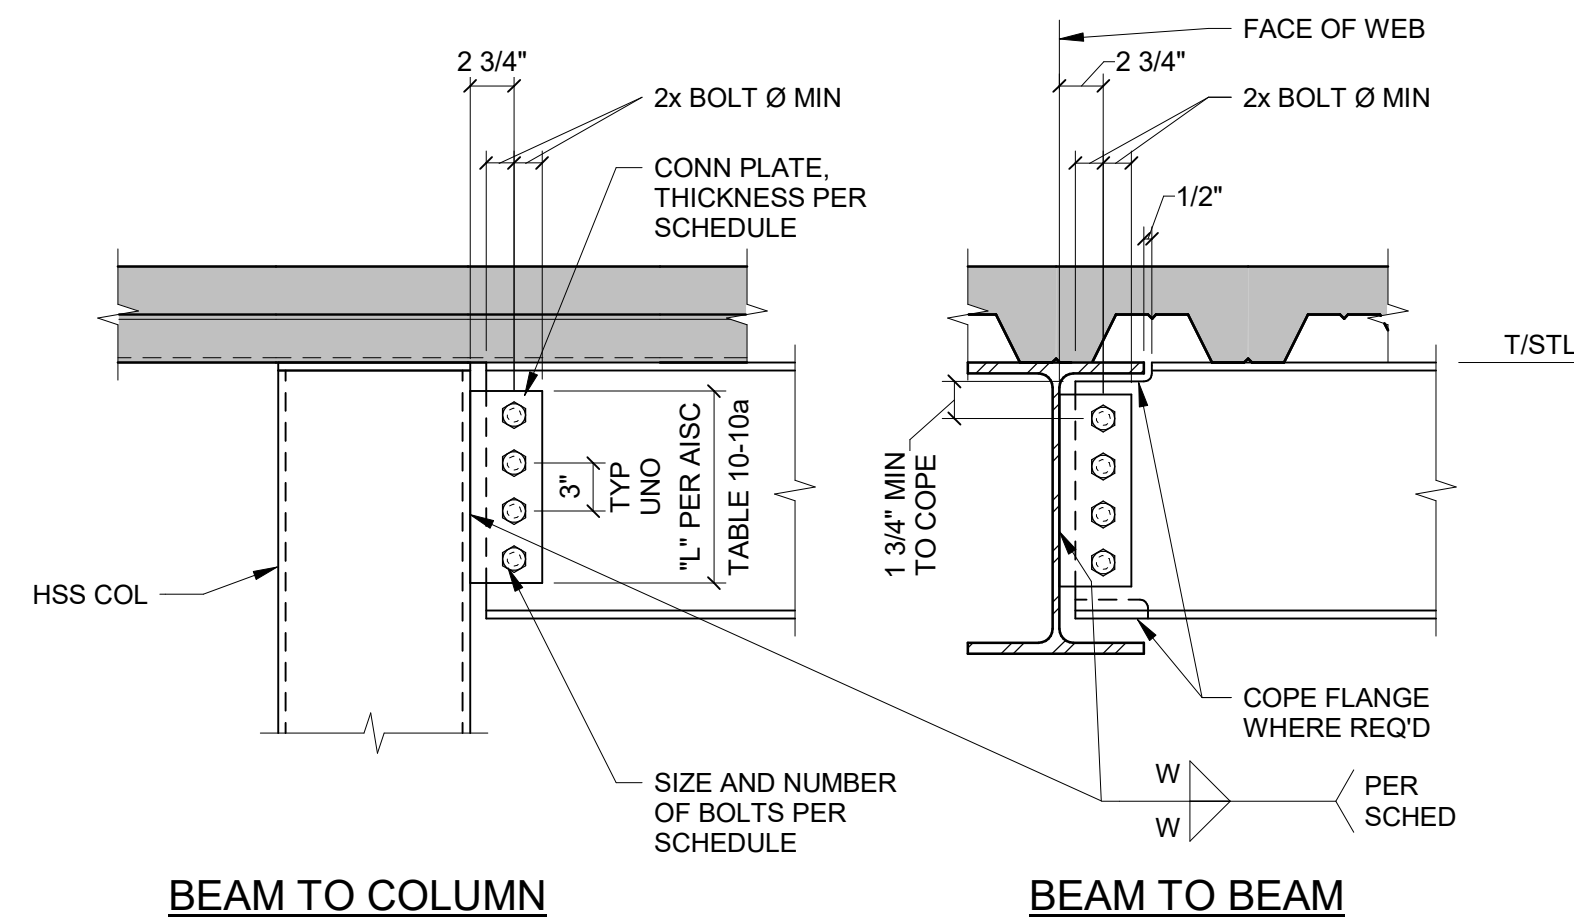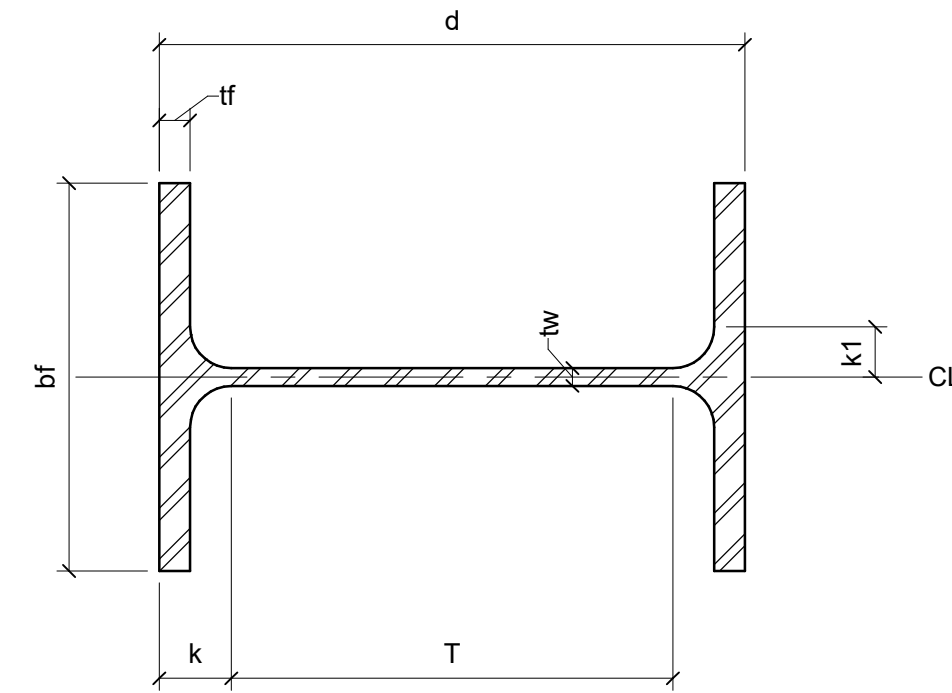

STANDARD BOLTED CONNECTION SCHEDULE			
BEAM SIZE	NUMBER AND SIZE OF BOLTS REQUIRED	MIN PLATE THICKNESS	WELD SIZE "W"
W6, C6, C7	(2) 3/4"Ø @ 2" GA	1/4"	3/16"
W8, C8, C9	(2) 3/4"Ø	1/4"	3/16"
W10, C10	(2) 3/4"Ø	1/4"	3/16"
W12, C12	(3) 3/4"Ø	1/4"	3/16"
W14, C15	(3) 3/4"Ø	1/4"	3/16"
W16	(4) 3/4"Ø	1/4"	3/16"
W18	(4) 3/4"Ø	5/16"	1/4"
W21	(5) 3/4"Ø	5/16"	1/4"
W24	(6) 3/4"Ø	5/16"	1/4"

NO SCALE

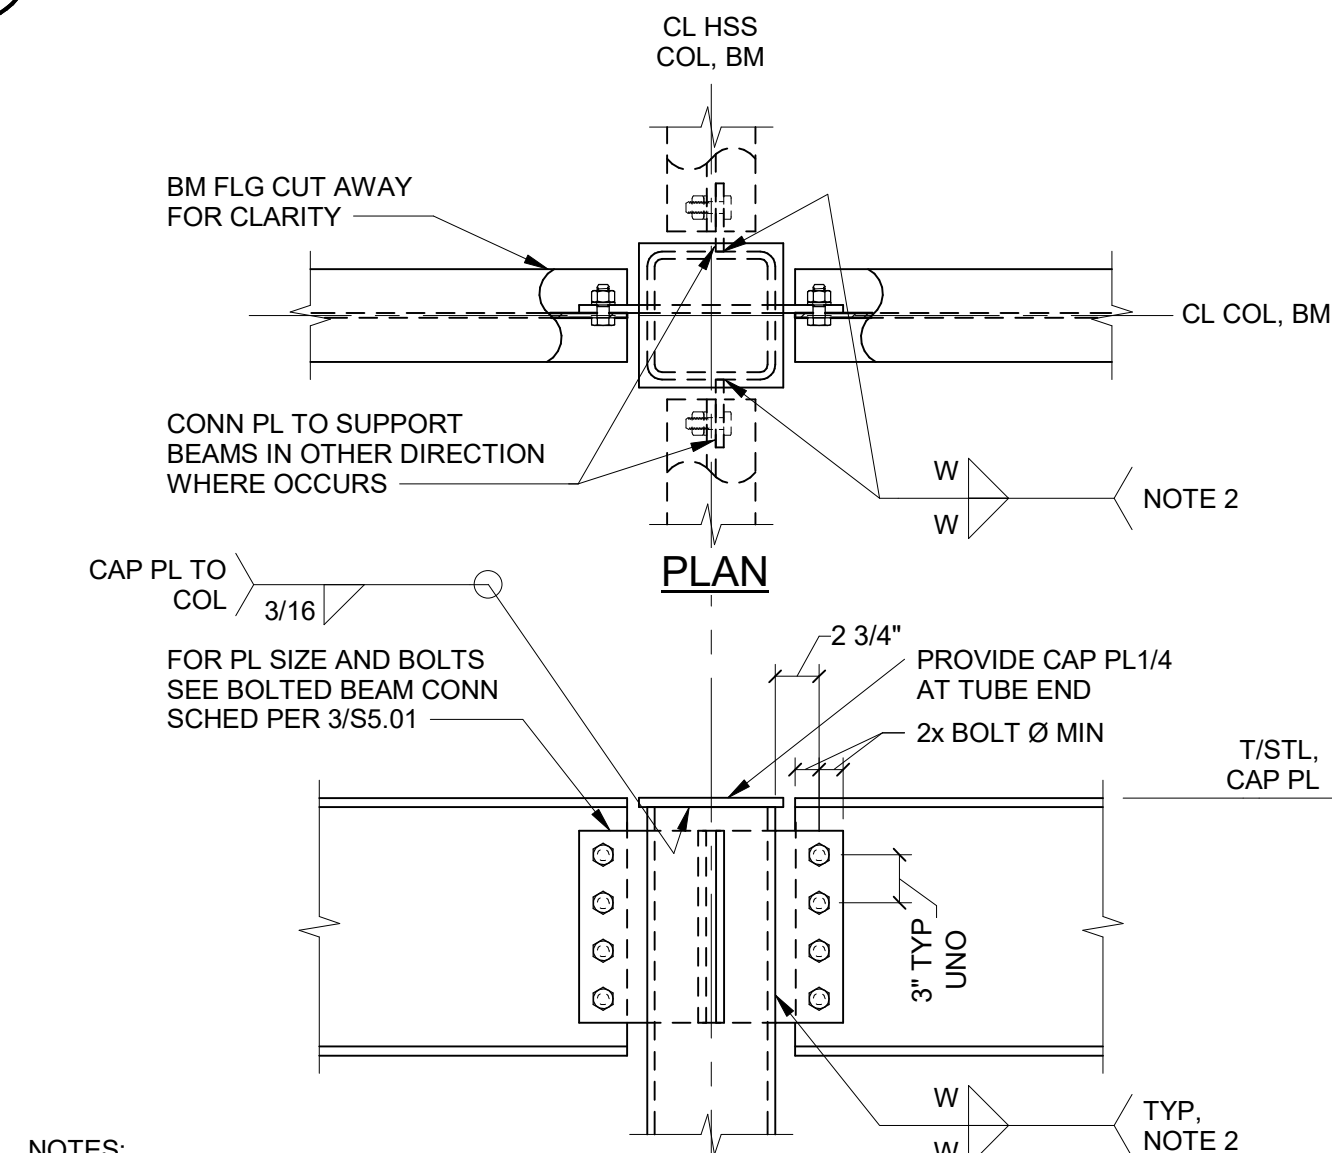


- NOTES:**
1. WHERE SINGLE BEAM CONNECTION IS REQUIRED ON THROUGH-PLATE, EXTEND PLATE 1/2" PAST EXTERIOR FACE OF COLUMN FOR WELD ACCESS.
 2. WELD SIZE "W" PER BOLTED BEAM SCHEDULE, SEE 3/S5.01.

5 NO SCALE

COLUMN BASE PLATE SCHEDULE	
TYPE MARK	REFERENCE DETAIL
BP-1	8/S5.11
BP-2	8/S5.11
BP-3	15/S5.11
BP-4	8/S6.11
BP-5	8/S6.11
BP-6	8/S5.11


(9) _____ NO SCALE

2 NO SCALE

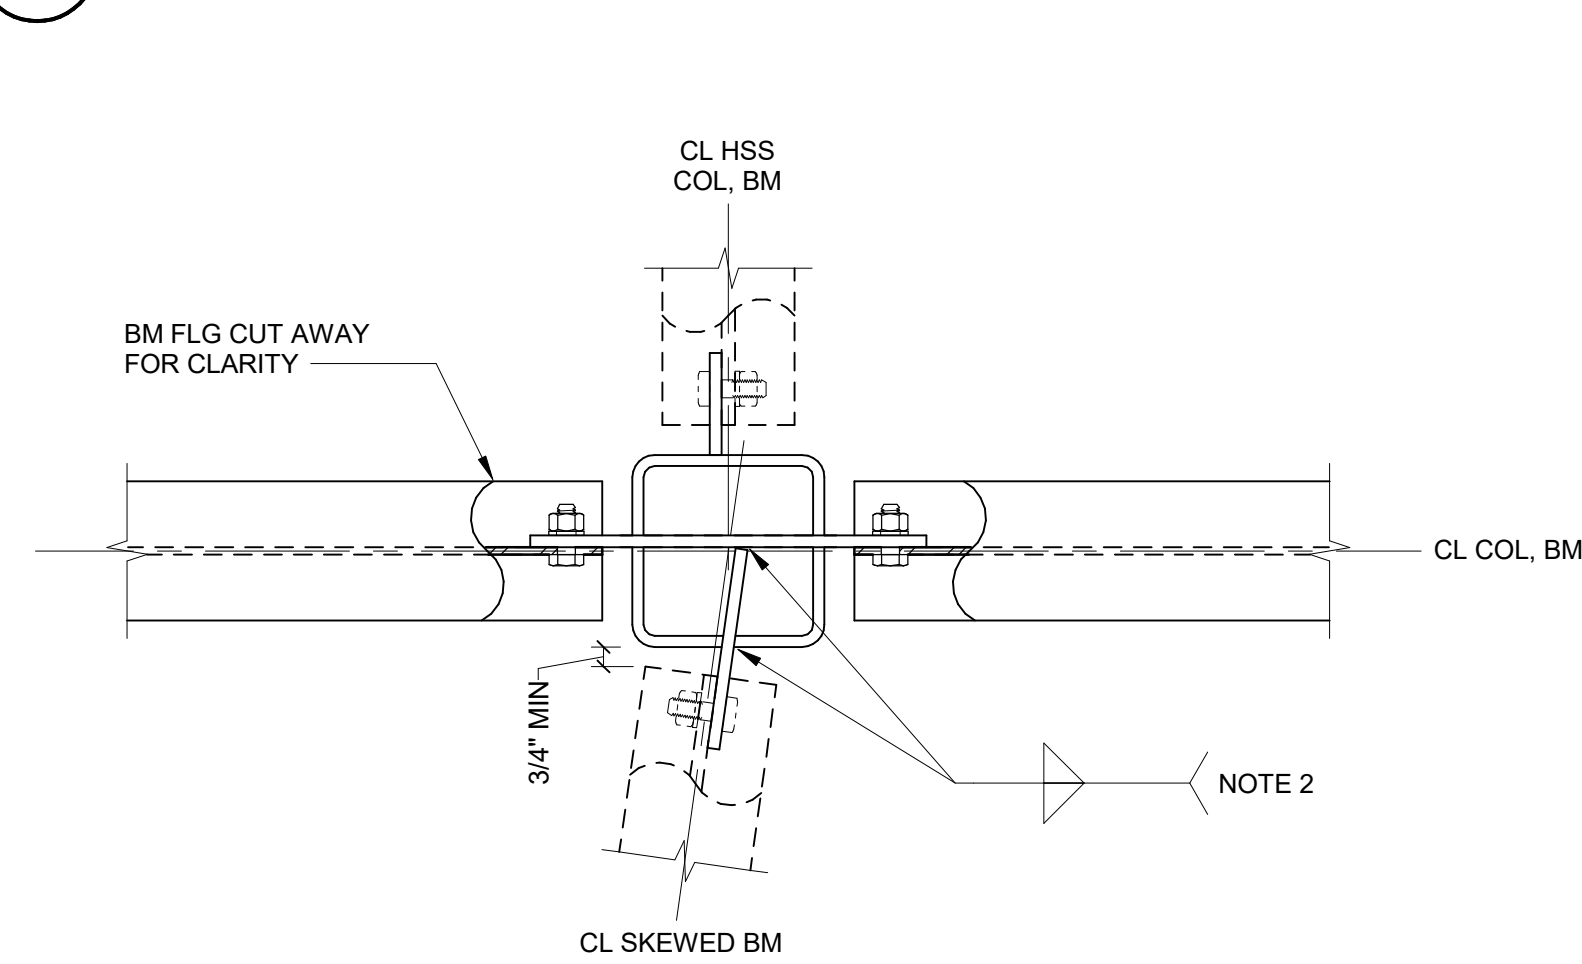

- NOTES:**
1. SEE 5/S5.01 FOR ADDITIONAL INFORMATION.
 2. WELD SIZE "W" PER BOLTED BEAM SCHEDULE, SEE 3/S5.01.
 3. CAP PLATE NOT SHOWN FOR CLARITY.


6 NO SCALE

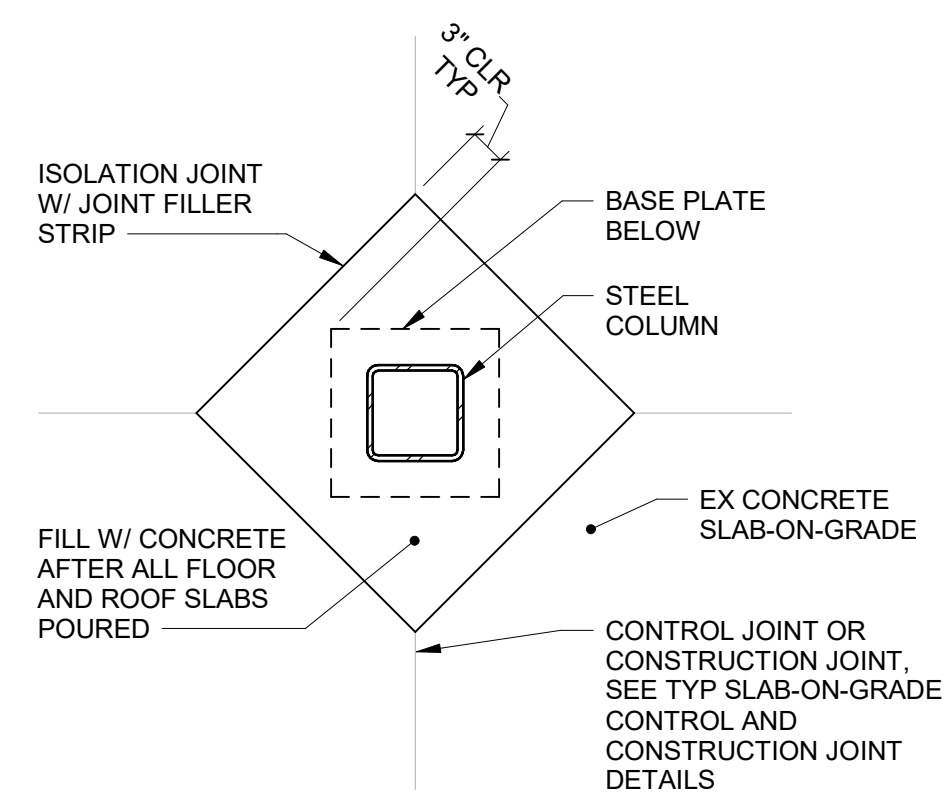


(10) NO SCALE

3 NO SCALE


EMBEDDED PLATE CONNECTION SCHEDULE			
CONN TYPE (XE)	NUMBER OF BOLTS REQUIRED	PLATE SIZE	DOUBLE ANGLE SIZE
2E	2	PL5/8x10x0'-11"	L5x3-1/2x5/16
3E	3	PL5/8x11x1'-2"	L5x3-1/2x5/16
4E	4	PL3/8x14x1'-5"	L5x3-1/2x5/16
5E	5	PL3/4x15x1'-8 1/2"	L5x3-1/2x5/16

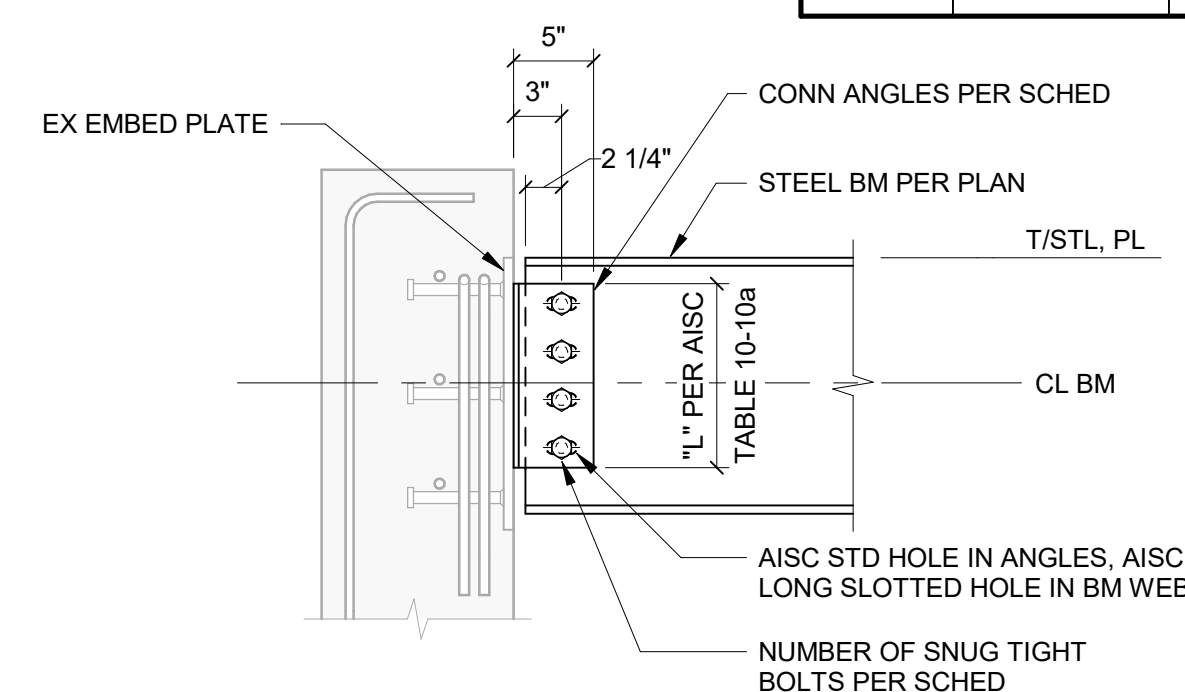

NO SCALE

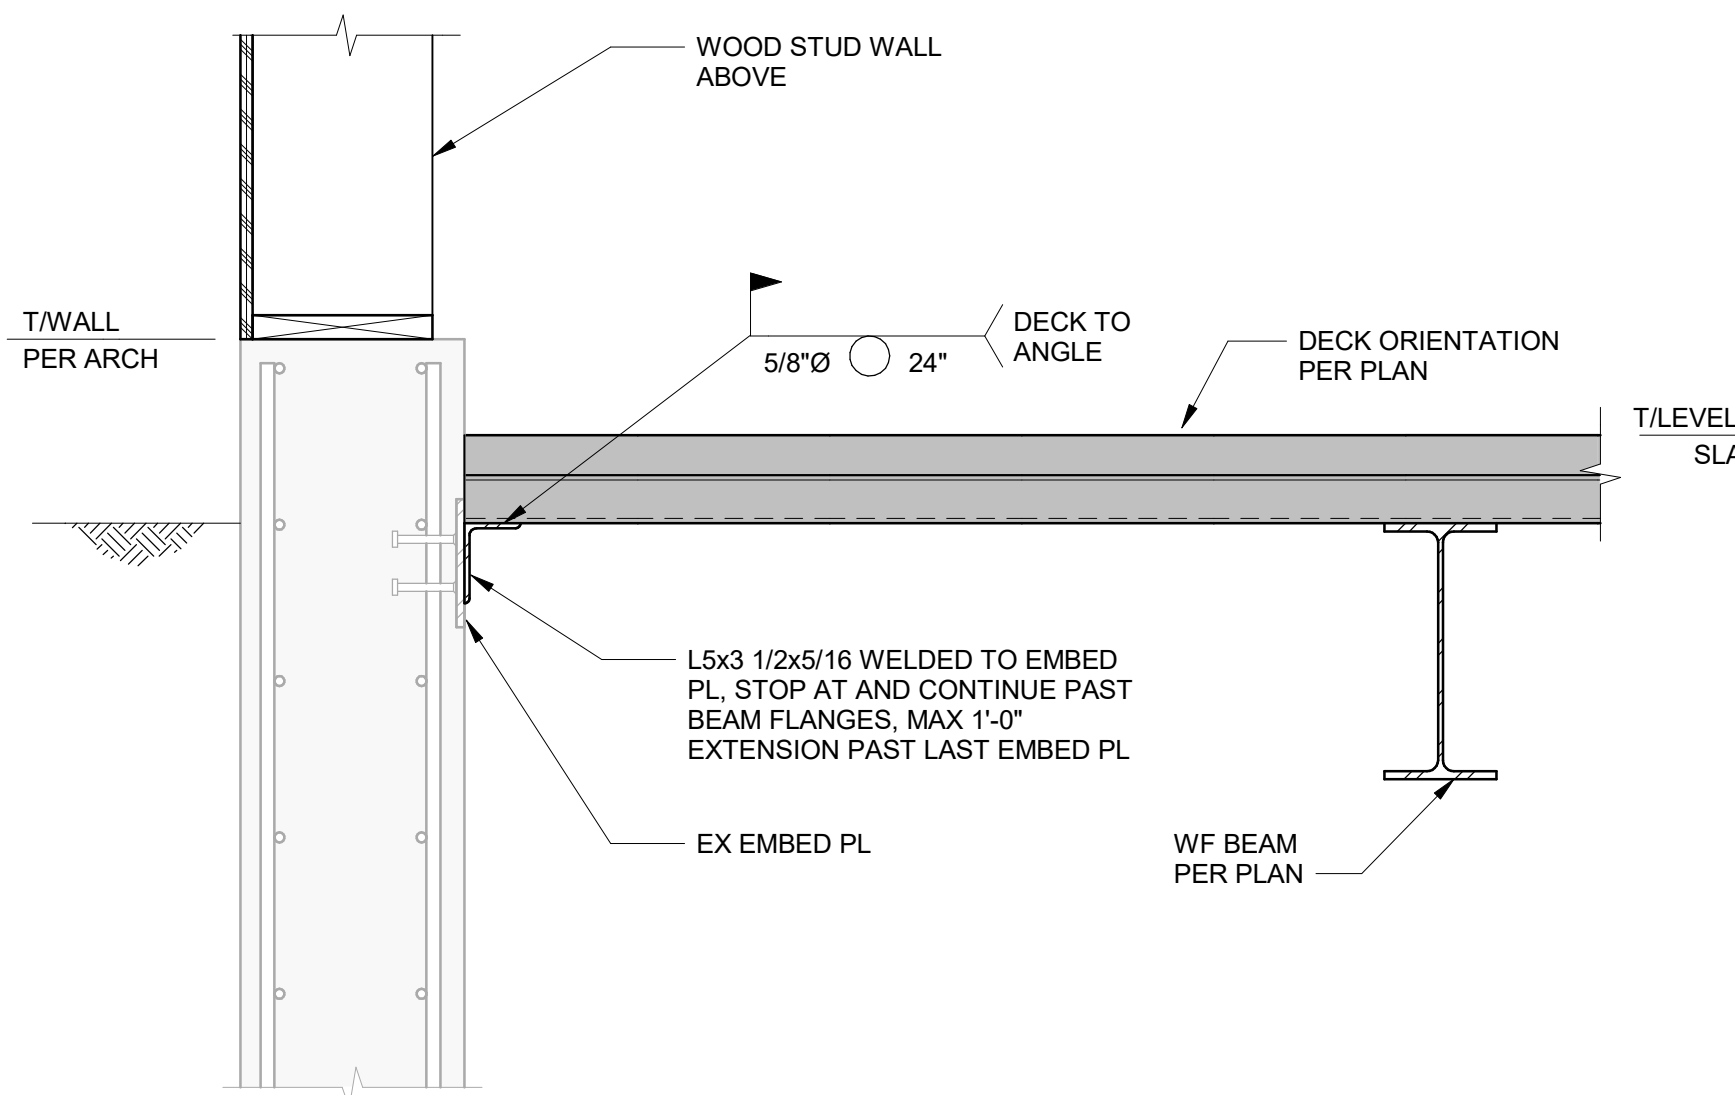

(11) NO SCALE

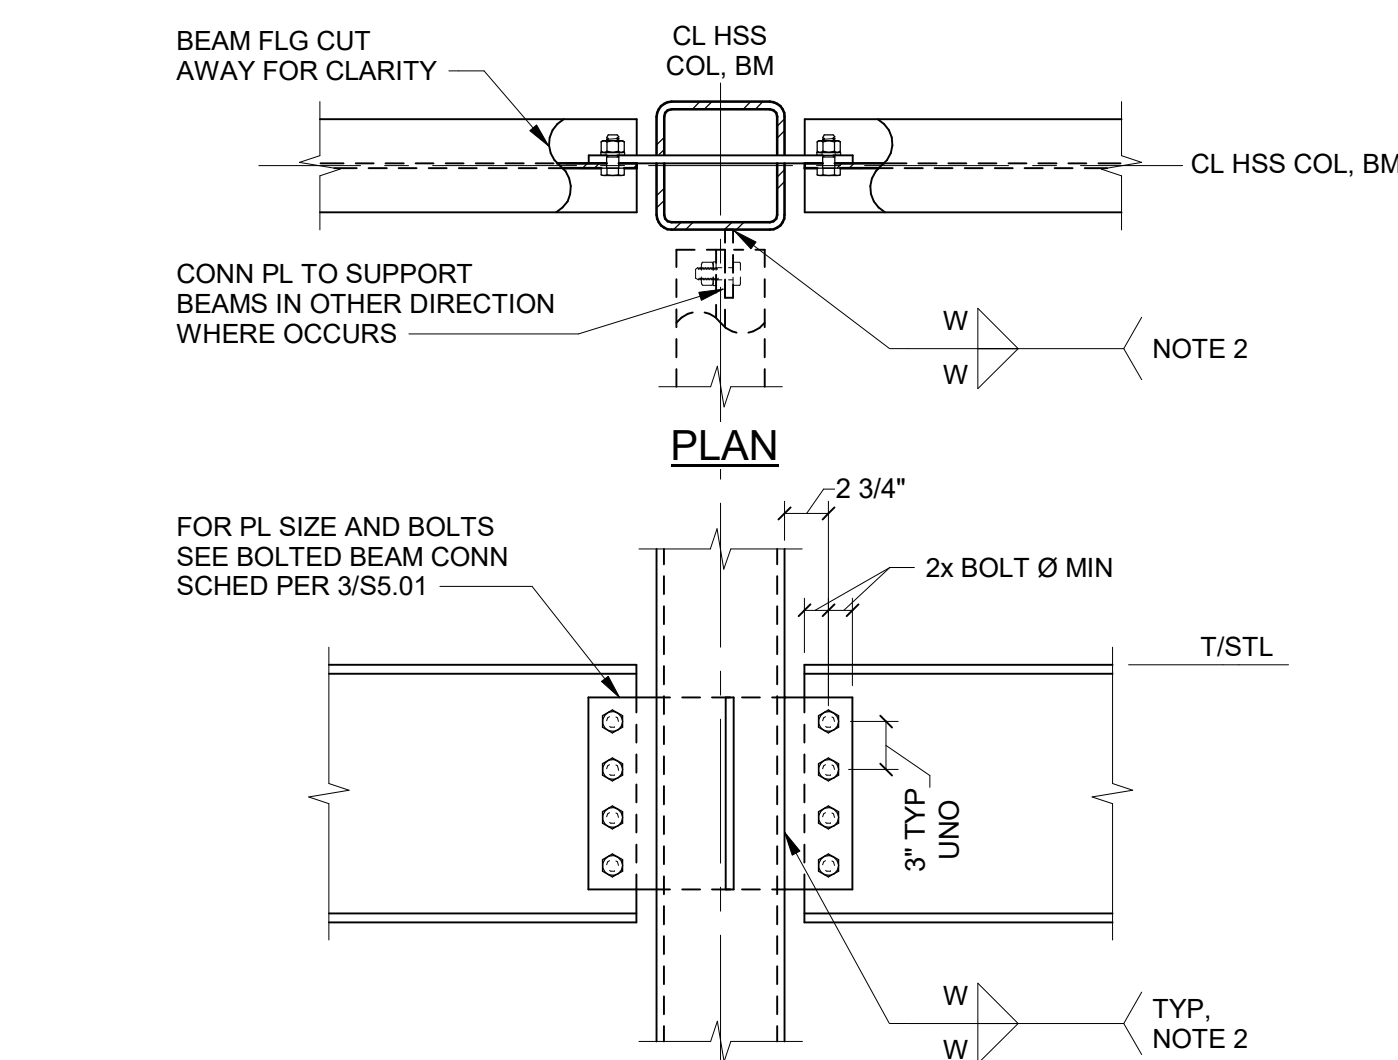

- NOTES:
1. WHERE SINGLE BEAM CONNECTION IS REQUIRED ON THROUGH-PLATE, EXTEND PLATE 1/2" PAST EXTERIOR FACE OF COLUMN FOR WELD ACCESS.
 2. WELD SIZE "W" PER BOLTED BEAM SCHEDULE. SEE 3/S5.01.

(12) NO SCALE



t 425.778.1530 21911 76th Ave W. Ste 210
f 425.774.7803 Edmonds WA 98026
info@tgbarchitects.com
www.tgbarchitects.com

kpff

1601 5th Avenue, Suite 1600
Seattle, WA 98101

206.622.5822
www.kpff.com


7512 TOTEM BEACH RD
TULALIP, WA 98271

[illegible]

PROJECT INFORMATION	
PROJECT NUMBER:	17031
PROJECT LEAD:	GMH
DRAWN BY:	BLE


SHEET NO

S5.01

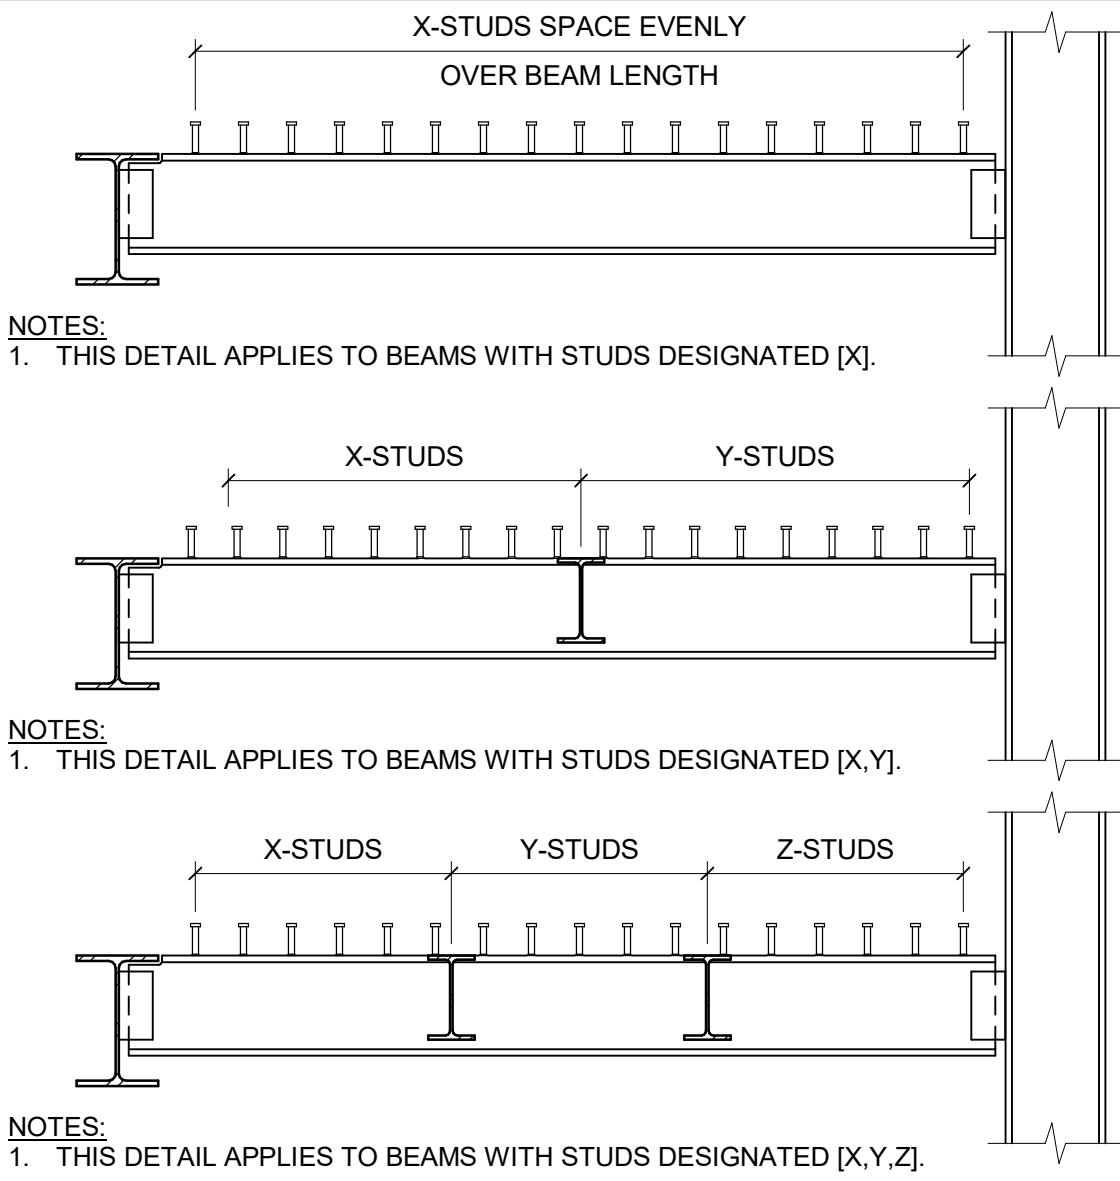


1 TYPICAL STUD SPACING

NO SCALE

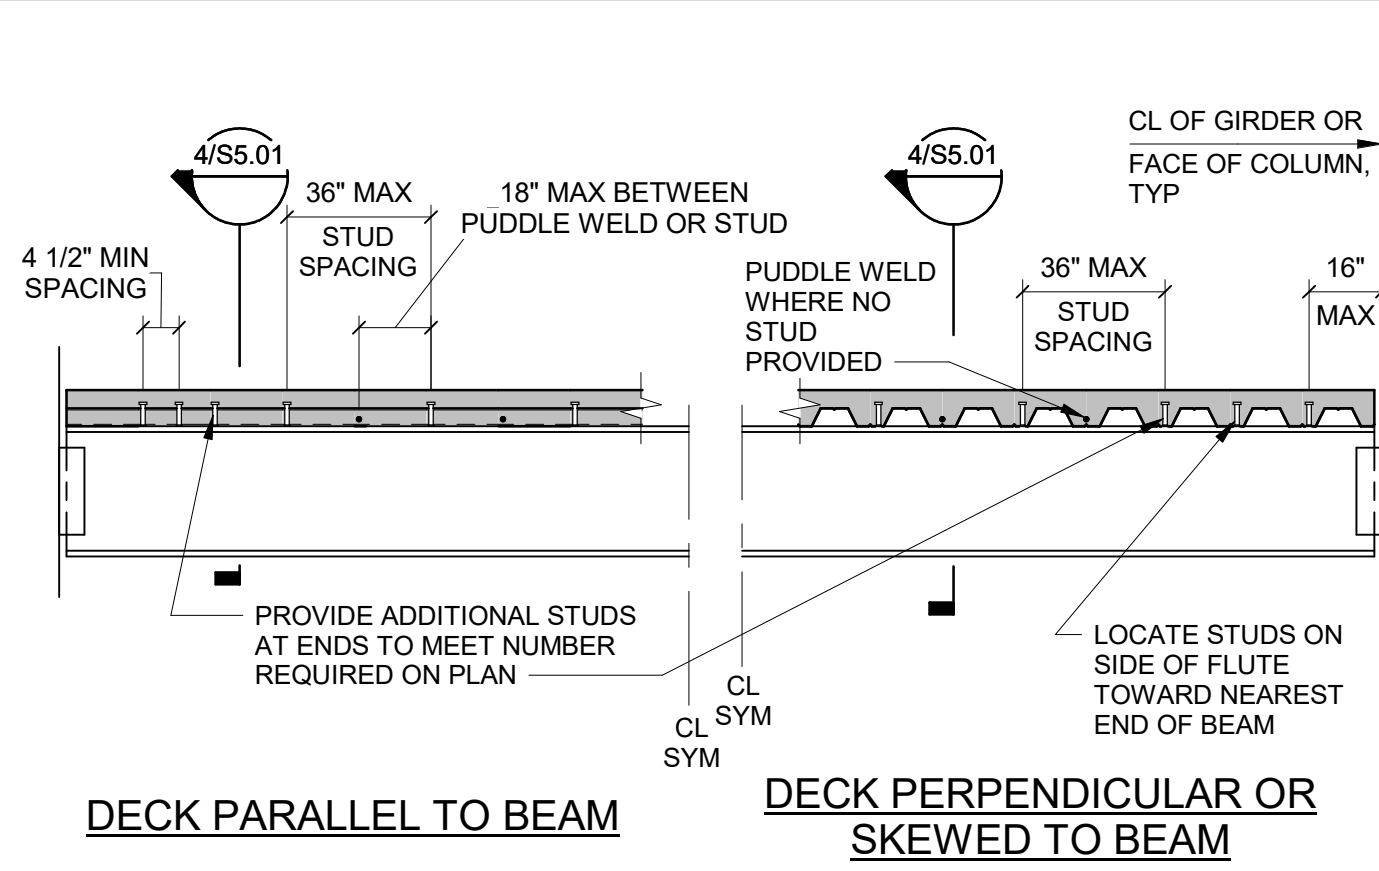


2 TYPICAL COMPOSITE BEAM DETAIL

NO SCALE

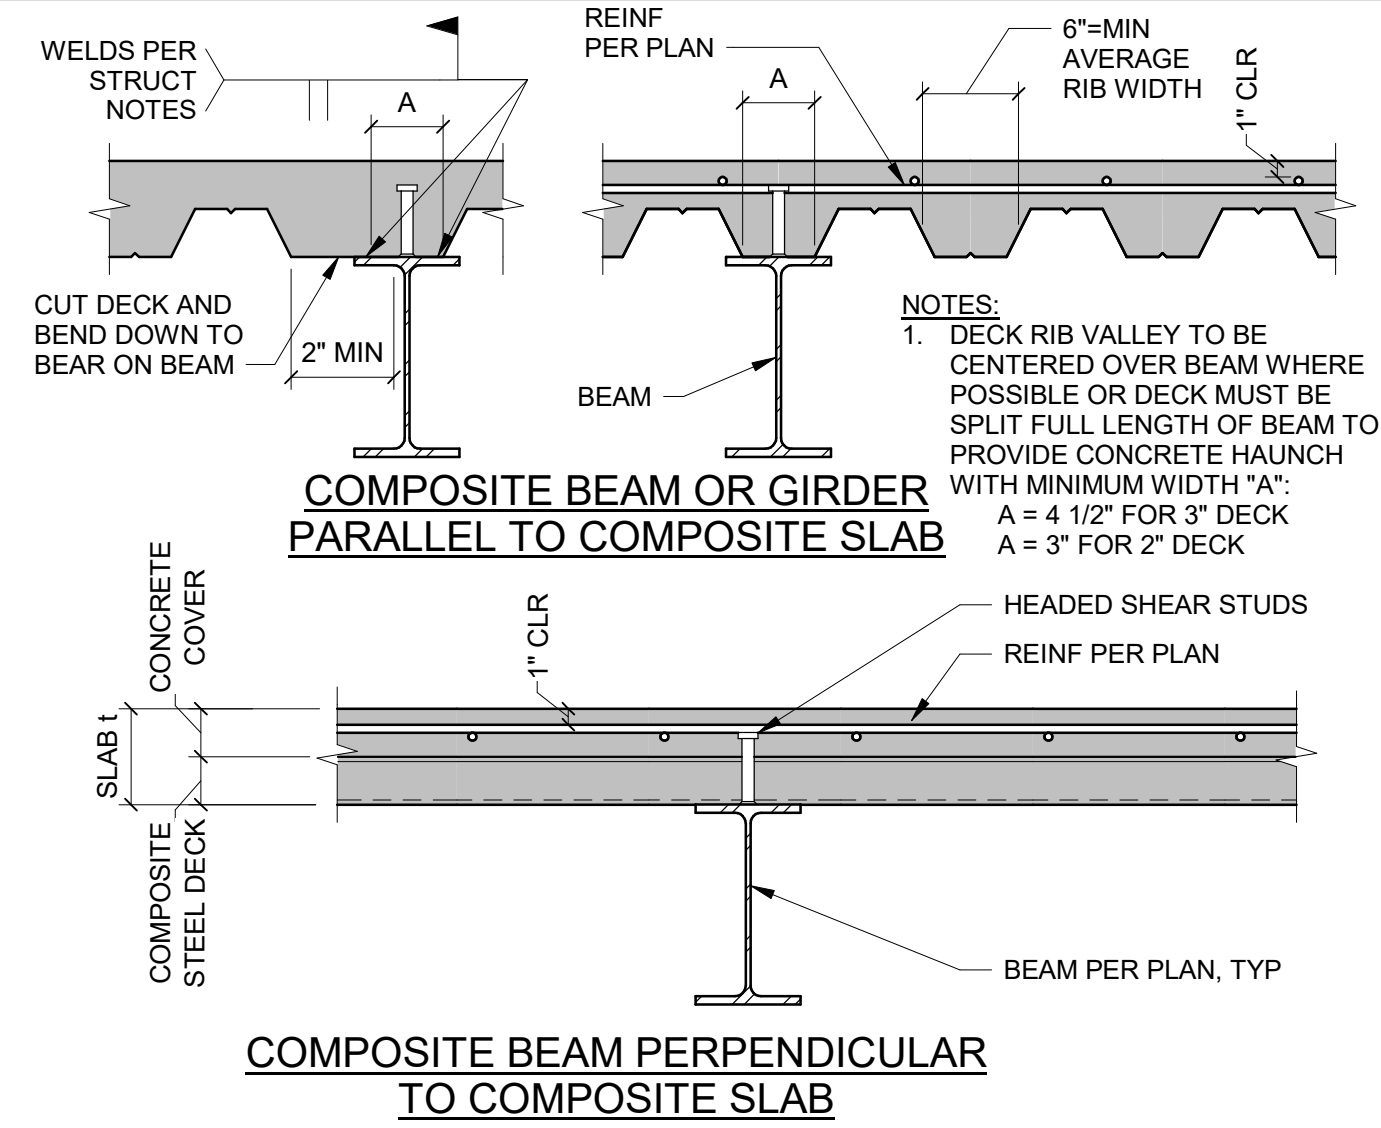


4 TYPICAL COMPOSITE BEAM TO COMPOSITE SLAB

NO SCALE

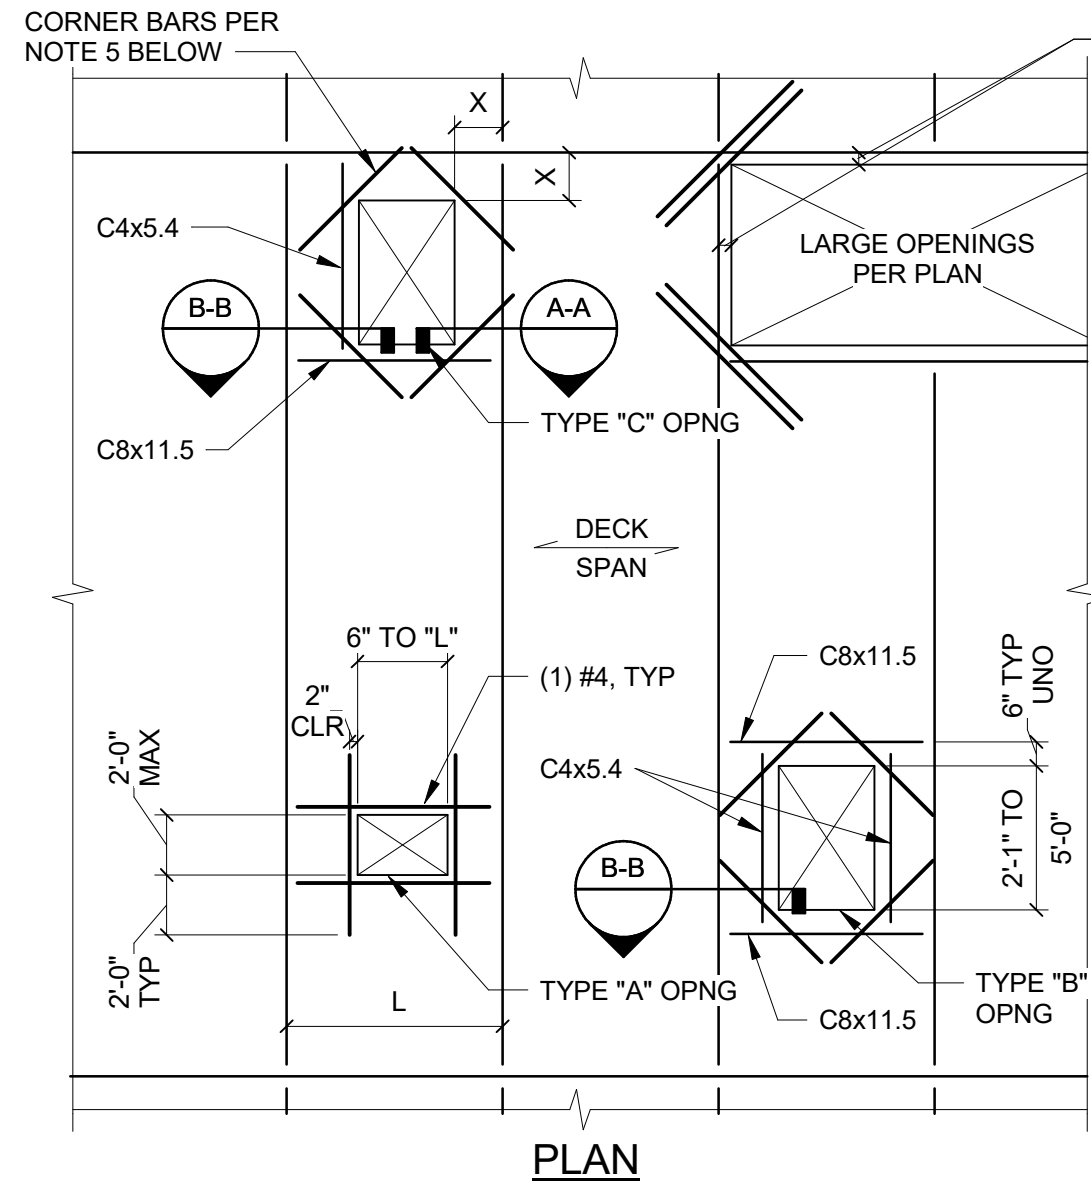

5 TYPICAL SLAB OPENINGS

NO SCALE

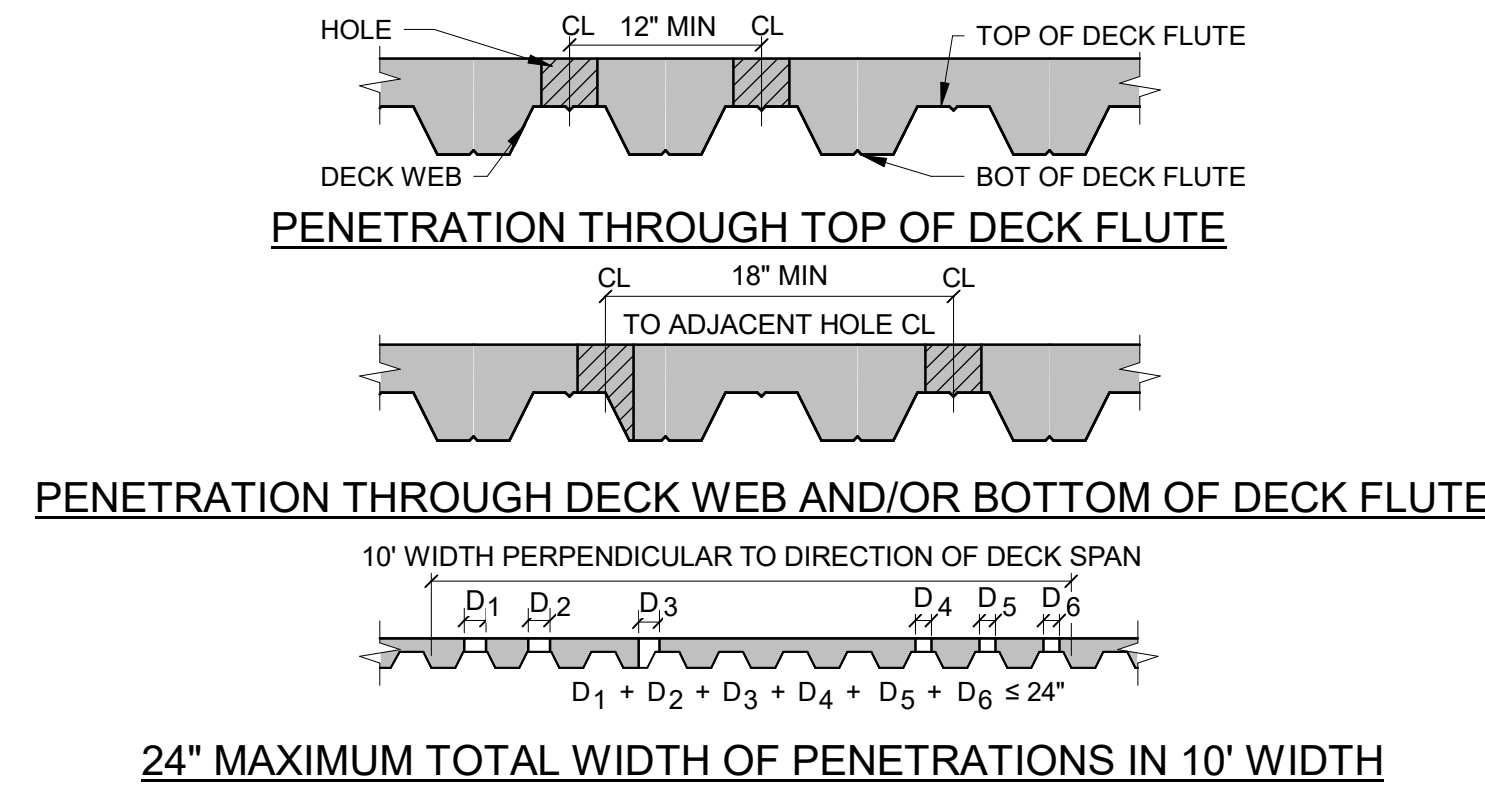


9 TYPICAL SLAB ON DECK PENETRATIONS

NO SCALE


SLAB THICKNESS	SLAB OVERHANG "B"							
	≤ 2"	≤ 4"	≤ 6"	≤ 8"	≤ 10"	≤ 12"	≤ 14"	≤ 16"
5 1/2"	18 GA	16 GA	14 GA	12 GA	10 GA	3/16"	1/4"	5/16"

- NOTES:
- CONNECTION ONLY TO BE USED FOR SLAB OVERHANG "B" ≤ 1'-6".
 - WELD EDGE FORM AS FOLLOWS:
18 GA & 16 GA MATERIAL = 1" @ 12" OC
14 GA & 12 GA MATERIAL = 1" @ 8" OC
10 GA & 3/16" MATERIAL = 2" @ 12" OC
1/4" & 5/16" MATERIAL = 2" @ 10" OC
 - PROVIDE HOOKED BAR AS FOLLOWS:
0'-0" < "B" ≤ 1'-0" (1) #4 x ☐ @ 12" OC
1'-0" < "B" ≤ 1'-6" (2) #4 x ☐ @ 12" OC

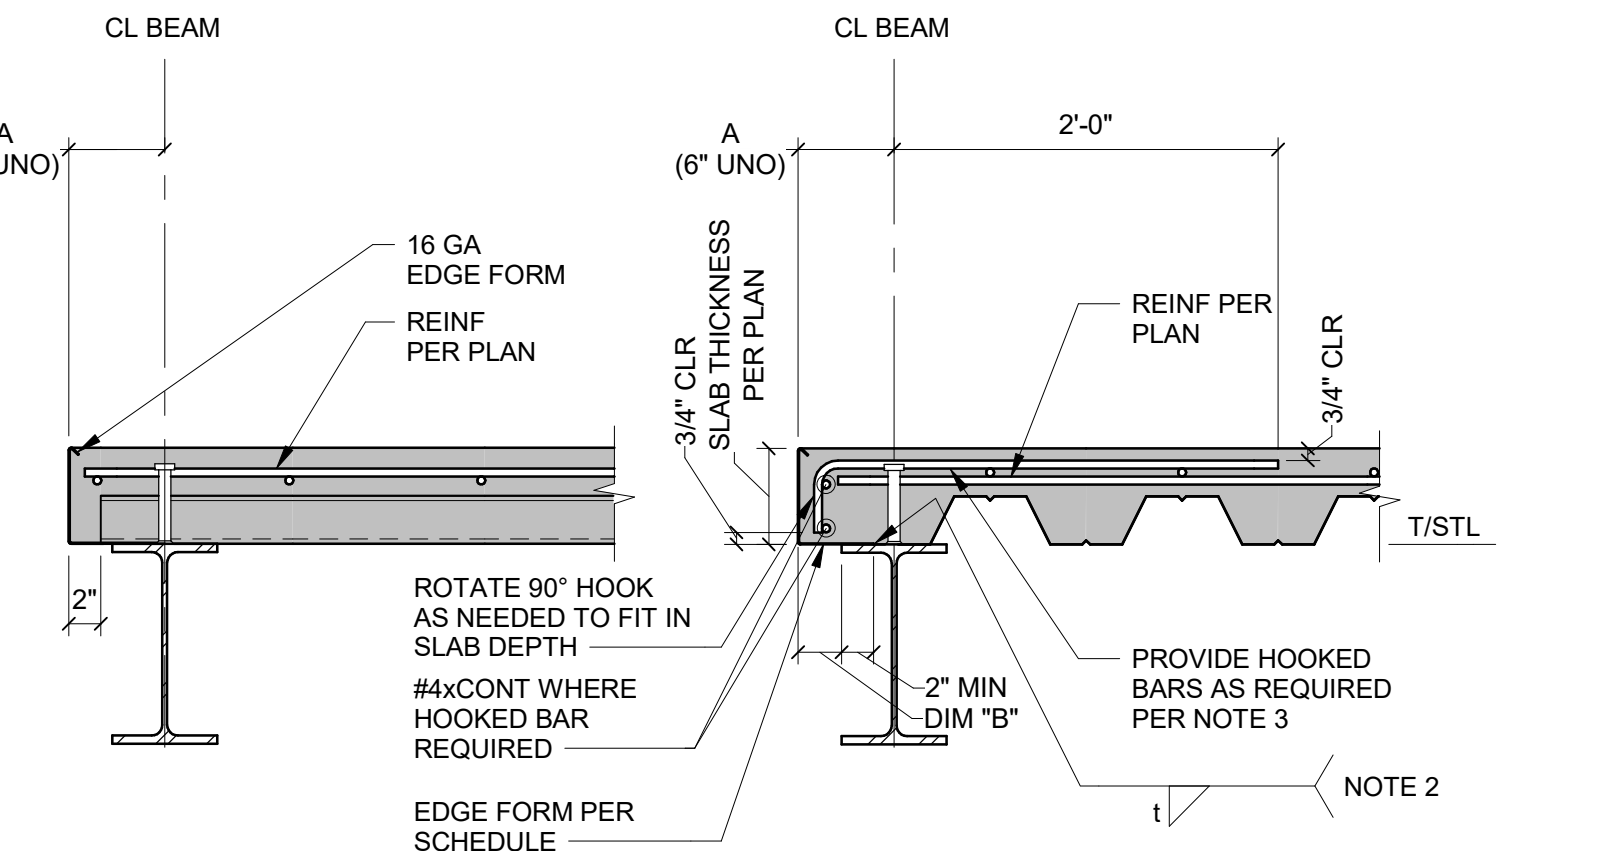

7 TYPICAL SLAB EDGE AT INTERIOR OPENING

NO SCALE

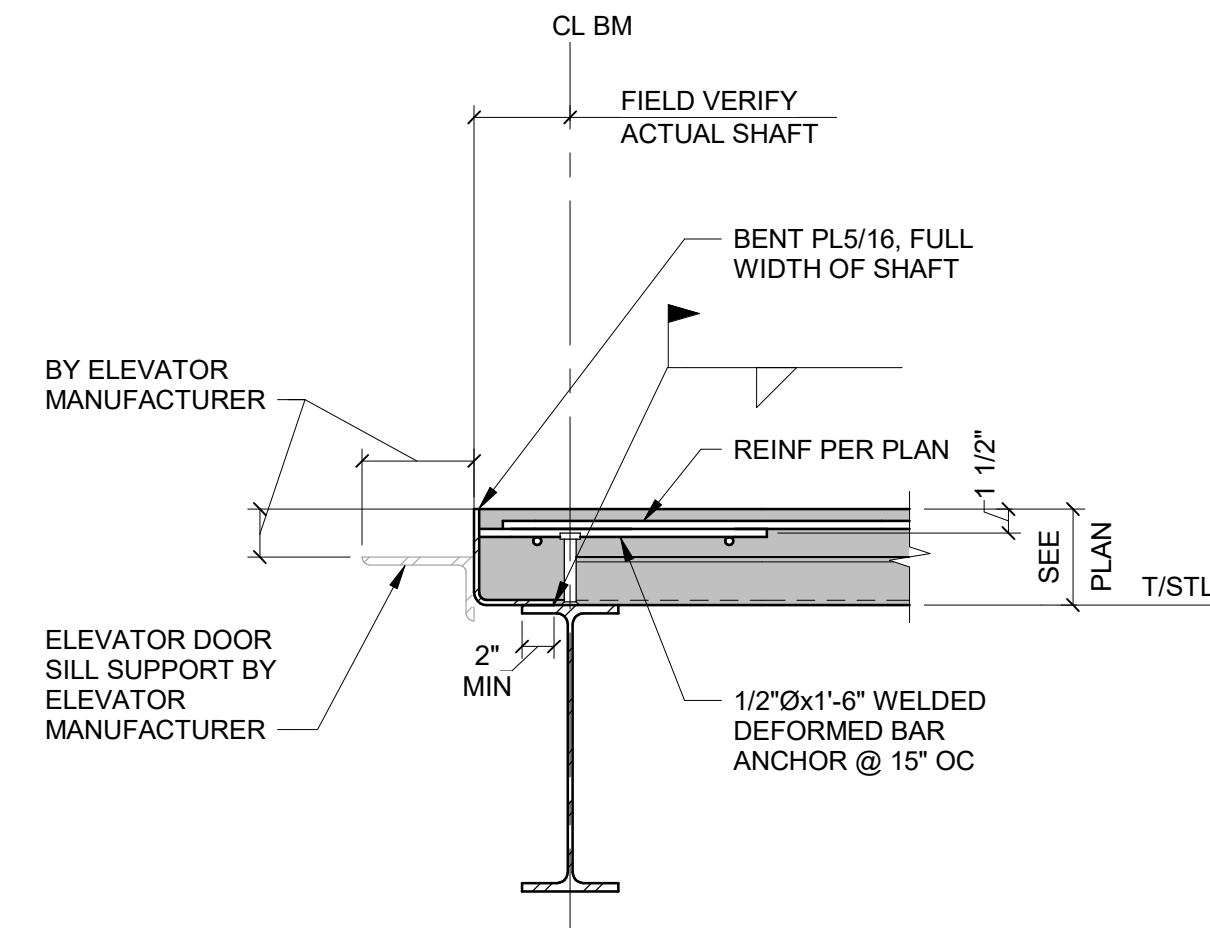

12 SLAB EDGE AT ELEVATOR DOOR SILLS

NO SCALE

tgba

t 425.778.1530 21911 76th Ave W, Ste 210
f 425.774.7803 Edmonds WA 98026
info@tgbaarchitects.com
www.tgbaarchitects.com

kpff

1601 5th Avenue, Suite 1600
Seattle, WA 98101

206.622.5822
www.kpff.com

TULALIP TRIBES GATHERING HALL

7512 TOTEM BEACH RD
TULALIP, WA 98271

PHASE 2 - BUILDING AND LANDSCAPING

TYPICAL STEEL DETAILS

ISSUANCE		
No.	Description	Date
	PHASE 2 PERMIT SET	08/20/18
	PHASE 2 BID SET	10/08/18
	PHASE 2 CONSTRUCTION SET	03/13/19
5	PH 2 RECORD SET	06/02/20


PROJECT INFORMATION
PROJECT NUMBER: 17031
PROJECT LEAD: GMH
DRAWN BY: BLE


SHEET NO

S5.02



















8 TYP STEEL COLUMN BASE DETAIL
NO SCALE

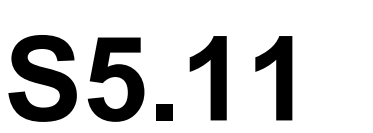

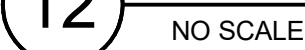[illegible]

PROJECT INFORMATION	
PROJECT NUMBER:	17031
PROJECT LEAD:	Designer
DRAWN BY:	Author

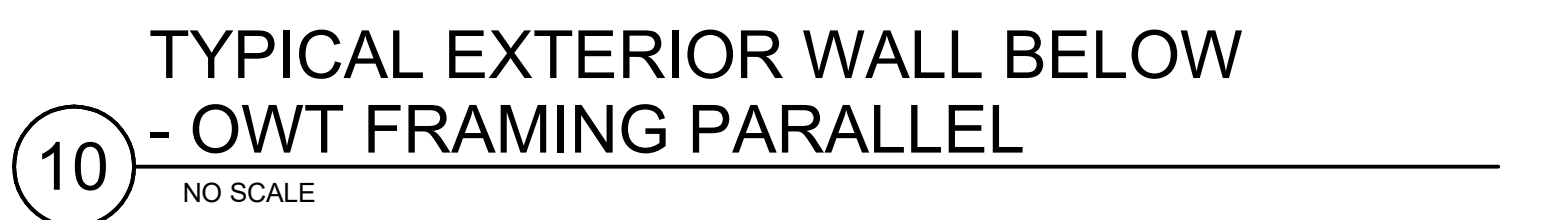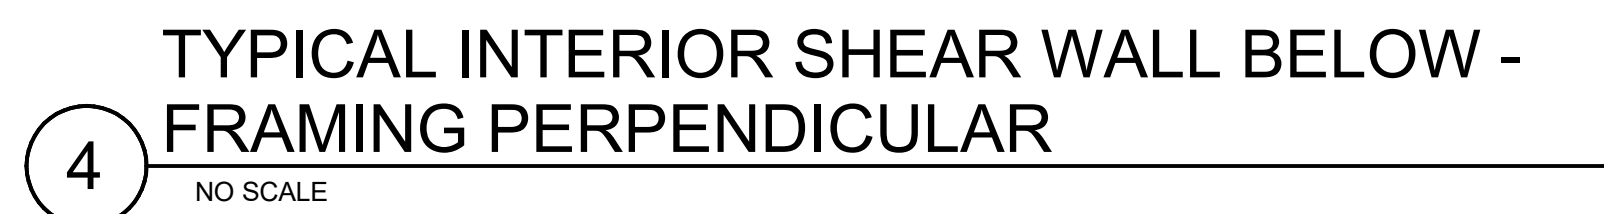

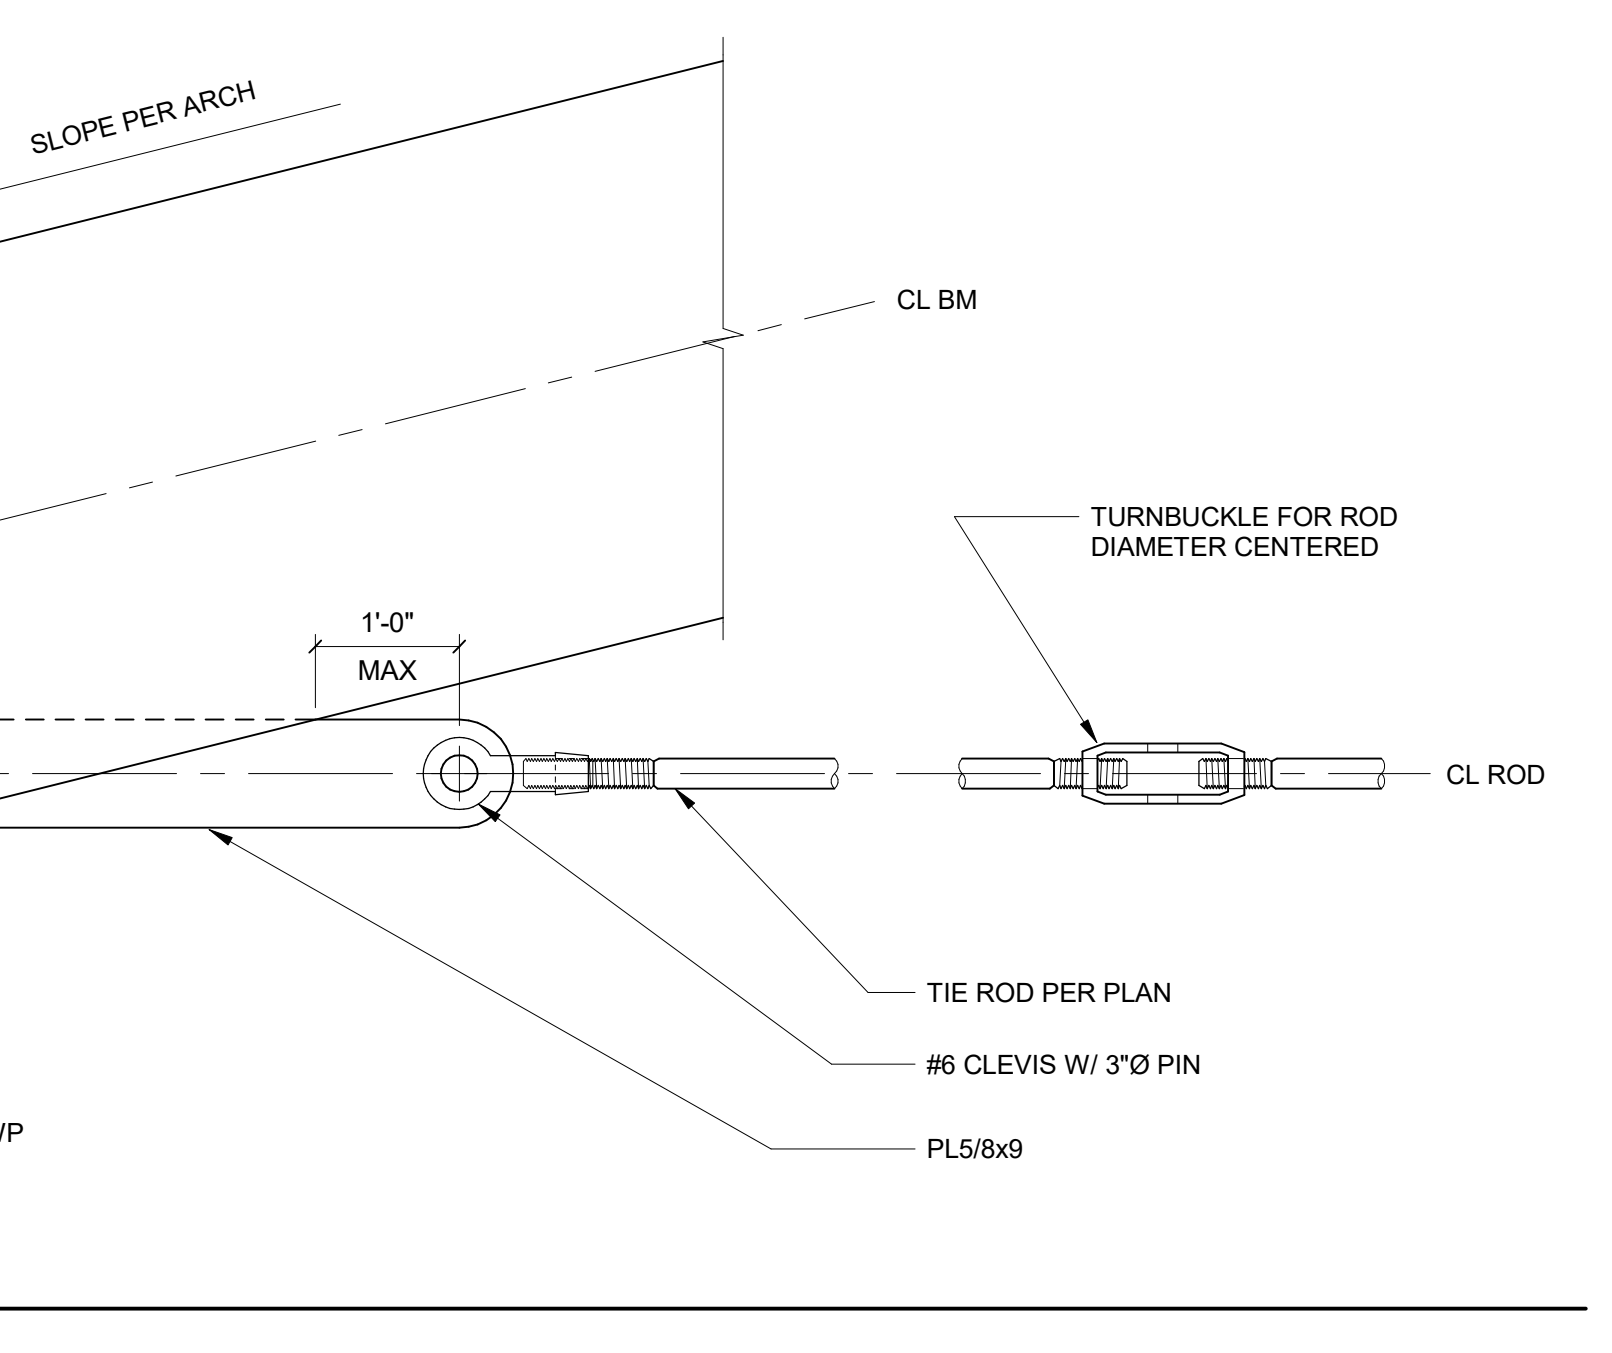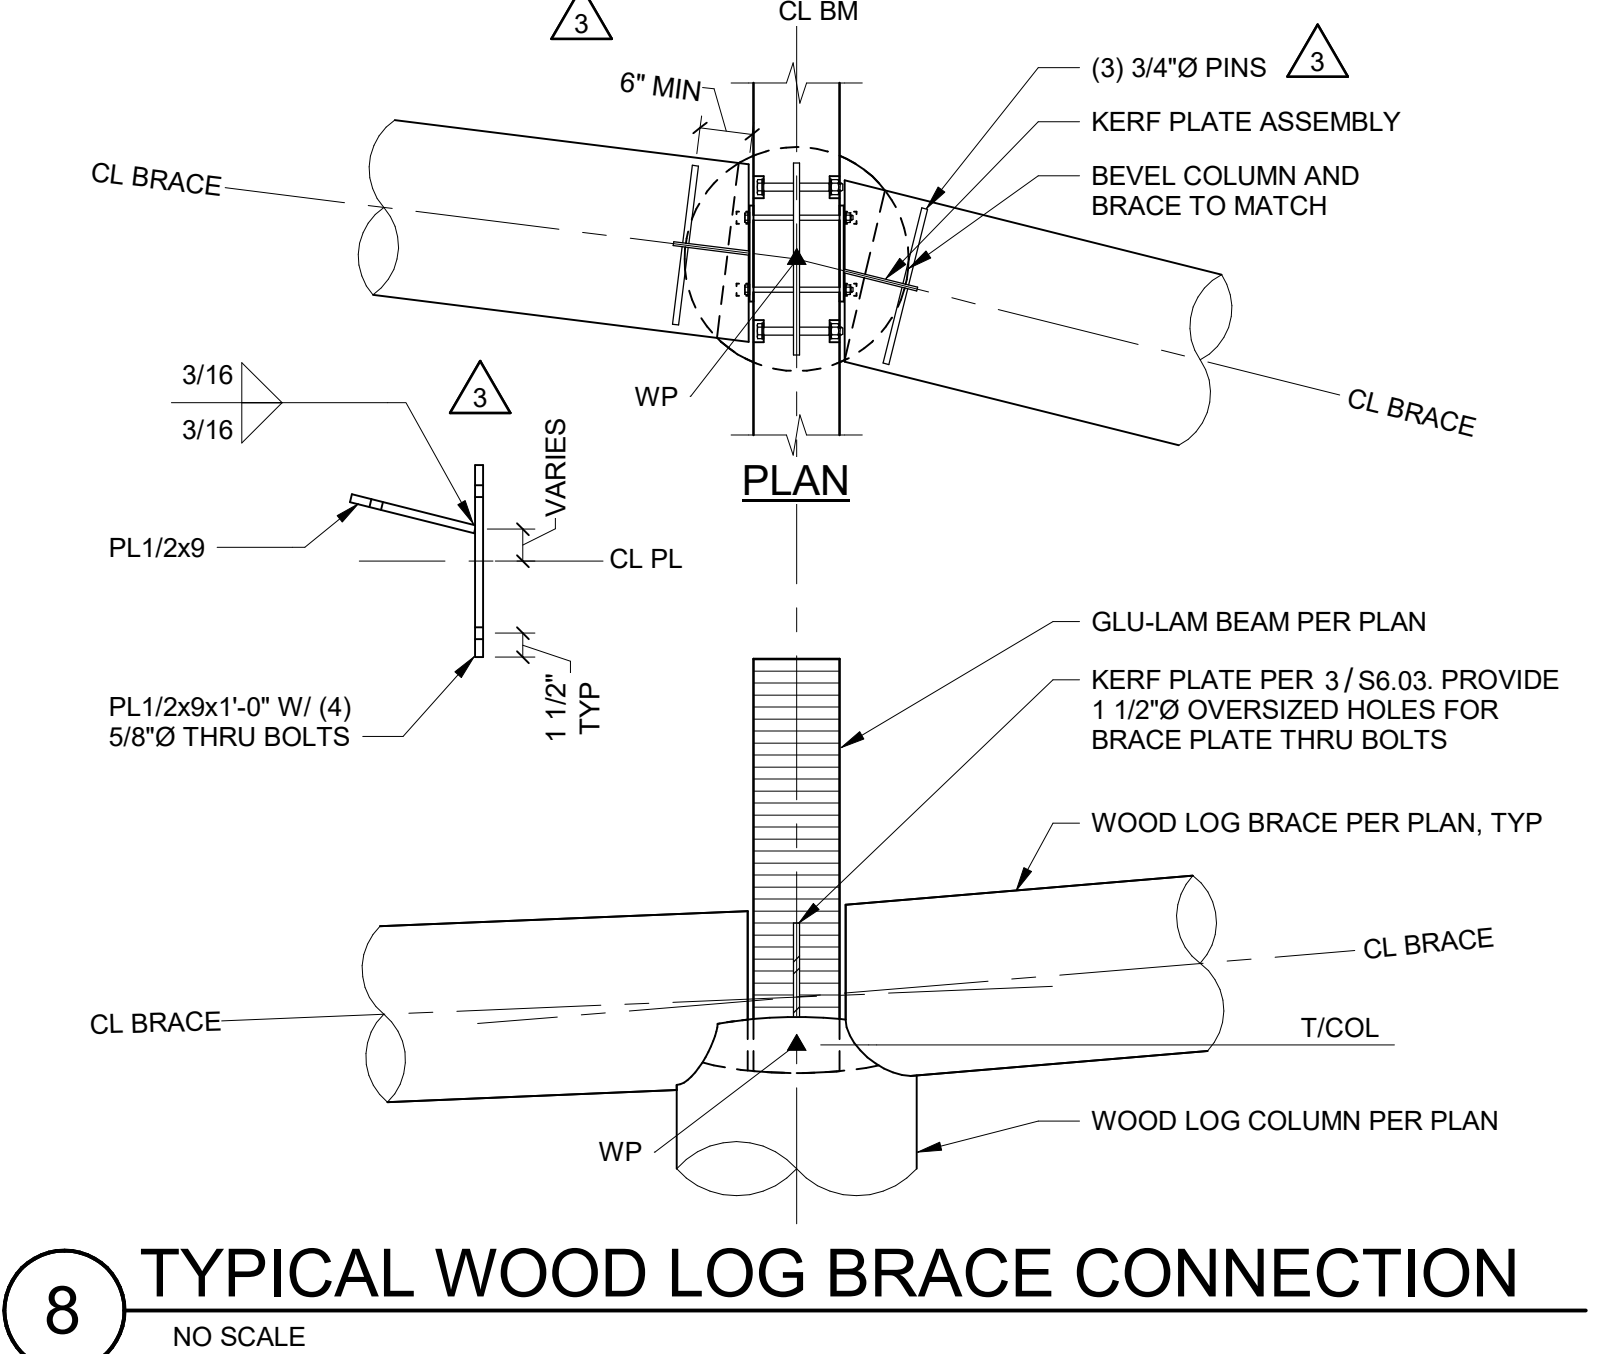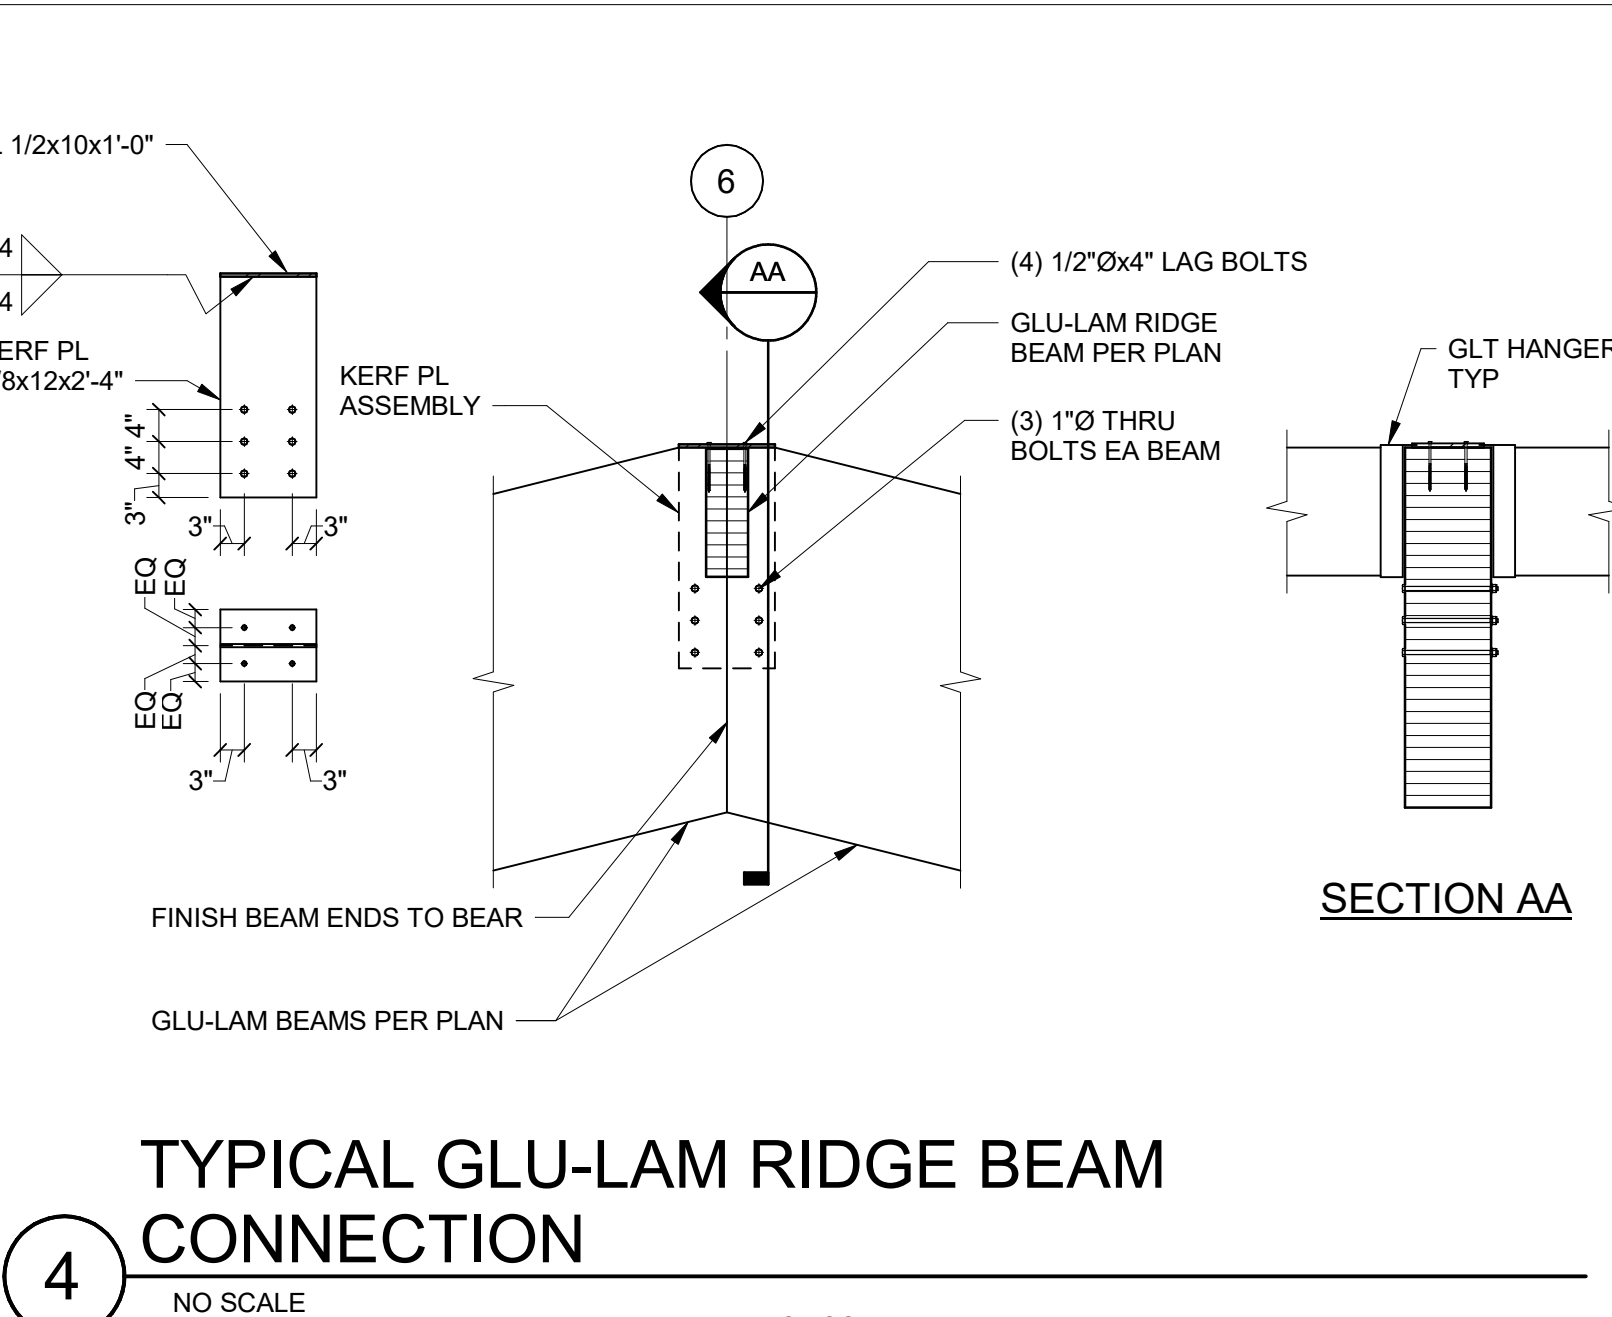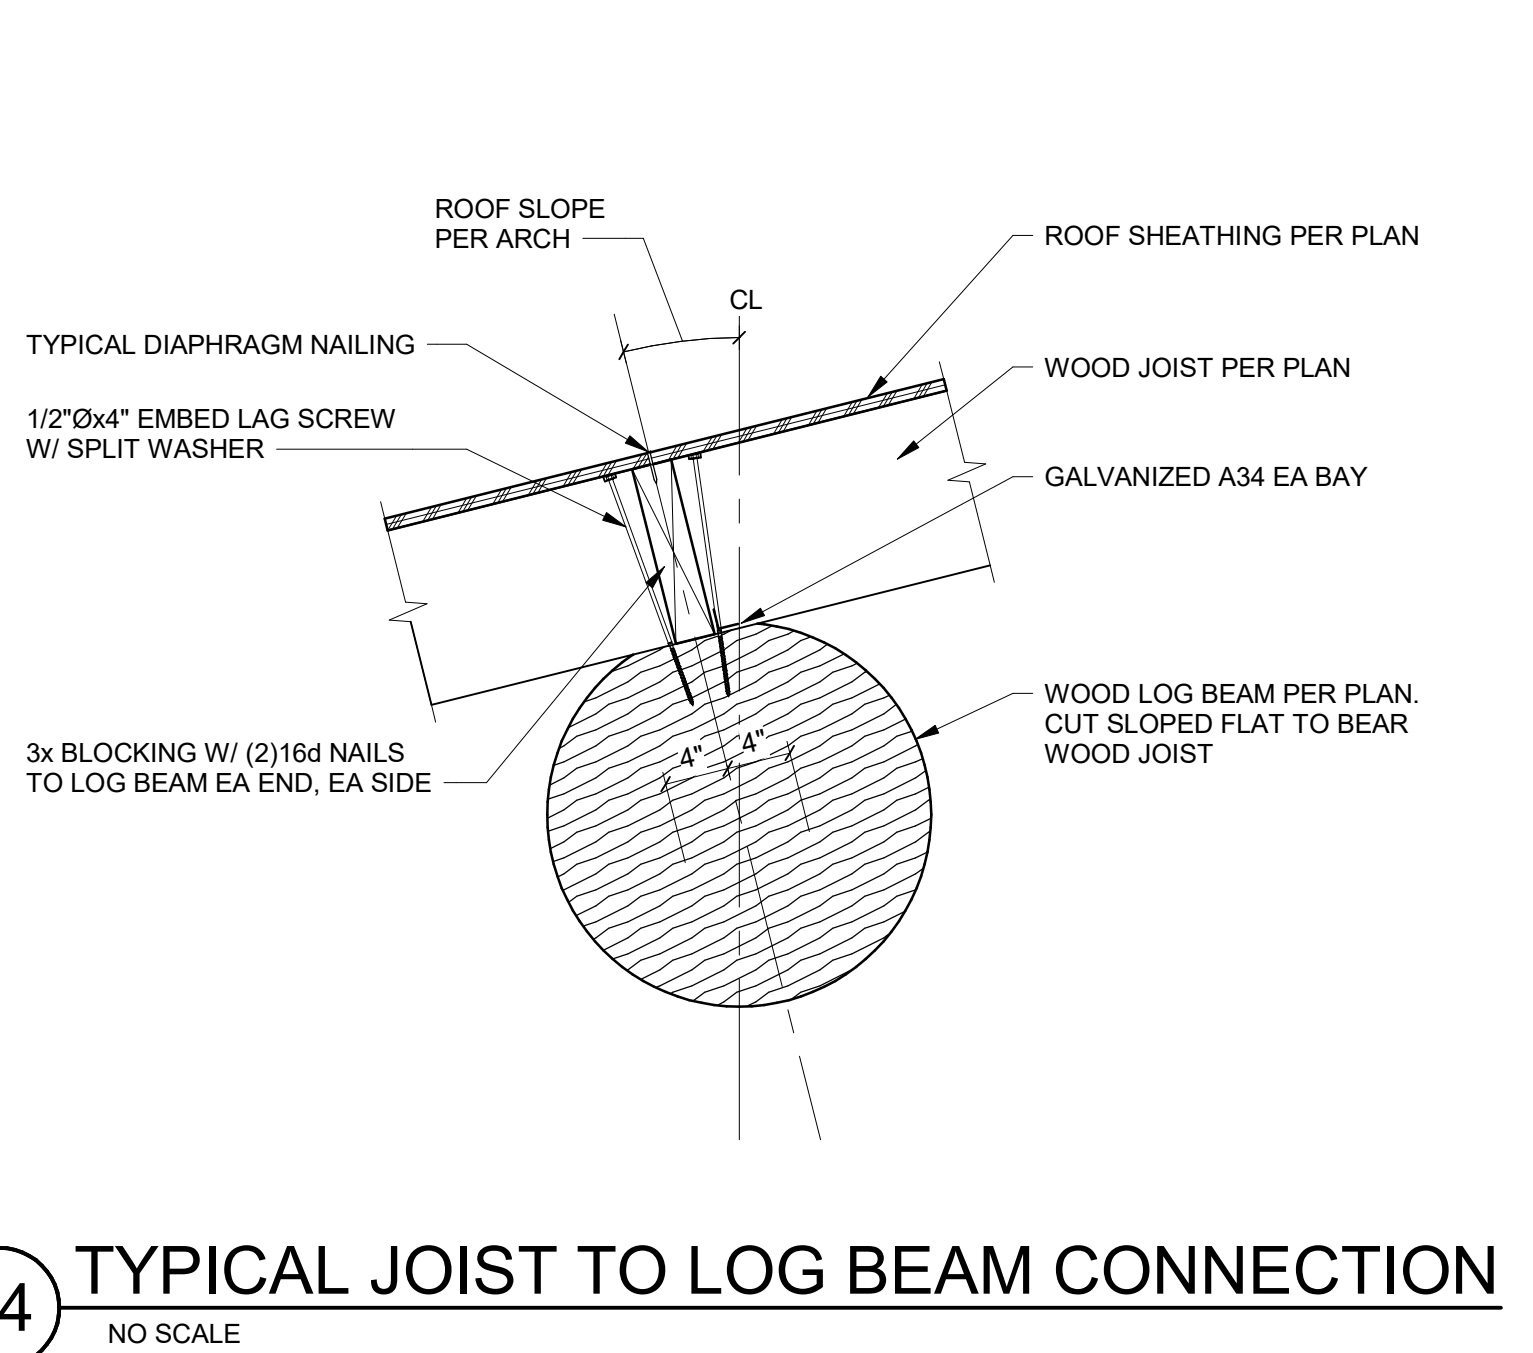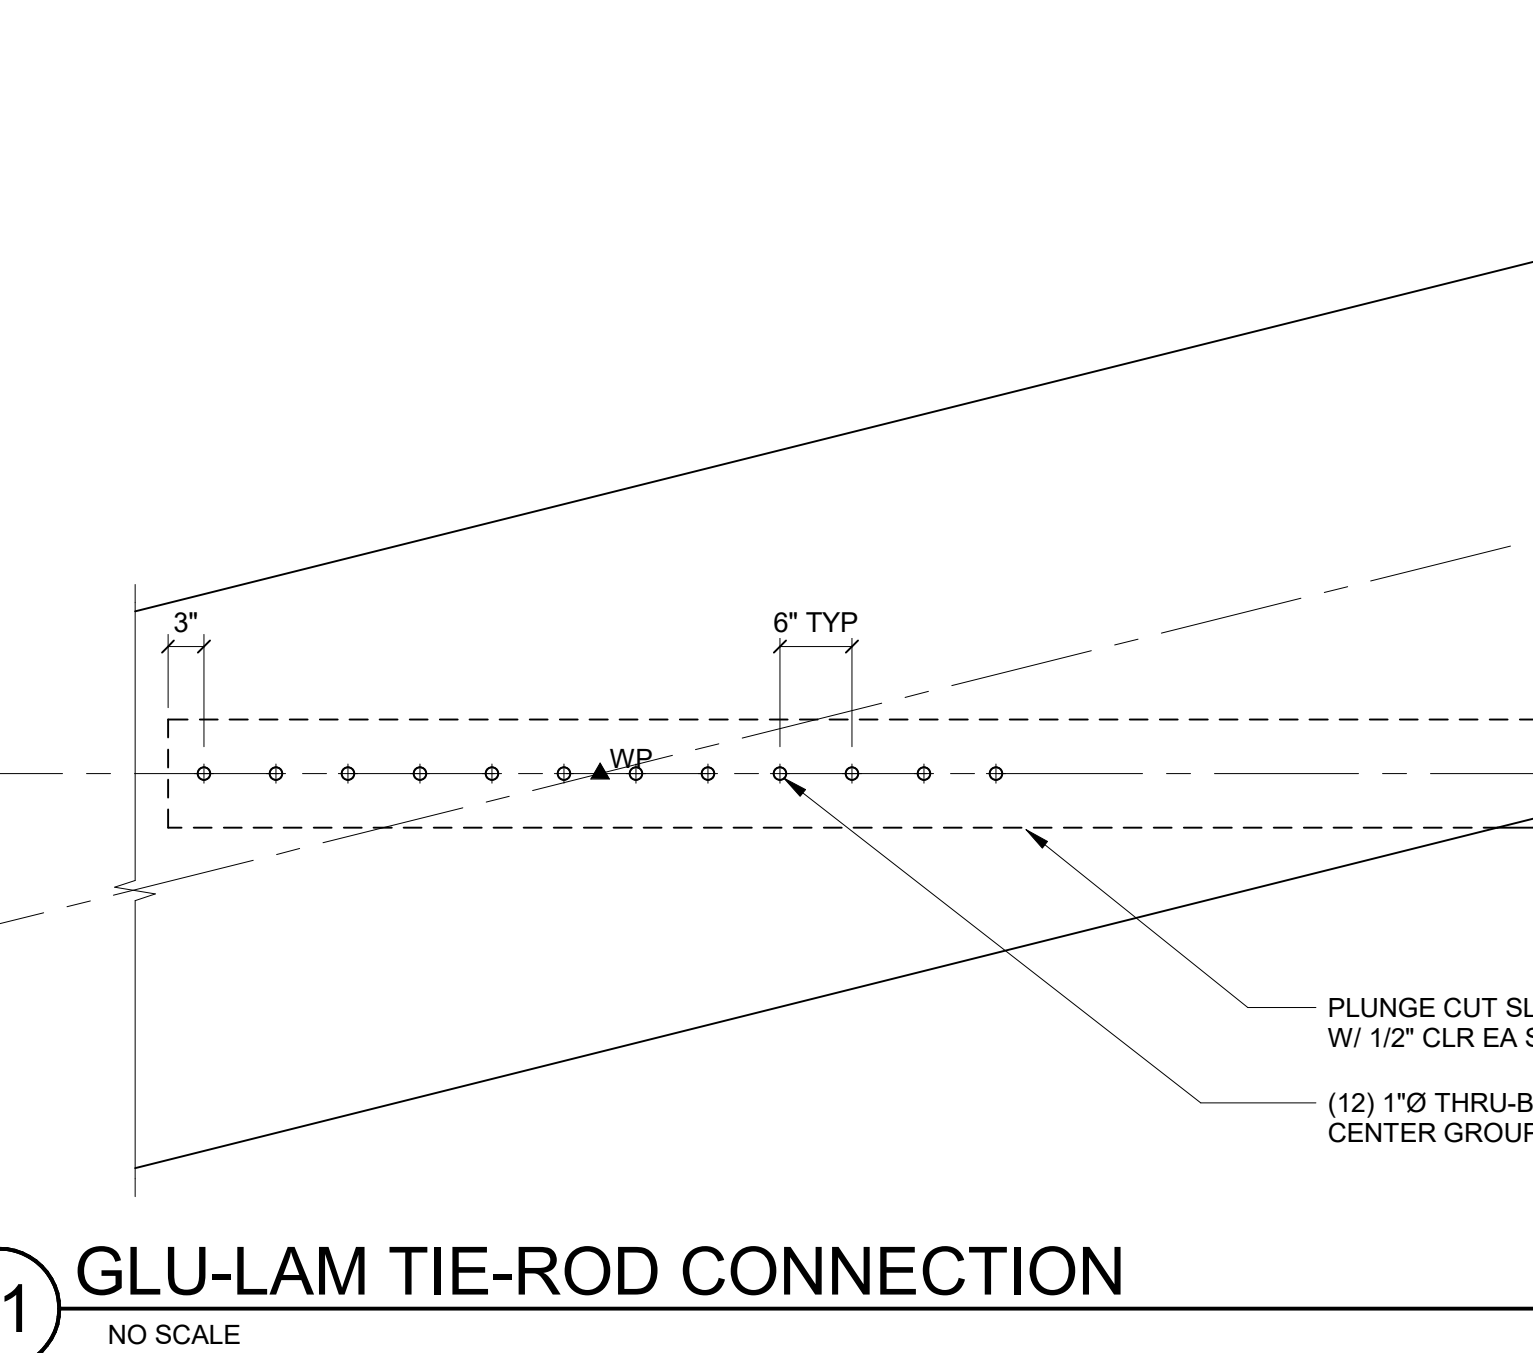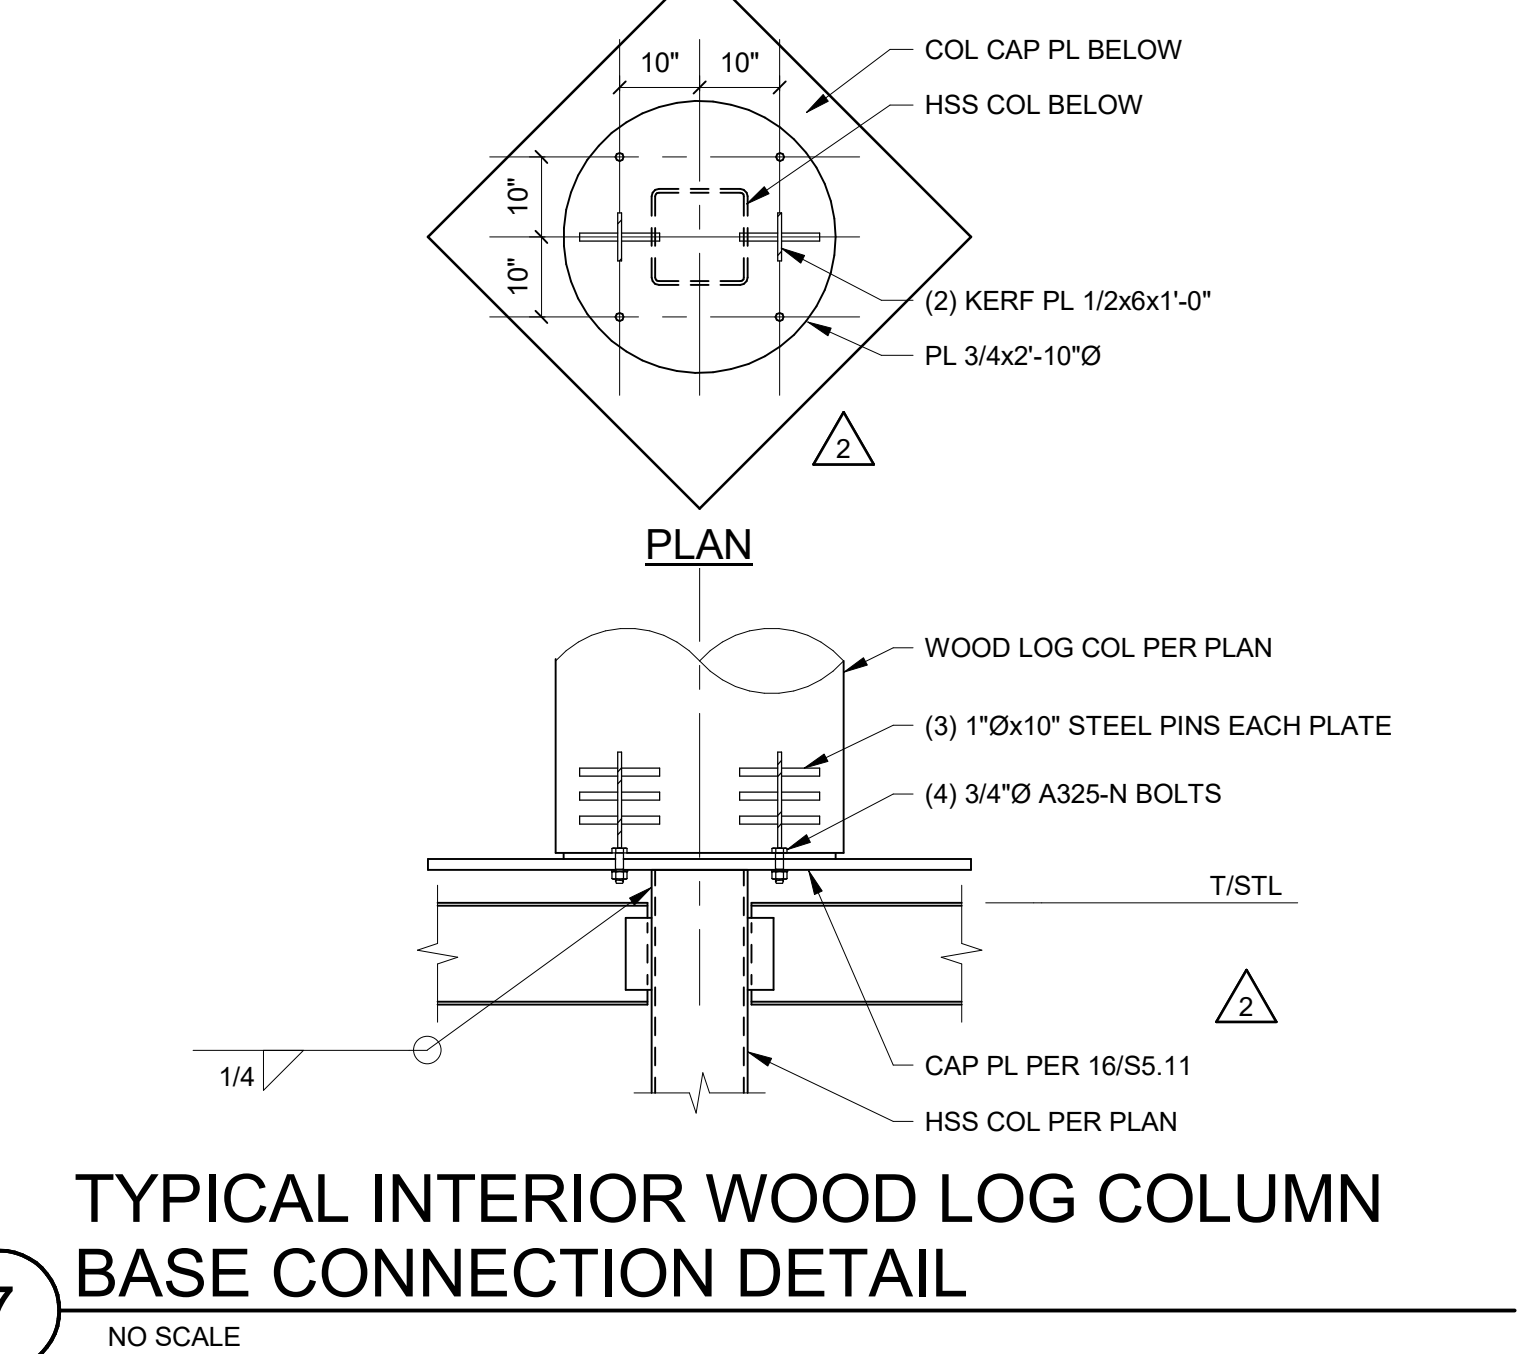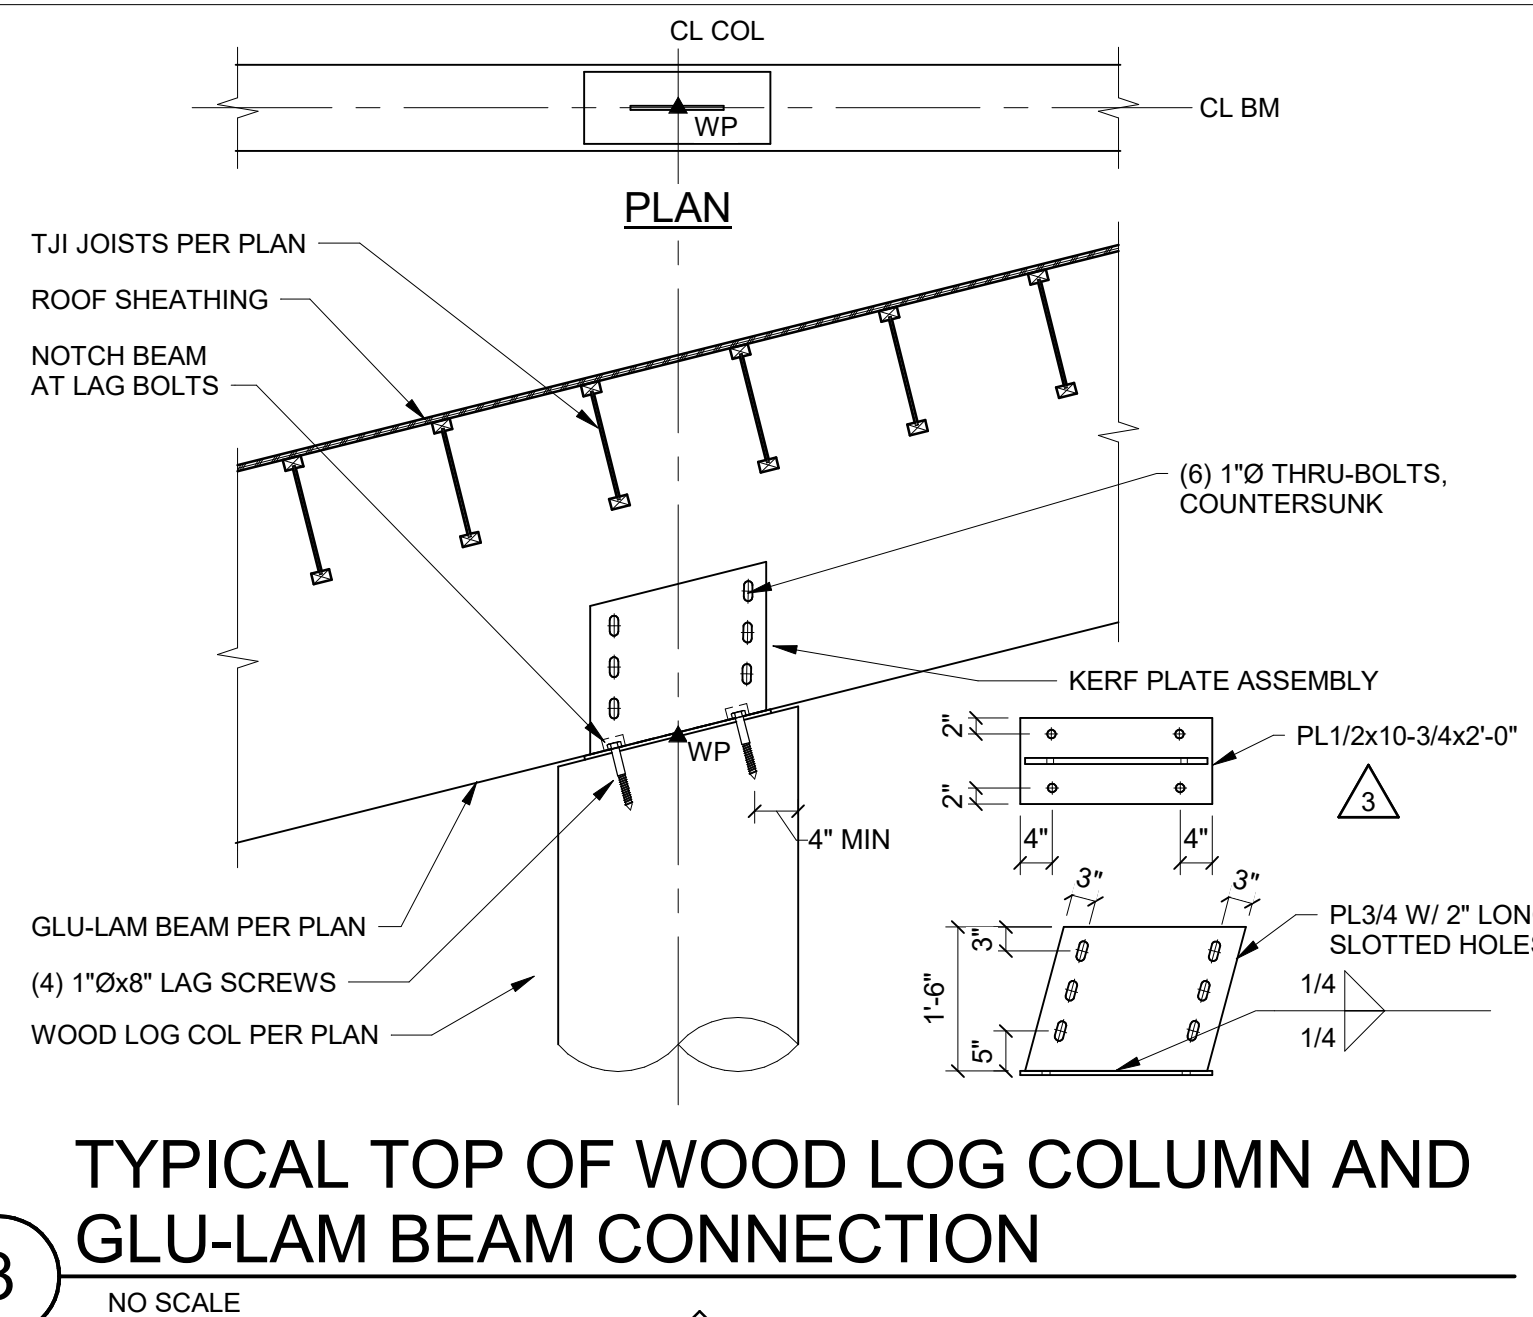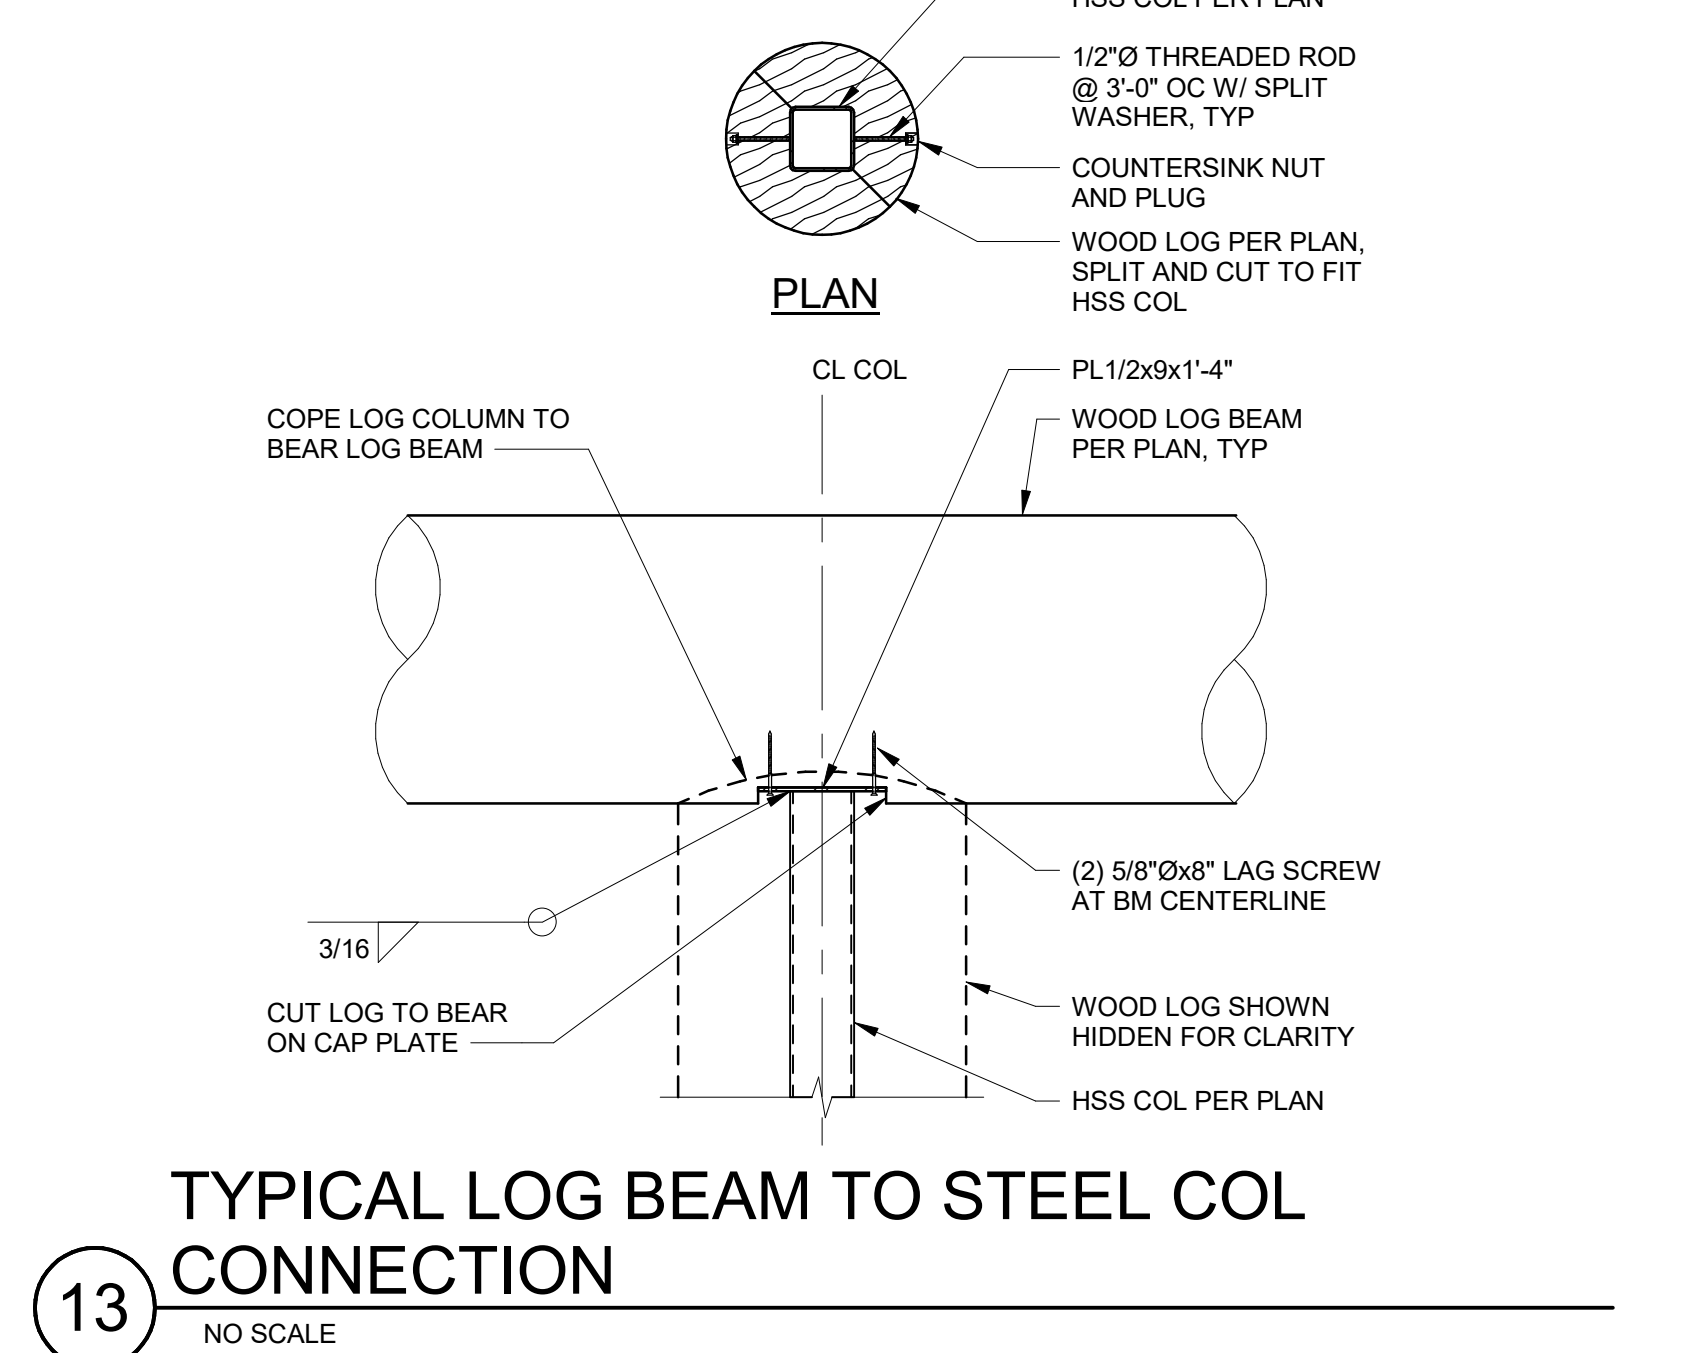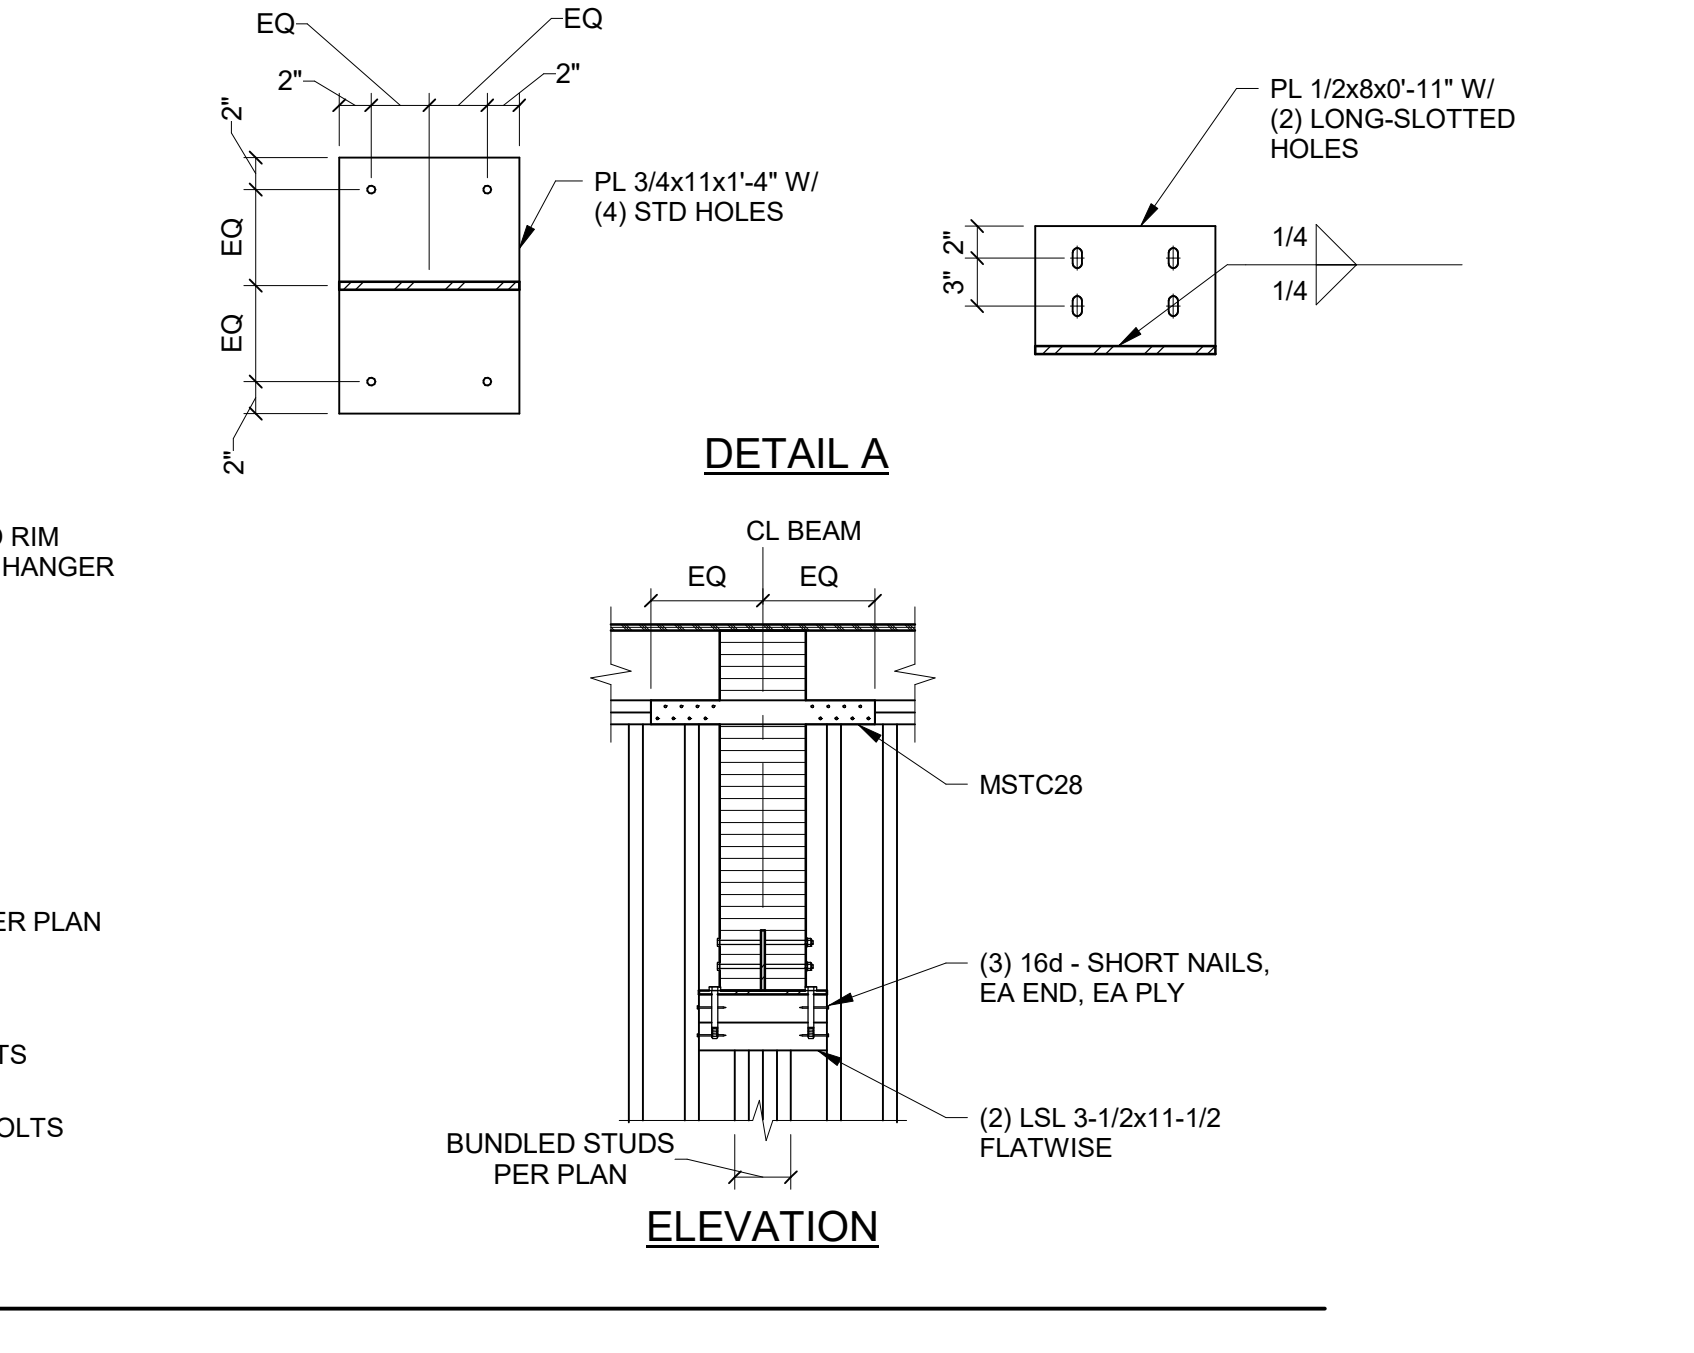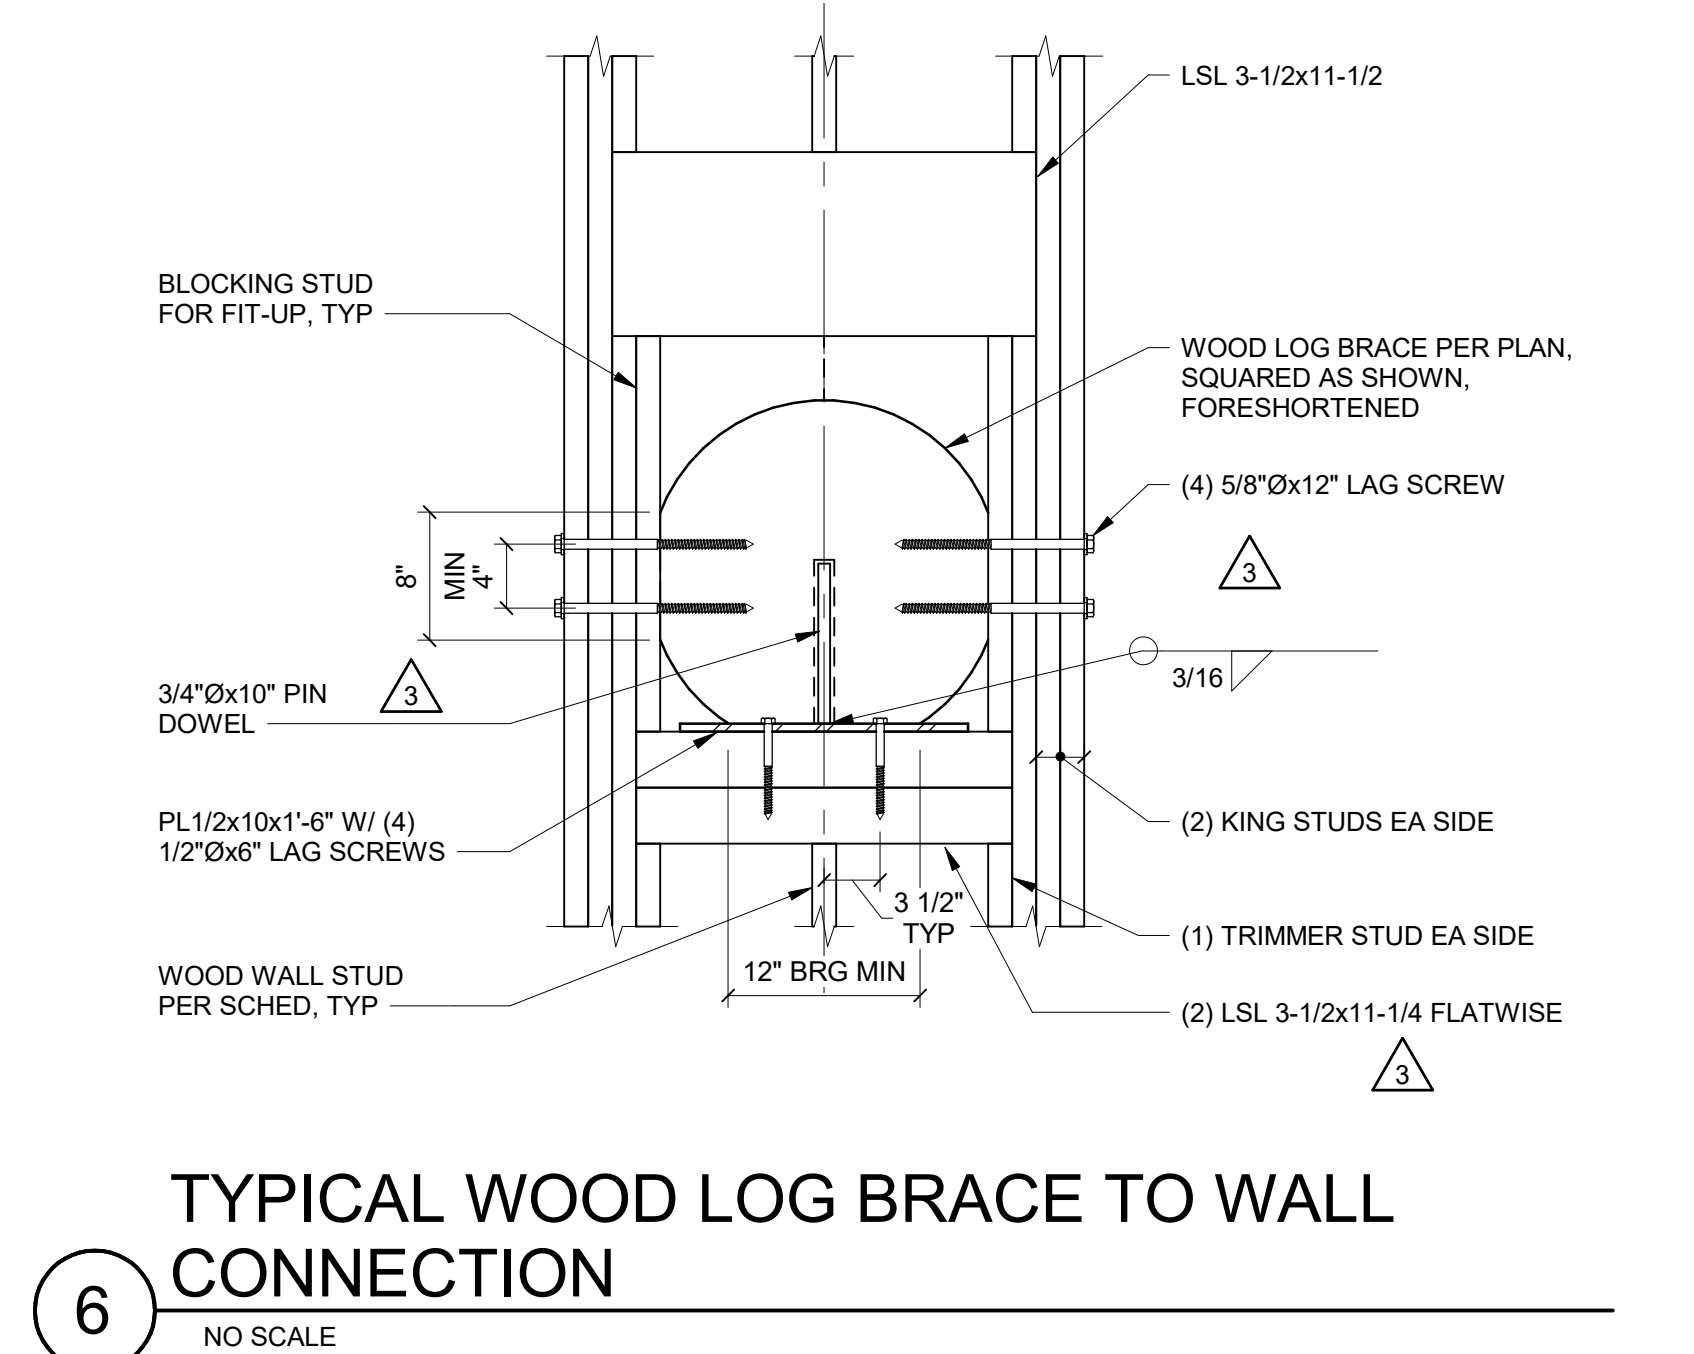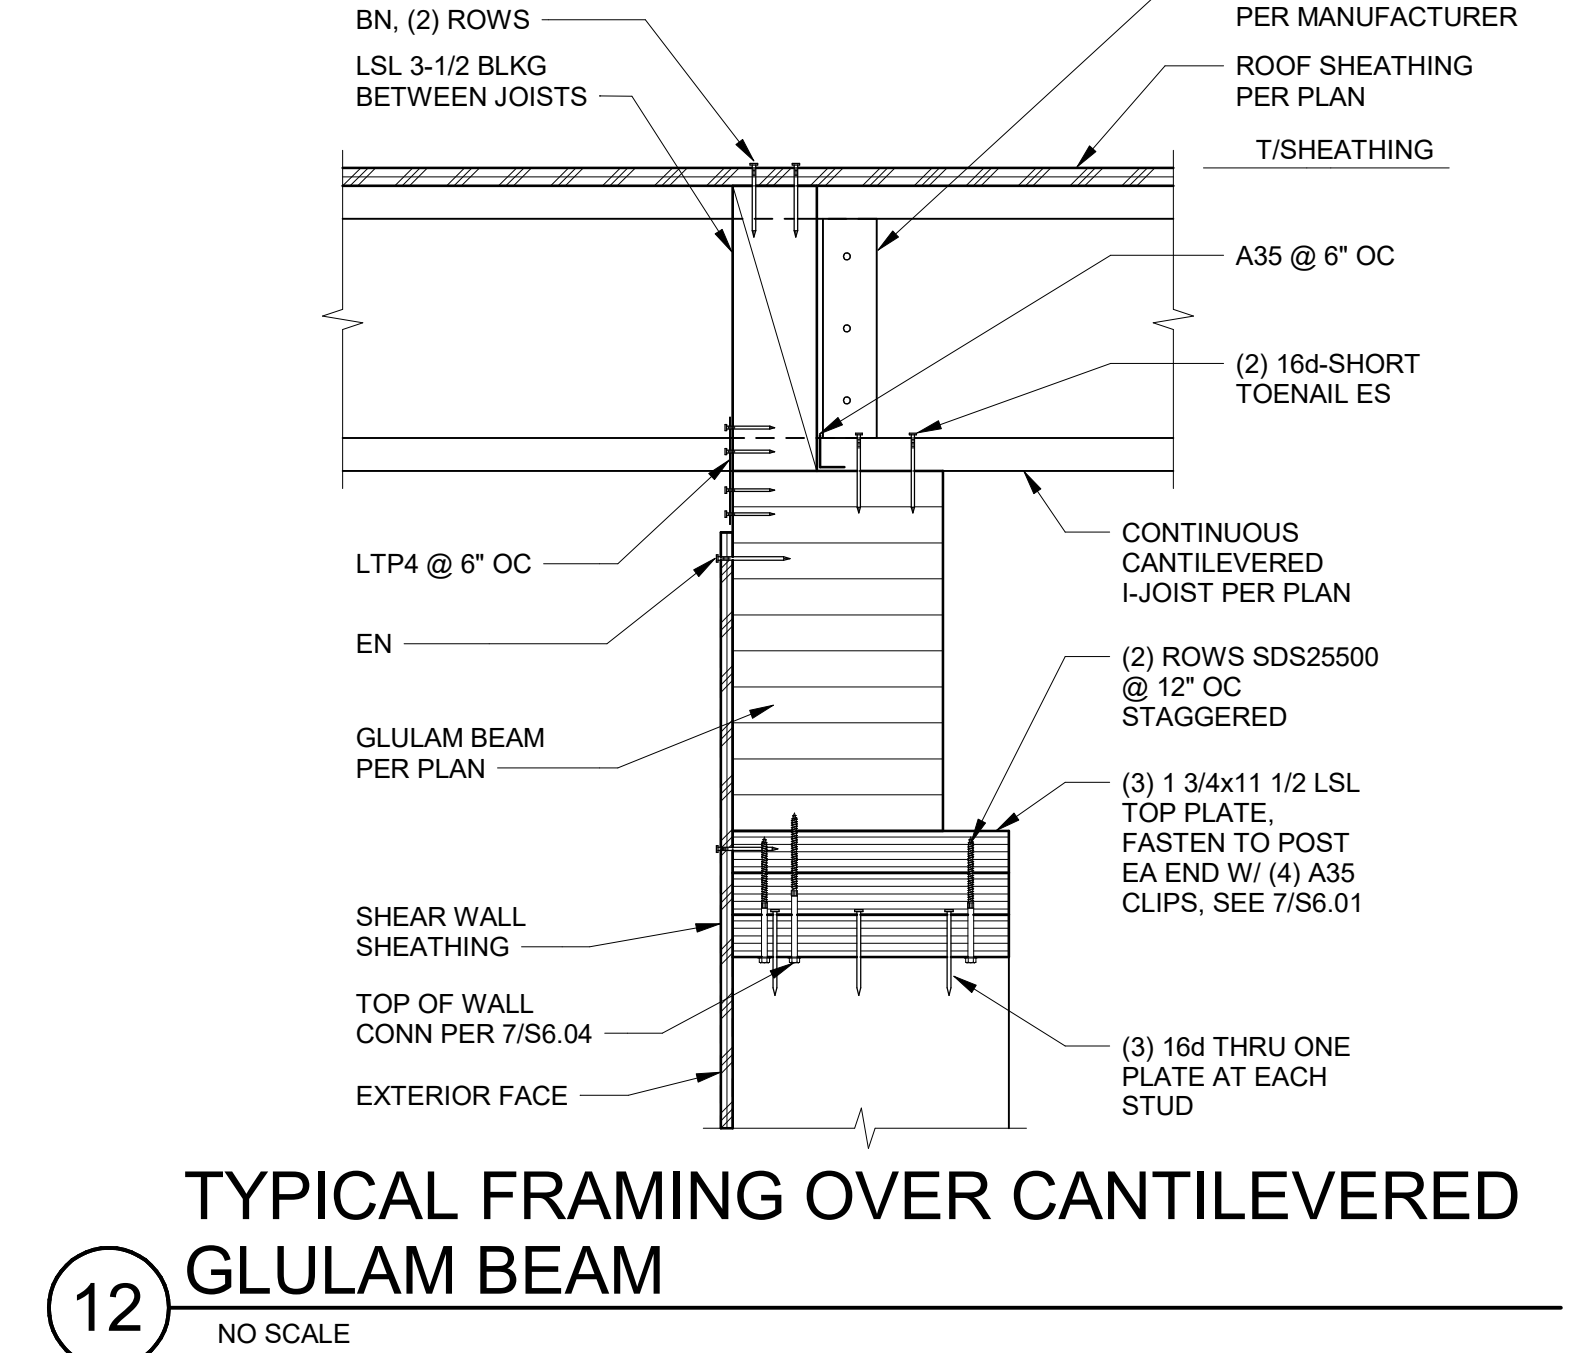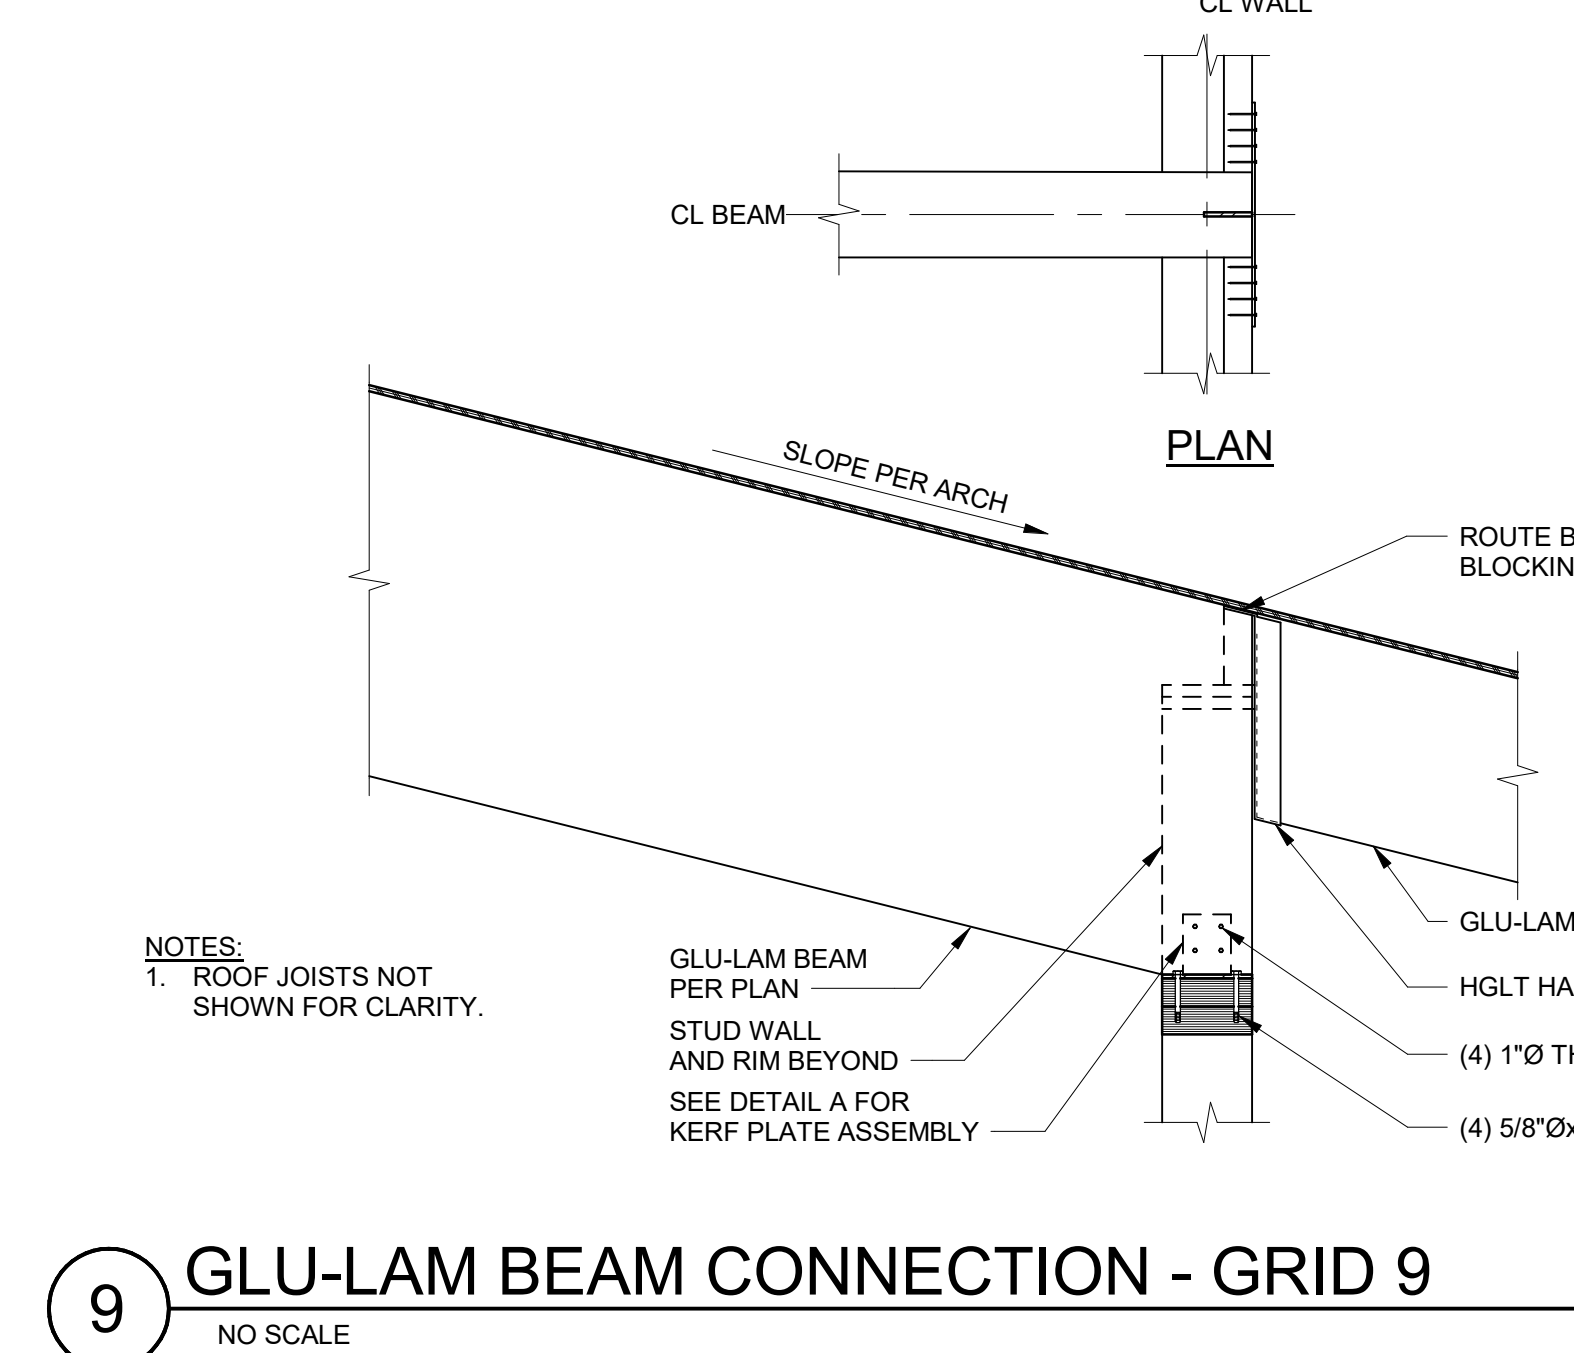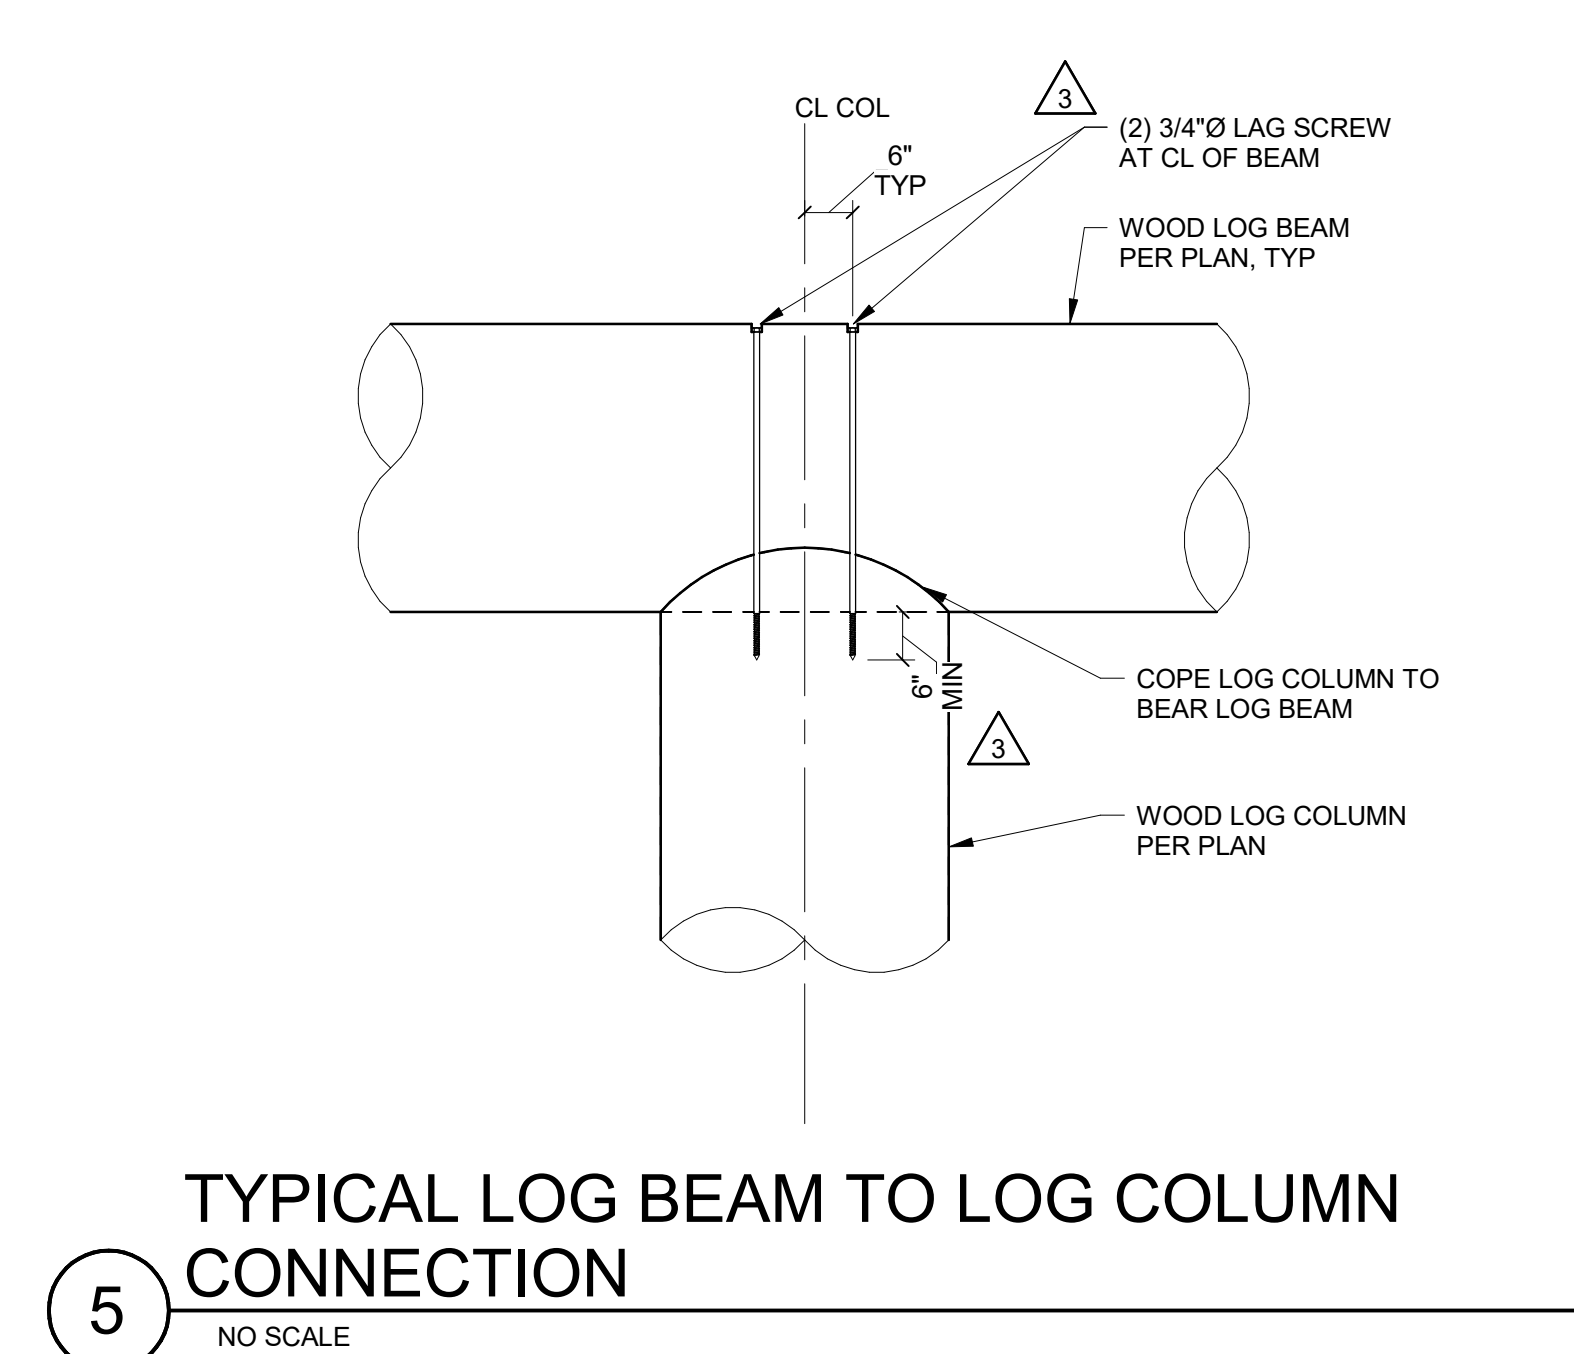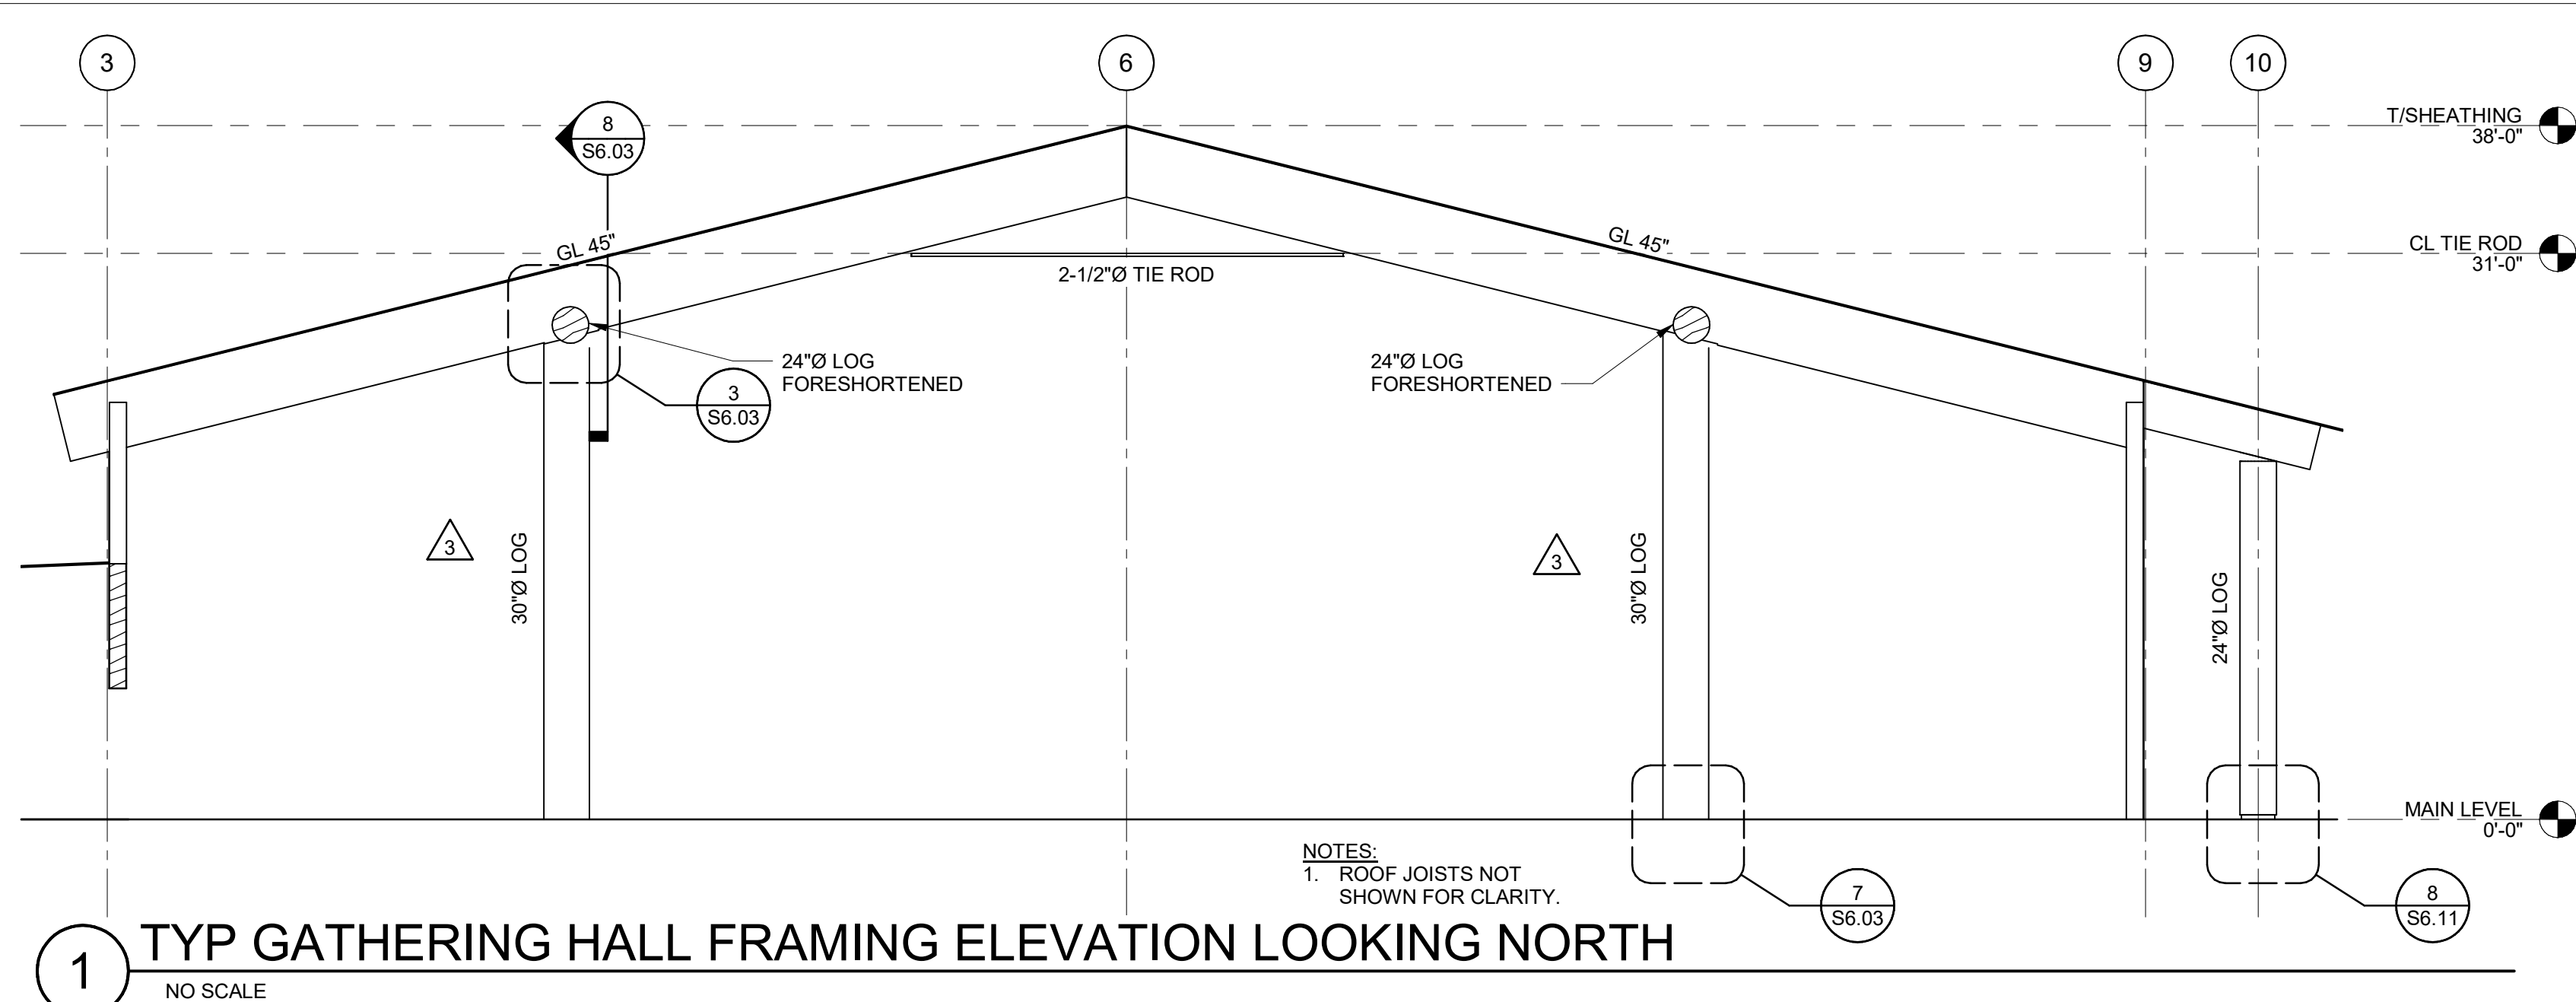

ISSUANCE		
No.	Description	Date
1	PHASE 2 PERMIT SET	08/20/18
2	PHASE 2 BID SET	10/08/18
3	ADDENDUM 3	11/14/18
4	PHASE 2 CONSTRUCTION SET	03/13/19
5	PHASE 2 CCD #2	04/30/19
6	PHASE 2 ASI 1	05/22/19
7	PH 2 RECORD SET	06/02/20

PROJECT INFORMATION	
PROJECT NUMBER:	17031
PROJECT LEAD:	Designer
DRAWN BY:	Author




INDICATES HOLD-DOWN ANCHOR PER 12/50.04

SW-6

SHEAR WALL TYPE MARK PER SCHEDULE. PLACE SHEATHING ON SAME SIDE AS TYPE MARK


SHEAR WALL LEGEND

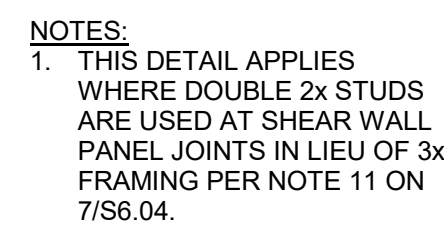

NOTES:

1. WHERE COMPRESSION POST DOES NOT SPECIFY SIZE OR GRADE MATCH WALL STUD SIZE AND GRADE.
2. THREADED ROD IS EXISTING, EMBEDDED IN EXISTING CONCRETE.




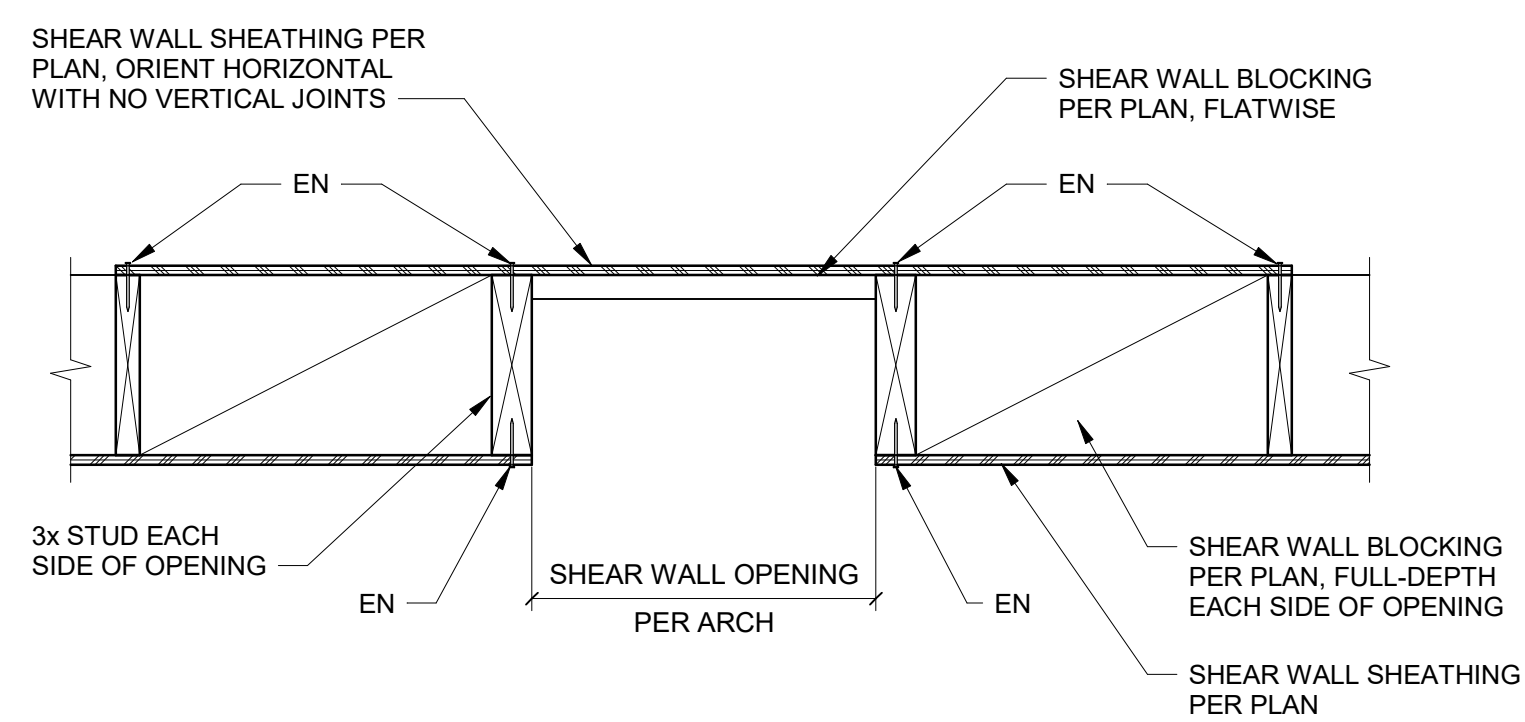


4

2 SHEAR WALL OPENING DETAIL


1" = 1'-0"

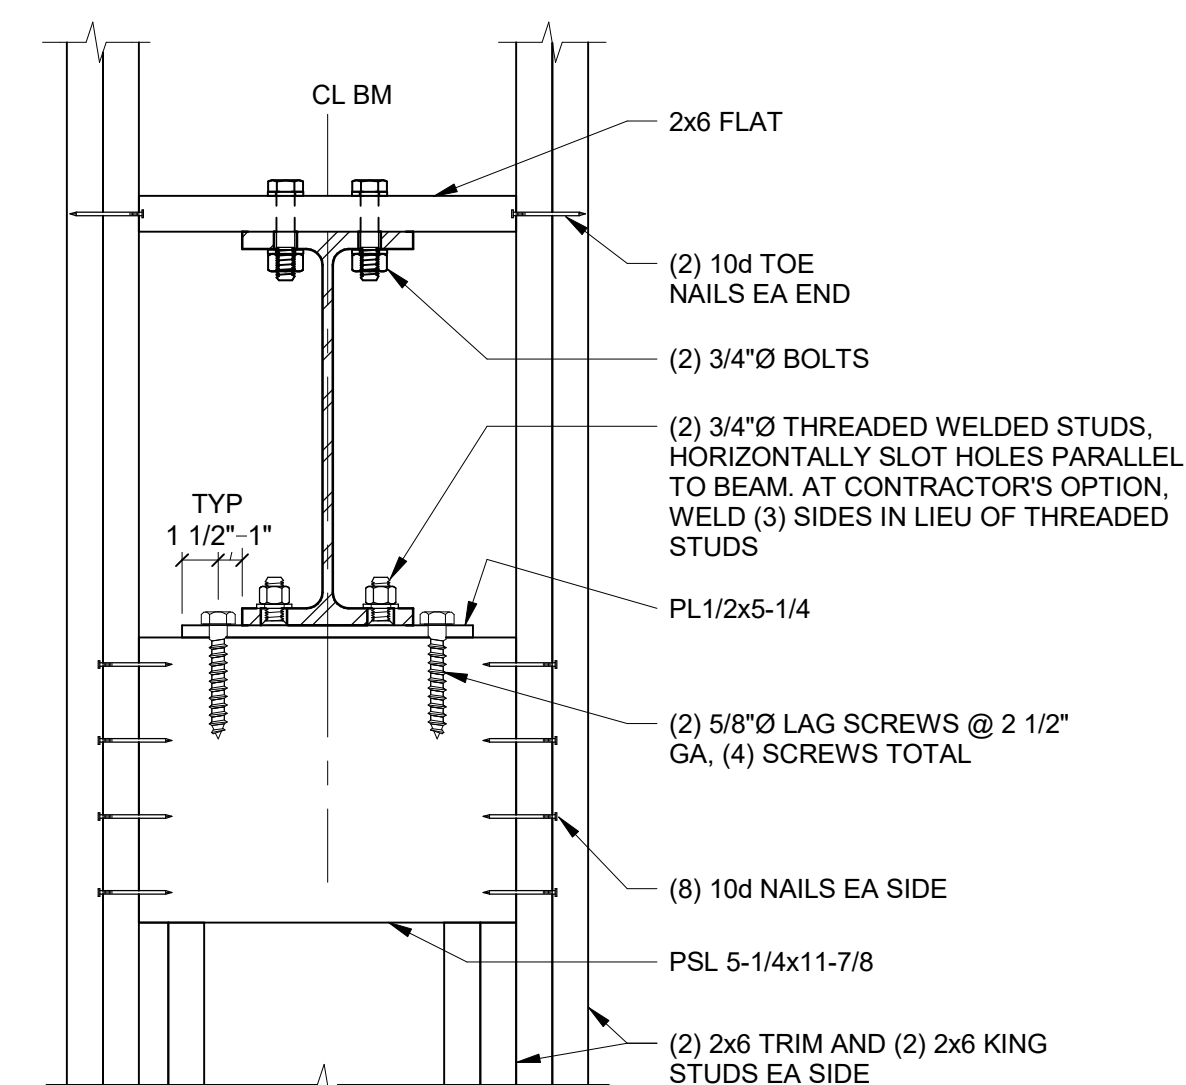


2 STEEL BM TO WOOD WALL CONN

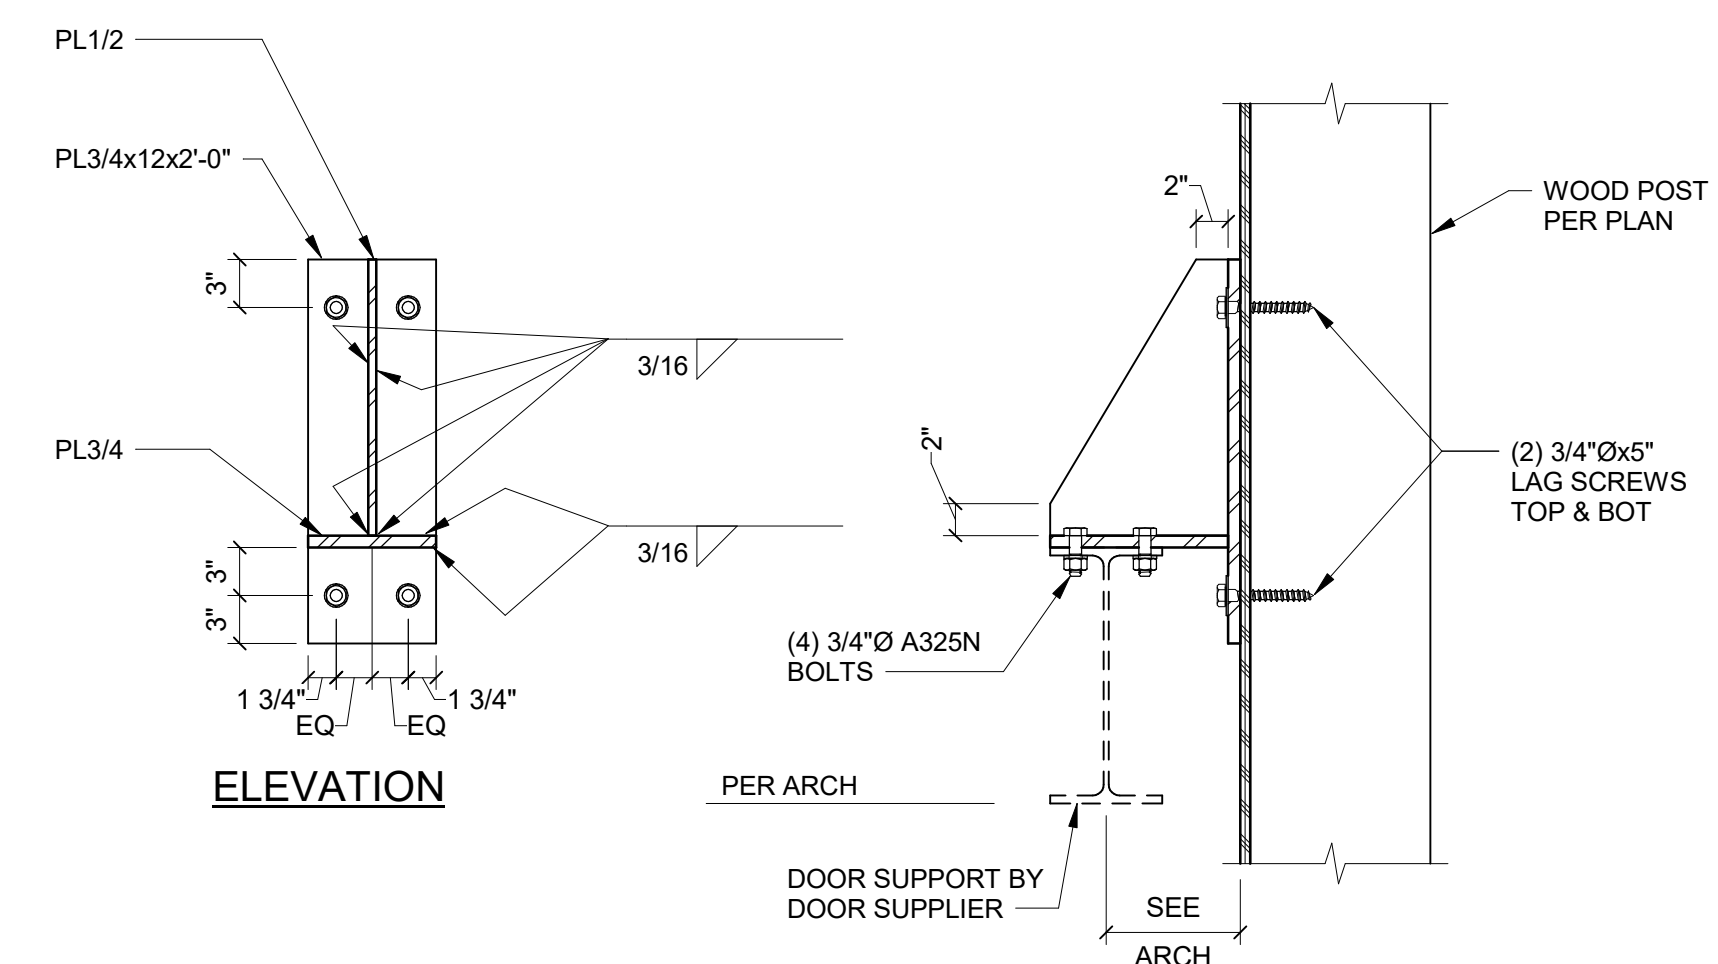


4 SLIDING DOOR SUPPORT BRACKET

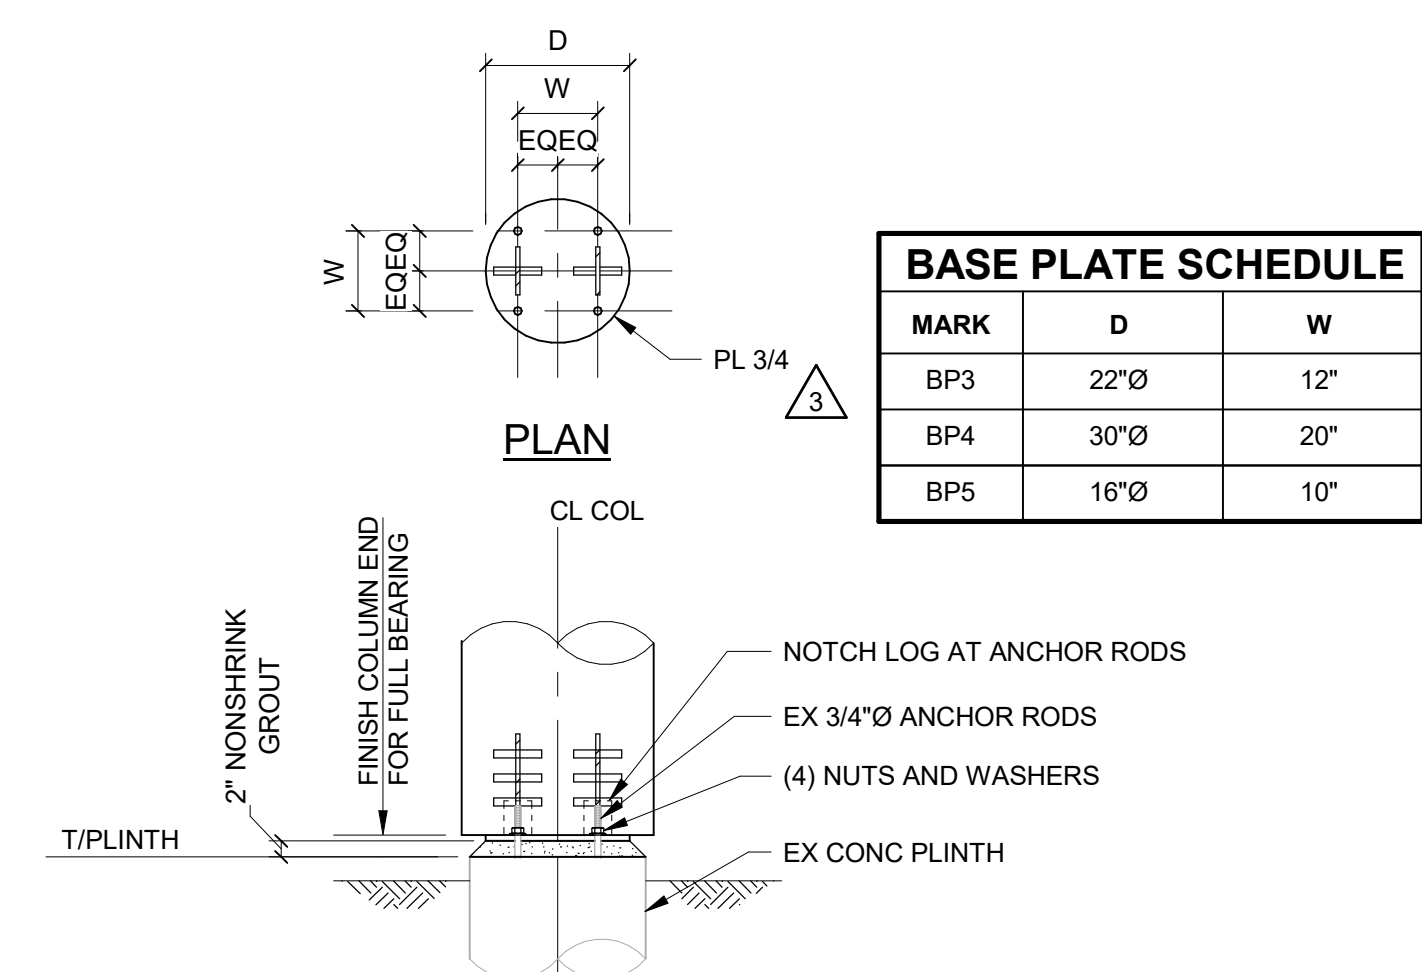


8 TYPICAL EXTERIOR WOOD LOG COLUMN
BASE CONNECTION DETAIL

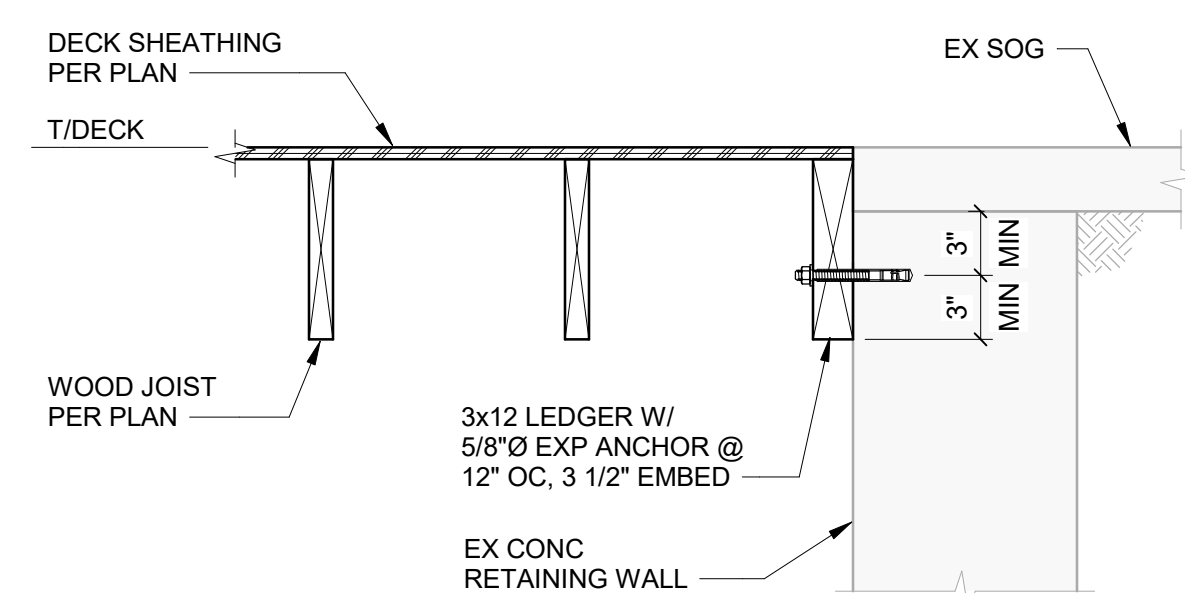


9 WOOD DECK CONN AT RETAINING WALL
1" = 1'-0"

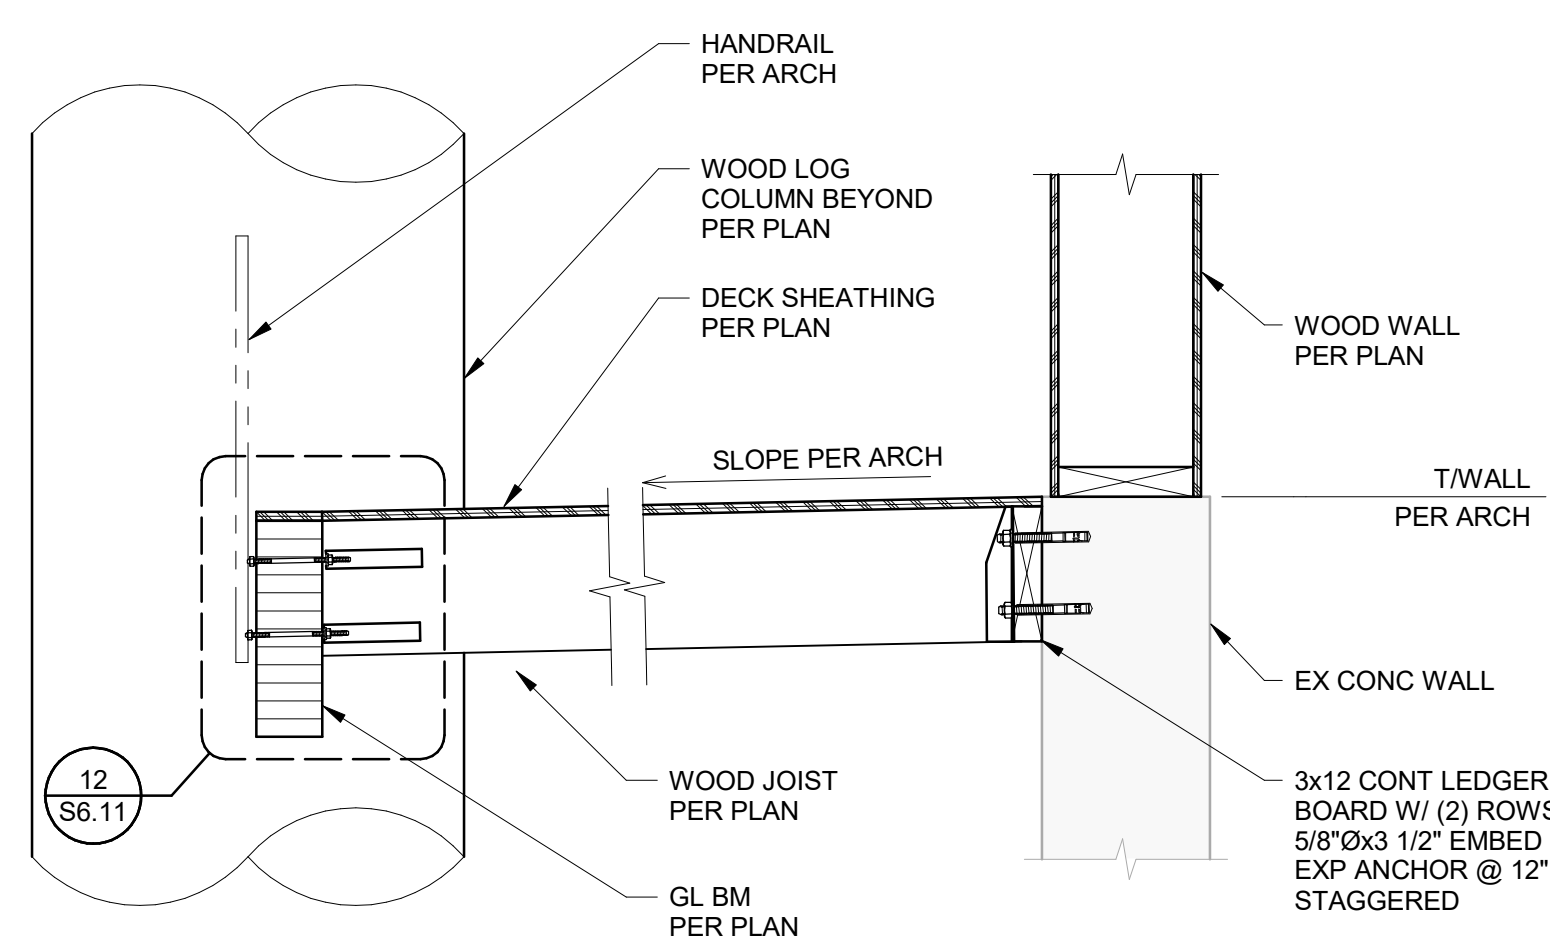

10 WOOD DECK SECTION

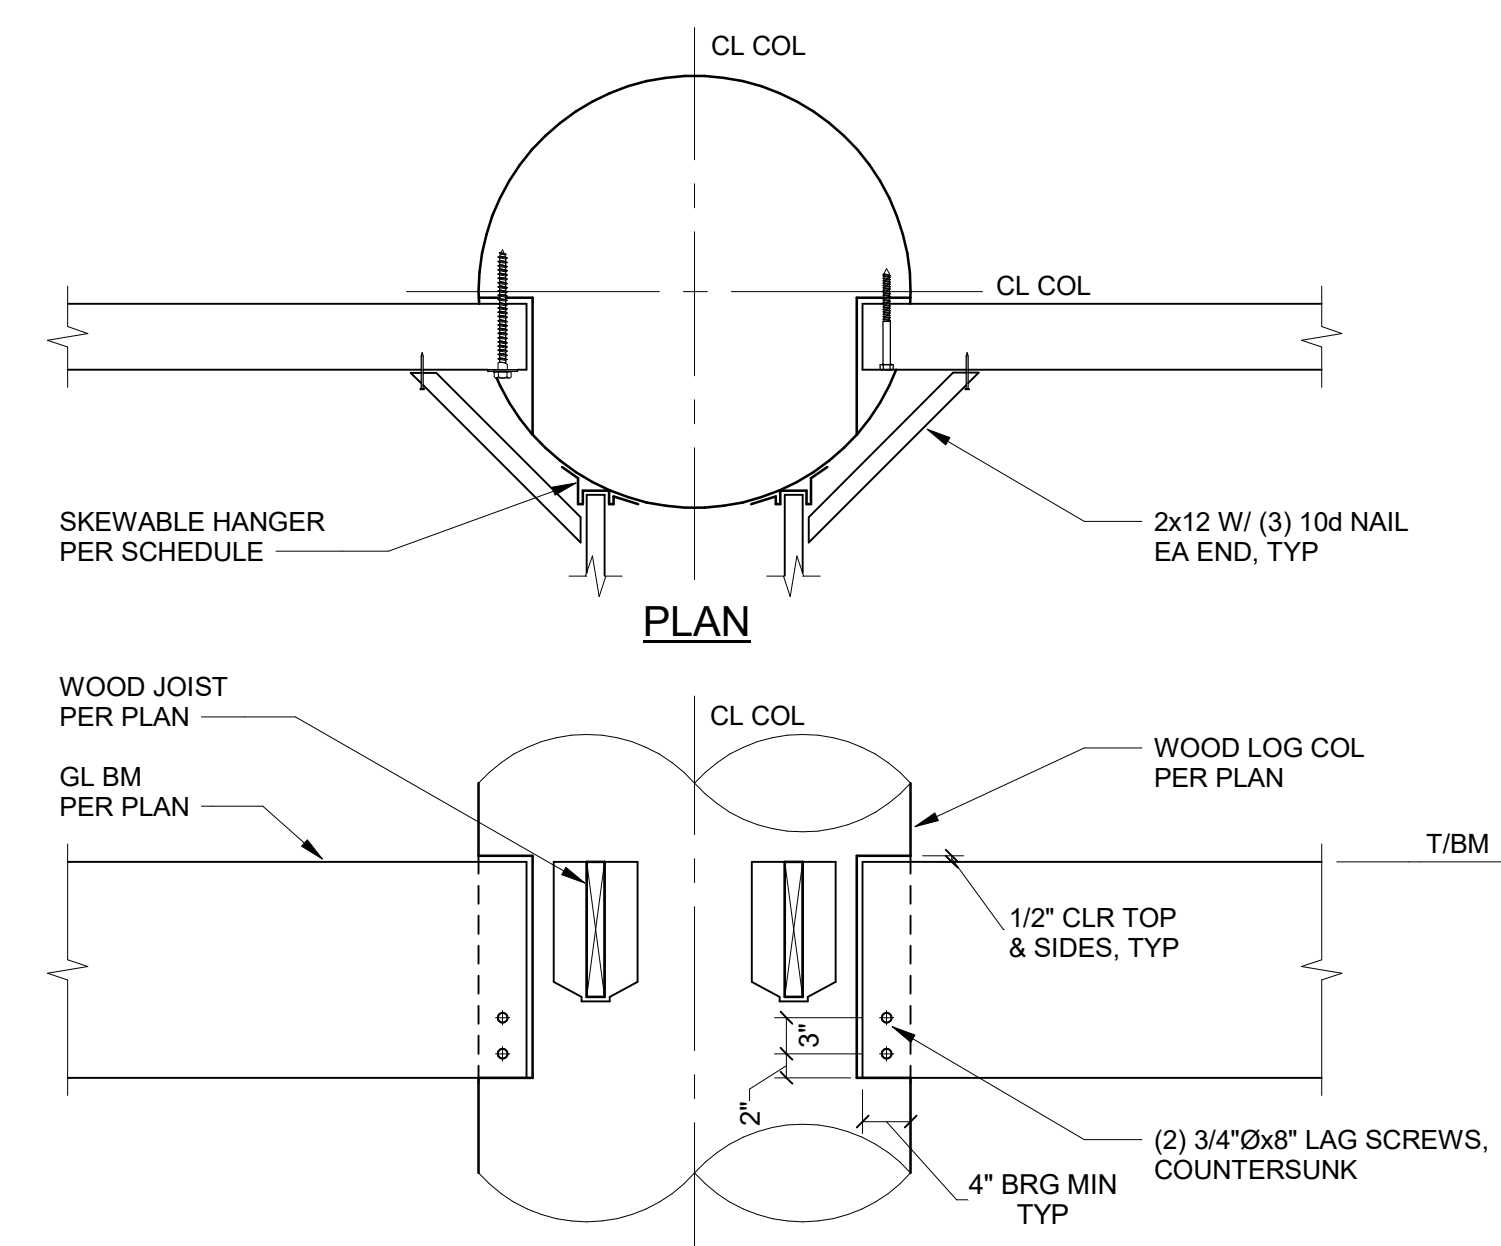

11 WOOD DECK COLUMN CONNECTIONS

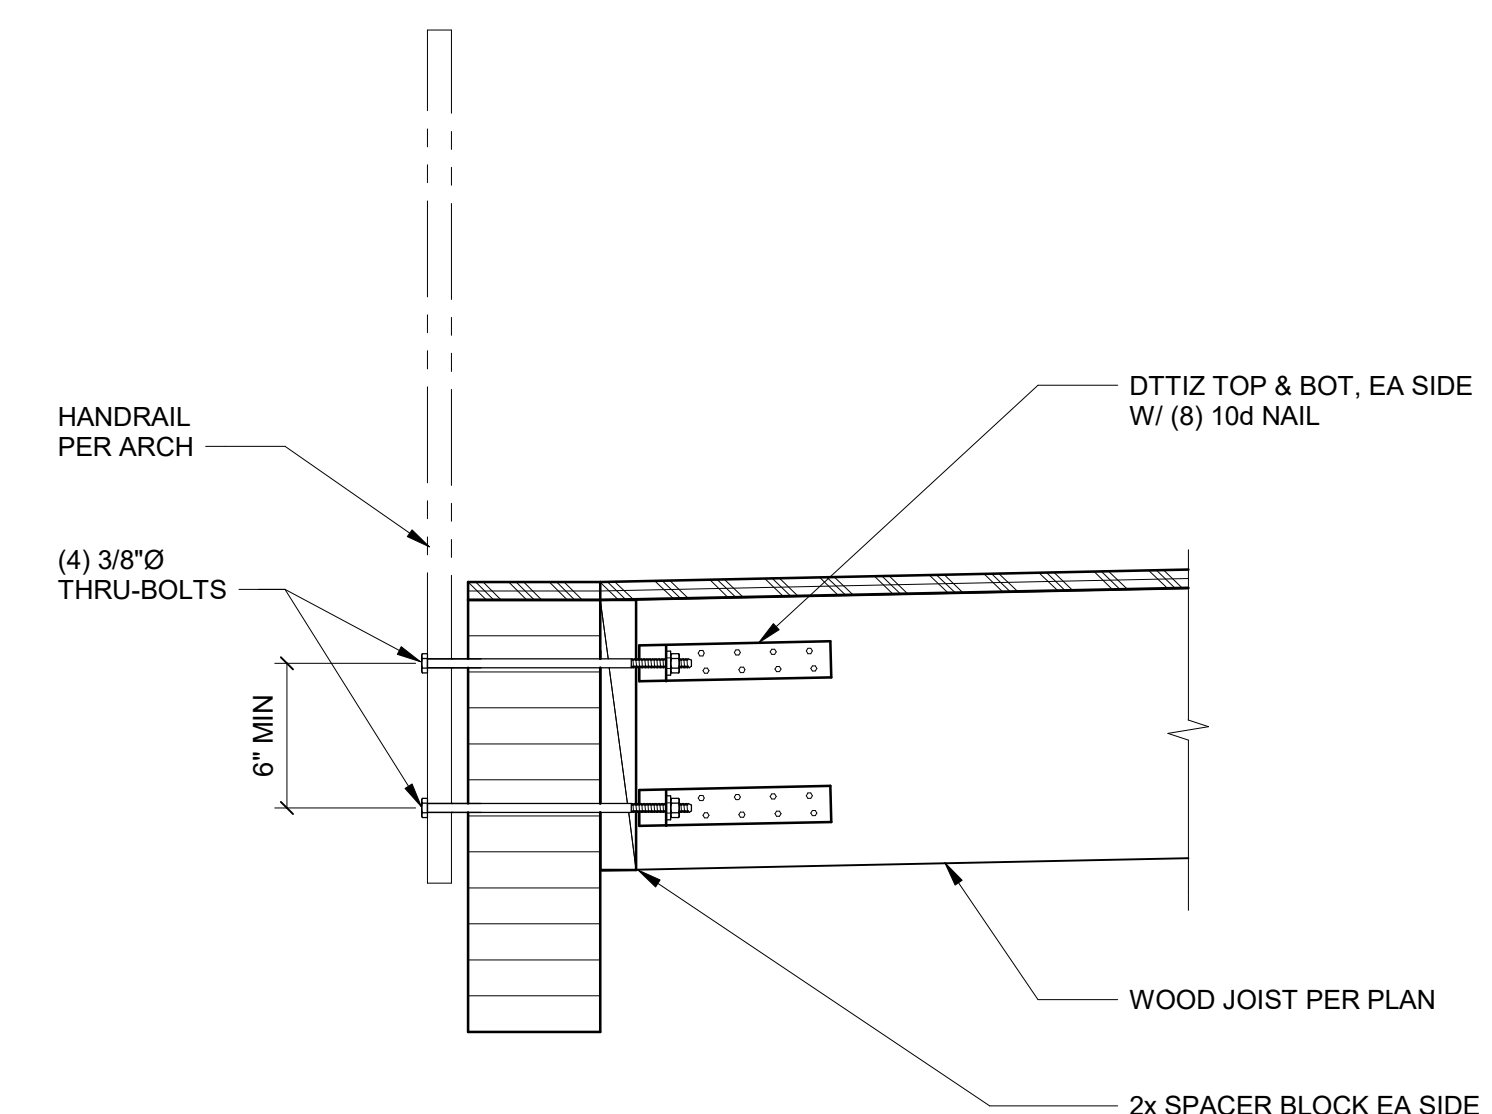

12 WOOD DECK HANDRAIL CONNECTION



t 425.778.1530 21911 76th Ave W. Ste 210
f 425.774.7803 Edmonds WA 98026
info@tgbarchitects.com
www.tgbarchitects.com



1601 5th Avenue, Suite 1600
Seattle, WA 98101

206.622.5822
www.kpff.com

**TULALIP TRIBES
GATHERING HALL**

7512 TOTEM BEACH RD
TULALIP, WA 98271

PHASE 2 - BUILDING AND LANDSCAPING

WOOD DETAILS

[illegible]

PROJECT INFORMATION	
PROJECT NUMBER:	17031
PROJECT LEAD:	Designer
DRAWN BY:	Author

SHEET NO

S6.11

Exhibit J.2.2. Interval Data

usage_hour_end_time_local	kWh	kVAR	kVA	kW
2025-04-03 01:00:00	0	0	0	0
2025-04-03 02:00:00	0	0	0	0
2025-04-03 03:00:00	0	0	0	0
2025-04-03 04:00:00	0	0	0	0
2025-04-03 05:00:00	0	0	0	0
2025-04-03 06:00:00	0	0	0	0
2025-04-03 07:00:00	0	0	0	0
2025-04-03 08:00:00	0	0	0	0
2025-04-03 09:00:00	0	0	0	0
2025-04-03 10:00:00	26.32	0.24	26.3211	88.32
2025-04-03 11:00:00	86	0.64	86.0024	92.8
2025-04-03 12:00:00	76.8	0.56	76.802	82.88
2025-04-03 13:00:00	60.24	1.04	60.249	66.24
2025-04-03 14:00:00	50.8	0.4	50.8016	61.44
2025-04-03 15:00:00	41.28	0.16	41.2803	45.44
2025-04-03 16:00:00	40.4	0.32	40.4013	46.72
2025-04-03 17:00:00	38.24	0.16	38.2403	42.56
2025-04-03 18:00:00	38.64	0.08	38.6401	43.52
2025-04-03 19:00:00	48.08	0	48.08	54.08
2025-04-03 20:00:00	60.48	0	60.48	66.24
2025-04-03 21:00:00	77.92	0	77.92	85.44
2025-04-03 22:00:00	82.48	0	82.48	94.08
2025-04-03 23:00:00	90.64	0	90.64	96.96
2025-04-04 00:00:00	90.56	0	90.56	93.44
2025-04-04 01:00:00	102.48	0.56	102.482	111.36
2025-04-04 02:00:00	95.68	0.8	95.6833	102.72
2025-04-04 03:00:00	94.48	0.88	94.4841	98.24
2025-04-04 04:00:00	100.24	0.88	100.244	113.92
2025-04-04 05:00:00	100.72	1.2	100.727	107.84
2025-04-04 06:00:00	98.4	1.44	98.4105	110.4
2025-04-04 07:00:00	96.88	1.52	96.8919	101.76
2025-04-04 08:00:00	98.16	1.2	98.1673	102.08
2025-04-04 09:00:00	94.08	0.56	94.0817	97.28
2025-04-04 10:00:00	88.16	0.08	88.16	96.64
2025-04-04 11:00:00	75.84	0.56	75.8421	80.32
2025-04-04 12:00:00	79.76	0.32	79.7606	93.44
2025-04-04 13:00:00	53.52	0.96	53.5286	59.84
2025-04-04 14:00:00	51.12	0.72	51.1251	67.2
2025-04-04 15:00:00	43.12	0.16	43.1203	49.6
2025-04-04 16:00:00	32.56	0.56	32.5648	36.16
2025-04-04 17:00:00	31.36	0.4	31.3626	35.2
2025-04-04 18:00:00	31.84	0	31.84	37.12
2025-04-04 19:00:00	35.12	0	35.12	42.24
2025-04-04 20:00:00	46.16	0.16	46.1603	68.8
2025-04-04 21:00:00	79.44	0	79.44	87.04
2025-04-04 22:00:00	76.64	0.08	76.64	82.56
2025-04-04 23:00:00	86.24	0	86.24	92.48
2025-04-05 00:00:00	91.6	0	91.6	94.4
2025-04-05 01:00:00	91.68	0	91.68	98.88
2025-04-05 02:00:00	94.16	0.48	94.1612	106.56
2025-04-05 03:00:00	88.32	1.2	88.3282	92.48
2025-04-05 04:00:00	98.16	1.2	98.1673	107.2
2025-04-05 05:00:00	97.6	1.36	97.6095	112.64
2025-04-05 06:00:00	98.4	1.12	98.4064	104.96
2025-04-05 07:00:00	88.24	1.52	88.2531	95.04
2025-04-05 08:00:00	96.24	1.52	96.252	101.44
2025-04-05 09:00:00	80.8	0.88	80.8048	91.2
2025-04-05 10:00:00	78.56	0.96	78.5659	81.6
2025-04-05 11:00:00	58.48	1.12	58.4907	71.68
2025-04-05 12:00:00	44.88	0.16	44.8803	48.64
2025-04-05 13:00:00	35.52	0.8	35.529	39.68
2025-04-05 14:00:00	32.16	0.56	32.1649	34.56
2025-04-05 15:00:00	20.96	0.24	20.9614	30.72
2025-04-05 16:00:00	16.8	0.08	16.8002	19.84
2025-04-05 17:00:00	21.12	0.32	21.1224	25.92
2025-04-05 18:00:00	25.44	0.16	25.4405	29.76
2025-04-05 19:00:00	30.4	0.16	30.4004	36.16
2025-04-05 20:00:00	28.72	0	28.72	32
2025-04-05 21:00:00	37.36	0	37.36	39.68
2025-04-05 22:00:00	64.64	0.08	64.6401	69.12
2025-04-05 23:00:00	60.64	0	60.64	66.88
2025-04-06 00:00:00	64	0.08	64.0001	67.84

2025-04-06 01:00:00	57.44	0.08	57.4401	62.72
2025-04-06 02:00:00	35.2	0	35.2	39.68
2025-04-06 03:00:00	34.08	0	34.08	37.44
2025-04-06 04:00:00	39.68	0	39.68	46.72
2025-04-06 05:00:00	41.68	0	41.68	53.12
2025-04-06 06:00:00	40.48	0.08	40.4801	53.44
2025-04-06 07:00:00	39.36	1.2	39.3783	46.08
2025-04-06 08:00:00	40.48	1.04	40.4934	50.24
2025-04-06 09:00:00	35.44	0.8	35.449	42.56
2025-04-06 10:00:00	34.88	0.16	34.8804	41.28
2025-04-06 11:00:00	30.64	0	30.64	32.64
2025-04-06 12:00:00	30	0	30	36.8
2025-04-06 13:00:00	31.04	0.48	31.0437	39.68
2025-04-06 14:00:00	30.96	0.48	30.9637	34.24
2025-04-06 15:00:00	31.92	0	31.92	35.84
2025-04-06 16:00:00	35.2	0.08	35.2001	48.32
2025-04-06 17:00:00	35.04	1.2	35.0605	40.96
2025-04-06 18:00:00	33.68	0.64	33.6861	39.68
2025-04-06 19:00:00	31.36	0	31.36	37.12
2025-04-06 20:00:00	34.08	0.08	34.0801	38.72
2025-04-06 21:00:00	38.56	0	38.56	45.12
2025-04-06 22:00:00	38.88	0.64	38.8853	44.8
2025-04-06 23:00:00	38.24	0.56	38.2441	44.8
2025-04-07 00:00:00	41.52	0.72	41.5262	43.52
2025-04-07 01:00:00	43.52	0.96	43.5306	54.08
2025-04-07 02:00:00	96.48	2	96.5007	102.72
2025-04-07 03:00:00	87.76	1.36	87.7705	92.16
2025-04-07 04:00:00	88.96	0.72	88.9629	94.08
2025-04-07 05:00:00	87.44	0.08	87.44	96.96
2025-04-07 06:00:00	80.08	0	80.08	86.72
2025-04-07 07:00:00	76.16	0.48	76.1615	83.2
2025-04-07 08:00:00	79.12	0.16	79.1202	82.88
2025-04-07 09:00:00	85.2	0.08	85.2	88.32
2025-04-07 10:00:00	80.32	0.32	80.3206	87.04
2025-04-07 11:00:00	67.36	0.56	67.3623	70.72
2025-04-07 12:00:00	74.64	0.4	74.6411	83.52
2025-04-07 13:00:00	59.04	0.24	59.0405	68.48
2025-04-07 14:00:00	61.04	0.4	61.0413	72.96
2025-04-07 15:00:00	80.8	0.48	80.8014	88.96
2025-04-07 16:00:00	80	0.32	80.0006	86.4
2025-04-07 17:00:00	74.96	0.32	74.9607	78.4
2025-04-07 18:00:00	75.36	0.08	75.36	78.08
2025-04-07 19:00:00	76.8	0	76.8	82.56
2025-04-07 20:00:00	76.88	0	76.88	80.96
2025-04-07 21:00:00	83.6	0.08	83.6	86.4
2025-04-07 22:00:00	81.52	0.16	81.5202	83.84
2025-04-07 23:00:00	83.12	0	83.12	86.72
2025-04-08 00:00:00	80.96	0	80.96	83.52
2025-04-08 01:00:00	89.44	1.68	89.4558	97.6
2025-04-08 02:00:00	90.72	1.6	90.7341	103.36
2025-04-08 03:00:00	80.88	1.36	80.8914	86.4
2025-04-08 04:00:00	91.28	1.28	91.289	96.64
2025-04-08 05:00:00	92.8	1.92	92.8199	96
2025-04-08 06:00:00	85.36	1.12	85.3673	88.64
2025-04-08 07:00:00	80.88	1.68	80.8974	87.04
2025-04-08 08:00:00	88	1.92	88.0209	89.92
2025-04-08 09:00:00	85.84	0.08	85.84	89.6
2025-04-08 10:00:00	87.12	0.24	87.1203	95.36
2025-04-08 11:00:00	89.12	0.32	89.1206	91.52
2025-04-08 12:00:00	91.92	0.08	91.92	100.8
2025-04-08 13:00:00	81.2	0.24	81.2004	85.76
2025-04-08 14:00:00	75.44	0.08	75.44	77.44
2025-04-08 15:00:00	77.92	0.4	77.921	87.36
2025-04-08 16:00:00	67.52	0.48	67.5217	69.12
2025-04-08 17:00:00	57.84	0.48	57.842	62.08
2025-04-08 18:00:00	56.8	0.48	56.802	61.76
2025-04-08 19:00:00	71.84	0.64	71.8429	80.96
2025-04-08 20:00:00	88.08	0	88.08	93.12
2025-04-08 21:00:00	86	0	86	89.6
2025-04-08 22:00:00	82.64	0	82.64	88
2025-04-08 23:00:00	82.32	0	82.32	90.24
2025-04-09 00:00:00	85.12	0.16	85.1202	90.56
2025-04-09 01:00:00	88.32	0.8	88.3236	92.16


2025-04-09 02:00:00	85.92	0.64	85.9224	90.56
2025-04-09 03:00:00	86.08	0.56	86.0818	88.96
2025-04-09 04:00:00	91.6	0.64	91.6022	98.24
2025-04-09 05:00:00	90.8	0.32	90.8006	95.68
2025-04-09 06:00:00	88.8	0.88	88.8044	96.96
2025-04-09 07:00:00	88.32	1.52	88.3331	92.48
2025-04-09 08:00:00	97.52	1.28	97.5284	110.08
2025-04-09 09:00:00	89.52	1.2	89.528	96.64
2025-04-09 10:00:00	82.48	0.72	82.4831	91.84
2025-04-09 11:00:00	67.12	0.64	67.1231	74.56
2025-04-09 12:00:00	64.24	0.72	64.244	68.16
2025-04-09 13:00:00	52.08	1.52	52.1022	56.32
2025-04-09 14:00:00	46.64	1.2	46.6554	53.76
2025-04-09 15:00:00	48.48	0.64	48.4842	52.48
2025-04-09 16:00:00	50.8	0.24	50.8006	53.12
2025-04-09 17:00:00	59.28	0.72	59.2844	64.96
2025-04-09 18:00:00	63.68	0.56	63.6825	68.16
2025-04-09 19:00:00	59.04	0	59.04	61.12
2025-04-09 20:00:00	87.84	0.48	87.8413	104.64
2025-04-09 21:00:00	107.52	2.16	107.542	110.72
2025-04-09 22:00:00	102.64	1.6	102.652	108.16
2025-04-09 23:00:00	102.56	1.2	102.567	107.52
2025-04-10 00:00:00	103.28	1.28	103.288	106.88
2025-04-10 01:00:00	104.24	1.52	104.251	111.68
2025-04-10 02:00:00	99.44	0.88	99.4439	114.88
2025-04-10 03:00:00	110.88	0.4	110.881	121.28
2025-04-10 04:00:00	119.44	0.96	119.444	124.48
2025-04-10 05:00:00	116.56	0.32	116.56	118.08
2025-04-10 06:00:00	115.76	2.88	115.796	120
2025-04-10 07:00:00	108.88	1.36	108.888	116.8
2025-04-10 08:00:00	117.28	2.4	117.305	120.32
2025-04-10 09:00:00	96.4	1.36	96.4096	112
2025-04-10 10:00:00	69.2	1.12	69.2091	76.8
2025-04-10 11:00:00	61.68	0.56	61.6825	71.68
2025-04-10 12:00:00	63.68	0.88	63.6861	71.04
2025-04-10 13:00:00	51.44	0.48	51.4422	56.64
2025-04-10 14:00:00	58.08	0.4	58.0814	65.28
2025-04-10 15:00:00	86.56	1.12	86.5672	97.28
2025-04-10 16:00:00	104.48	0.72	104.482	108.16
2025-04-10 17:00:00	115.36	1.76	115.373	122.56
2025-04-10 18:00:00	105.28	1.12	105.286	116.8
2025-04-10 19:00:00	104.08	0.24	104.08	108.16
2025-04-10 20:00:00	114.08	0.4	114.081	121.92
2025-04-10 21:00:00	113.92	1.12	113.926	132.16
2025-04-10 22:00:00	104.56	0.24	104.56	108.48
2025-04-10 23:00:00	95.36	0.16	95.3601	108.16
2025-04-11 00:00:00	88.64	0.24	88.6403	99.52
2025-04-11 01:00:00	93.04	0.16	93.0401	99.2
2025-04-11 02:00:00	93.92	0.24	93.9203	99.52
2025-04-11 03:00:00	90.64	0	90.64	95.36
2025-04-11 04:00:00	102	0.56	102.002	105.92
2025-04-11 05:00:00	106.4	0.48	106.401	115.2
2025-04-11 06:00:00	72.72	0	72.72	87.68
2025-04-11 07:00:00	59.6	0.96	59.6077	64.32
2025-04-11 08:00:00	76.64	0.24	76.6404	79.68
2025-04-11 09:00:00	83.2	1.36	83.2111	88.32
2025-04-11 10:00:00	92.72	1.12	92.7268	99.2
2025-04-11 11:00:00	79.52	2.24	79.5515	87.68
2025-04-11 12:00:00	79.52	1.28	79.5303	89.6
2025-04-11 13:00:00	62.48	2	62.512	72.32
2025-04-11 14:00:00	46.56	0.64	46.5644	51.84
2025-04-11 15:00:00	36.16	1.6	36.1954	43.52
2025-04-11 16:00:00	30.32	1.44	30.3542	37.76
2025-04-11 17:00:00	33.6	1.12	33.6187	40
2025-04-11 18:00:00	35.2	0.4	35.2023	38.08
2025-04-11 19:00:00	38.8	0.08	38.8001	42.24
2025-04-11 20:00:00	42	0.08	42.0001	48
2025-04-11 21:00:00	69.92	1.44	69.9348	81.28
2025-04-11 22:00:00	63.68	0.48	63.6818	72.32
2025-04-11 23:00:00	64.4	0	64.4	68.8
2025-04-12 00:00:00	60.8	0.16	60.8002	63.36
2025-04-12 01:00:00	72.96	0.96	72.9663	80.96
2025-04-12 02:00:00	70.48	1.92	70.5061	74.88

2025-04-12 03:00:00	67.12	1.44	67.1354	78.72
2025-04-12 04:00:00	72.8	2.16	72.832	77.12
2025-04-12 05:00:00	77.68	1.6	77.6965	81.28
2025-04-12 06:00:00	70.8	2.16	70.8329	75.2
2025-04-12 07:00:00	66.24	1.6	66.2593	72
2025-04-12 08:00:00	66.8	2	66.8299	76.16
2025-04-12 09:00:00	58.72	0.08	58.7201	66.88
2025-04-12 10:00:00	64.48	0.8	64.485	73.92
2025-04-12 11:00:00	53.76	0.08	53.7601	59.84
2025-04-12 12:00:00	47.2	1.04	47.2115	54.72
2025-04-12 13:00:00	33.6	0.8	33.6095	40.96
2025-04-12 14:00:00	24.16	0.56	24.1665	36.16
2025-04-12 15:00:00	25.2	1.12	25.2249	35.52
2025-04-12 16:00:00	21.6	0.88	21.6179	25.28
2025-04-12 17:00:00	23.2	1.2	23.231	25.6
2025-04-12 18:00:00	26.56	0.48	26.5643	30.08
2025-04-12 19:00:00	36.16	0.72	36.1672	43.2
2025-04-12 20:00:00	46.08	0.24	46.0806	48.32
2025-04-12 21:00:00	61.12	0	61.12	71.04
2025-04-12 22:00:00	63.12	0.48	63.1218	71.36
2025-04-12 23:00:00	68.8	0.48	68.8017	83.52
2025-04-13 00:00:00	95.2	3.2	95.2538	105.6
2025-04-13 01:00:00	101.04	1.68	101.054	106.56
2025-04-13 02:00:00	58.56	2.24	58.6028	69.12
2025-04-13 03:00:00	64.8	2.56	64.8505	68.48
2025-04-13 04:00:00	73.2	2.48	73.242	77.76
2025-04-13 05:00:00	75.6	2.56	75.6433	84.8
2025-04-13 06:00:00	71.12	2.8	71.1751	75.2
2025-04-13 07:00:00	66.4	3.04	66.4696	71.68
2025-04-13 08:00:00	68.88	2.32	68.9191	76.16
2025-04-13 09:00:00	66.64	2.8	66.6988	68.48
2025-04-13 10:00:00	59.6	3.2	59.6858	70.08
2025-04-13 11:00:00	39.2	4.08	39.4118	46.4
2025-04-13 12:00:00	36.96	3.6	37.1349	40.64
2025-04-13 13:00:00	36.72	4.16	36.9549	41.28
2025-04-13 14:00:00	25.76	2.48	25.8791	29.12
2025-04-13 15:00:00	22.16	1.84	22.2363	27.2
2025-04-13 16:00:00	25.68	1.68	25.7349	27.52
2025-04-13 17:00:00	28.16	1.44	28.1968	33.28
2025-04-13 18:00:00	26.64	0.88	26.6545	34.24
2025-04-13 19:00:00	29.68	1.04	29.6982	36.48
2025-04-13 20:00:00	36.8	0.88	36.8105	42.56
2025-04-13 21:00:00	43.36	1.04	43.3725	51.52
2025-04-13 22:00:00	50.4	2.64	50.4691	61.44
2025-04-13 23:00:00	45.84	2.96	45.9355	49.92
2025-04-14 00:00:00	49.6	2.4	49.658	57.6
2025-04-14 01:00:00	64.08	2.64	64.1344	73.28
2025-04-14 02:00:00	107.2	3.44	107.255	122.24
2025-04-14 03:00:00	94.88	2.4	94.9103	108.48
2025-04-14 04:00:00	115.28	3.12	115.322	124.48
2025-04-14 05:00:00	108.48	2.08	108.5	114.88
2025-04-14 06:00:00	108.32	2.64	108.352	123.84
2025-04-14 07:00:00	106.48	3.84	106.549	111.68
2025-04-14 08:00:00	113.52	3.04	113.561	118.72
2025-04-14 09:00:00	109.12	1.76	109.134	113.6
2025-04-14 10:00:00	92.64	1.76	92.6567	103.36
2025-04-14 11:00:00	100.48	2	100.5	111.36
2025-04-14 12:00:00	95.36	2.4	95.3902	100.16
2025-04-14 13:00:00	72.32	2	72.3477	80.64
2025-04-14 14:00:00	61.52	2.32	61.5637	64.64
2025-04-14 15:00:00	66.88	3.12	66.9527	81.6
2025-04-14 16:00:00	57.52	1.36	57.5361	62.72
2025-04-14 17:00:00	58.08	1.44	58.0978	72
2025-04-14 18:00:00	52.64	0.64	52.6439	58.56
2025-04-14 19:00:00	46.8	0	46.8	55.36
2025-04-14 20:00:00	60.88	0.08	60.8801	65.92
2025-04-14 21:00:00	73.12	0.32	73.1207	79.68
2025-04-14 22:00:00	71.76	0.08	71.76	79.68
2025-04-14 23:00:00	85.12	0	85.12	89.28
2025-04-15 00:00:00	83.84	0.08	83.84	85.44
2025-04-15 01:00:00	84.96	0.16	84.9602	93.44
2025-04-15 02:00:00	86	0	86	95.04
2025-04-15 03:00:00	84.96	0	84.96	89.92

2025-04-15 04:00:00	94.08	0.16	94.0801	104.64
2025-04-15 05:00:00	93.52	0.4	93.5209	103.68
2025-04-15 06:00:00	92.96	0.08	92.96	103.36
2025-04-15 07:00:00	92.64	0.48	92.6412	94.4
2025-04-15 08:00:00	120.4	0.8	120.403	133.12
2025-04-15 09:00:00	117.28	1.28	117.287	121.6
2025-04-15 10:00:00	114.56	1.28	114.567	126.4
2025-04-15 11:00:00	99.2	0.96	99.2046	107.84
2025-04-15 12:00:00	84.24	0.96	84.2455	92.16
2025-04-15 13:00:00	60.64	1.2	60.6519	76.48
2025-04-15 14:00:00	38.56	0.48	38.563	44.16
2025-04-15 15:00:00	36.8	1.6	36.8348	39.36
2025-04-15 16:00:00	36.48	1.36	36.5053	41.6
2025-04-15 17:00:00	38.4	0.72	38.4067	46.72
2025-04-15 18:00:00	40.16	0.24	40.1607	42.56
2025-04-15 19:00:00	50.4	0.32	50.401	53.44
2025-04-15 20:00:00	39.92	0	39.92	46.08
2025-04-15 21:00:00	46.16	0.08	46.1601	53.76
2025-04-15 22:00:00	43.76	0	43.76	48.64
2025-04-15 23:00:00	54.08	0.16	54.0802	65.92
2025-04-16 00:00:00	55.12	0.24	55.1205	59.52
2025-04-16 01:00:00	56.32	0.48	56.322	64
2025-04-16 02:00:00	60.16	0.16	60.1602	64.64
2025-04-16 03:00:00	74.48	1.52	74.4955	97.6
2025-04-16 04:00:00	91.52	1.84	91.5385	105.92
2025-04-16 05:00:00	96.4	2.32	96.4279	98.88
2025-04-16 06:00:00	99.28	3.2	99.3316	110.4
2025-04-16 07:00:00	91.76	2.32	91.7893	100.48
2025-04-16 08:00:00	96.96	2.72	96.9981	114.88
2025-04-16 09:00:00	84.8	1.28	84.8097	91.2
2025-04-16 10:00:00	68.88	1.68	68.9005	76.48
2025-04-16 11:00:00	69.12	1.76	69.1424	80.64
2025-04-16 12:00:00	53.68	0.96	53.6886	58.24
2025-04-16 13:00:00	40	1.6	40.032	47.36
2025-04-16 14:00:00	35.36	1.04	35.3753	40.32
2025-04-16 15:00:00	29.84	1.44	29.8747	33.6
2025-04-16 16:00:00	30.96	1.2	30.9832	35.84
2025-04-16 17:00:00	30.96	0.56	30.9651	33.28
2025-04-16 18:00:00	28	0	28	36.16
2025-04-16 19:00:00	33.76	0.08	33.7601	38.08
2025-04-16 20:00:00	35.76	0	35.76	41.28
2025-04-16 21:00:00	45.12	0	45.12	49.92
2025-04-16 22:00:00	45.12	0	45.12	48.64
2025-04-16 23:00:00	54.48	0	54.48	61.12
2025-04-17 00:00:00	54.64	0.4	54.6415	61.44
2025-04-17 01:00:00	58.96	0.48	58.962	66.56
2025-04-17 02:00:00	77.84	1.6	77.8564	86.4
2025-04-17 03:00:00	87.28	1.44	87.2919	89.92
2025-04-17 04:00:00	100.08	2.72	100.117	110.08
2025-04-17 05:00:00	99.466	1.602	99.4789	105.816
2025-04-17 06:00:00	100.825	2.319	100.852	110.184
2025-04-17 07:00:00	103.6	3.52	103.66	106.24
2025-04-17 08:00:00	111.92	3.12	111.963	116.8
2025-04-17 09:00:00	104.56	3.2	104.609	114.56
2025-04-17 10:00:00	93.2	1.76	93.2166	102.72
2025-04-17 11:00:00	71.04	1.92	71.0659	88
2025-04-17 12:00:00	50.64	0.8	50.6463	56.64
2025-04-17 13:00:00	36.88	1.84	36.9259	45.76
2025-04-17 14:00:00	32.56	1.52	32.5955	36.8
2025-04-17 15:00:00	29.2	1.04	29.2185	32
2025-04-17 16:00:00	33.36	0.72	33.3678	38.72
2025-04-17 17:00:00	40.4	0.16	40.4003	46.4
2025-04-17 18:00:00	42.32	0	42.32	46.08
2025-04-17 19:00:00	47.44	0.24	47.4406	52.48
2025-04-17 20:00:00	60.72	0.08	60.7201	72
2025-04-17 21:00:00	76.96	0.08	76.96	83.2
2025-04-17 22:00:00	87.52	0	87.52	93.12
2025-04-17 23:00:00	91.36	0.08	91.36	96.96
2025-04-18 00:00:00	107.2	0.24	107.2	118.4
2025-04-18 01:00:00	111.84	0.08	111.84	117.76
2025-04-18 02:00:00	119.12	0.72	119.122	125.12
2025-04-18 03:00:00	119.68	1.12	119.685	121.28
2025-04-18 04:00:00	148.48	3.52	148.522	154.88

Exhibit J.2.3. Architectural Drawings

PROJECT SYMBOLS

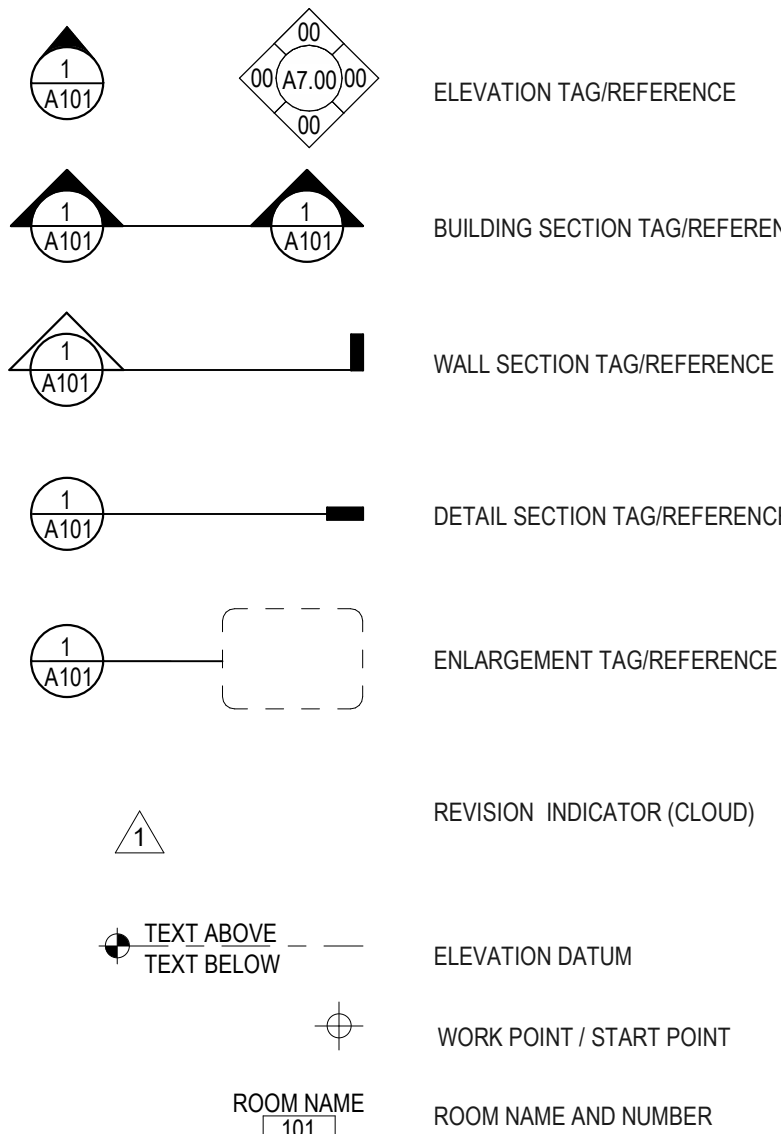

PROJECT NOTES

1) DO NOT SCALE THE DRAWINGS.

2) THE DRAWINGS AND THE SPECIFICATION ARE COMPLEMENTARY. WHATEVER IS INDICATED IN ONE IS ASSUMED TO BE INDICATED IN THE OTHER. NOTIFY THE ARCHITECT IN CASE OF DISCOVERED DISCREPANCIES.

3) DRAWINGS OF EXISTING CONDITIONS AND BUILDING PLANS HAVE BEEN PREPARED FROM DATA AND DRAWINGS PROVIDED BY THE CLIENT TO THE ARCHITECT. THE ARCHITECT HAS VERIFIED EXISTING CONDITIONS TO THE BEST OF THEIR ABILITY, AND THEN USED THE INFORMATION, IN ACCORDANCE WITH GENERALLY ACCEPTED STANDARDS OF PROFESSIONAL PRACTICE, TO INDICATE EXISTING CONDITIONS. HOWEVER, THE ARCHITECT ISSUES NO WARRANTY, EITHER EXPRESSED OR IMPLIED, FOR THE ACCURACY OR COMPLETENESS OF THE INFORMATION INDICATED THEREIN.

4) UNLESS NOTED OTHERWISE ALL DIMENSION ARE TO THE FINISH FACE OF WALLS.

NEW CONSTRUCTION NOTES:

1) ALL MATERIALS AND SYSTEMS SHALL BE INSTALLED PER MANUFACTURERS' PRINTED INSTRUCTIONS TO PER INDUSTRY STANDARDS. NOTIFY ARCHITECT OF ANY DISCREPANCIES.

2) THE GENERAL CONTRACTOR SHALL COORDINATE THE WORK OF THE VARIOUS TRADES UNDER HIS CONTRACT, AND SHALL COORDINATE THEIR WORK WITH WORK BY THE OWNER, THE OWNER'S SUPPLIERS, THE OWNER'S SUBCONTRACTORS, AND WITH OWNER'S EQUIPMENT IN PLACE AT THE TIME OF THE BID/PROPOSAL.


3) THE COMPLETED PROJECT SHALL HAVE A FINISHED APPEARANCE IN ALL SPACES ACCESSIBLE BY THE PUBLIC AND BY EMPLOYEES USING THE SPACE. THERE SHALL BE NO EXPOSED PIPE, CONDUIT, OR DUCTS UNLESS APPROVED BY THE ARCHITECT. THERE SHALL BE NO WALLS WITHOUT BASE PANEL AND PANEL UNLESS APPROVED BY THE ARCHITECT. THERE SHALL BE NO UNPAINTED OR UNFINISHED ACCESS PANELS, CLEANOUTS, OR GRADWAYS UNLESS APPROVED BY THE ARCHITECT.

ABBREVIATIONS

ACC	ACCESSIBLE	HR	HOUR
ADJ	ADJUNCT	HSP	HOUSEKEEPING
AFF	ABOVE FINISHED FLOOR	IBC	INTERNATIONAL BUILDING CODE
BLDG	BUILDING	JAN	JANITOR
BO	BOTTOM OF	JAN	JANITOR
CL	CENTERLINE	MAX	MAXIMUM
CJ	CONTROL JOINT	MDO	MEDIUM DENSITY OVERLAY
CLG	CEILING	MDF	MEDIUM DENSITY FIBER BOARD
CLR	CLEAR	MECH	MECHANICAL
CNMJ	CONCRETE MASONRY UNIT	MFR	MANUFACTURER
CNC	CONCRETE	MIN	MINIMUM
CONT	CONTINUOUS	MO	MASONRY OPENING
CORR	CORRIDOR	N	NORTH
CTR	CENTER	NIC	NOT IN CONTRACT
DEPT	DEPARTMENT	NTS	NOT TO SCALE
DF	DRINKING FOUNTAIN	OC	ON CENTER
DIA	DIAMETER	OPP	OPPOSITE
DM	DIMENSION	ORD	OVERFLOW ROOF DRAIN
DISP	DISPENSER	PL	PROPERTY LINE
DN	DOWN	PLAM	PLASTIC LAMINATE
DS	DOWN SPOUT	PR	PAIR
DWG	DRAWING	RD	ROOF DRAIN
E	EAST	RO	ROUGH OPENING
EJ	EXPANSION JOINT	S	SOUTH
EL	ELEVATOR	SC	SOLID CORE
ELV	ELEVATION	SCWD	SOLID CORE WOOD
EQ	EQUIPMENT	SF	SQUARE FEET, SQUARE FOOT
EQUIP	EQUIPMENT	SIM	SIMILAR
EW	ELECTRIC WATER COOLER	SS	STAINLESS STEEL
EXT	EXTERIOR	T&G	TONGUE AND GROOVE
FAB	FABRICATE	TOM	TOP OF MASONRY
FDN	FOUNDATION	TOS	TOP OF STEEL
FF	FINISH FLOOR	TOL	TOP OF SLAB
FF	FEET, FOOT	TOW	TOP OF WALL
FE	FIRE EXTINGUISHER	TYP	TYPICAL
FE	FIRE EXTINGUISHER (AND) CABINET	UNO	UNLESS NOTED OTHERWISE
G	GAUGE	VIF	VERIFY IN FIELD
GC	GENERAL CONTRACTOR	W	WEST
GW	GYPSUM WALL BOARD		
HT	HEIGHT		

WHERE SCHEDULES (INCLUDING THOSE FOR DOORS, OPENINGS, WINDOWS, PARTITIONS, FINISHES, MATERIALS, GLAZING, HARDWARE, AND SIMILAR ITEMS) USE ABBREVIATIONS OTHER THAN THESE, FOR REASONS OF EXTREME BREVITY, AN ABBREVIATION LEGEND IS PROVIDED AT THAT LOCATION FOR INTERPRETING SUCH ABBREVIATIONS.

VICINITY MAP

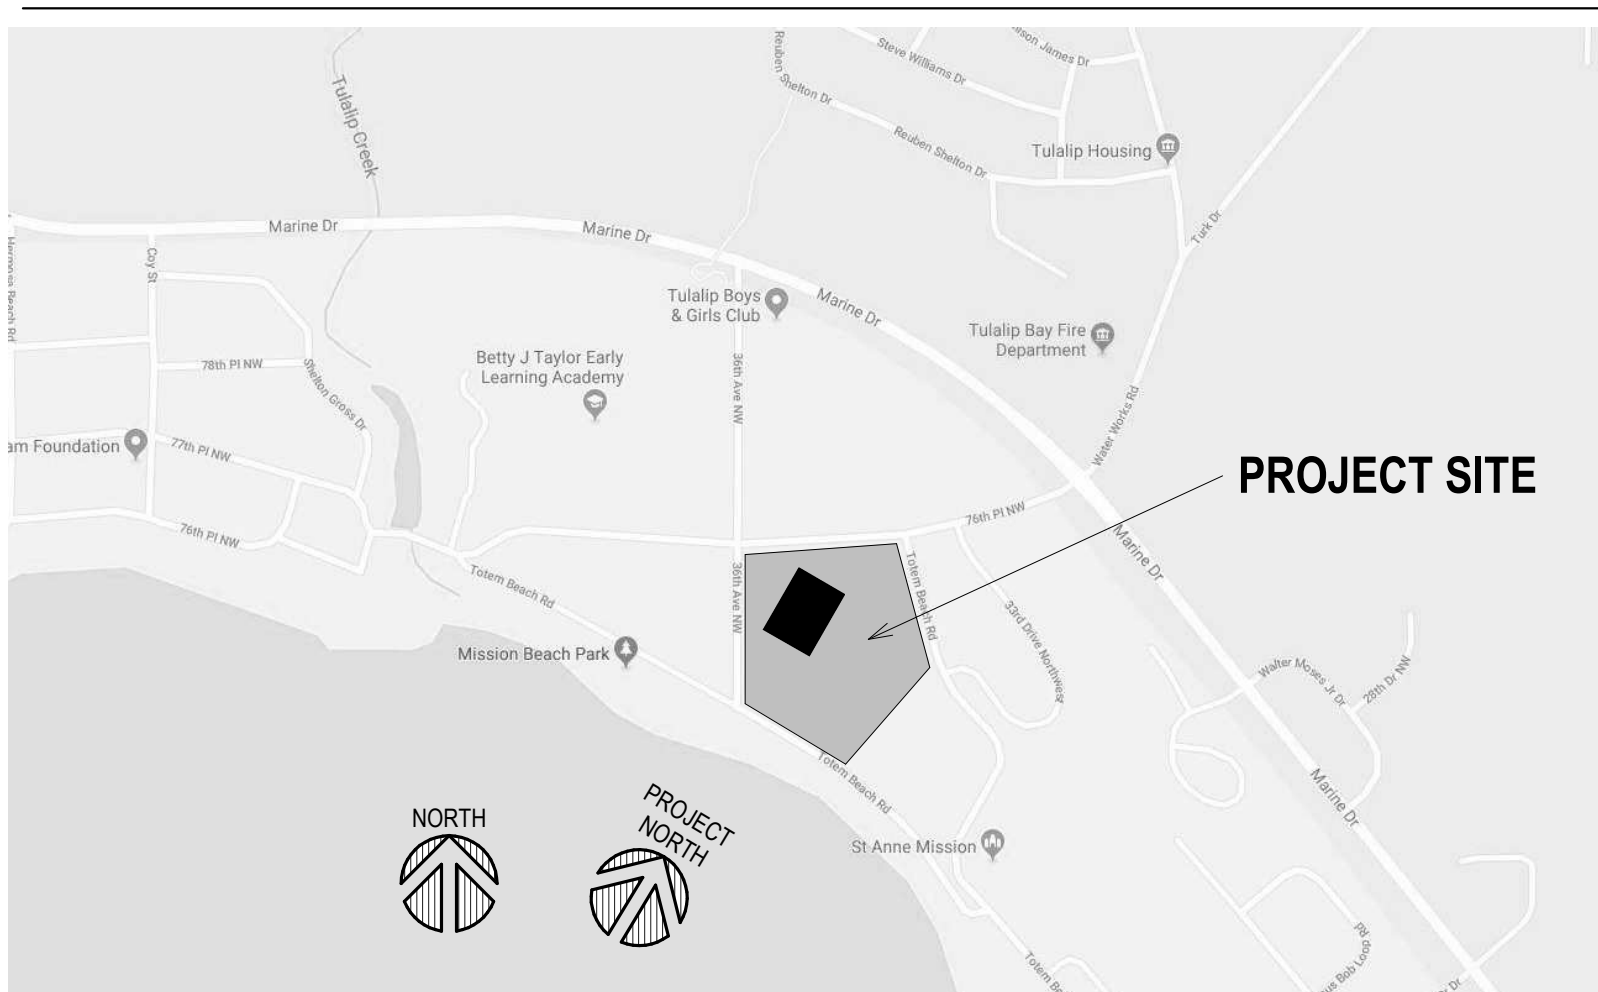

PROJECT INFORMATION

SCOPE OF WORK

NEW TWO STORY BUILDING OF APPROXIMATELY 30,524 SF ON MAIN LEVEL AND 27,710 SF ON THE LOWER LEVEL. THE MAIN LEVEL WILL INCLUDE A LARGE GATHERING HALL, 2 CONFERENCE ROOMS, A KITCHEN AND SUPPORT SPACES. THE LOWER LEVEL WILL INCLUDE AN OFFICE, STORAGE AND SUPPORT SPACES. THE SCOPE ALSO INCLUDES AN OUTDOOR COOKING PAVILION, LANDSCAPING, STRUCTURAL, MECHANICAL, PLUMBING AND ELECTRICAL.

FOUNDATIONS AND SITEWORK WERE A PART OF PHASE 1 (PERMIT # GP 2018-020)

QTR -SEC-TWP-RNG

NE 27 T30N R04E: NW 27 T30N R04E: SE 22 T30N
R04E: SW 22 T30N R04E

PARCEL NUMBER

30042700100200

AUTHORITY HAVING JURISDICTION (AHJ)

TULALIP TRIBES PLANNING DEPARTMENT

LAND USE

LAND USE JURISDICTION: SNOHOMISH COUNTY: TRIBAL TRUST
ZONING: TULALIP BAY PLANNING AREA
MAXIMUM LOT COVERAGE BY BUILDINGS: 50%
MINIMUM BUILDING SETBACK FRONT YARD ARTERIAL STREET: 25'
MINIMUM BUILDING SETBACK FRONT YARD OTHER STREET: 10'
MINIMUM BUILDING SETBACK SIDE YARD: 5'
MINIMUM BUILDING SETBACK REAR YARD: 5'
BUILDING HEIGHT: THE HEIGHT OF ANY INDUSTRIAL OR COMMERCIAL BUILDING OR PORTION THEREOF ABUTTING A RESIDENTIAL ZONE MAY NOT EXCEED THE DISTANCE TO THE PROPERTY LINE

APPLICABLE CODES

TULALIP TRIBAL CODES
 2012 IBC (ADOPTED CODE). 2015 IBC ALLOWED AS SUBSTITUTION
 EXISTING-BUILDING CODE: WA STATE EXISTING-BUILDING CODE (IEBC with amendments) - 2015
 BUILDING CODE: WA STATE BUILDING CODE (IBC with amendments) - 2015
 ENERGY CODE: WA STATE ENERGY CODE (IECC with amendments) - 2015
 LIFE SAFETY CODE: NFPA 101 - 2012
 FIRE CODE: INTERNATIONAL FIRE CODE (IFC) - 2015
 MECHANICAL CODE: INTERNATIONAL MECHANICAL CODE (IMC) - 2015
 PLUMBING CODE: UNIFORM PLUMBING CODE (UPC) - 2015
 ELECTRICAL CODE: NATIONAL ELECTRICAL CODE (NEC) - 2014
 ACCESSIBILITY CODE: ANSI A117.1 - 2009 (BY REFERENCE FROM IBC AND WSCB)

DEFERRED SUBMITTALS

2. SMOKE DETECTION SYSTEM AND FIRE ALARM SYSTEM - BUILDING SHALL BE EQUIPT WITH A VOICE ALARM SYSTEM

PROJECT TEAM


OWNER: TULALIP TRIBES 6406 MARINE DRIVE TULALIP BAY, WA 98271	OWNER CONTACT: ANTHONY HART 360-618-1797 ahart@tulaliptribesns.gov
ARCHITECT: TGB ARCHITECTS 21911 78TH AVE. W. SUITE 210 EDMONDS, WA 98225	PROJECT LEAD: DEXTER CHIN PRINCIPAL IN CHARGE: KENT GREGORY 425-589-4492 dchin@TGBarchitects.com
STRUCTURAL ENGINEER: KPF CONSULTING ENGINEERS 1601 FIFTH AVE. SUITE 1800 SEATTLE, WA 98101	STRUCTURAL ENGINEER CONTACT: GREG HENSLEY 206-526-5454 greg.hensley@kpf.com
MECHANICAL ENGINEER: HARRIS GROUP 20201 CEDAR VALLEY ROAD, SUITE 120 LYNNWOOD, WA 98036	MECHANICAL ENGINEER CONTACT: CHRIS WRIGHT 206-649-2454 chris.wright@harrisgroup.com
ELECTRICAL ENGINEER: AWA ELECTRICAL CONSULTANTS, INC 19015 38TH AVE. W. SUITE E LYNNWOOD, WA 98036	ELECTRICAL ENGINEER CONTACT: BRAD ADCOCK 425-775-1799 brad@awae.com
CIVIL ENGINEER: WH PACIFIC 12100 NE 195TH STREET, SUITE 300 BOTHELL, WA 98011	CIVIL ENGINEER CONTACT: TED EVERAGE 425-351-4555 teverage@whpacific.com
LANDSCAPE ARCHITECT: JONES AND JONES 105 SOUTH MAIN STREET, SUITE 300 SEATTLE, WA 98104	LANDSCAPE ARCHITECT CONTACT: DUANE DIETZ 206-402-8562 ddietz@jonesandjones.com
CULTURAL CONSULTANT: JONES AND JONES 105 SOUTH MAIN STREET, SUITE 300 SEATTLE, WA 98104	CULTURAL CONSULTANT: JOHN PAUL RYAN 206-402-8562 jpryan@jonesandjones.com
ESTIMATOR: RIDER LEVITT BUCKNALL 2003 WESTERN AVENUE, SUITE 515 SEATTLE, WA 98121	ESTIMATOR CONTACT: EMILIE J LEROUX 206-223-0555 emilie.leroux@usrb.com

PHASE 2 DRAWING INDEX

GENERAL	GENERAL INFORMATION
G0 12	
LANDSCAPE	
L1.00	SITE REFERENCE PLAN
L1.10	EAST PLAZA PLAN
L5.00	SITE DETAILS
L5.10	CANOE PROW DETAILS
L6.00	TREE PLANTING PLAN
L6.01	SHRUBS, GRASSES, PERENNIALS, BULBS, FORBS PLANTING PLAN
L6.02	PLANTING DETAILS
L6.03	PLANT SCHEDULE
L7.00	DESIGN/BUILD IRRIGATION PLAN
ARCHITECTURAL	
A0.22	LIFE SAFETY PLANS/CODE ANALYSIS
A0.23	AIR BARRIERS DIAGRAMS
A0.24	UL FIRE RATED ASSEMBLIES
A1.01	ARCHITECTURAL SITE PLAN
A2.11	LOWER LEVEL FLOOR PLAN
A2.12	MAIN LEVEL FLOOR PLAN
A2.13	LOW ROOF PLAN
A2.14	HIGH ROOF PLAN
A2.21	LOWER LEVEL CEILING PLAN
A2.22	MAIN LEVEL LOW CEILING PLAN
A2.23	MAIN LEVEL HIGH CEILING PLAN
A2.31	MAIN LEVEL FINISH PLAN
A2.32	MAIN LEVEL FINISH PLAN
A3.01	EXTERIOR ELEVATIONS
A3.02	EXTERIOR ELEVATIONS
A4.01	BUILDING SECTIONS
A5.01	WALL SECTIONS - NORTH
A5.02	WALL SECTIONS - EAST
A5.03	WALL SECTIONS - SOUTH
A5.04	WALL SECTIONS - WEST
A5.05	ELEVATOR AND STAIR PLANS AND SECTIONS
A5.06	EXTERIOR STAIR PLANS AND SECTIONS
A5.10	EXTERIOR CLADDING SYSTEMS AND TYPICAL DETAILS
A6.01	EXTERIOR DETAILS - SECTION
A6.12	EXTERIOR DETAILS - SECTION
A5.13	EXTERIOR DETAILS - SECTION
A6.10	EXTERIOR DETAILS - PLAN
A5.25	EXTERIOR DETAILS - MISC
A5.30	ROOF DETAILS
A5.31	METAL ROOF AND SKYLIGHT FRAMING AND DETAILS
A5.40	ELEVATOR AND STAIR DETAILS
A5.41	OUTDOOR COOKING PAVILION
A5.60	SUNGLASS CURTAIN WALL
A6.01	LEGENDS & DETAILS - DOOR, WINDOW, AND HARDWARE
A7.02	LEGENDS & DETAILS - PARTITIONS
A7.03	ENLARGED PLANS AND INTERIOR ELEVATIONS - MAIN LEVEL
A7.04	ENLARGED TOILET PLAN AND INTERIOR ELEVATIONS - LOWER LEVEL
A7.05	ENLARGED PLANS AND ELEVATIONS - GATHERING HALL
A7.06	ENLARGED PLANS AND INTERIOR ELEVATIONS - CORRIDORS AND BUFFET
A7.06	ENLARGED PLANS AND INTERIOR ELEVATIONS - LOBBY
A7.06	ENLARGED PLANS AND INTERIOR ELEVATIONS
A8.01	DETAILS (INTERIORS)
A8.02	INTERIOR DETAILS (STAIRS)
A8.03	DETAILS (FINISHES)
A8.04	DETAILS
A8.05	FIRE SUPPRESSION DETAILS
STRUCTURAL	
S0.01	STRUCTURAL NOTES AND DRAWING LIST
S0.02	STRUCTURAL NOTES
S0.03	STRUCTURAL ABBREVIATIONS AND SYMBOLS
S0.11	STATEMENT OF SPECIAL INSPECTIONS
S2.10	LOAD MAP PLANS
S2.11B	FOUNDATION PLAN - PHASE 2
S2.12B	MAIN LEVEL FRAMING PLAN - PHASE 2
S2.13	LOW ROOF FRAMING PLAN
S2.14	ROOF FRAMING PLAN
S2.21	OUTDOOR COOKING PAVILION
S4.02	TYPICAL CONCRETE DETAILS - PHASE 2
S5.01	TYPICAL STEEL DETAILS
S5.02	TYPICAL STEEL DETAILS
S5.11	STEEL DETAILS
S5.12	STEEL DETAILS
S6.01	TYPICAL WOOD DETAILS
S6.02	TYPICAL WOOD DETAILS
S6.03	TYPICAL WOOD DETAILS
S6.04	TYPICAL WOOD DETAILS
S6.10	TYPICAL WOOD DETAILS
S6.11	WOOD DETAILS
MECHANICAL	
MPI.0	COVER SHEET
M1.1	MECHANICAL SCHEDULES
M1.2	ENERGY CODE LOADS
M1.3	ENERGY CODE LOADS
M1.4	SEQUENCE OF OPERATIONS
M3.0	MECHANICAL BASEMENT PLAN HVAC
M3.1	MECHANICAL LEVEL 1 PLAN HVAC
M3.2	MECHANICAL ROOM PLAN HVAC
M3.3	MECHANICAL ROOF PLAN HVAC
M4.0	MECHANICAL SECTIONS-DETAILS
M4.1	DETAILS
M5.1	MECHANICAL CAPTIVE/FAIRE DRAWINGS
M5.2	MECHANICAL CAPTIVE/FAIRE DRAWINGS
M5.3	MECHANICAL CAPTIVE/FAIRE DRAWINGS
M5.4	MECHANICAL CAPTIVE/FAIRE DRAWINGS
M5.5	MECHANICAL CAPTIVE/FAIRE DRAWINGS
M5.6	MECHANICAL CAPTIVE/FAIRE DRAWINGS
M5.7	MECHANICAL CAPTIVE/FAIRE DRAWINGS
M5.8	MECHANICAL CAPTIVE/FAIRE DRAWINGS
M5.9	MECHANICAL CAPTIVE/FAIRE DRAWINGS
M5.10	MECHANICAL CAPTIVE/FAIRE DRAWINGS
M5.11	MECHANICAL CAPTIVE/FAIRE DRAWINGS
M5.12	MECHANICAL CAPTIVE/FAIRE DRAWINGS
PLUMBING	
P1.0	PLUMBING NOTES & SCHEDULES
P2.10	BELOW GRADE PLAN - PLUMBING
P2.10	BASEMENT PLAN - PLUMBING
P2.11	ENLARGED BASEMENT PLAN - PLUMBING
P2.20	LEVEL 1 PLAN - PLUMBING
P2.21	ENLARGED LEVEL 1 PLAN - PLUMBING
P3.0	DETAILS
ELECTRICAL	
E1.0	ELECTRICAL COVER SHEET
E1.1	ELECTRICAL SITE UTILITY PLAN
E1.2	ELECTRICAL SITE LIGHTING
E1.3	ELECTRICAL SITE DATA & SECURITY
E2.1	LOWER LEVEL FLOOR PLAN LIGHTING
E2.2	MAIN LEVEL FLOOR PLAN LIGHTING
E2.3	LIGHTING CONTROLS & DETAILS
E2.4	LIGHTING CONTROLS ONE-LINE
E3.1	LOWER LEVEL FLOOR PLAN POWER
E3.2	MAIN LEVEL FLOOR PLAN POWER
E3.3	ROOF PLAN PHOTOVOLTAIC
E3.4	ENLARGED KITCHEN PLAN POWER
E3.5	ELEVATOR DETAILS
E4.1	LOWER LEVEL - FLOOR PLAN HVAC
E4.2	MAIN LEVEL - FLOOR PLAN HVAC
E4.3	ROOF PLAN HVAC
E4.4	LOWER LEVEL MECHANICAL ROOM POWER
E5.1	LOWER LEVEL FLOOR PLAN SPECIAL SYSTEMS
E5.2	MAIN LEVEL FLOOR PLAN SPECIAL SYSTEMS
E5.3	SPECIAL SYSTEMS DETAILS
E5.0	ELECTRICAL ONE-LINE DIAGRAM
E6.1	ELECTRICAL PANEL SCHEDULES
E6.2	ELECTRICAL PANEL SCHEDULES
KITCHEN	
FS-1.0	KITCHEN FUNCTIONAL FLOOR PLAN
FS-1.1	EQUIPMENT KEVED FLOOR PLAN
FS-2.0	KITCHEN EQUIPMENT SCHEDULE
FS-2.1	KITCHEN EQUIPMENT SCHEDULE
FS-3.0	PLUMBING ROUGH-IN PLAN
FS-4.0	ELECTRICAL ROUGH-IN PLAN
FS-5.0	REFRIGER COMPRESSORS FOR THE WALK-IN COOLER AND FREEZER
FS-5.3	WALK-IN COOLER AND FREEZER
FS-6.0	KITCHEN ELEVATIONS



t 425.778.1530 21911 76th Ave W. Ste 210
f 425.774.7803 Edmonds WA 98026
info@tgbarchitects.com
www.tgbarchitects.com

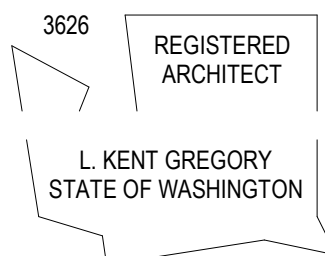

TULALIP TRIBES GATHERING HALL

7512 TOTEM BEACH RD
TULALIP, WA 98271

PHASE 2 - BUILDING AND LANDSCAPING

GENERAL INFORMATION

[illegible]

PROJECT INFORMATION	
PROJECT NUMBER:	17031
PROJECT LEAD:	Designer
DRAWN BY:	Author

SHEET NO

G0.12



This architectural section drawing shows a building with a gabled roof. The roof is supported by a series of trusses or rafters. The interior space is divided into several sections by vertical walls. On the left, there is a lower section with a flat roof. The main part of the building has a higher ceiling. The drawing uses solid lines for walls and roof, and dashed lines for the ground level and foundation. There are small circles on the roofline, possibly representing ventilation or lighting fixtures. The ground is indicated by a hatched pattern at the bottom.

This architectural floor plan depicts a long, narrow hall, likely a lecture hall or a small theater. The hall is oriented horizontally. At the right end, there is a raised platform or stage area, indicated by a dashed line and a small rectangular structure. Along the left wall, there is a row of small, rectangular tables or desks, each with a chair, suggesting a seating arrangement for an audience or students. The right wall is mostly blank, with a small rectangular structure at the far right end. The floor is represented by a dashed line, and the walls are shown as solid lines. The overall layout is simple and functional, designed for a large group of people to be seated and facing a common point of interest at the right end of the hall.

ROOF AIR PRESSURE BOUNDARY

ROOF AREA (A): 7,310.00 SF
ROOF AREA (B): 23,916.13 SF

TOTAL AREA: 31,226.13 SF

MAIN LEVEL AIR PRESSURE BOUNDARY

SLAB ON GRADE: 2,852 SF
WALL AREA (BUILDING A): 264'-6" X 14'-0" = 3,703 SF
WALL AREA (AREA B):
NORTH: 3,332 SF
EAST: 4,674.375 SF
SOUTH: 3,332 SF
WEST: 2,145 SF

TOTAL AREA: 20,038.375 SF

LOWER LEVEL AIR PRESSURE BOUNDARY

ELEVATOR PIT WALLS: 45'-0" X 5' = 225 SF
FOUNDATION WALLS: 710'-0" X 14' - 6" = 10,295 SF
SLAB ON GRADE: 27,677 SF

TOTAL AREA: 38,197 SF

The floor plan illustrates the layout of the 1st floor, which is primarily composed of a large 'GATHERING HALL' and a smaller 'AREA B'. The 'GATHERING HALL' is centrally located and contains numerous bookshelves and tables. 'AREA B' is situated below the main hall and also features bookshelves and tables. The top of the plan shows a 'RECEPTION' area, a 'STAIRS' area, and a 'RESTROOMS' area. The right side of the plan includes a 'SERVICES' area and another 'STAIRS' area. The bottom right corner contains a 'STAIRS' area and a 'RESTROOMS' area. The plan also shows various bookshelves, tables, and chairs arranged throughout the space.



3626 REGISTERED ARCHITECT
L. KENT GREGORY
STATE OF WASHINGTON

AIR BARRIER DIAGRAMS

PROJECT INFORMATION	
PROJECT NUMBER:	17031
PROJECT LEAD:	DC
DRAWN BY:	AB

A0.23

7512 TOTEM BEACH RD
TULALIP, WA 98271

PHASE 2 - BUILDING AND LANDSCAPING


ARCHITECTURAL SITE PLAN

[illegible]

PROJECT INFORMATION	
PROJECT NUMBER:	1703
PROJECT LEAD:	DO
DRAWN BY:	AS


SHEET NO

A1.01

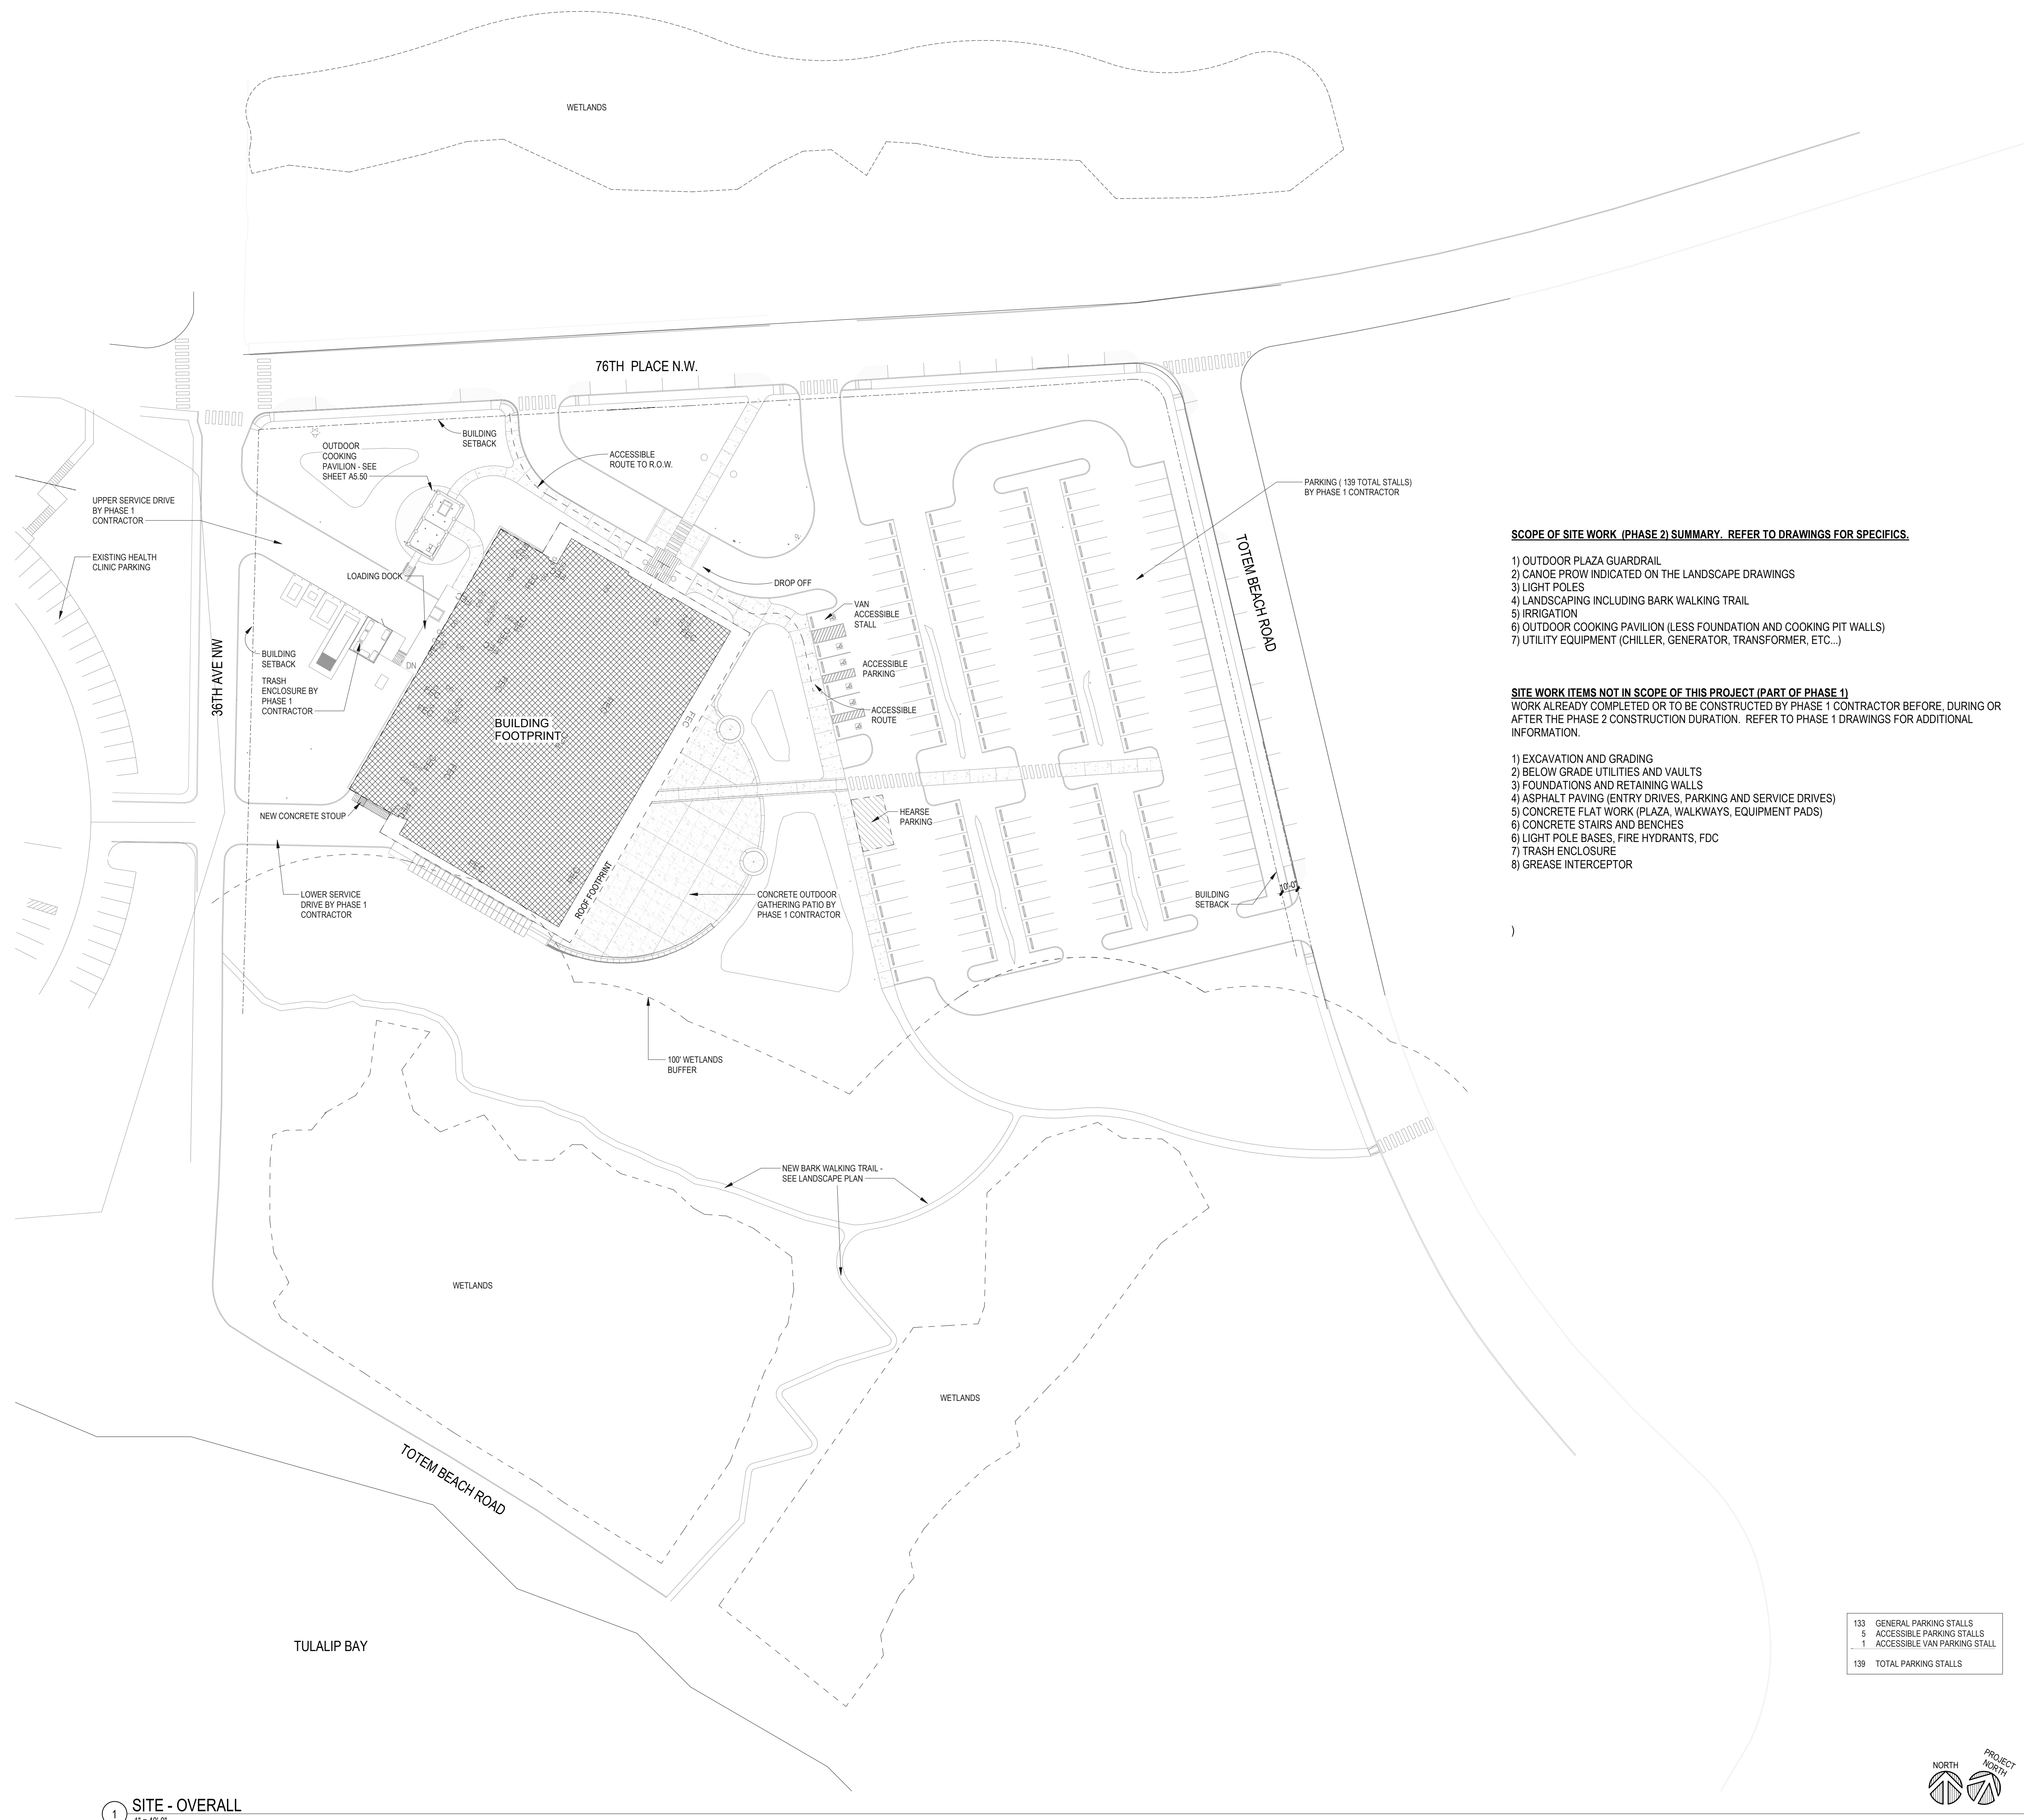

[illegible]

PROJECT INFORMATION	
PROJECT NUMBER:	1703
PROJECT LEAD:	DO
DRAWN BY:	AS

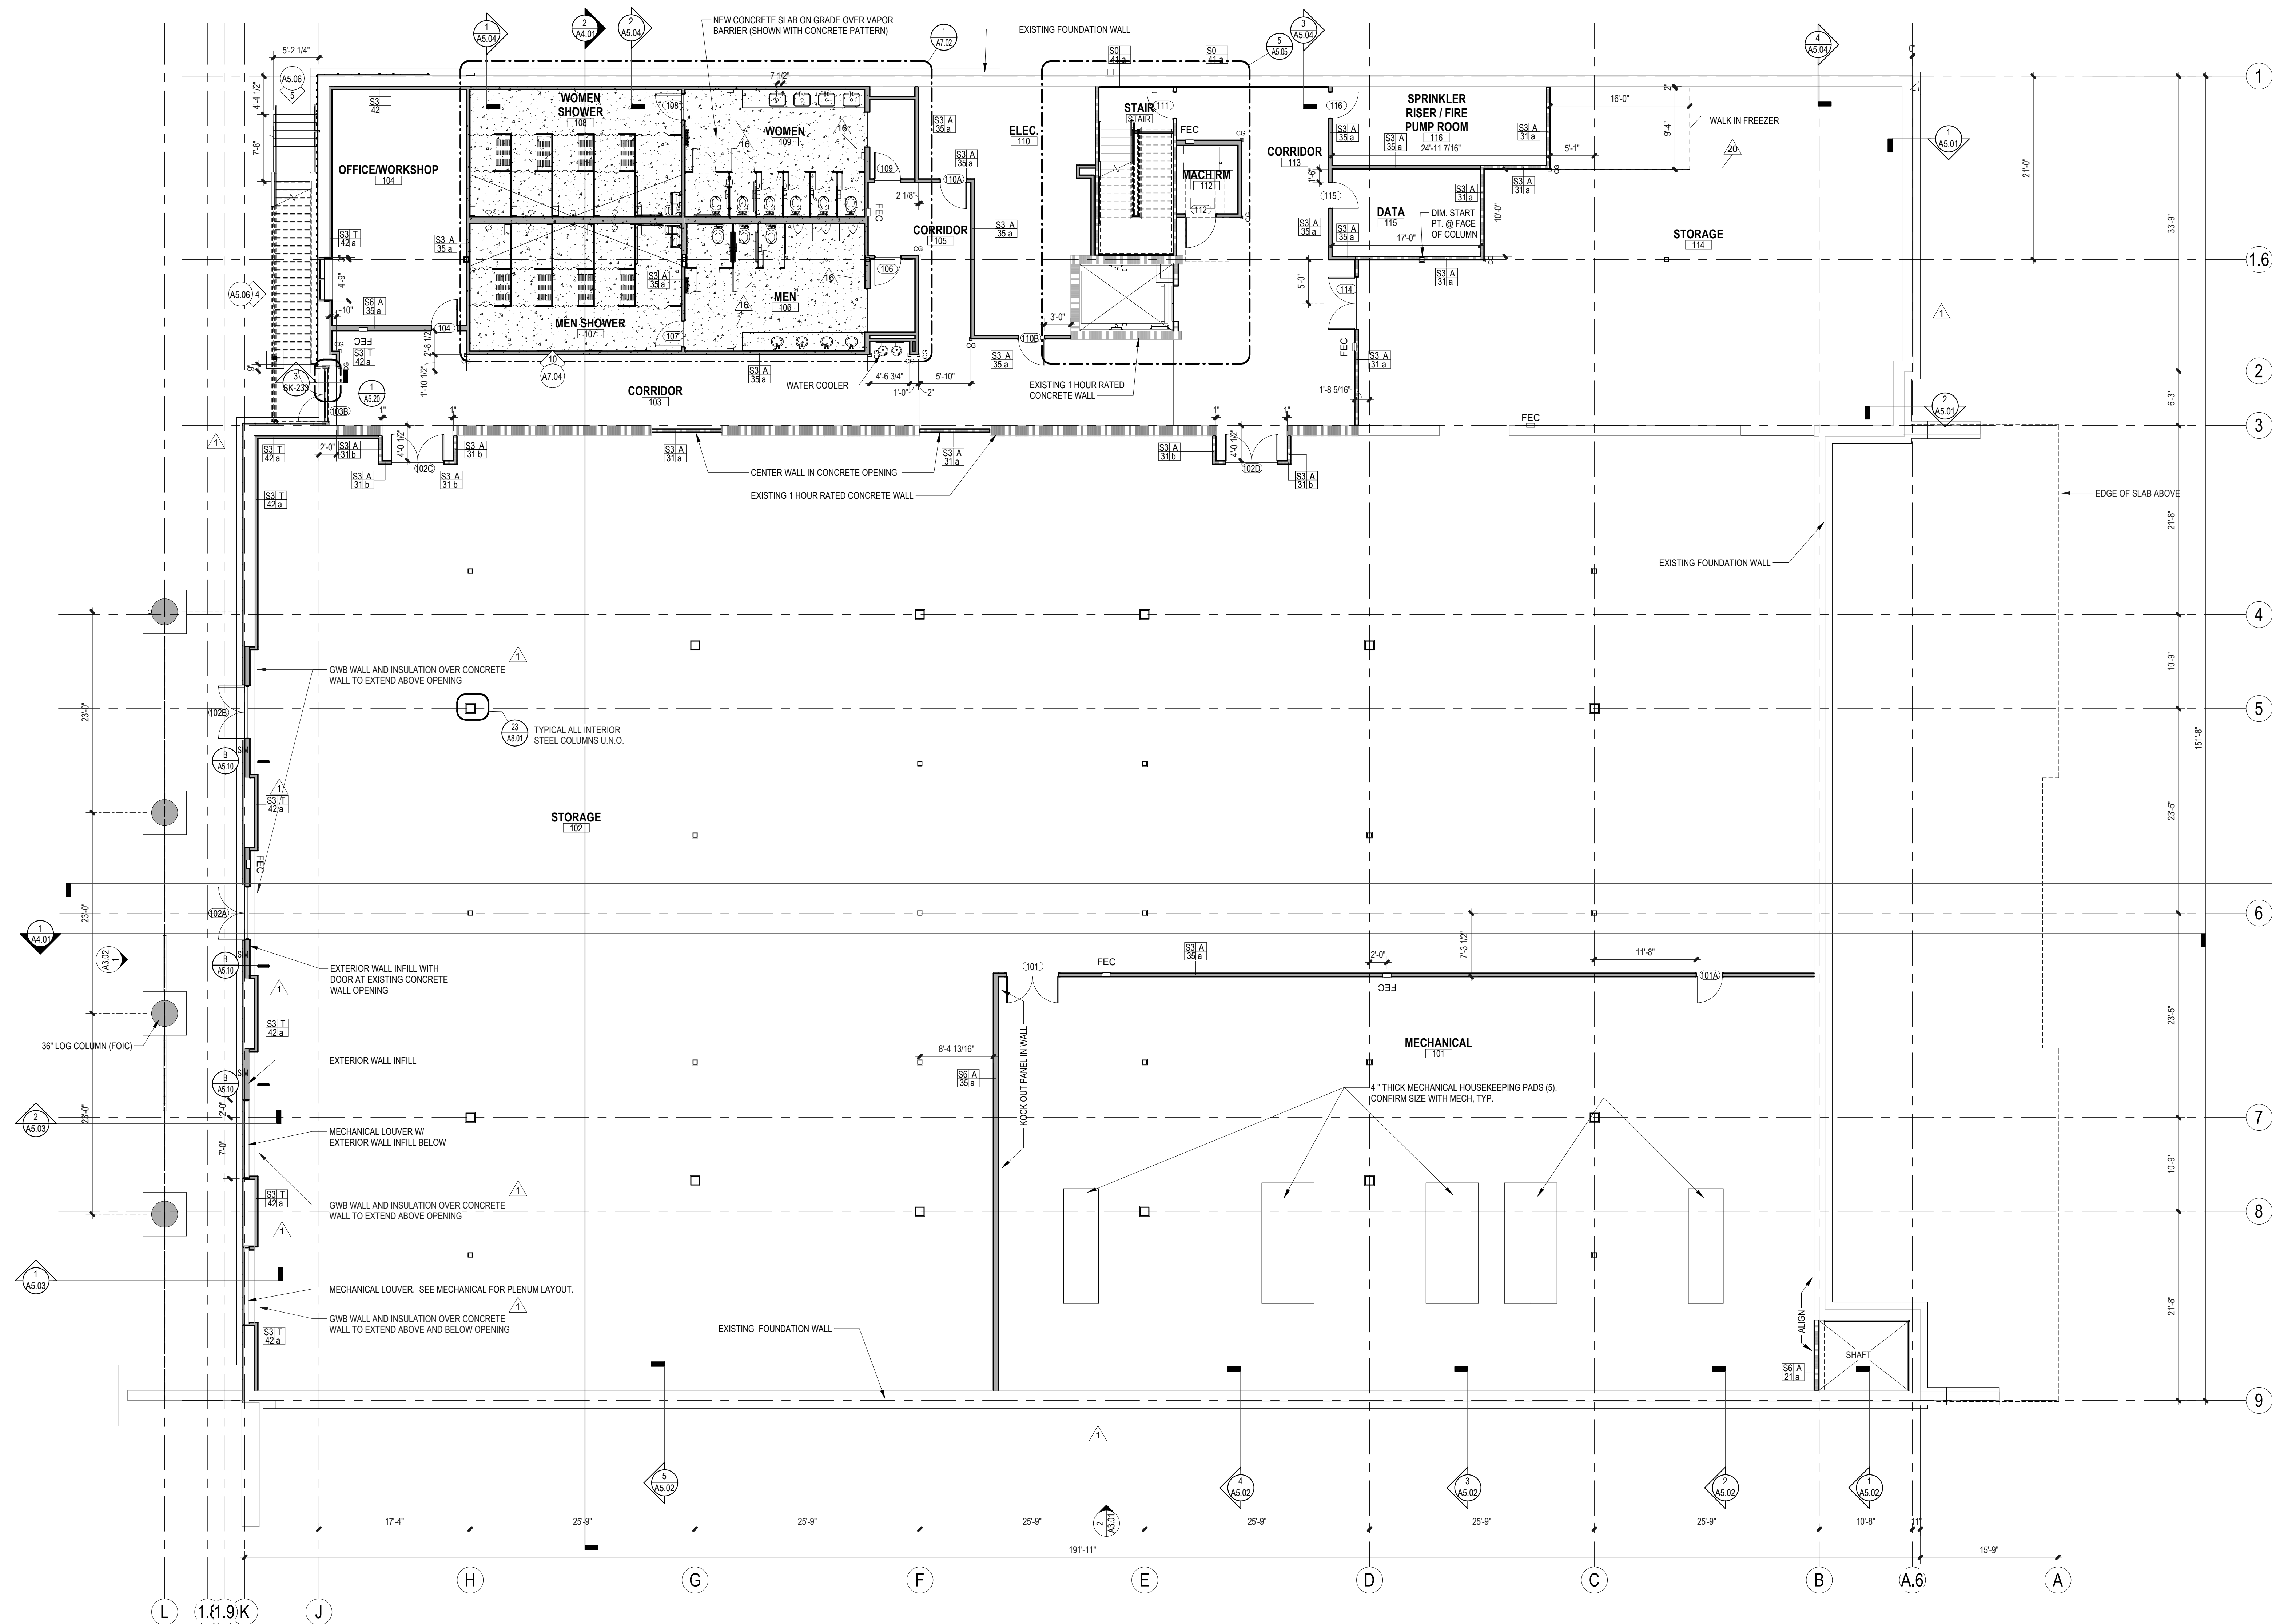

1 LOWER LEVEL - FLOOR PLAN
1/8" = 1'-0"

TULALIP TRIBES
GATHERING HALL

7512 TOTEM BEACH RD
TULALIP, WA 98271


PHASE 2 - BUILDING AND
LANDSCAPING

MAIN LEVEL
FLOOR PLAN

ISSUANCE		
No.	Description	Date
1	PH 2 PERMIT SET	08/16/18
2	PH 2 BID SET	10/08/18
3	ADDENDUM 3	11/14/18
4	PH 2 PERMIT COMMENTS	12/12/18
5	ADDENDUM 7	01/04/19
6	PH 2 PERMIT REVIEW 2019	01/04/19
7	PH 2 ASI 3	06/19/19
8	RFI 87-065	07/02/19
9	RFI 94-070	08/28/19
10	RFI 102-069	08/28/19
11	PH 2 CCD 5	08/22/19
12	PH 2 CONFORM SET	10/14/19
13	PH 2 CCD 13	12/10/19
14	PH 2 ASI 6	01/06/20
15	PH 2 CCD 15	03/02/20
16	PH 2 RECORD SET	06/02/20

PROJECT INFORMATION
PROJECT NUMBER: 17031
PROJECT LEAD: DC
DRAWN BY: AB

SHEET NO

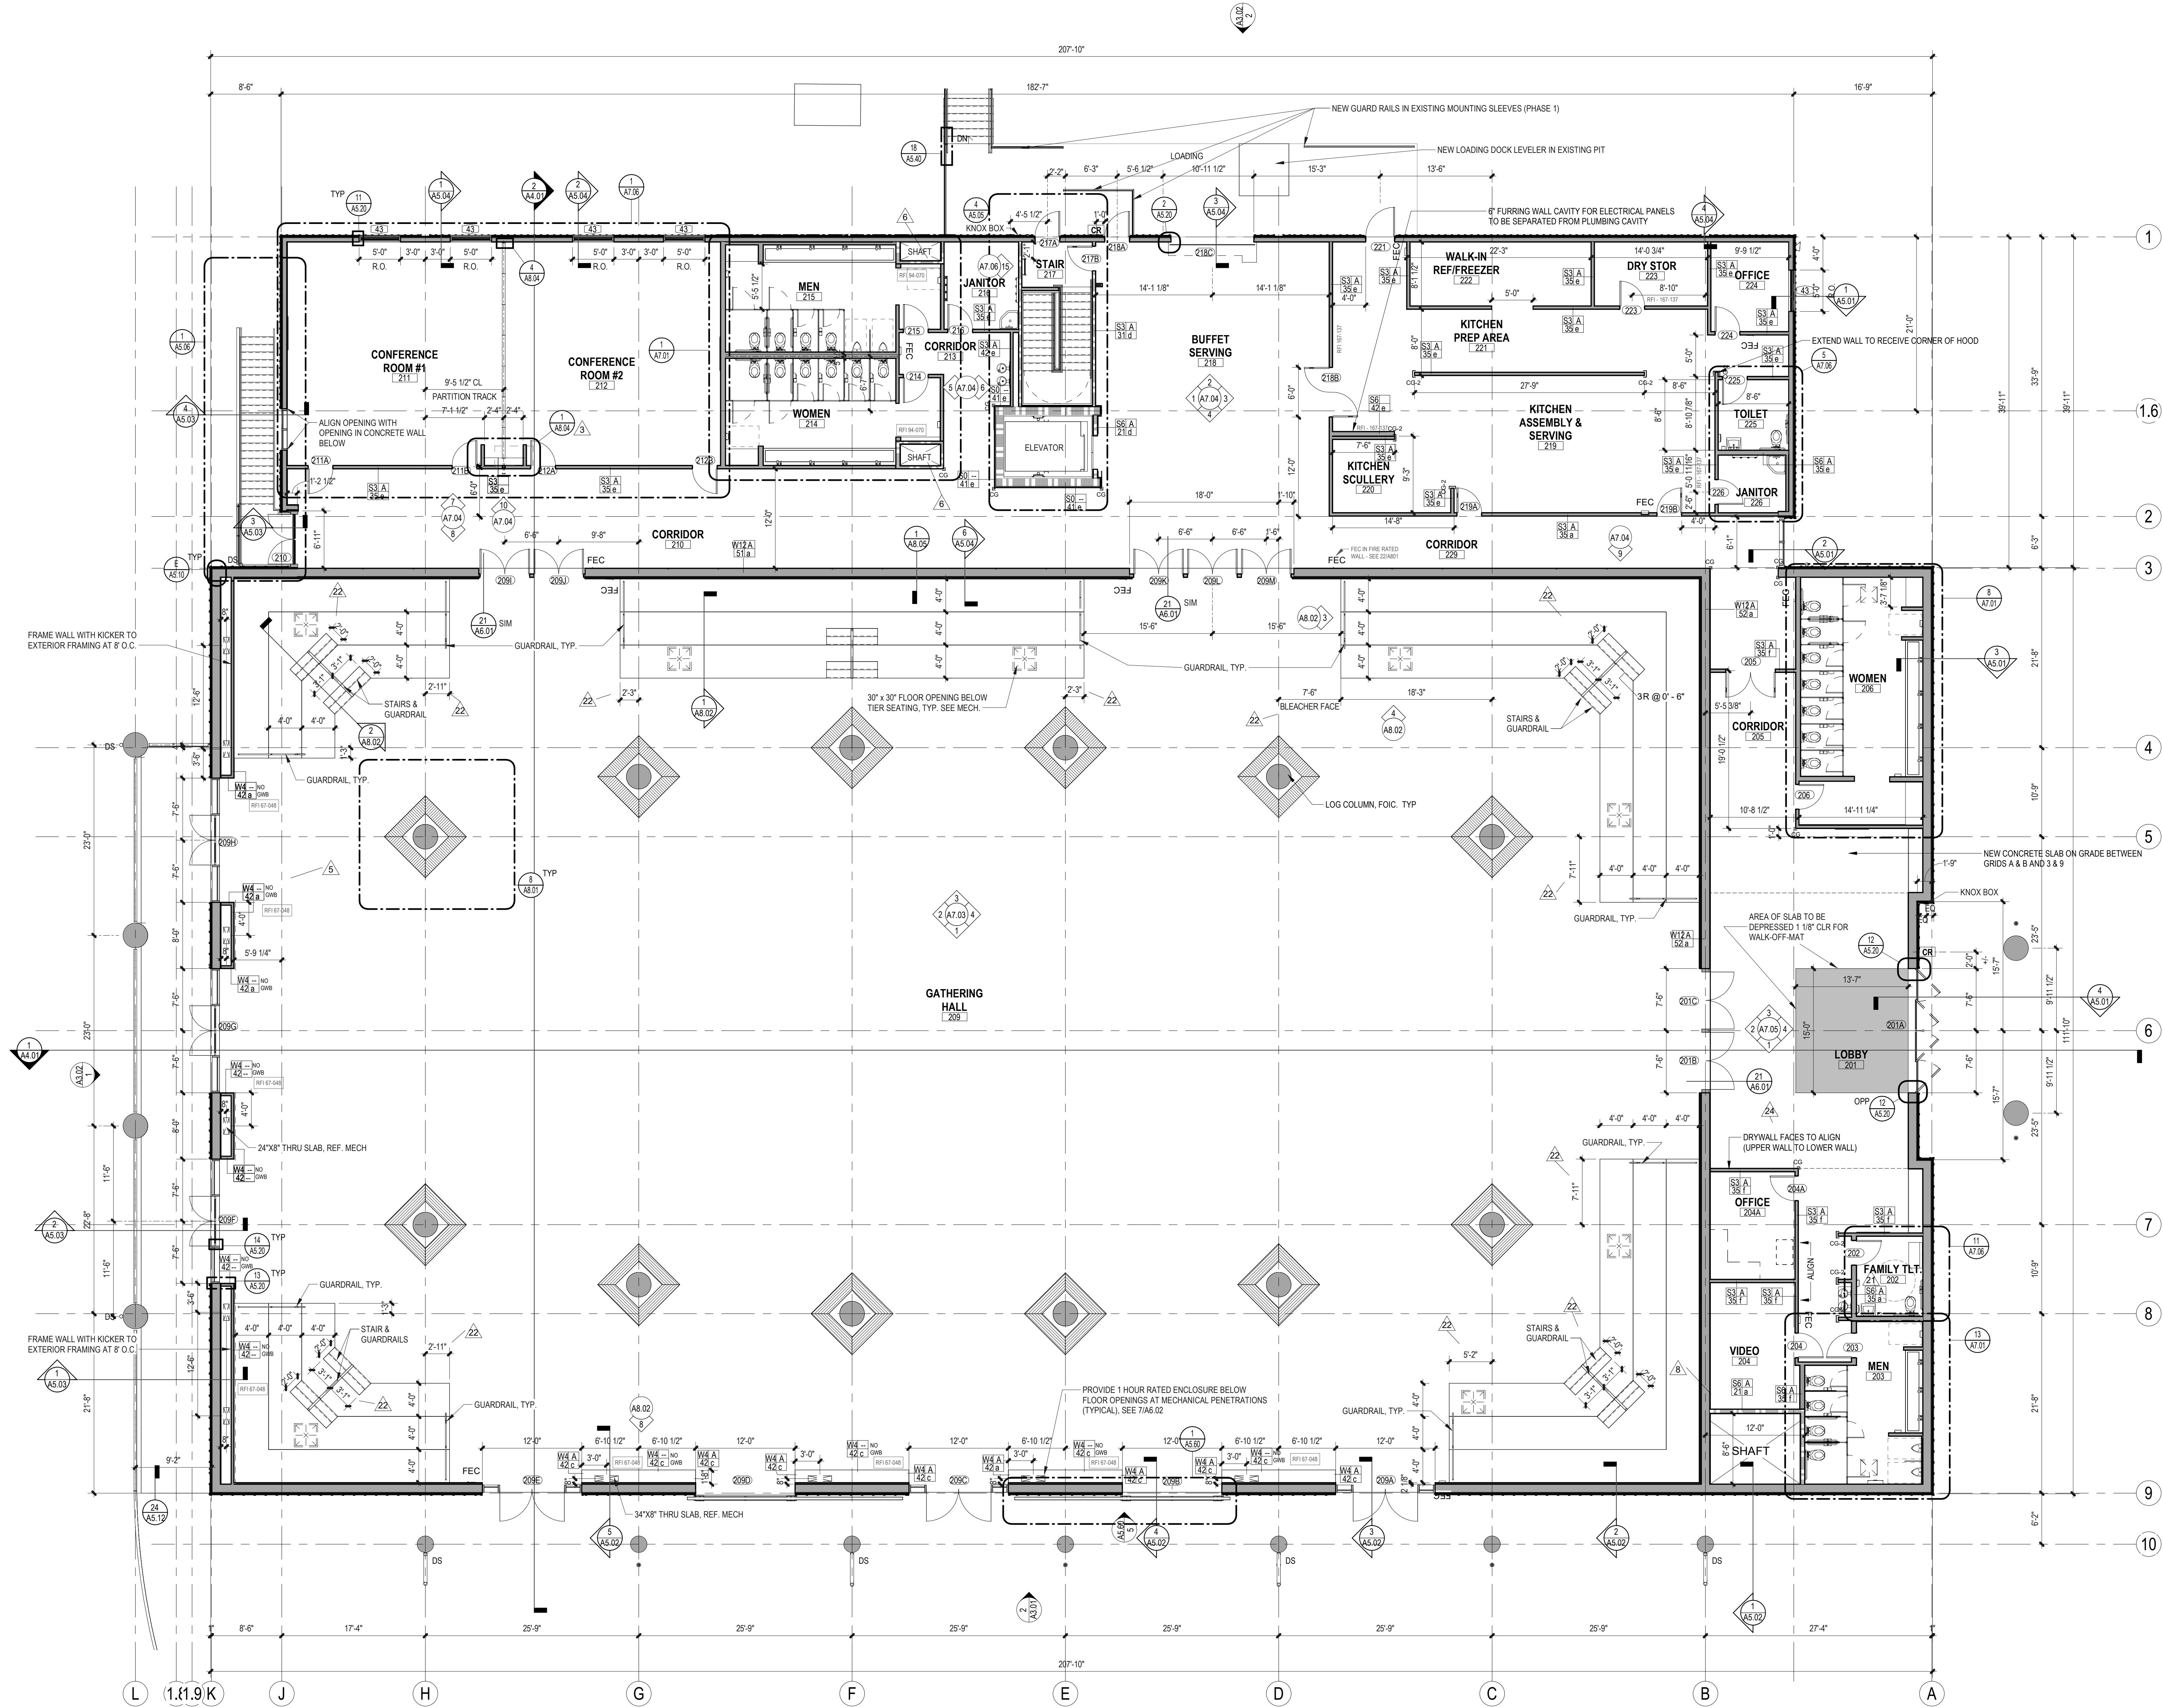

1 FLOOR PLAN - MAIN LEVEL
1/8" = 1'-0"





[illegible]

PROJECT INFORMATION	
PROJECT NUMBER:	17031
PROJECT LEAD:	DC
DRAWN BY:	AB


EAST HIGH ROOF DOWNSPOUTS -
 PLAIN AREA - 67'-0" X 217'-9" = 14,590 SQ. FT.
 PER TABLE 1-1 OF SMACNA - DESIGN AREA FOR PITCHED ROOF FACTOR OF 3 INIFT IS A FACTOR OF 1.00
 DESIGN AREA OF ROOF = 14,590 SQ. FT.
 (3) DOWNSPOUTS ARE LOCATED EQUALLY SPACED ON EAST ROOF, MAKING THE AREA SERVED BY EACH DOWNSPOUT 4,864 SQ. FT.
 PER COLUMN B OF TABLE 1-2, THE ROOF AREA DRAINED PER DOWNSPOUT IN SEATTLE, WA (WITH AN INTENSITY FACTOR OF 3.3 IN/HR) IS 3660 SQ. FT./SQ. IN.
 4,864 SQ. FT. / 3660 SQ. FT./SQ. IN. = 1.33 IN. REQUIRED DOWNSPOUT
 PER TABLE 1-3, A 5" PLAIN ROOF DOWNSPOUT PROVIDES AN AREA OF 17,711 SQ. IN. DESIGN TO UTILIZE 5" PLAIN ROOF DOWNSPOUTS

WEST HIGH ROOF - (67'-0" X 217'-9") - (8'-0" X 152'-6") = 13,370 SQ. FT.
PLAIN AREA - (67'-0" X 217'-9") - (8'-0" X 152'-6") = 13,370 SQ. FT.
PER TABLE 1-1 OF SMACNA - DESIGN AREA FOR PITCHED ROOF DUE TO 3 IN/FT IS A FACTOR OF 1.00
DESIGN AREA OF ROOF = 13,370 SQ. FT.
(4) DOWNSPUTS ARE NOT LOCATED EQUALLY SPACED ON WEST ROOF, DUE TO THE IRREGULAR SHAPE. THE LARGEST AREA SERVED PER DOWNSPUT IS \$9072 SQ FT / 2 = 4536 SQ FT. PER COLUMN 8 OF TABLE 1-2, THE ROOF AREA DRAINED PER DOWNSPUT IN SEATTLE, WA (WITH AN INTENSITY FACTOR OF 3.3 IN/HR) IS 3809 SQ FT. / SQ. IN.
PER COLUMN 8 OF TABLE 1-2, THE ROOF AREA DRAINED PER DOWNSPUT IN SEATTLE, WA (WITH AN INTENSITY FACTOR OF 3.3 IN/HR) IS 3809 SQ FT. / SQ. IN.
PER TABLE 1-3, A 5" PLAIN ROOF DOWNSPUT PROVIDES AN AREA OF 1771 SQ. IN. DESIGN TO UTILIZE 5" PLAIN ROOF DOWNSPUTS

EAST HIGH ROOF GUTTER SIZING -
AREA (A) OF EAST ROOF IS 14,590 SQ. FT
RAINFALL INTENSITY FACTOR (I) PER TABLE 1-2 IS 3.3 IN/HR
 $I \times A = 48,147$
LENGTH (L) OF GUTTER AT MAX = 38'-3"
RATIO (M) OF DEPTH/WIDTH OF GUTTER = 1.0
PER CHART 1-1, THE MIN. WIDTH OF GUTTER IS 10" FOR RECTANGULAR GUTTER

WEST HIGH ROOF GUTTER SIZING -
 AREA (A) OF EAST ROOF IS 13,370 SQ. FT
 RAINFALL INTENSITY FACTOR (I) PER TABLE 1-2 IS 3.3 IN/H
 I X A = 44,121
 LENGTH (L) OF GUTTER AT MAX = 46'-3"
 RATIO (M) OF DEPTH/WIDTH OF GUTTER = 1.0
 PER CHART 1-1, THE MIN. WIDTH OF GUTTER IS 10" FOR RECTANGULAR GUTTER

SEE SHEET A2.13 FOR LOW ROOF PLAN

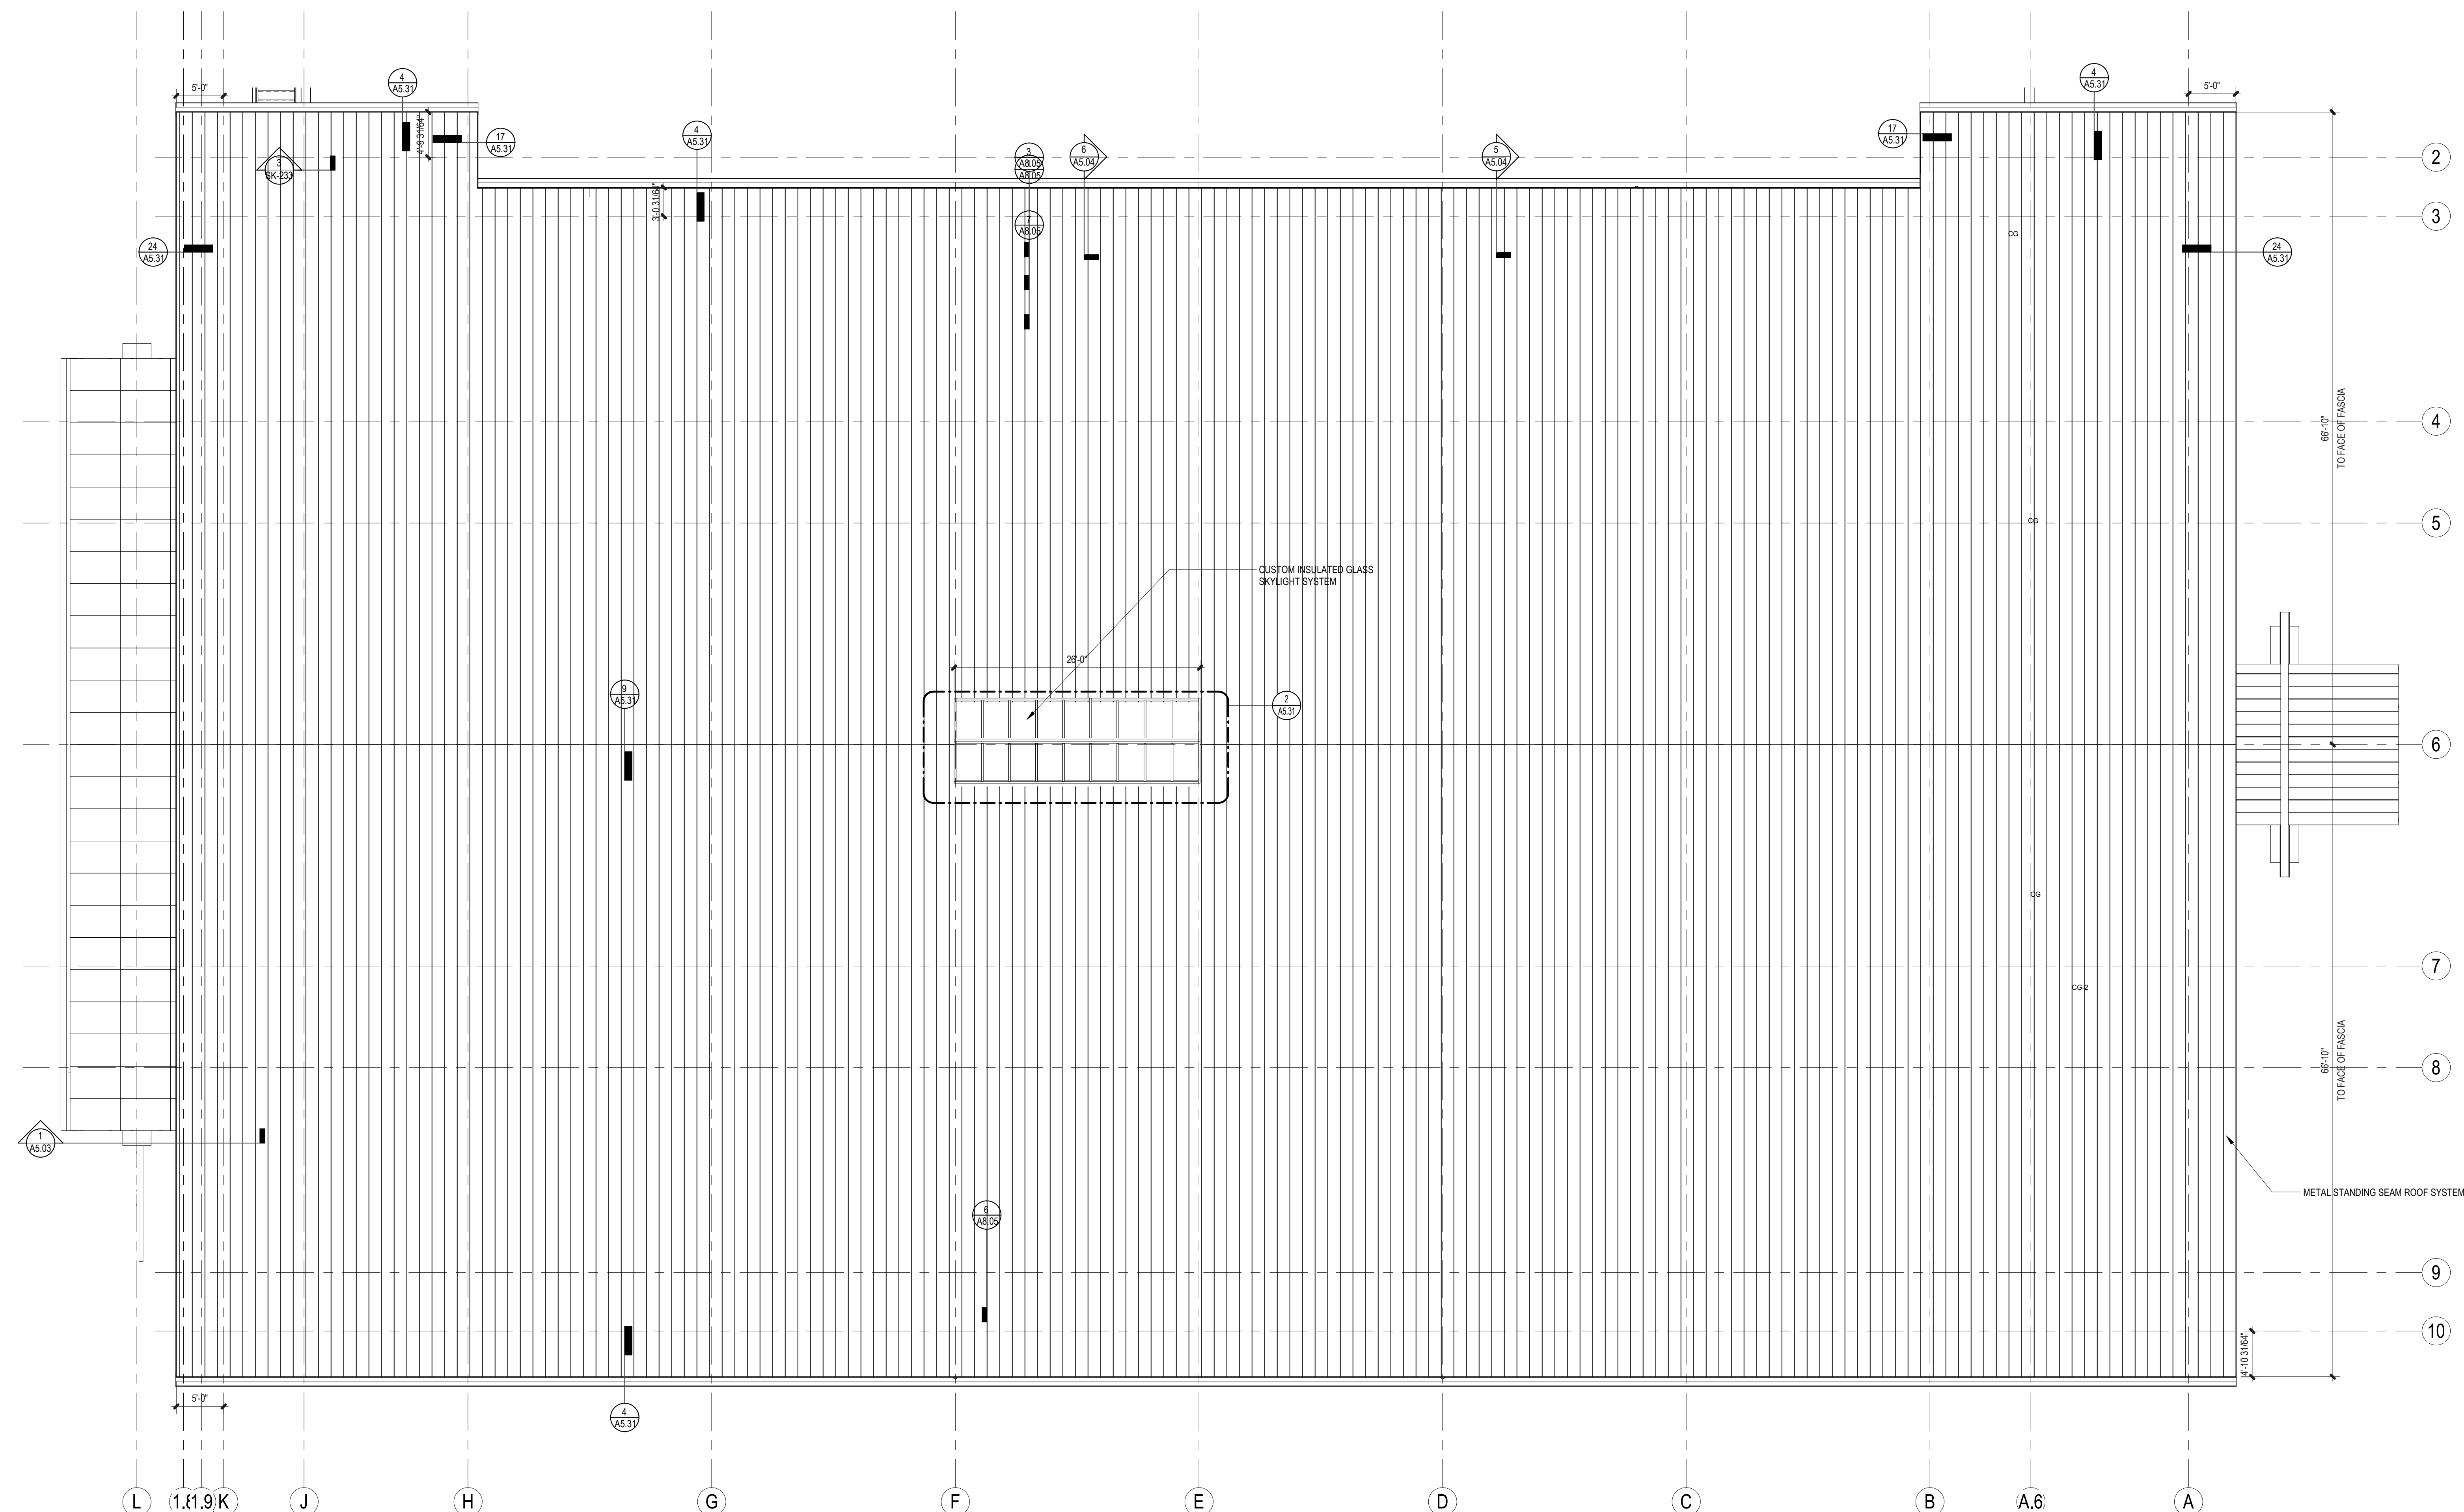

1 HIGH ROOF PLAN
1/8" = 1'-0"

7512 TOTEM BEACH RD
TULALIP, WA 98271

LOWER LEVEL CEILING PLAN


ISSUANCE		
No.	Description	Date
	PH 2 PERMIT SET	08/16/18
	PH 2 BID SET	10/08/18
	ADDENDUM 3	11/14/18
	PH 2 PERMIT REVIEW 2019	01/04/19
	PH 2 CONFORM SET	10/14/19
	PH 2 RECORD SET	06/02/20

PROJECT INFORMATION	
PROJECT NUMBER:	17031
PROJECT LEAD:	DC
DRAWN BY:	JLO



***SEE ELECTRICAL PLANS FOR
EXIT LIGHT LOCATIONS**

A2.21

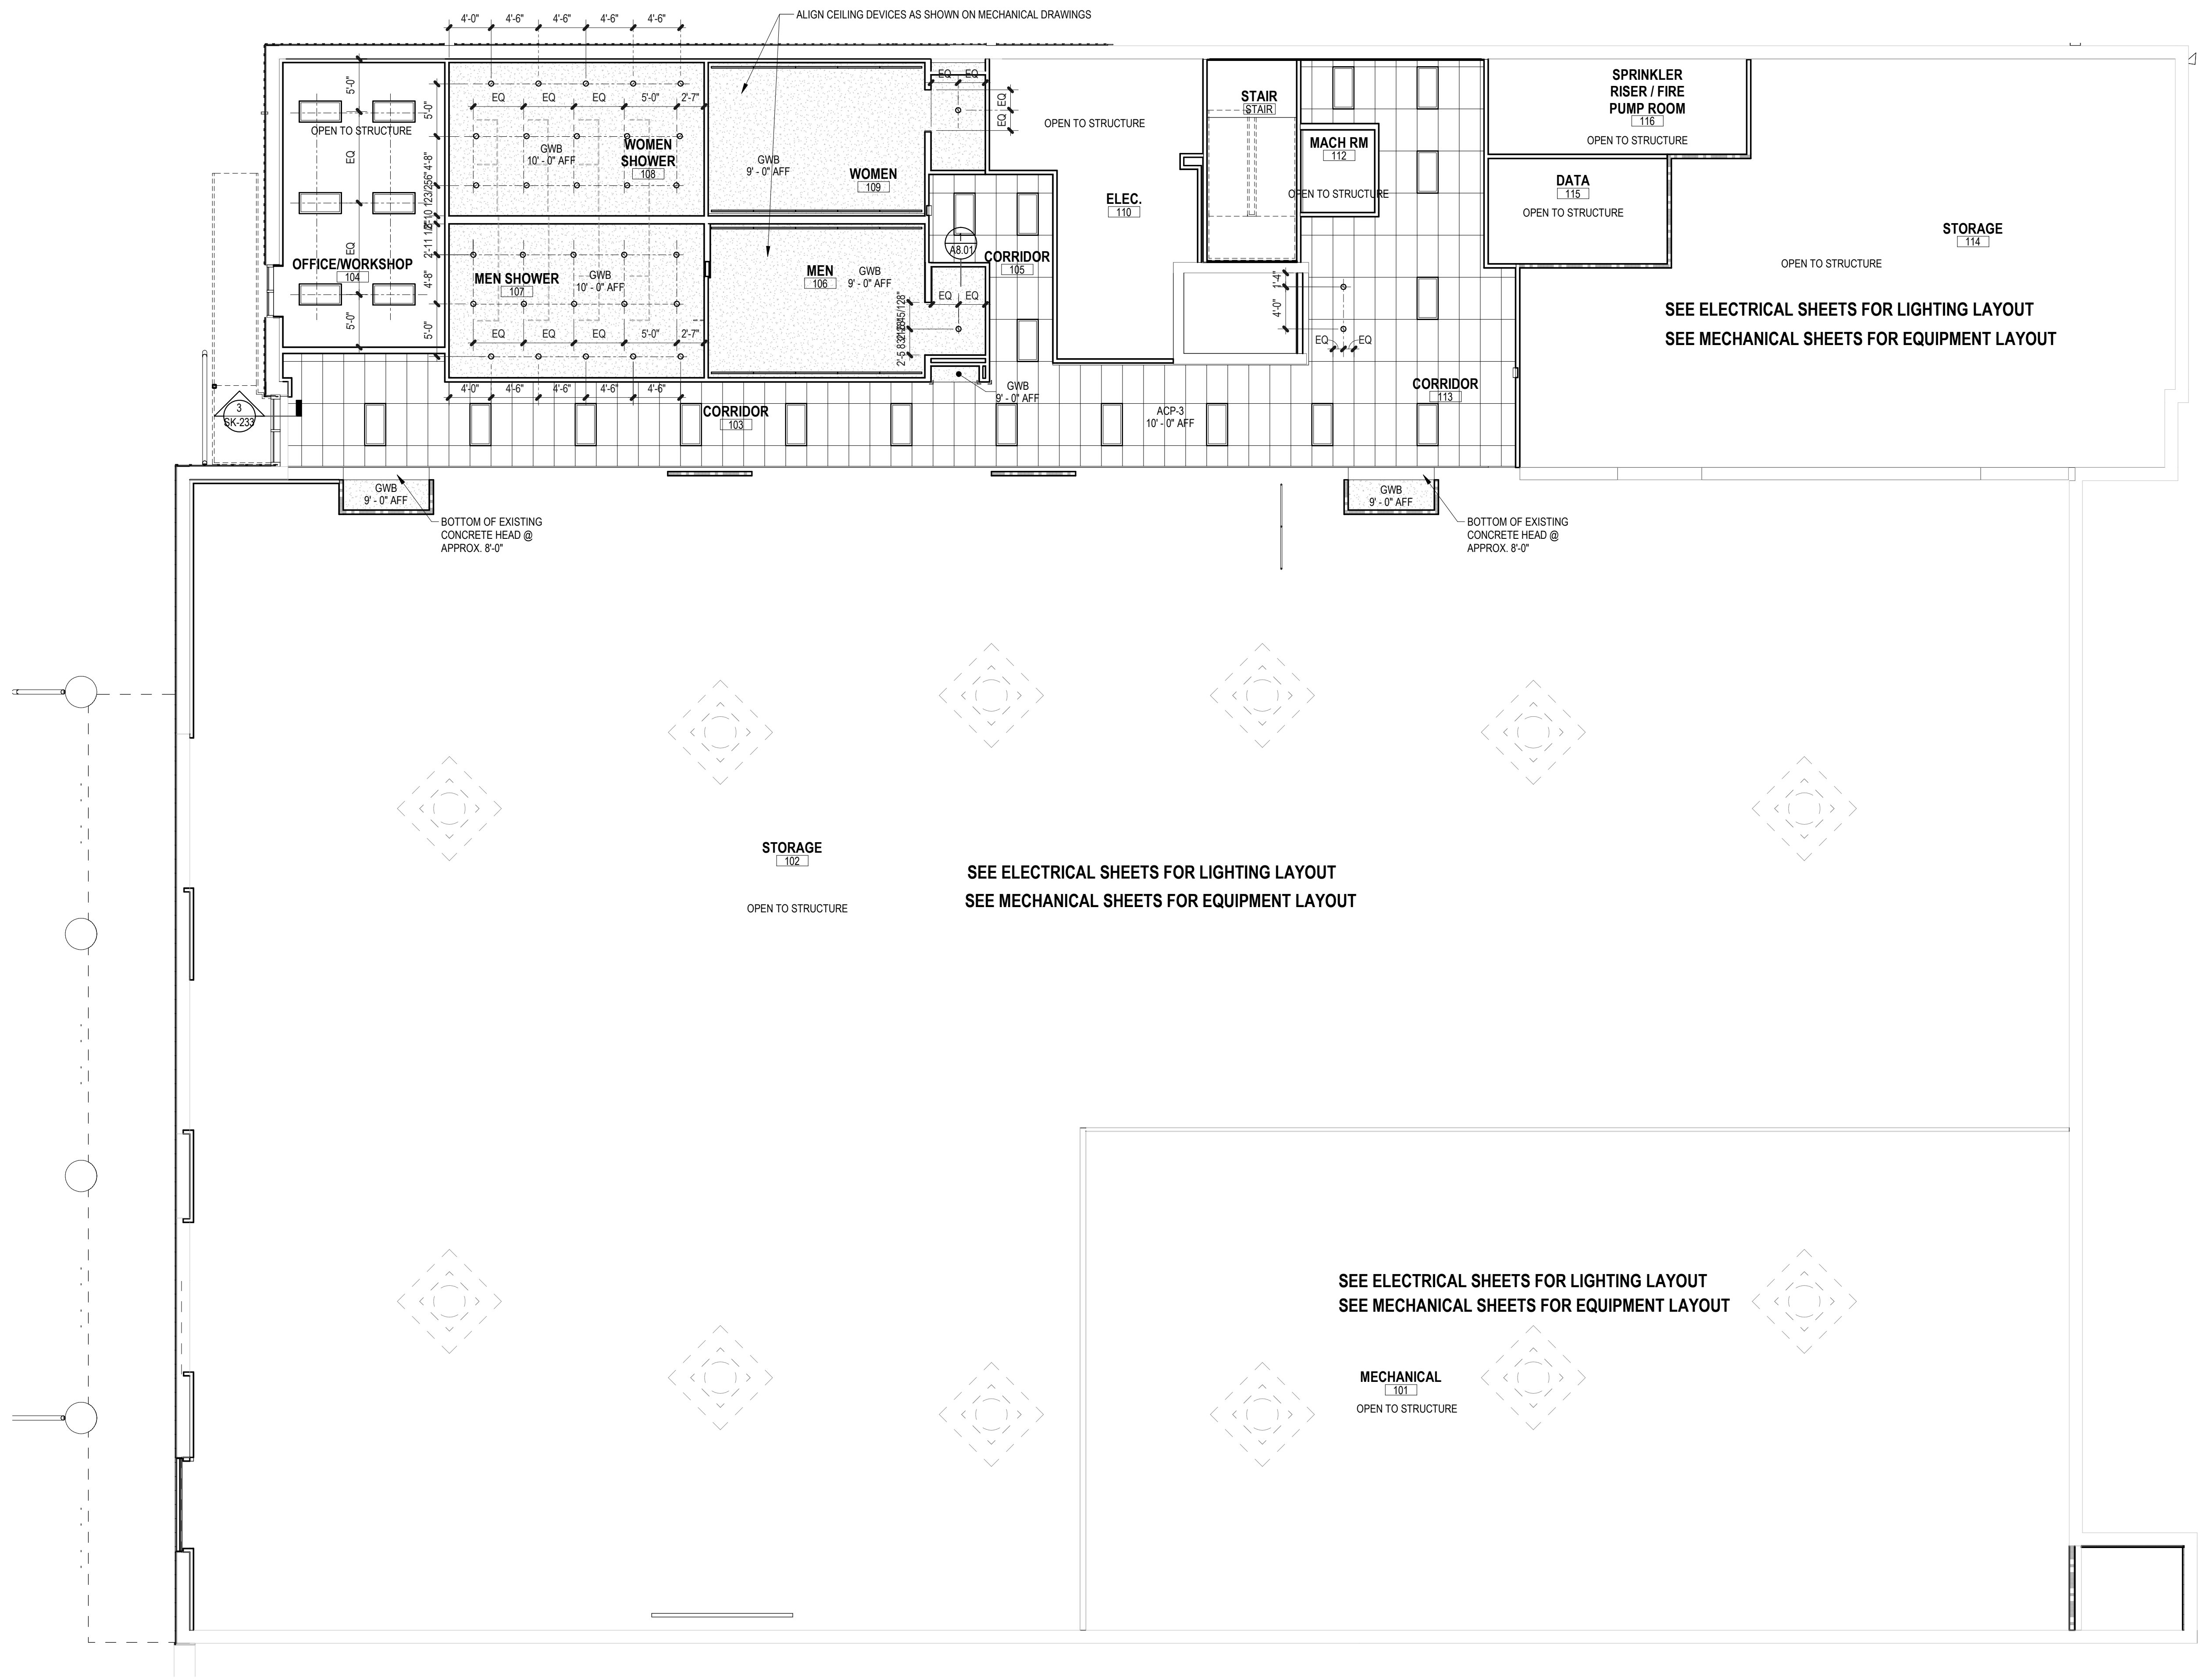

1 LOWER LEVEL - REFLECTED CEILING PLAN
1/8" = 1'-0"

7/7/2020 12:42:48 PM C:\Users\mzgorski\Documents\17031 Tulalip Gathering Hall-Central_mzgorski@TGBArchitects.com.rvt

7512 TOTEM BEACH RD
TULALIP, WA 98271

PHASE 2 - BUILDING AND LANDSCAPING

[illegible]

PROJECT INFORMATION	
PROJECT NUMBER:	17031
PROJECT LEAD:	DC
DRAWN BY:	JLO

SHEET NO. _____



1 REFLECTED CEILING PLAN - MAIN LEVEL (LOW CEILINGS)
1/8" = 1'-0"

7512 TOTEM BEACH RD
TULALIP, WA 98271


PHASE 2 - BUILDING AND LANDSCAPING

MAIN LEVEL HIGH CEILING PLAN

[illegible]

PROJECT INFORMATION	
PROJECT NUMBER:	17031
PROJECT LEAD:	DC
DRAWN BY:	JLO

SHEET NO

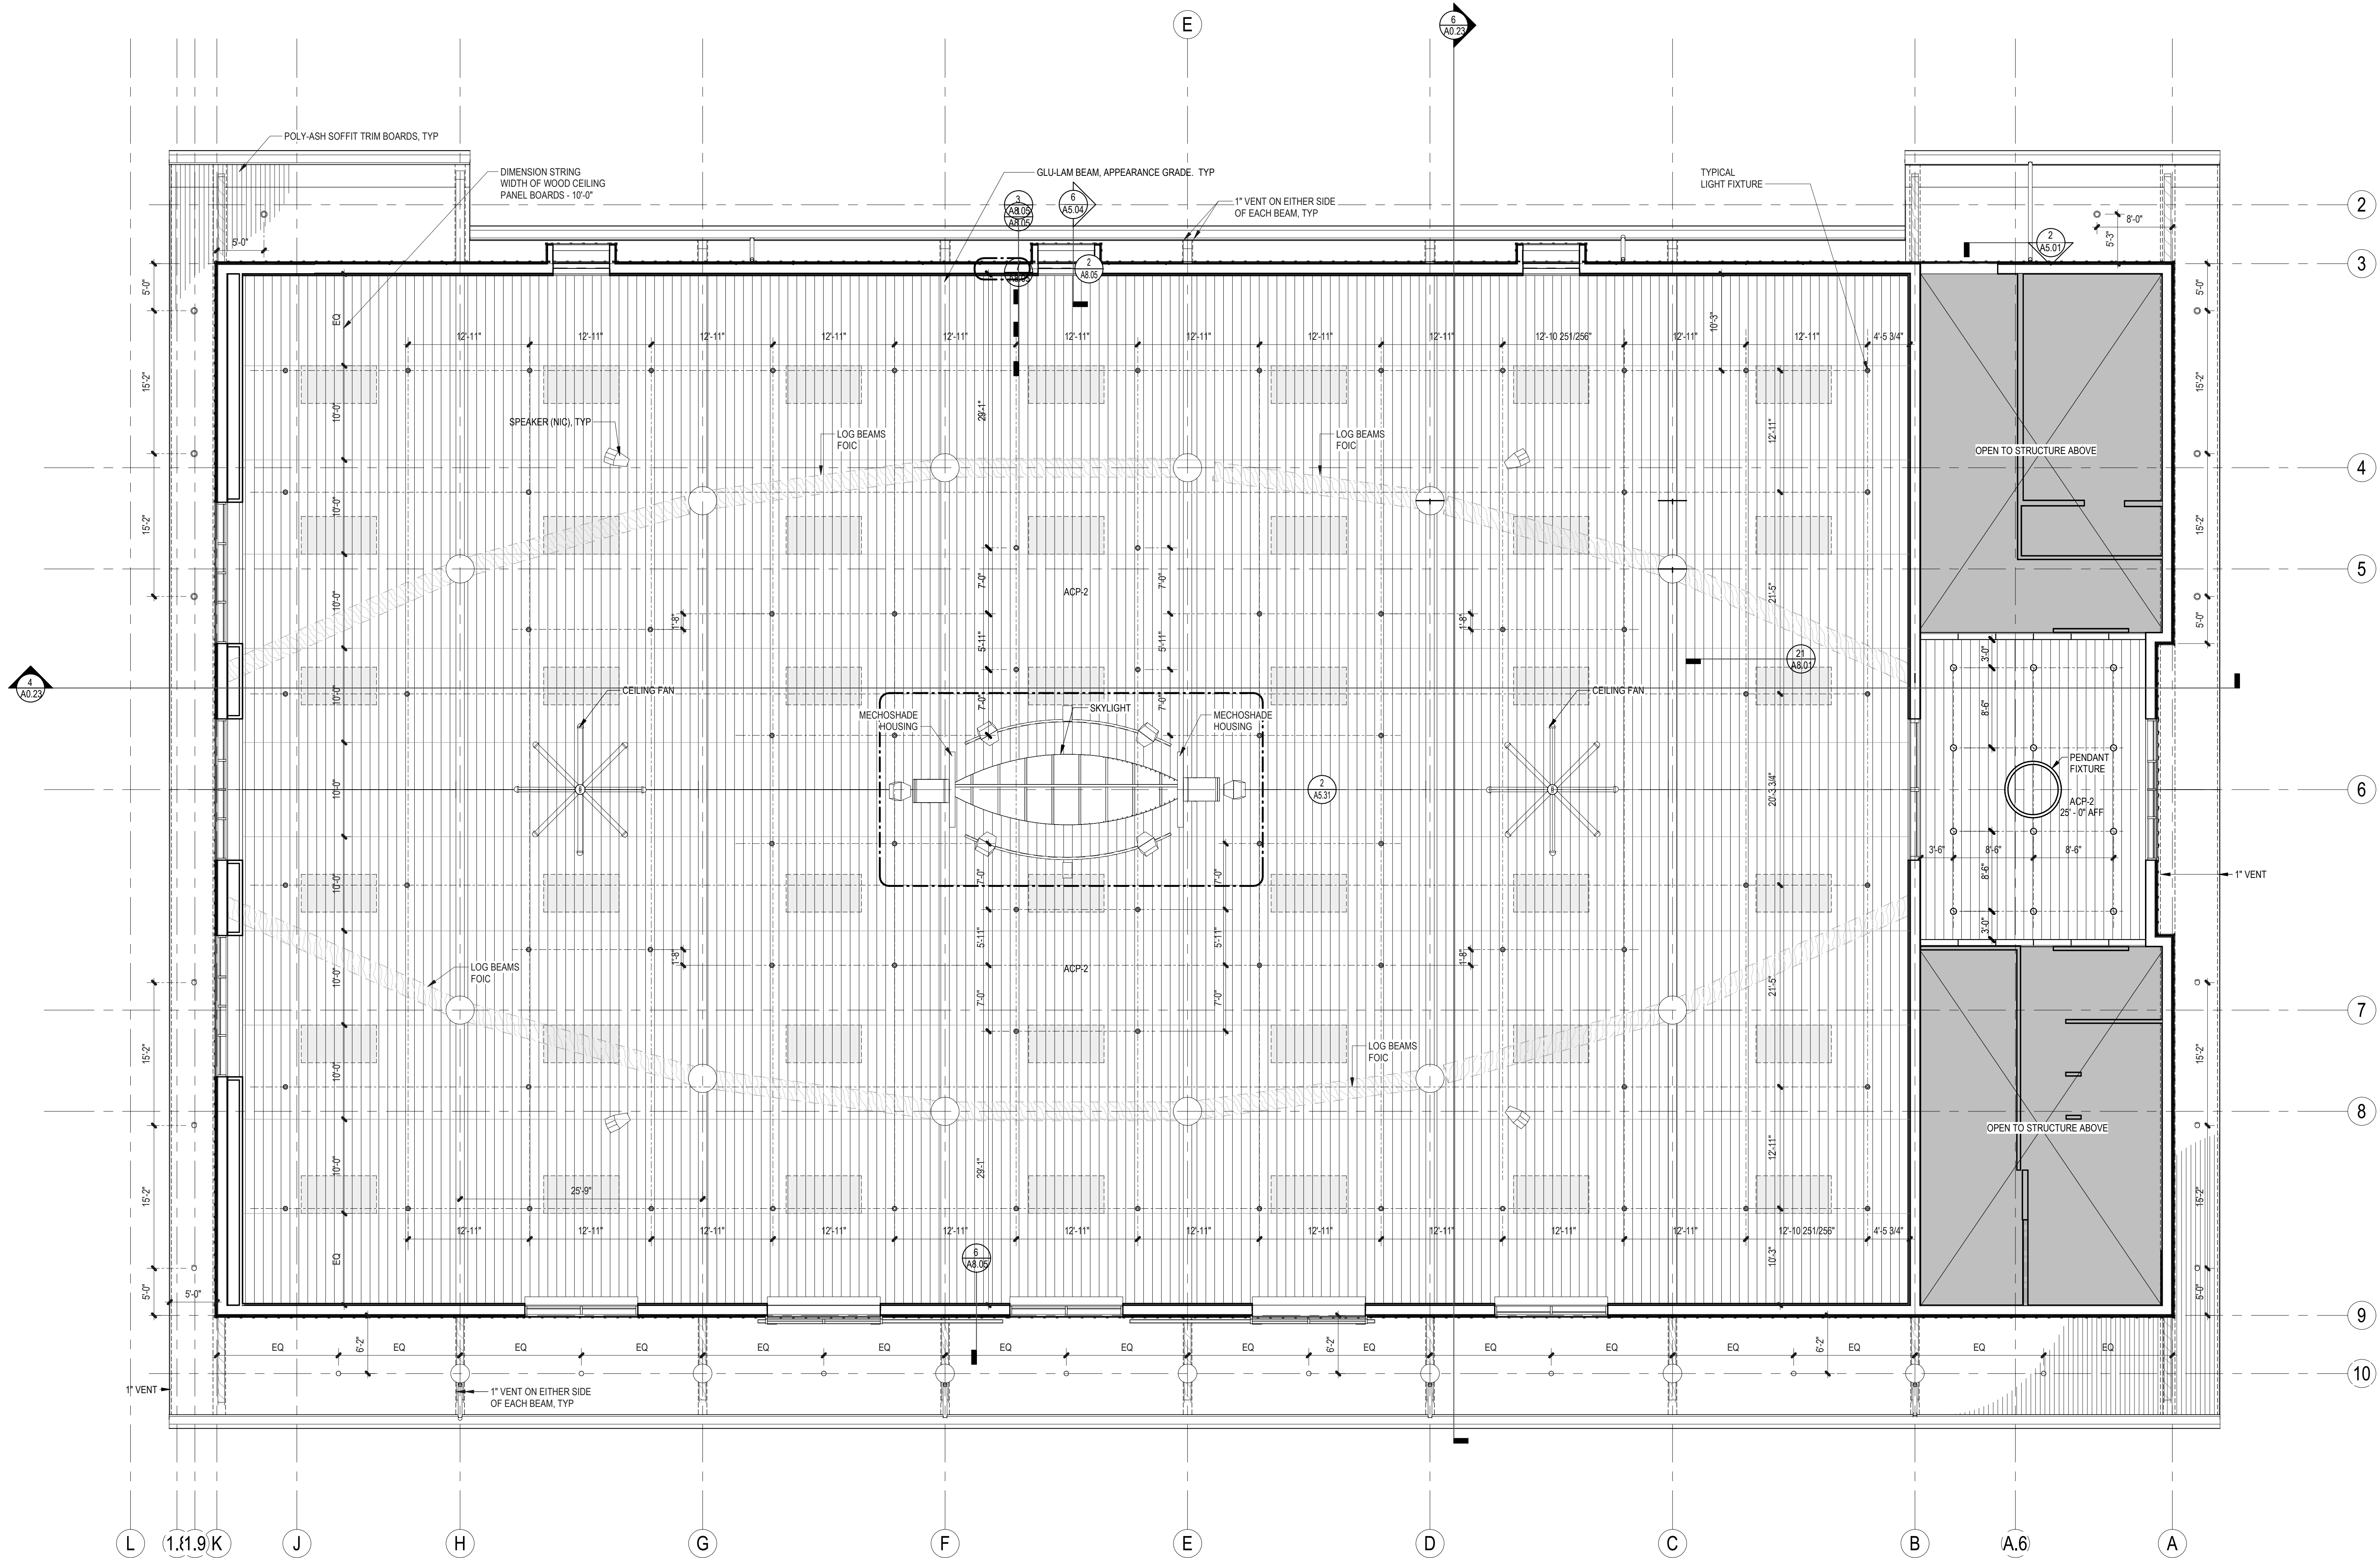


1 REFLECTED CEILING PLAN - MAIN LEVEL (HIGH CEILING)
1/8" = 1'-0"

***SEE ELECTRICAL PLANS FOR
EXIT LIGHT LOCATIONS**



MATERIAL FINISH LEGEND							
NAME	MATERIAL DESCRIPTION	MANUFACTURER	MATERIAL STYLE/SERIES	COLOR/TEXTURE	SIZE	REMARKS/INSTRUCTIONS	CONTACT
ACOUSTIC CEILING PANEL							
ACP-1	ACOUSTICAL CEILING PANEL	CERTAINTEED	ECOPHON - FOCUS F - 3542 2801	TEXTURED - SMOOTH - SILVER STONE	24" X 48" X 9/16"		
ACP-2	WOOD ACOUSTICAL CEILING	RULON OR SWOOD	GRILLE SLATTED CEILING SYSTEM - PG-4-21-2ZW	POPLAR WOOD - FINISH TO BE HONEY	10" L PANELS X 24" W		
ACP-3	ACOUSTICAL CEILING PANEL	CERTAINTEED	BAROQUE - BET-197	WHITE	24" X 48" X 5/8"		
ACP-4	ACOUSTICAL CEILING PANEL	ARMSTRONG	ULTIMA HIGH NRG - 1943 - SQUARE EDGE LAY-IN.	WHITE	24" X 48" X 7/8"	INSTALL WITH 9/16" GRID	
BASE							
B-1	WOOD BASE	MILLWORK	1 X 6 WESTERN RED CEDAR	SEMI-TRANSPARENT FINISH - MATCH ARCHITECTS SAMPLE	1" W X 6" H	INSTALLED AT ALL LOCATIONS PER PLAN	
B-2	SELF-COVED BASE	ALTRO	ALTRO STRONGHOLD 30	SKYLINE K30332	6" UP WALL	IN KITCHEN	
CARPET							
CPT-1	CARPET TILE	SHAW INDUSTRIES	INGRAIN TILE - ALTERNATURE	59339 - QUINCE 3950-4	24" X 24"	INSTALLATION METHOD - QUARTER TURN	
CPT-2	CARPET TILE	SHAW INDUSTRIES	ENTWINE TILE - ALTERNATURE	59337 - QUINCE 78504	24" X 24"	INSTALLATION METHOD - MONOLITHIC	
CONCRETE STAIN							
CONC-1	CONCRETE FLOOR	H&C	POLISHED				
CONC-2	CONCRETE FLOOR	H&C	SEALED				
CORNER GUARD							
CG-1	90 DEGREE CORNER GUARD	CS CONSTRUCTION SPECIALTIES	ACROVYN CORNER GUARD - HEAVY DUTY - STAINLESS STEEL	CO-8 - 2" LEG	8" TALL		
CG-2	END CAP	CS CONSTRUCTION SPECIALTIES	ACROVYN CORNER GUARD - HEAVY DUTY - STAINLESS STEEL	SCO-8 - 2" LEG	8" TALL		
FILM							
F-1 - NOT USED	WINDOW FILM	3M	FASARA	SEMI-TRANSPARENT FILM			
METAL							
M-1	BLACKENED STEEL METAL	COMPANY K	BLACKENED STEEL	OXIDE FINISH	1/8" GAUGE	SHOP APPLIED CLEAR FLAT POLANE FINISH	
PAINT							
P-1/EP-1	GENERAL WALL PAINT/EPOXY PAINT	BENJAMIN MOORE	HALO	OC-46		GENERAL WALL PAINT - ALL WALLS NOT INDICATED	
P-2/EP-2	GENERAL WALL PAINT	SHERWIN WILLIAMS	ANONOMOUS GREY	SW 7046	CORRIDOR WALLS AS INDICATED		
P-3/EP-3	ACCENT PAINT/EPOXY PAINT	SHERWIN WILLIAMS	SERENGETI GRASS	SW 9116	EPOXY PAINT USED AT TOILET WALLS & CEILINGS	LOCATION: WOMEN'S TOILET ACCENT PAINT	
P-4/EP-4	ACCENT PAINT/EPOXY PAINT	GLIDDEN - MATER PALLETTE	DRY GOODS	A1652	EPOXY PAINT USED AT TOILET WALLS & CEILINGS	LOCATION: MEN'S TOILET ACCENT PAINT	
P-5	PAINT	SHERWIN WILLIAMS	BLACK FOX	SW 7020		AS NOTED	
P-6	PAINT	SHERWIN WILLIAMS	ROYCROFT COPPER RED	SW 2839	ACCENT PAINT		
P-7/EP-7	PAINT/EPOXY PAINT	SHERWIN WILLIAMS	PAVESTONE	SW 7642	WALLS & TOILET GWB CEILINGS	LOCATION: COLOR TO MATCH CEILING FINISH	
P-8	WHITEBOARD PAINT	SHERWIN WILLIAMS	SKETCH PAD BRY ERASE COATING	KB73C2001	CONFERENCE ROOM WALLS		
P-9	EXTERIOR PAINT	BENJAMIN MOORE	SATCHEL	AF-240	EXTERIOR PAINT	EXTERIOR - MAIN BUILDING	
P-10	EXTERIOR PAINT	BENJAMIN MOORE	WARMED COGNAC	AF-235	EXTERIOR PAINT	EXTERIOR - ANCILIARY BUILDING	
RESILIENT SHEET							
RS-1	RESILIENT SHEET FLOORING	ALTRO - COMMERCIAL KITCHENS	ALTRO STRONGHOLD 30	SKYLINE - K30332			
RS-2	NOT USED	NOT USED	NOT USED	TBD			
RS-3	FLUID APPLIED FLOORING	DUR-O-TEX	HYBRI-FLEX EQ	FOSSIL			
SOLID SURFACING MATERIAL							
SSM-1	SOLID SURFACING MATERIAL	INPRO CORP	BIOPRISM	PARCHMENT P9058		WOMEN'S SHOWER WALLS	
SSM-2	SOLID SURFACING MATERIAL	INPRO CORP	BIOPRISM	SHORELINE P9093			
SSM-3	SOLID SURFACING MATERIAL	AVONITE	SOLID SURFACING	ALASKAN STONE - 4312		WOMEN'S TOILET ROOMS - COUNTERTOP	
SSM-4	SOLID SURFACING MATERIAL	AVONITE	SOLID SURFACING	MORNING TUNDRA - 7503		MEN'S TOILET ROOMS - COUNTERTOP	
TILE							
T-1	CERAMIC WALL TILE	DALTILE	MODERN DIMENSIONS	0790 - MATTE ARTIC WHITE	4 1/4" X 12 7/8"	TOILET ROOM WALL TILE (FIELD)	
T-2	CERAMIC WALL TILE BASE	DALTILE	MODERN DIMENSIONS	0709 - MATTE - ARCHITECTURAL GRAY	4 1/4" X 12 7/8"	TOILET ROOM BASE	
T-3	CERAMIC WALL TILE	DALTILE	CLIO MOSAICS - ALT. STONE ACCENTS	CL 5 HERA - ALT. DA07 EARTHY BLEND	MOSAIC - VARIES	WOMEN'S TOILET ROOM ONLY	
T-4	CERAMIC WALL TILE	DALTILE	CLIO MOSAICS - ALT. STONE ACCENTS	CL 18 BOREAS - ALT. DA05 BLACK RIVER	MOSAIC - VARIES	MEN'S TOILET ROOM ONLY	
WALL PROTECTION							
WP-1	WALL PROTECTION	CS CONSTRUCTION SPECIALTIES	318 BERRY RED	S100 S2/S WHITE	SMOOTH	LOWER LEVEL CORRIDOR PROVIDE JOINT CAPS, TOP & BASE ACCESSORIES AS NEEDED	
WP-2	WALL PROTECTION	INPRO CORP	SE026 BRUSHED NICKEL			LOCATION: BUFFET	
WP-3	WALL PROTECTION	INPRO CORP	0117 BEIGE			LOCATION: WOMEN'S TOILET - LOWER LEVEL	
WP-4	WALL PROTECTION	INPRO CORP	SE025 BRUSHED SILVER			LOCATION: MEN'S TOILET - LOWER LEVEL	
WP-5	WALL PROTECTION - FRP	ALTRO - COMMERCIAL KITCHENS	ALTRO PURAGUARD	W134 WHITE	SMOOTH	LOCATION: KITCHEN WALLS	
WP-6	WALL PROTECTION - SS	METAL FABRICATION	STAINLESS STEEL SHEET			LOCATION: KITCHEN WALL - STAINLESS STEEL	
WINDOW TREATMENT							
WT-1	WINDOW TREATMENT - SHADE	MECHOSHADE	THERMOVEIL	5% OPEN 1320 SHADOW GREY	FIELD VERIFY	SEE FINISH PLAN FOR LOCATIONS	
WT-2	WINDOW TREATMENT - BLACKOUT SHADE	MECHOSHADE	EQUINOX BLACKOUT	0108 ONYX	FIELD VERIFY	SEE FINISH PLAN FOR LOCATIONS	
WT-3		MECHOSHADE	EQUINOX BLACKOUT	0108 ONYX	FIELD VERIFY	HORIZONTAL AT SKYLIGHT	
WOOD							
WD-1	WOOD PLANK FLOORING SYSTEM	JUNCHERS HARDWOOD	HARMONY	OAK - ULTRA MATTE URETHANE	7/8" D X 5" W X 12' L		
WD-2	WOOD PANELS	MILLWORK	1 X 6 TIGHT KNOT CEDAR	CEDAR - STAIN TO MATCH ARCHITECTS SAMPLE	1" D X 6" H X LENGTH AS PROVIDED		
WD-3	WOOD WALL PLANKS	MILLWORK	4" & 6" VARIED HEIGHT AND DEPTH WOOD PLANKS	RESAWN TIMBERS - TBD	1" X 4", 1/2" X 4" & 1 1/2" X 6" - VARIES IN LENGTH		
WD-4	WOOD WALL PANELS	ISSAQUAH CEDAR OR EQUAL	VERTICALLY GROOVED WESTERN RED CEDAR - MATCH ARCHITECTS SAMPLE	WESTERN RED CEDAR - SATINED TO MATCH ARCHITECTS SAMPLE	1" X 12' FULL LENGTH - SEE ELEVATION FOR EXACT SIZES NEEDED		
WALK-OFF MAT							
WOM-1	WALK OFF MAT	KADEE	KD-98 - 1 1/8" STAINLESS STEEL GRATE				

FLOOR FINISH LEGEND

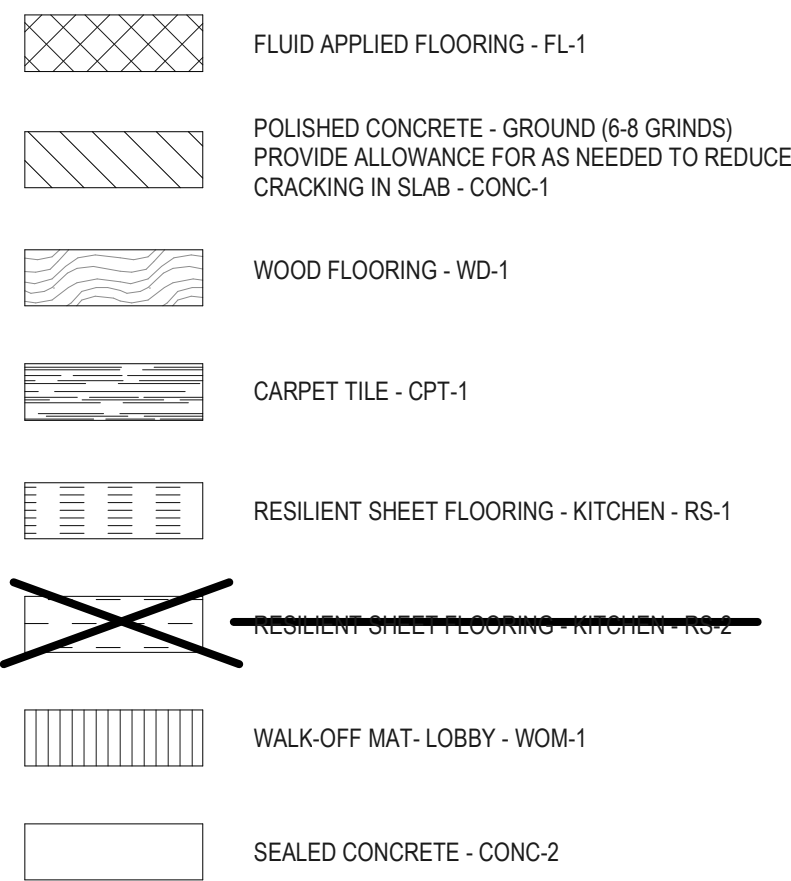


FINISH NOTES & FFE&A NOTES

- 1) ALL EXPOSED WALL SURFACES SHALL BE FINISHED.
- 2) ALL WALLS SHALL RECEIVE WALL BASE.
- 3) FLOORING SHALL EXTEND UNDERNEATH ALL (OPEN - NO CASEWORK-BELOW) COUNTERTOP WORK SURFACES.
- 4) ALL HARD (CERAMIC, STONE, AND SIMILAR) TILE SHALL BE CENTERED ON FLOOR AND/OR ON WALLS.
- 5) UNLESS OTHERWISE INDICATED: DOORS AND/OR FRAMES FOR PAINT FINISH SHALL BE PAINTED THE SAME COLOR AS THE CEILING. DOOR CREAMING CENTERED IN TWO ROOMS OF DIFFERENT COLORS; PAINT BREAK SHALL OCCUR AT INSIDE CORNER OF DOOR STOP AT DOOR-LEAF SIDE.
- 6) WALLCOVERING AT CEILING WORK BACKSPLASH AND SIDESPASHES SHALL BE TUCKED BEHIND THE SPLASH BEFORE APPLICATION OF SEALANT SEE. ALSO SEE CASKWORK DRAWINGS.
- 7) CONTRACTOR SHALL CONFIRM DIMENSIONS, LOCATIONS, WEIGHTS, SUPPORT-REQUIREMENTS, AND UTILITY REQUIREMENTS OF ALL OWNER-FURNISHED EQUIPMENT WITH OWNER AND EQUIPMENTS SUPPLIER, PRIOR TO INSTALLATION.
- 8) WHERE NO MOUNTING HEIGHT IS INDICATED OR SCHEDULED FOR FIXTURES, EQUIPMENT, ACCESSORIES, COORDINATE MOUNTING HEIGHT WITH ARCHITECT PRIOR TO INSTALLATION.
- 9) UNLESS OTHERWISE INDICATED, CEILING GRIDS ARE DRAWN CENTERED IN THE ROOMS, GRILLS SHALL BE INSTALLED CENTERED WITH THE ROOM AS SHOWN.
- 10) UNLESS OTHERWISE INDICATED, CEILING-MOUNTED LIGHTS, SPEAKERS, DIFFUSERS, GRILLS, AIR TERMINALS, SPRINKLER HEADS, AND SIMILAR ARE DRAWN CENTERED IN CEILING PLANES OR CENTERED IN ROOM. THESE DEVICES SHALL BE INSTALLED CENTERED WITHIN THE CEILING PLANES AND WITHIN THE ROOMS AS SHOWN.



t 425.778.1530 21911 76th Ave W. Ste 210
f 425.774.7803 Edmonds WA 98026
info@tgbarchitects.com
www.tgbarchitects.com

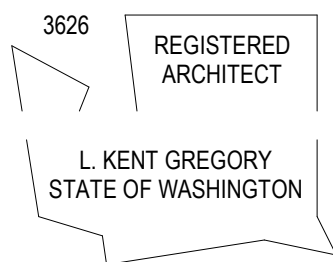

TULALIP TRIBES GATHERING HALL

7512 TOTEM BEACH RD
TULALIP, WA 98271

PHASE 2 - BUILDING AND LANDSCAPING

LOWER LEVEL FINISH PLAN

[illegible]

PROJECT INFORMATION	
PROJECT NUMBER:	17031
PROJECT LEAD:	DC
DRAWN BY:	JLO


SHEET NO

A2.31


1 FINISH PLAN - LEVEL 1
1/8" = 1'-0"

BUILDING COMPONENT PERFORMANCE	
STOREFRONT ENTRANCE DOOR:	
SOLAR HEAT GAIN COEFFICIENT ASSEMBLY (SHGC) MINIMUM = 0.40	
ASSEMBLY U-FACTOR = 0.38 (OR LOWER)	
STOREFRONT SYSTEM / WINDOW:	
SOLAR HEAT GAIN COEFFICIENT ASSEMBLY (SHGC) MINIMUM = 0.40	
ASSEMBLY U-FACTOR = 0.60 (OR LOWER)	


GLAZING LEGEND		
TAG	DESCRIPTION	COMMENTS
G1	INSULATED CLEAR	
G2	INSULATED SPANDREL	
G3	INSULATED CLEAR	OPERABLE
G4	INSULATED CLEAR SAFETY GLASS	
G5	INSULATED CLEAR SAFETY GLASS	OPERABLE AWNING

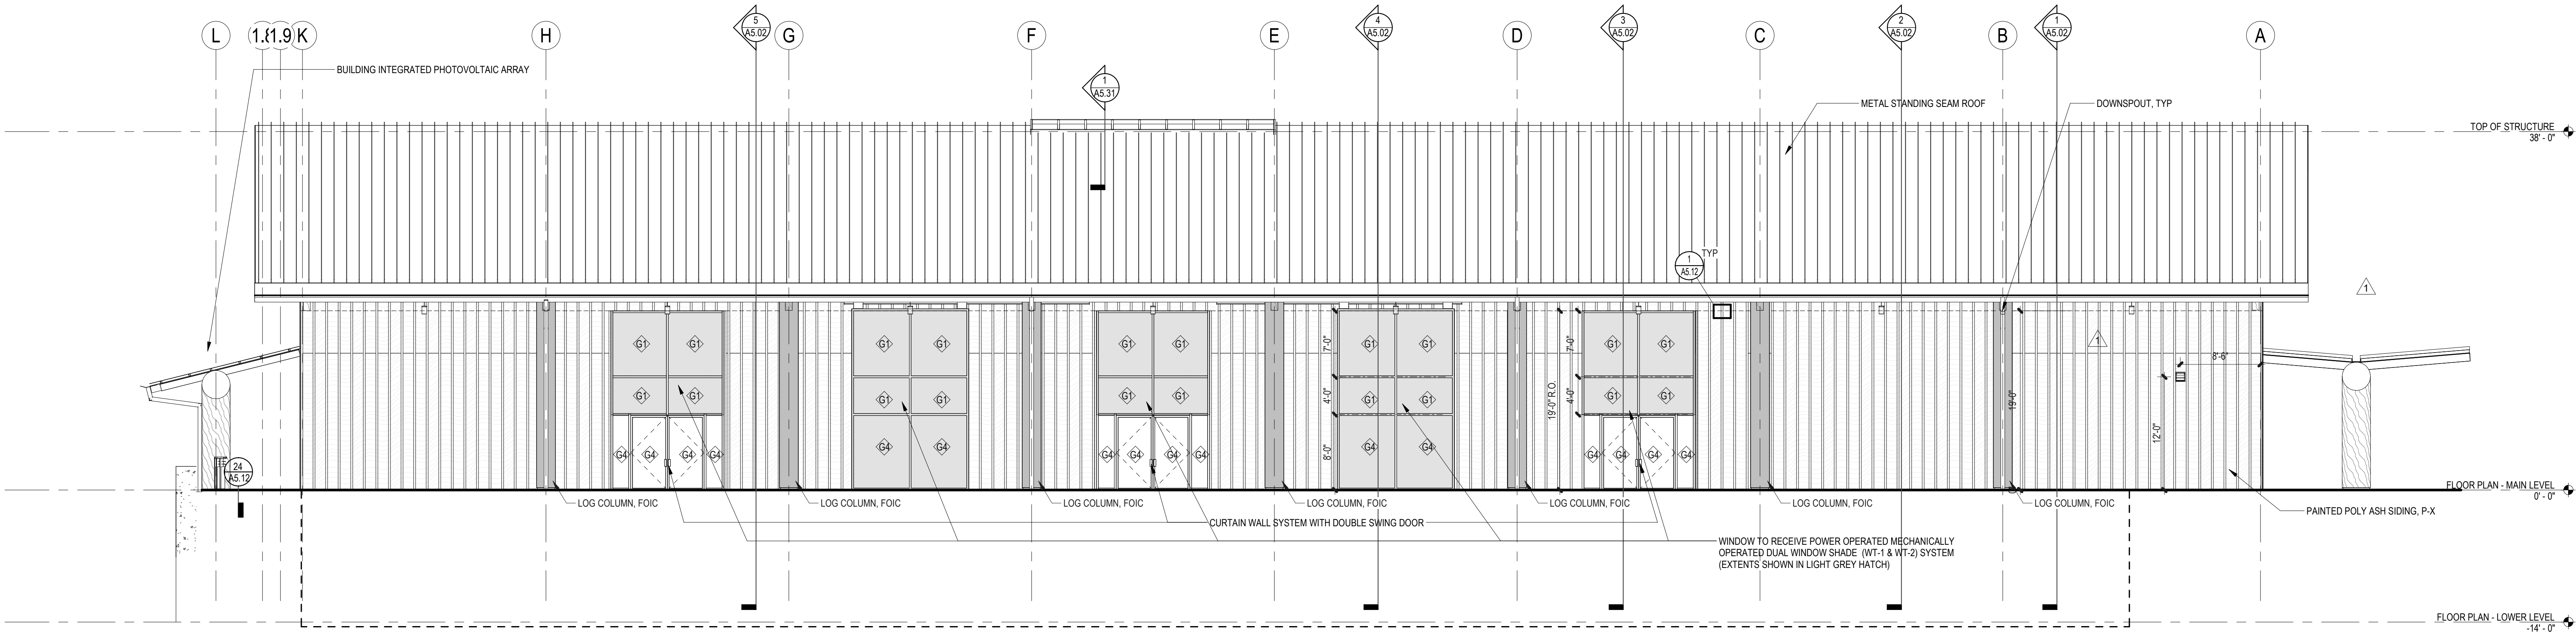

2 EAST ELEVATION
1/8" = 1'-0"

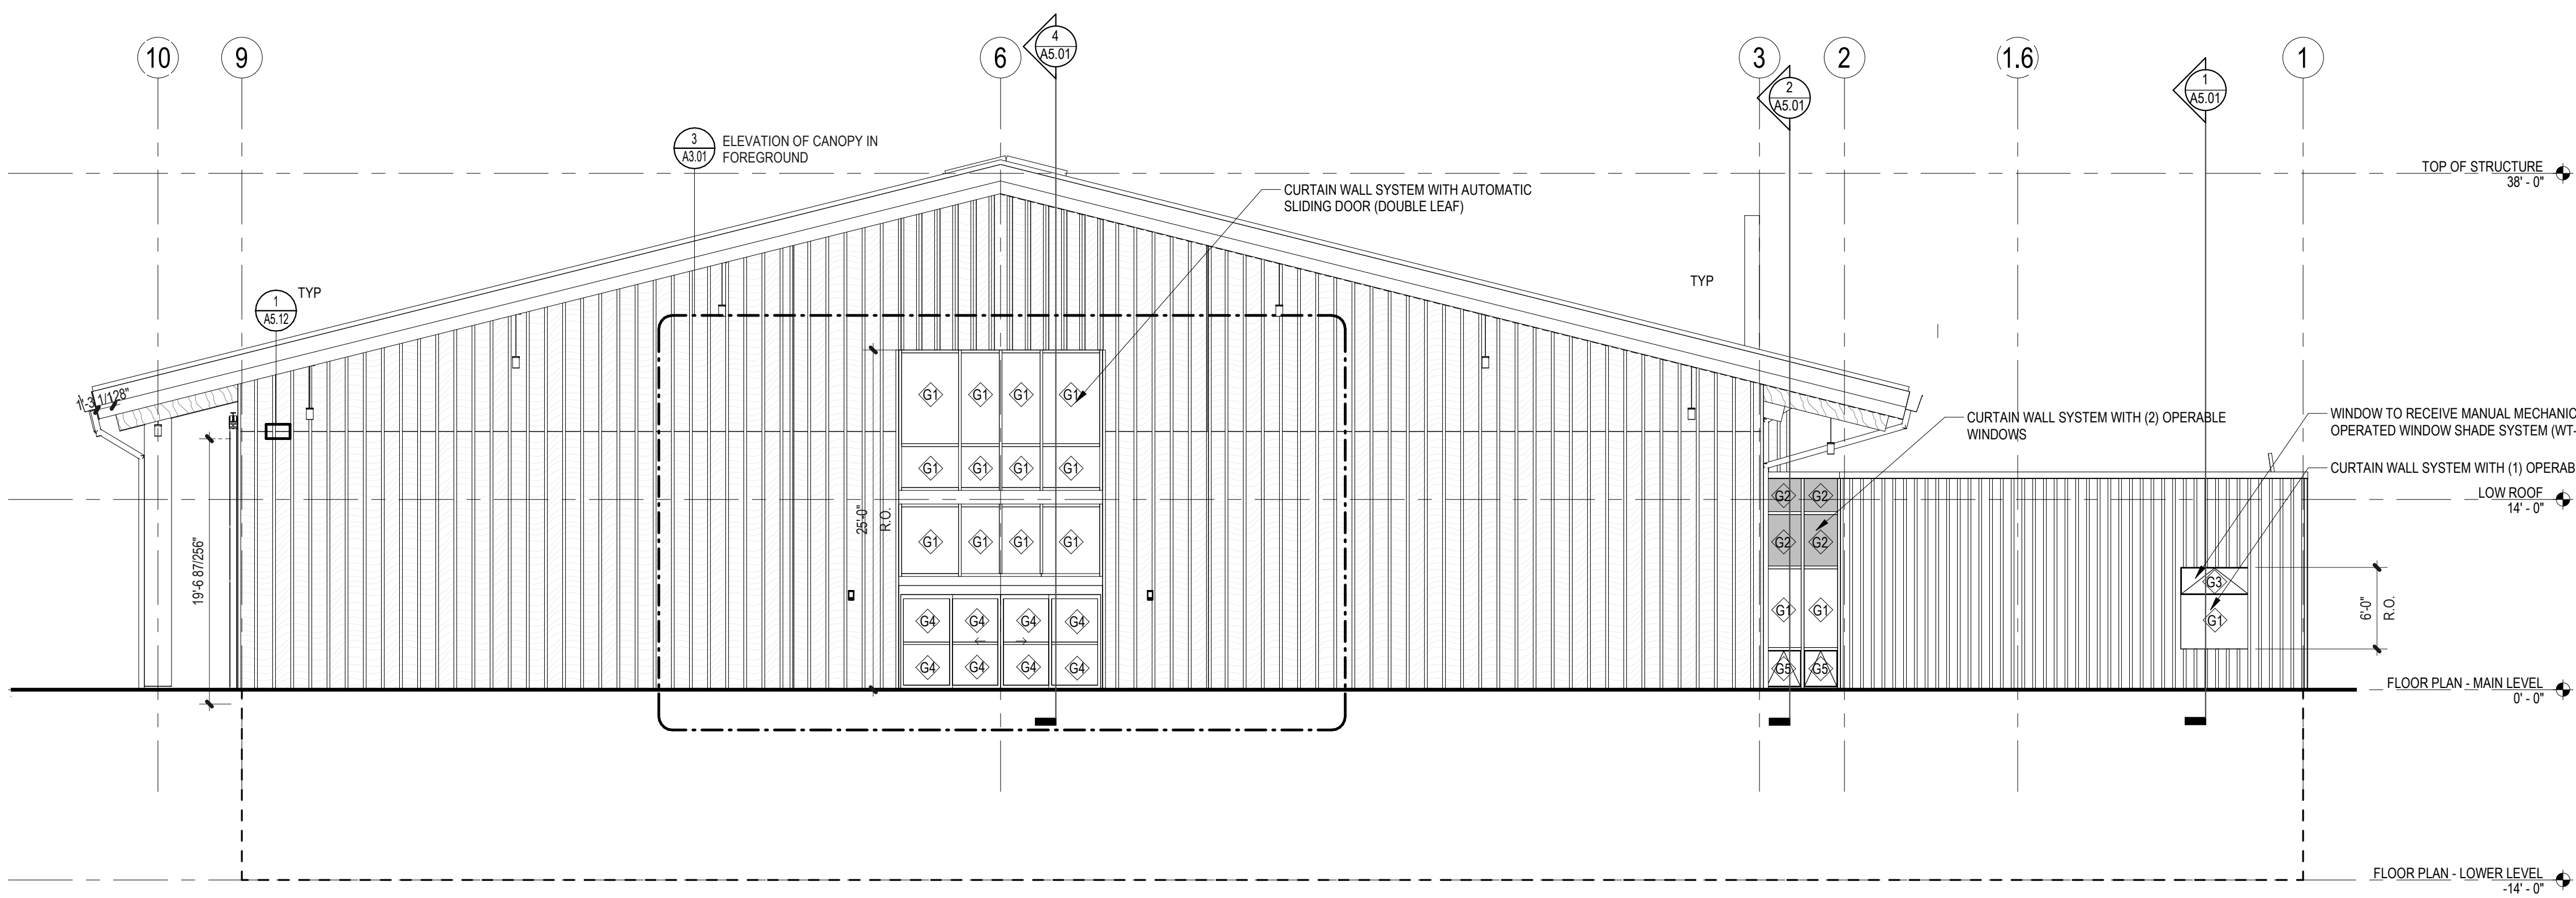

1 NORTH ELEVATION
1/8" = 1'-0"

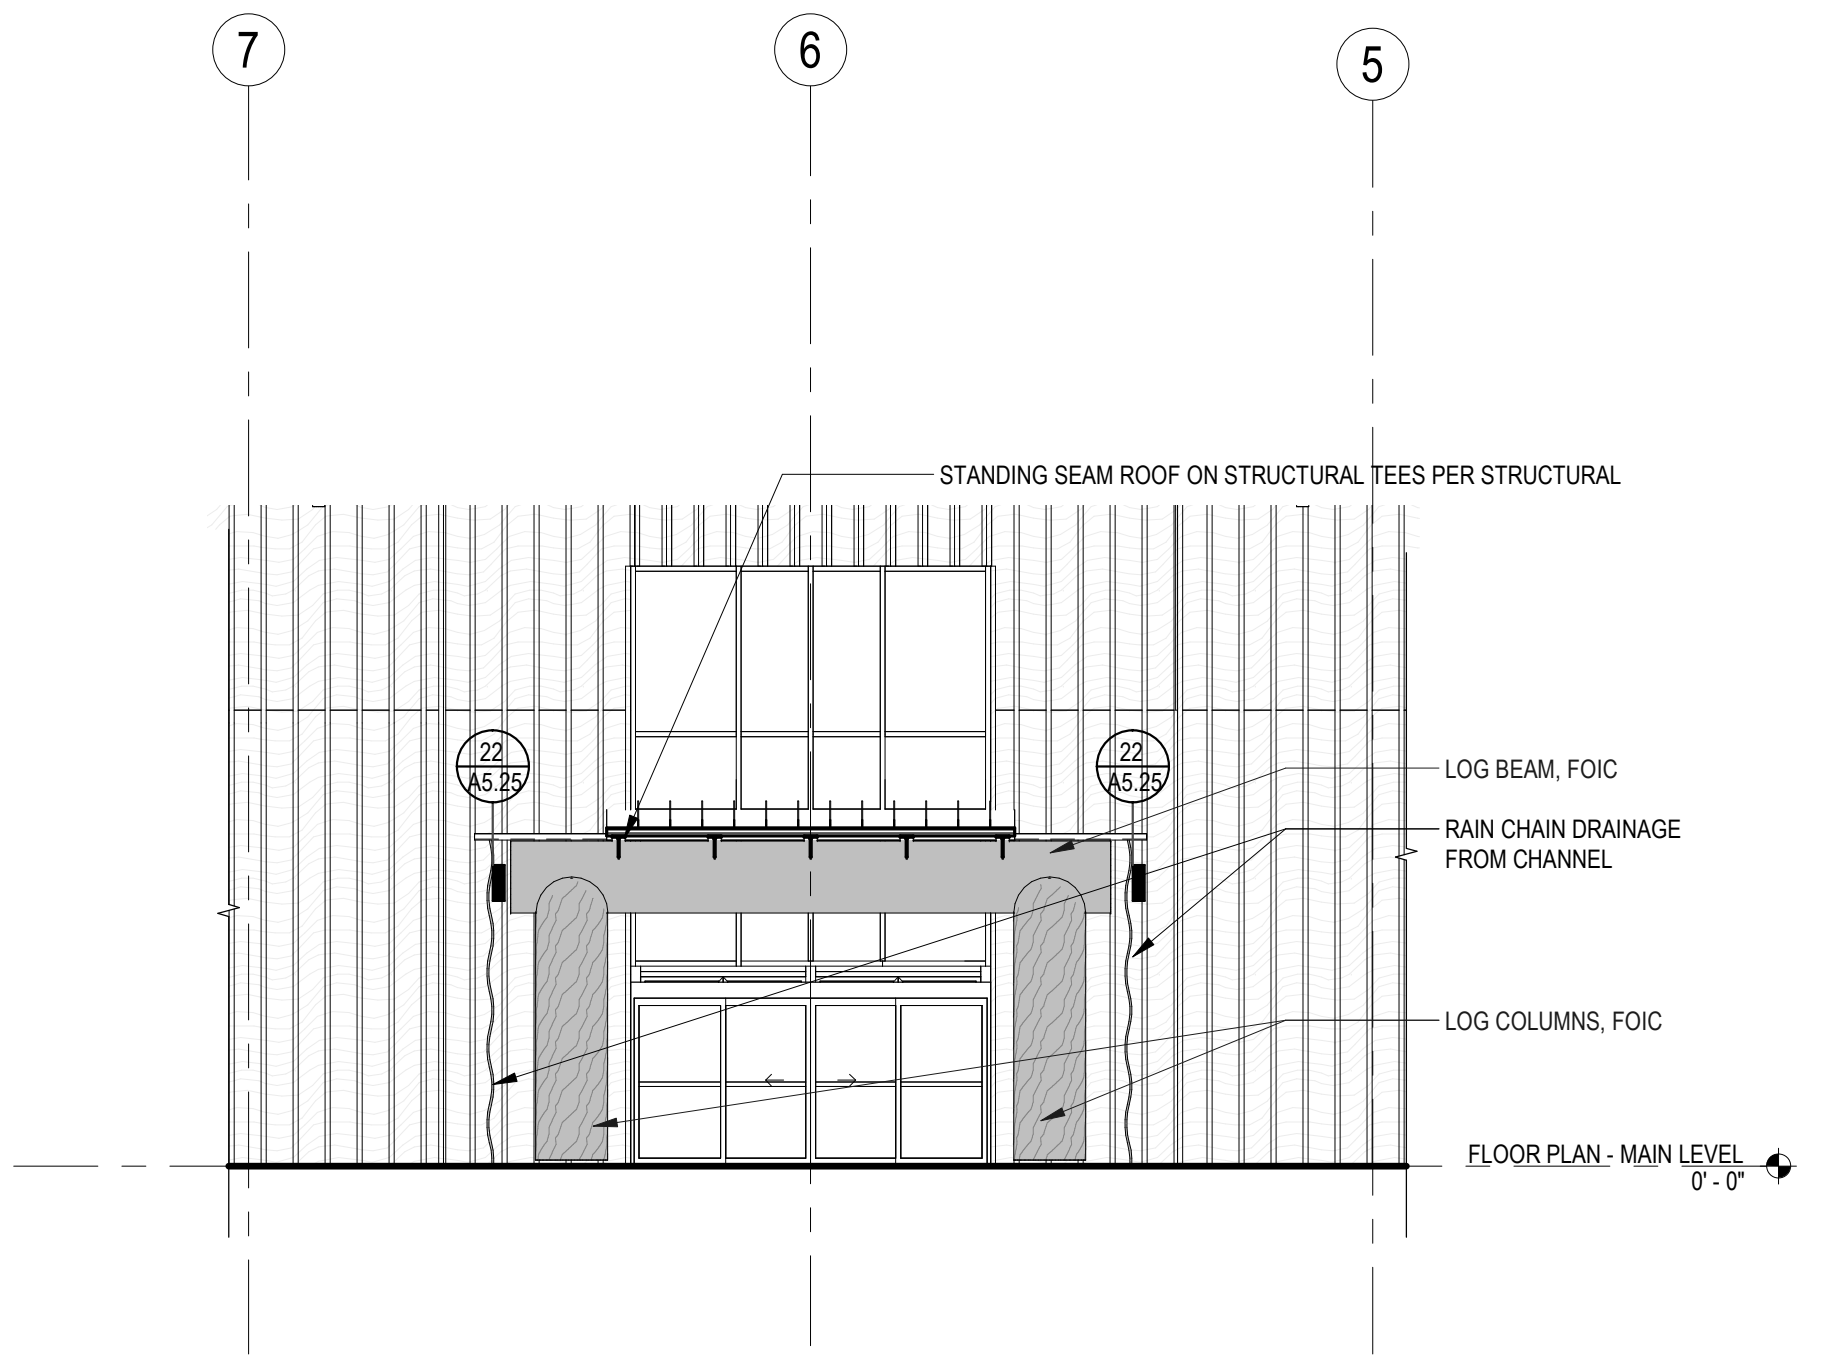

3 NORTH ELEVATION - ENTRY CANOPY
1/8" = 1'-0"

TULALIP TRIBES GATHERING HALL

7512 TOTEM BEACH RD
TULALIP, WA 98271

PHASE 2 - BUILDING AND LANDSCAPING

EXTERIOR ELEVATIONS

ISSUANCE		
No.	Description	Date
	SITE AND FOUNDATION PERMIT SET	04/09/18
	PH 2 PERMIT SET	08/16/18
	PH 2 BID SET	10/08/18
	ADDENDUM 3	11/14/18
	PH 2 PERMIT REVIEW 2019	01/04/19
1	PH 2 CCD 1	03/12/19
	PH 2 CONFORM SET	10/14/19
	PH 2 RECORD SET	06/02/20

PROJECT INFORMATION	
PROJECT NUMBER:	17031
PROJECT LEAD:	DC
DRAWN BY:	AB

SHEET NO

A3.01

LOW ROOF DOWNSPOUT SIZING (PER SMACNA GUIDELINES)

LOW ROOF DOWNSPOUTS -
PLAIN AREA = 7,067 SQ. FT.
PER TABLE 1-1 OF SMACNA - DESIGN AREA FOR PITCHED ROOF FACTOR IS 1.00
DESIGN AREA OF ROOF = 7,067 SQ. FT. + LOAD FROM UPPER ROOF (SEE CALC ON A2.14) OF 9,072 SQ. FT.
TOTAL LOAD = 16,139 SQ. FT.
(4) DOWNSPOUTS ARE LOCATED EQUALLY SPACED ON FLAT ROOF, MAKING THE AREA SERVED BY EACH DOWNSPOUT 4,035 SQ. FT.
PER COLUMN B OF TABLE 1-2, THE ROOF AREA DRAINED PER DOWNSPOUT IN SEATTLE, WA (WITH AN INTENSITY FACTOR OF 3.3 IN/HR) IS 360 SQ. FT. / SQ. IN.
4,035 SQ. FT. / 360 = 11.21 SQ. IN. REQ. PER DOWNSPOUT
PER TABLE 1-3, A 5" PLAIN ROUND DOWNSPOUT PROVIDES AN AREA OF 17.71 SQ. IN. DESIGN TO UTILIZE 5" PLAIN ROUND DOWNSPOUTS


CONDUCTOR HEADS AT SCUPPERS - PER SMACNA 5TH EDITION, CONDUCTOR HEADS (FIG 1-25C) TO BE APPROX.
FACE WIDTH: 3 TO 4X DOWNSPOUT WIDTH (TO FIT WITHIN CHANNEL. WIDTH TO BE 10" FOR CONDUCTOR HEAD)
FACE DEPTH: 2X DOWNSPOUT WIDTH (8" DEPTH AT CONDUCTOR HEAD)
HEIGHT: 3 TO 4X DOWNSPOUT WIDTH (10" HEIGHT AT CONDUCTOR HEAD)

BUILDING COMPONENT PERFORMANCE


STOREFRONT ENTRANCE DOOR:
SOLAR HEAT GAIN COEFFICIENT ASSEMBLY (SHGC) MINIMUM = 0.40
ASSEMBLY U-FACTOR = 0.38 (OR LOWER)
STOREFRONT SYSTEM / WINDOW:
SOLAR HEAT GAIN COEFFICIENT ASSEMBLY (SHGC) MINIMUM = 0.40
ASSEMBLY U-FACTOR = 0.60 (OR LOWER)

GLAZING LEGEND

TAG	DESCRIPTION	COMMENTS
G1	INSULATED CLEAR	
G2	INSULATED SPANDREL	
G3	INSULATED CLEAR	OPERABLE
G4	INSULATED CLEAR SAFETY GLASS	
G5	INSULATED CLEAR SAFETY GLASS	OPERABLE AWNING

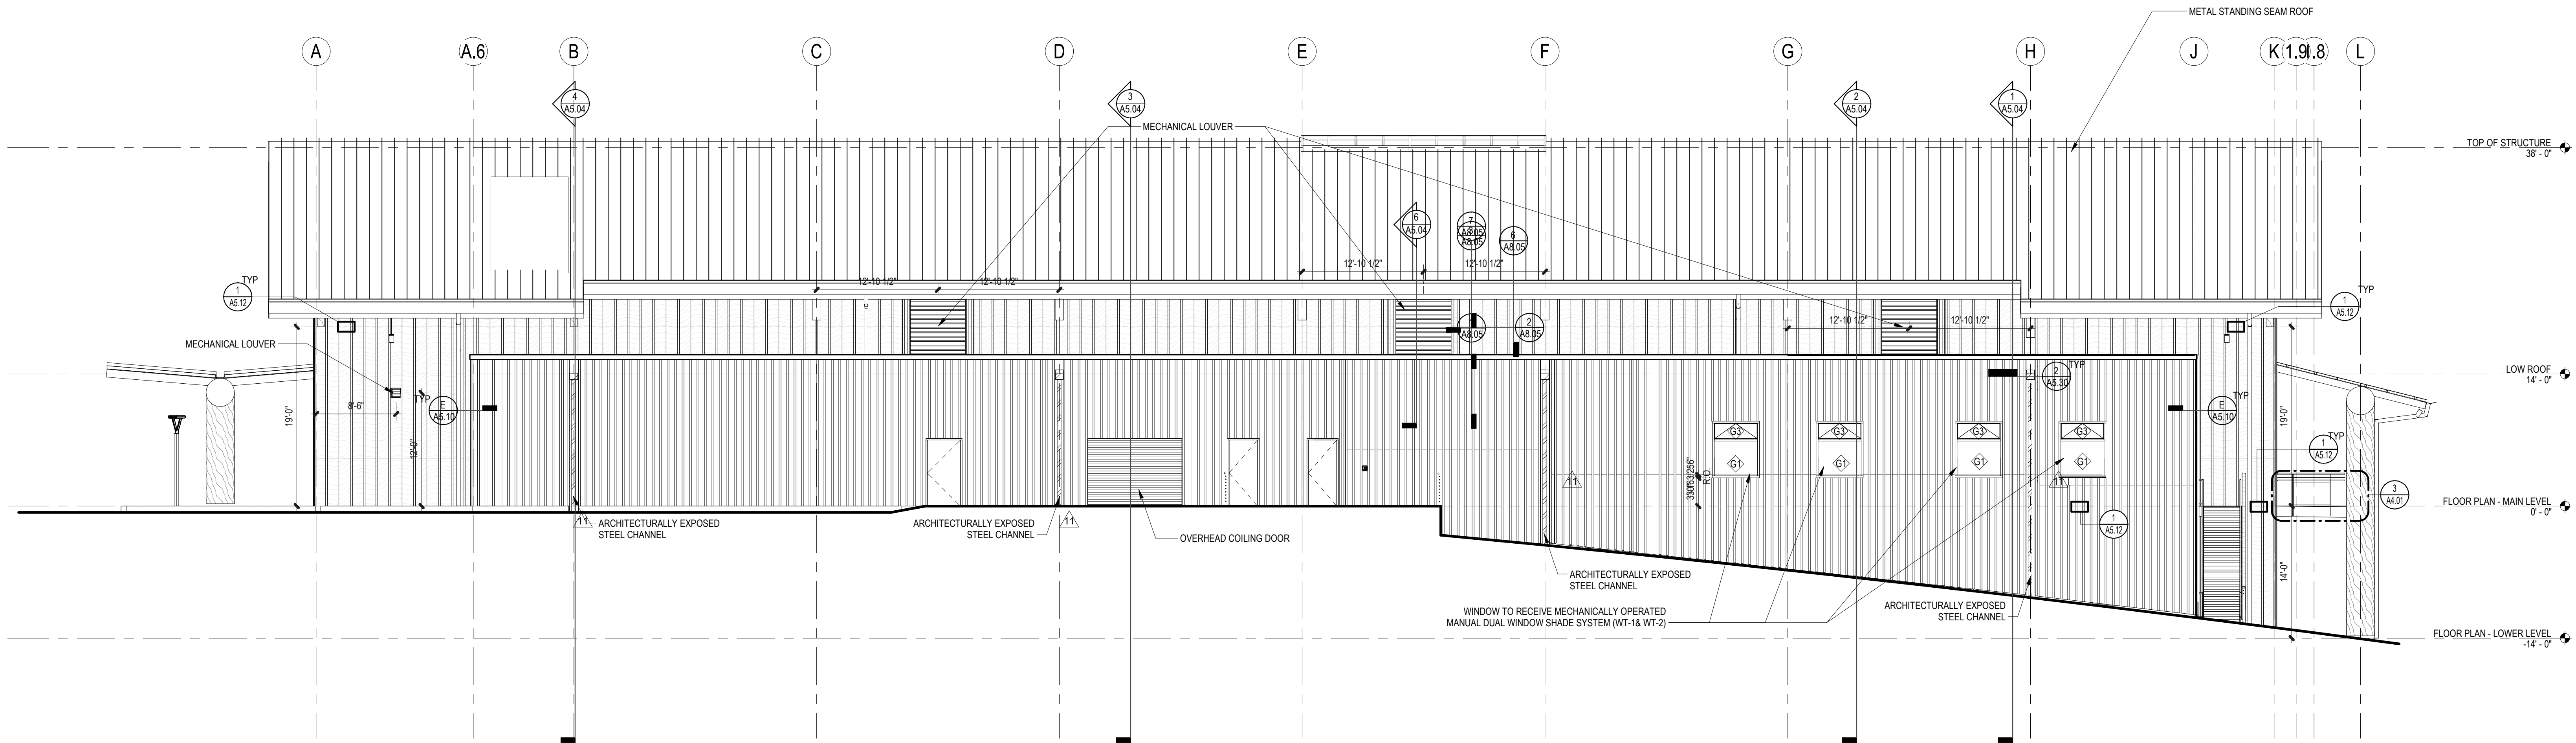

2 WEST ELEVATION
1/8" = 1'-0"

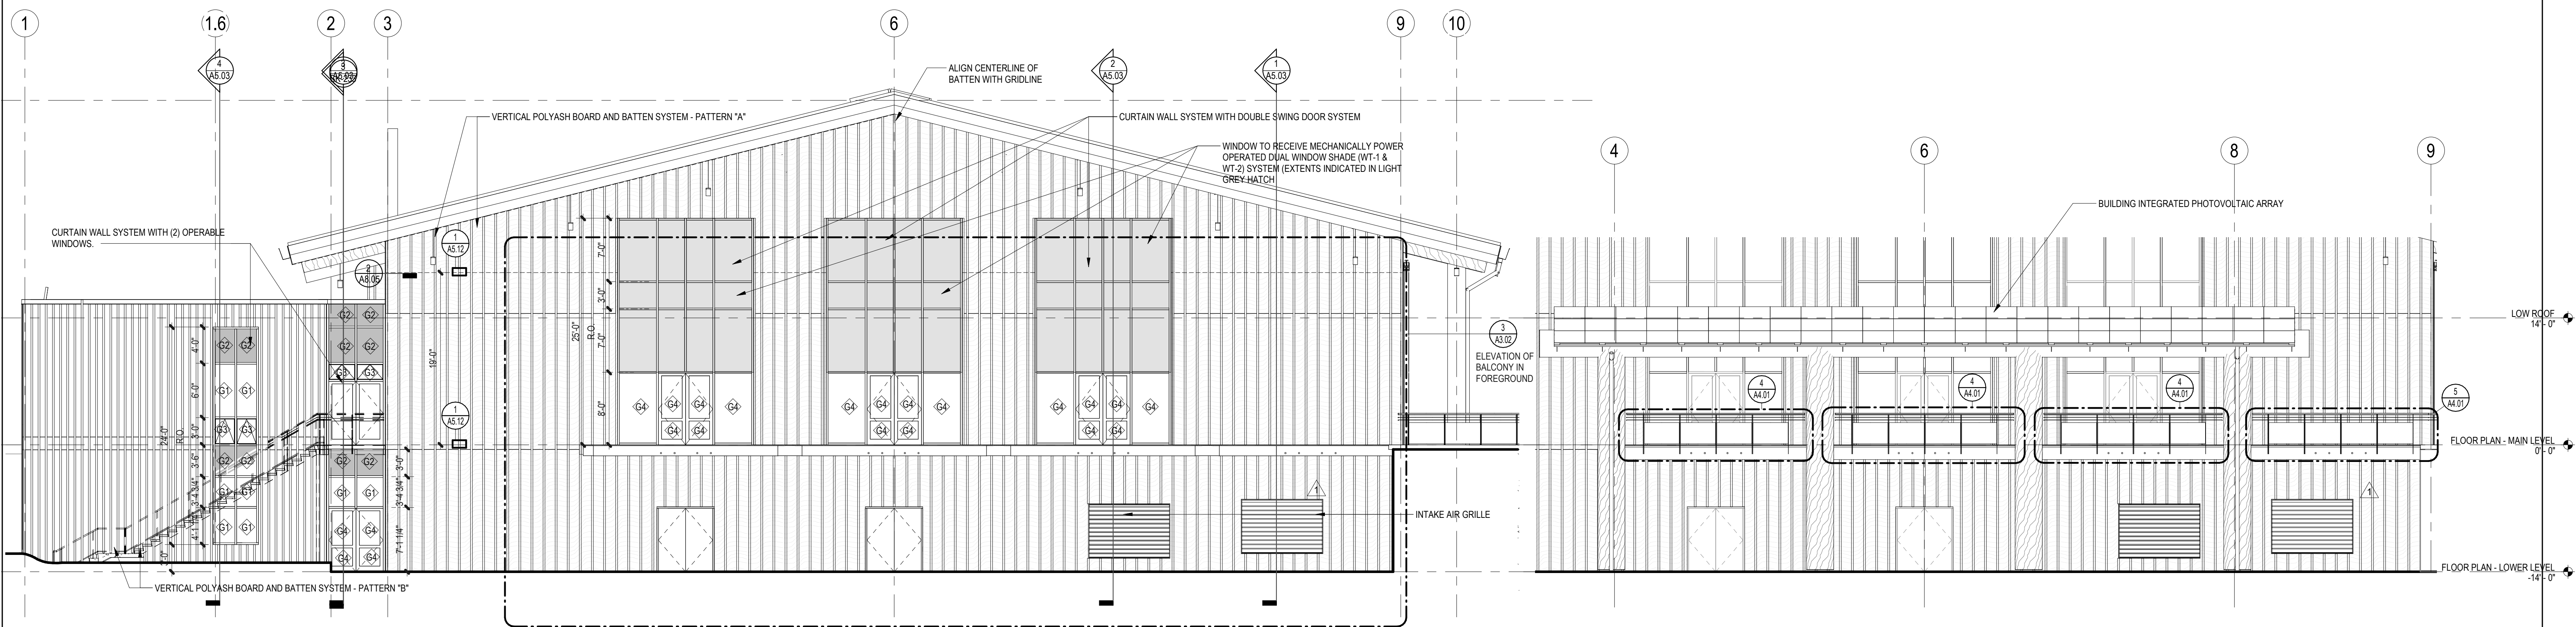

1 SOUTH ELEVATION
1/8" = 1'-0"

3 SOUTH ELEVATION - SOUTH BALCONY
1/8" = 1'-0"

TULALIP TRIBES
GATHERING HALL

7512 TOTEM BEACH RD
TULALIP, WA 98271

PHASE 2 - BUILDING AND
LANDSCAPING

EXTERIOR
ELEVATIONS

ISSUANCE		
No.	Description	Date
PH 2 PERMIT SET		08/16/18
PH 2 BID SET		10/08/18
ADDENDUM 3		11/14/18
PH 2 PERMIT REVIEW 2019		01/04/19
PH 2 CCD 1		03/12/19
PH 2 CCD 4		08/13/19
PH 2 CONFORM SET		10/14/19
PH 2 RECORD SET		06/02/20

PROJECT INFORMATION
PROJECT NUMBER: 17031
PROJECT LEAD: DC
DRAWN BY: AB

SHEET NO

TULALIP TRIBES GATHERING HALL




7512 TOTEM BEACH RD
TULALIP, WA 98271

PHASE 2 - BUILDING AND LANDSCAPING

BUILDING SECTIONS

[illegible]

PROJECT INFORMATION	
PROJECT NUMBER:	17031
PROJECT LEAD:	DC
DRAWN BY:	AB

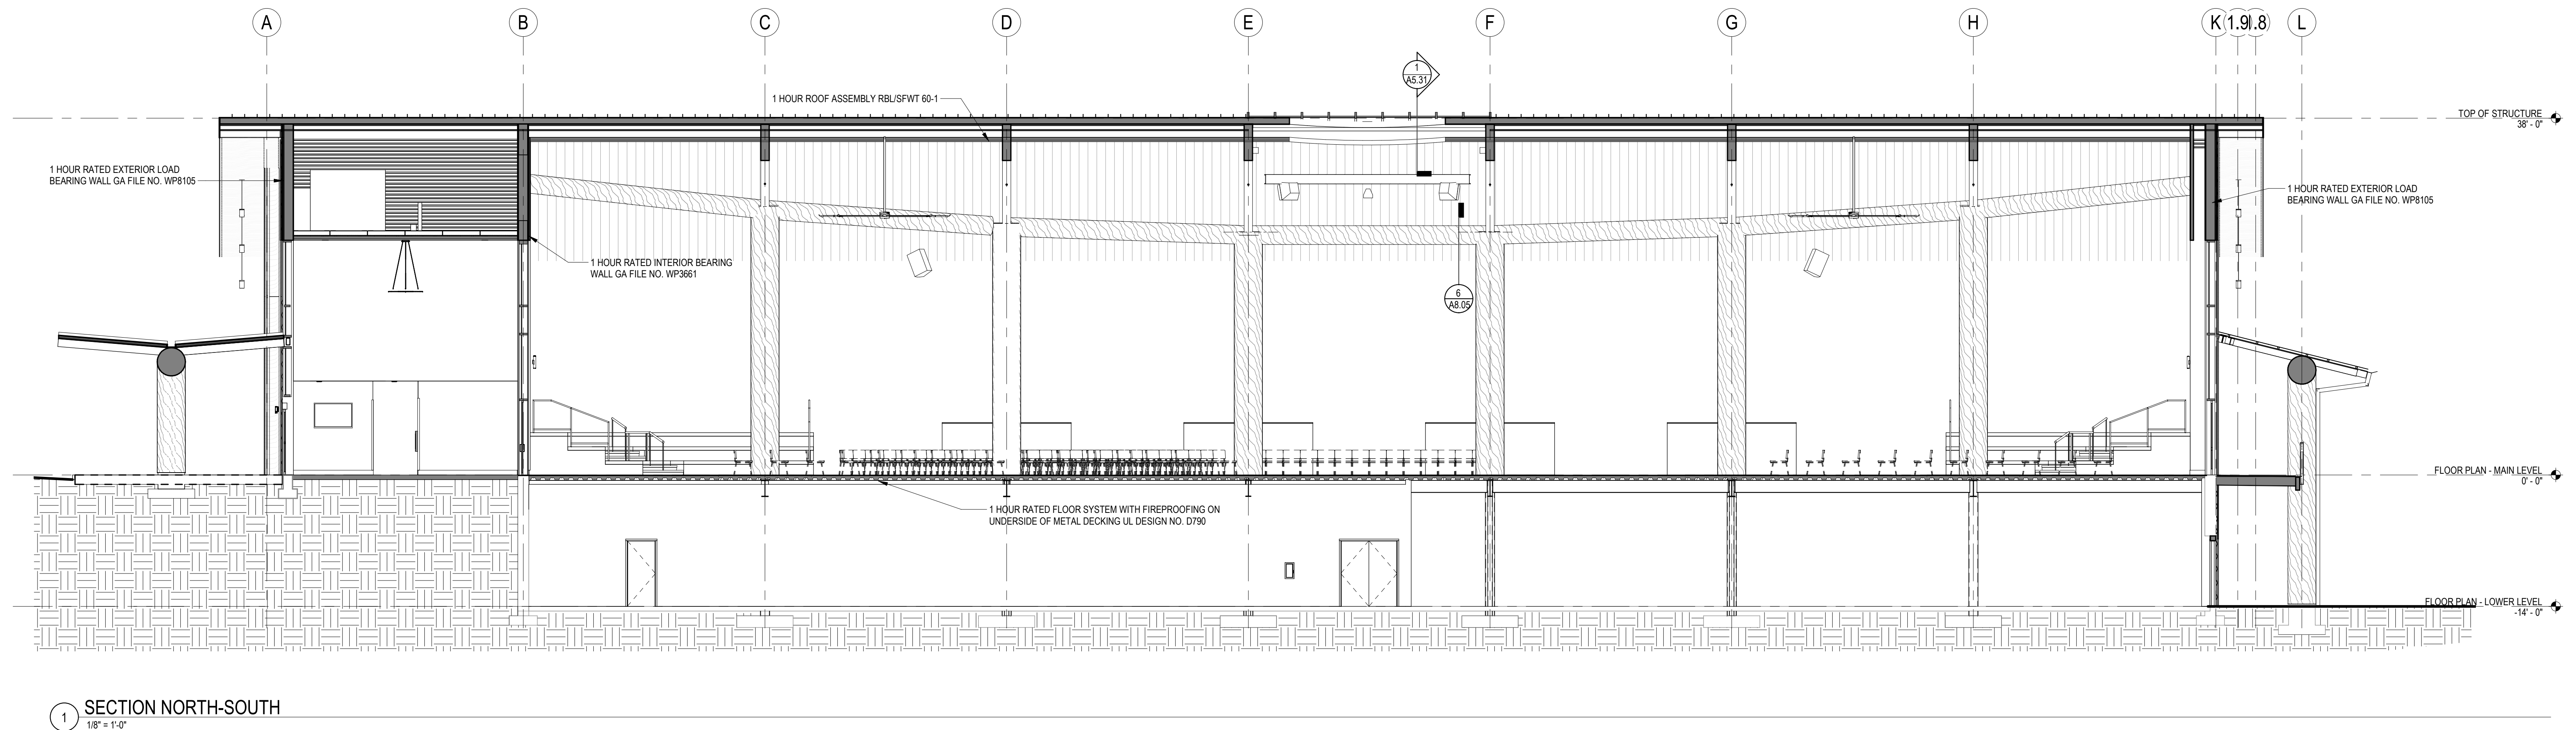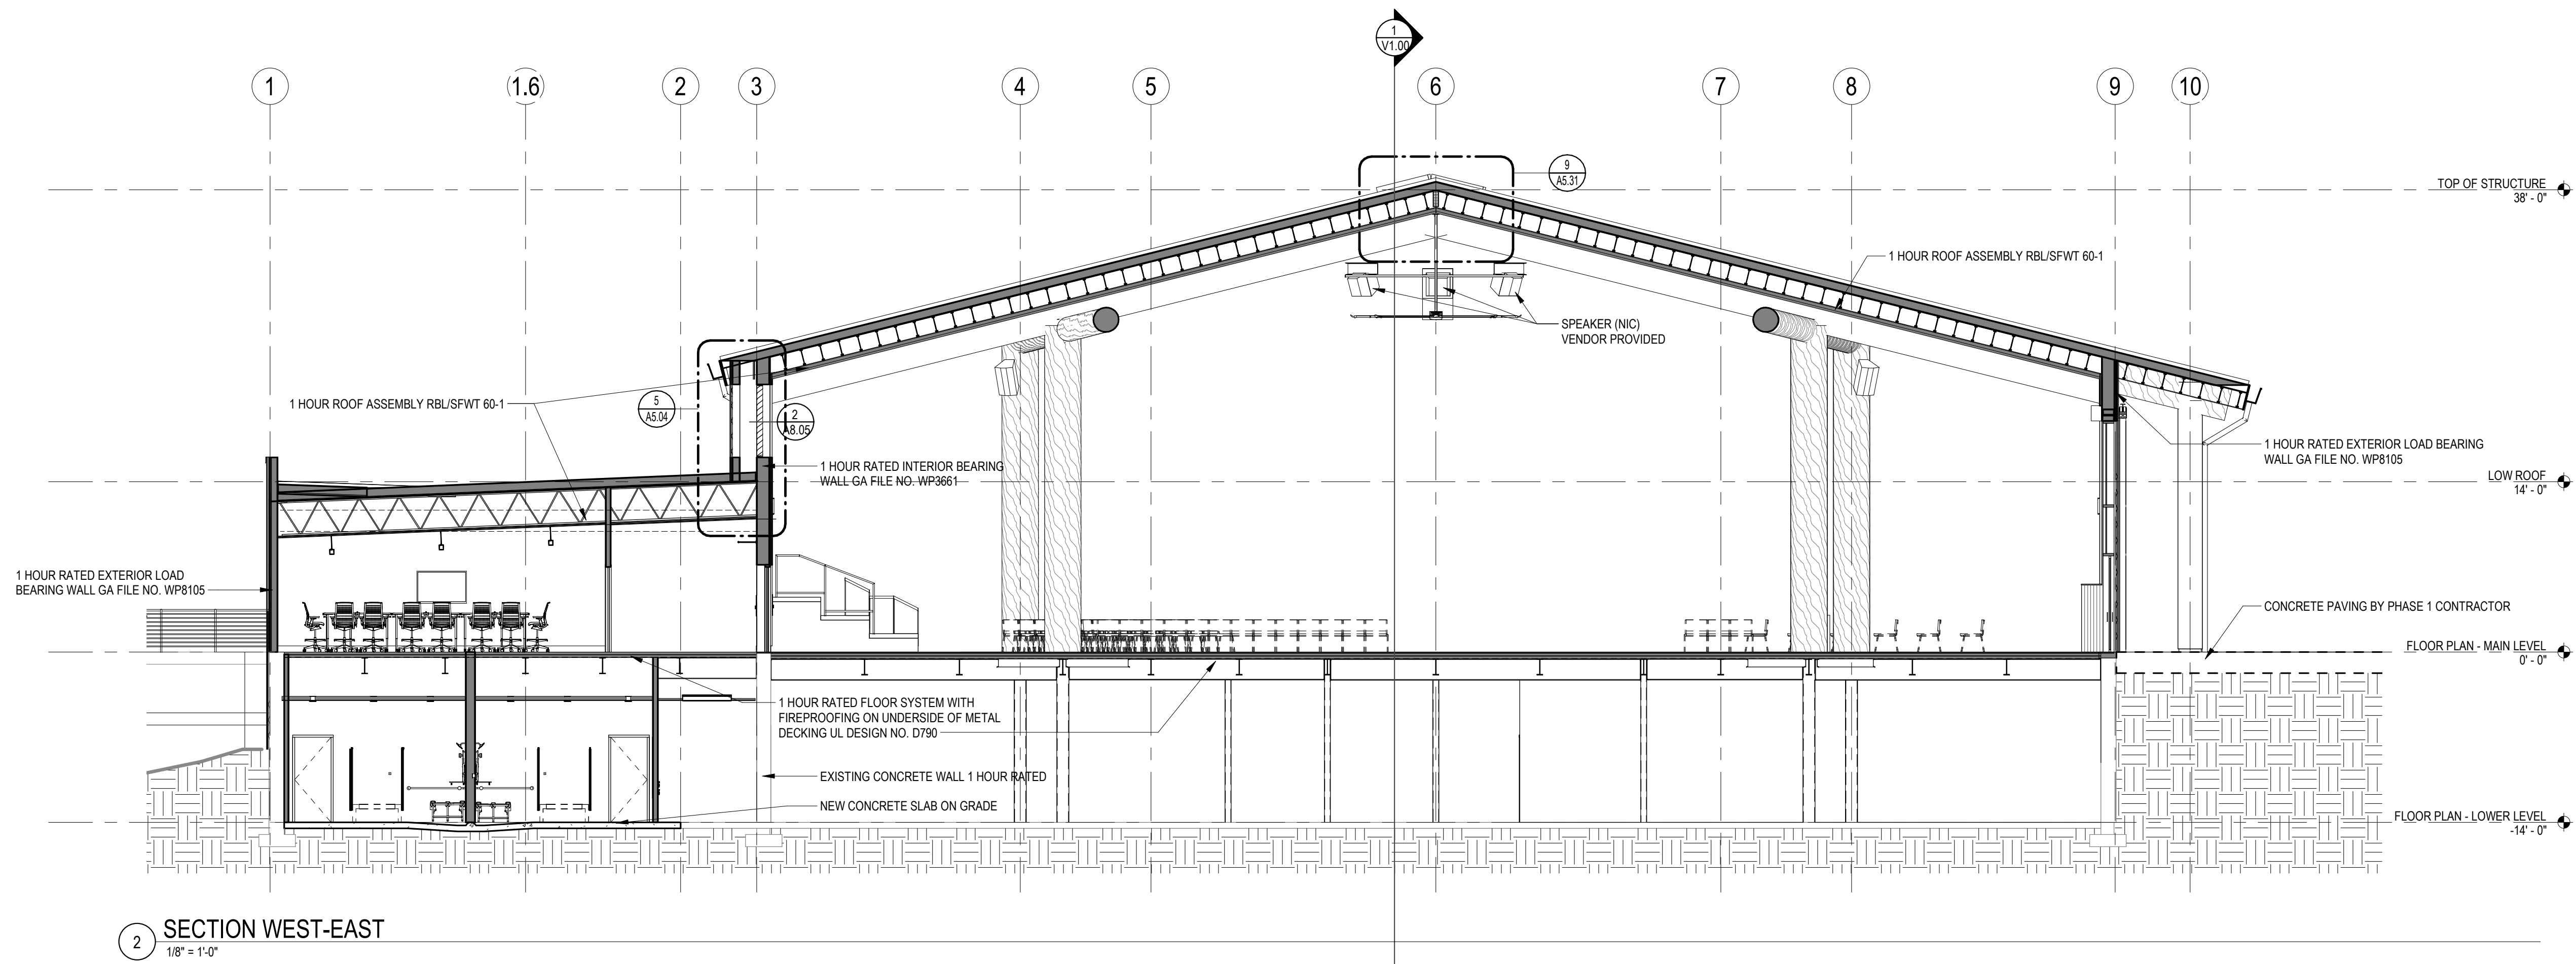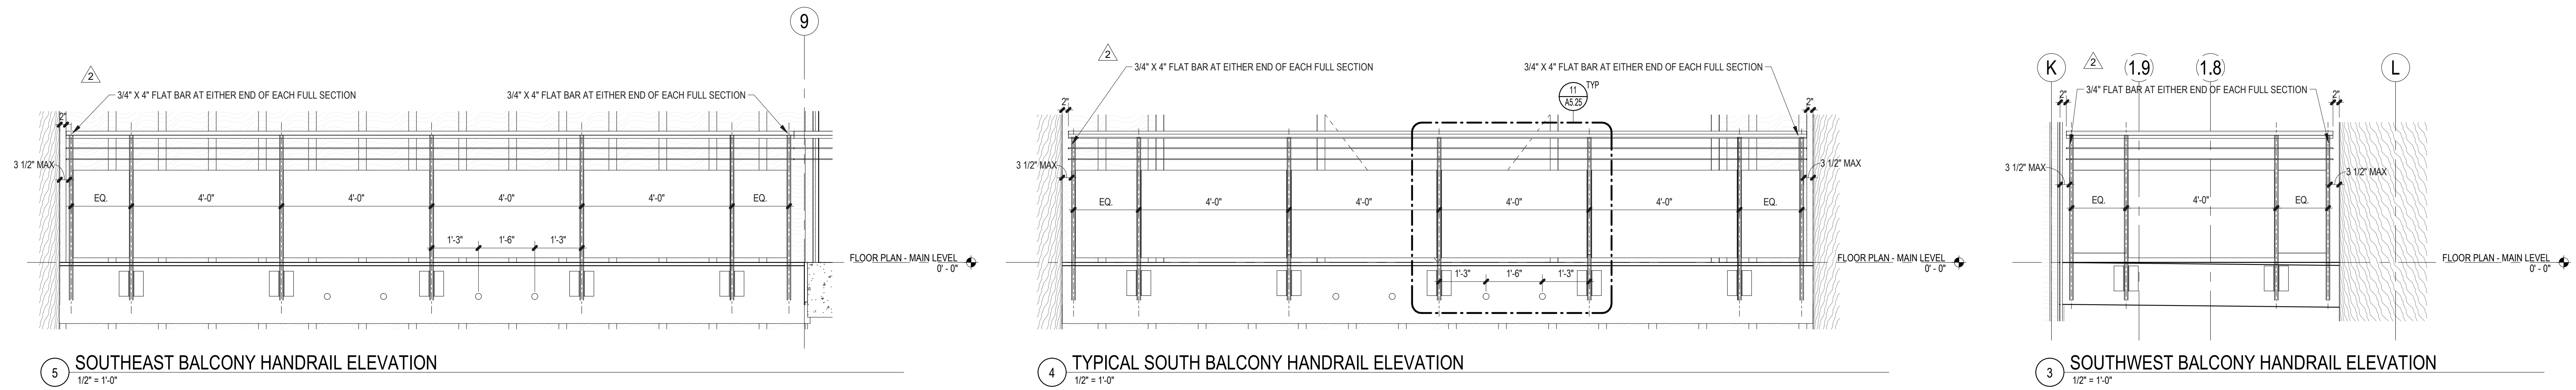

PROJECT INFORMATION	
PROJECT NUMBER:	17031
PROJECT LEAD:	DC
DRAWN BY:	AB




7512 TOTEM BEACH RD
TULALIP, WA 98271

WALL SECTIONS - EAST

[illegible]

PROJECT INFORMATION	
PROJECT NUMBER:	17031
PROJECT LEAD:	DC
DRAWN BY:	AB

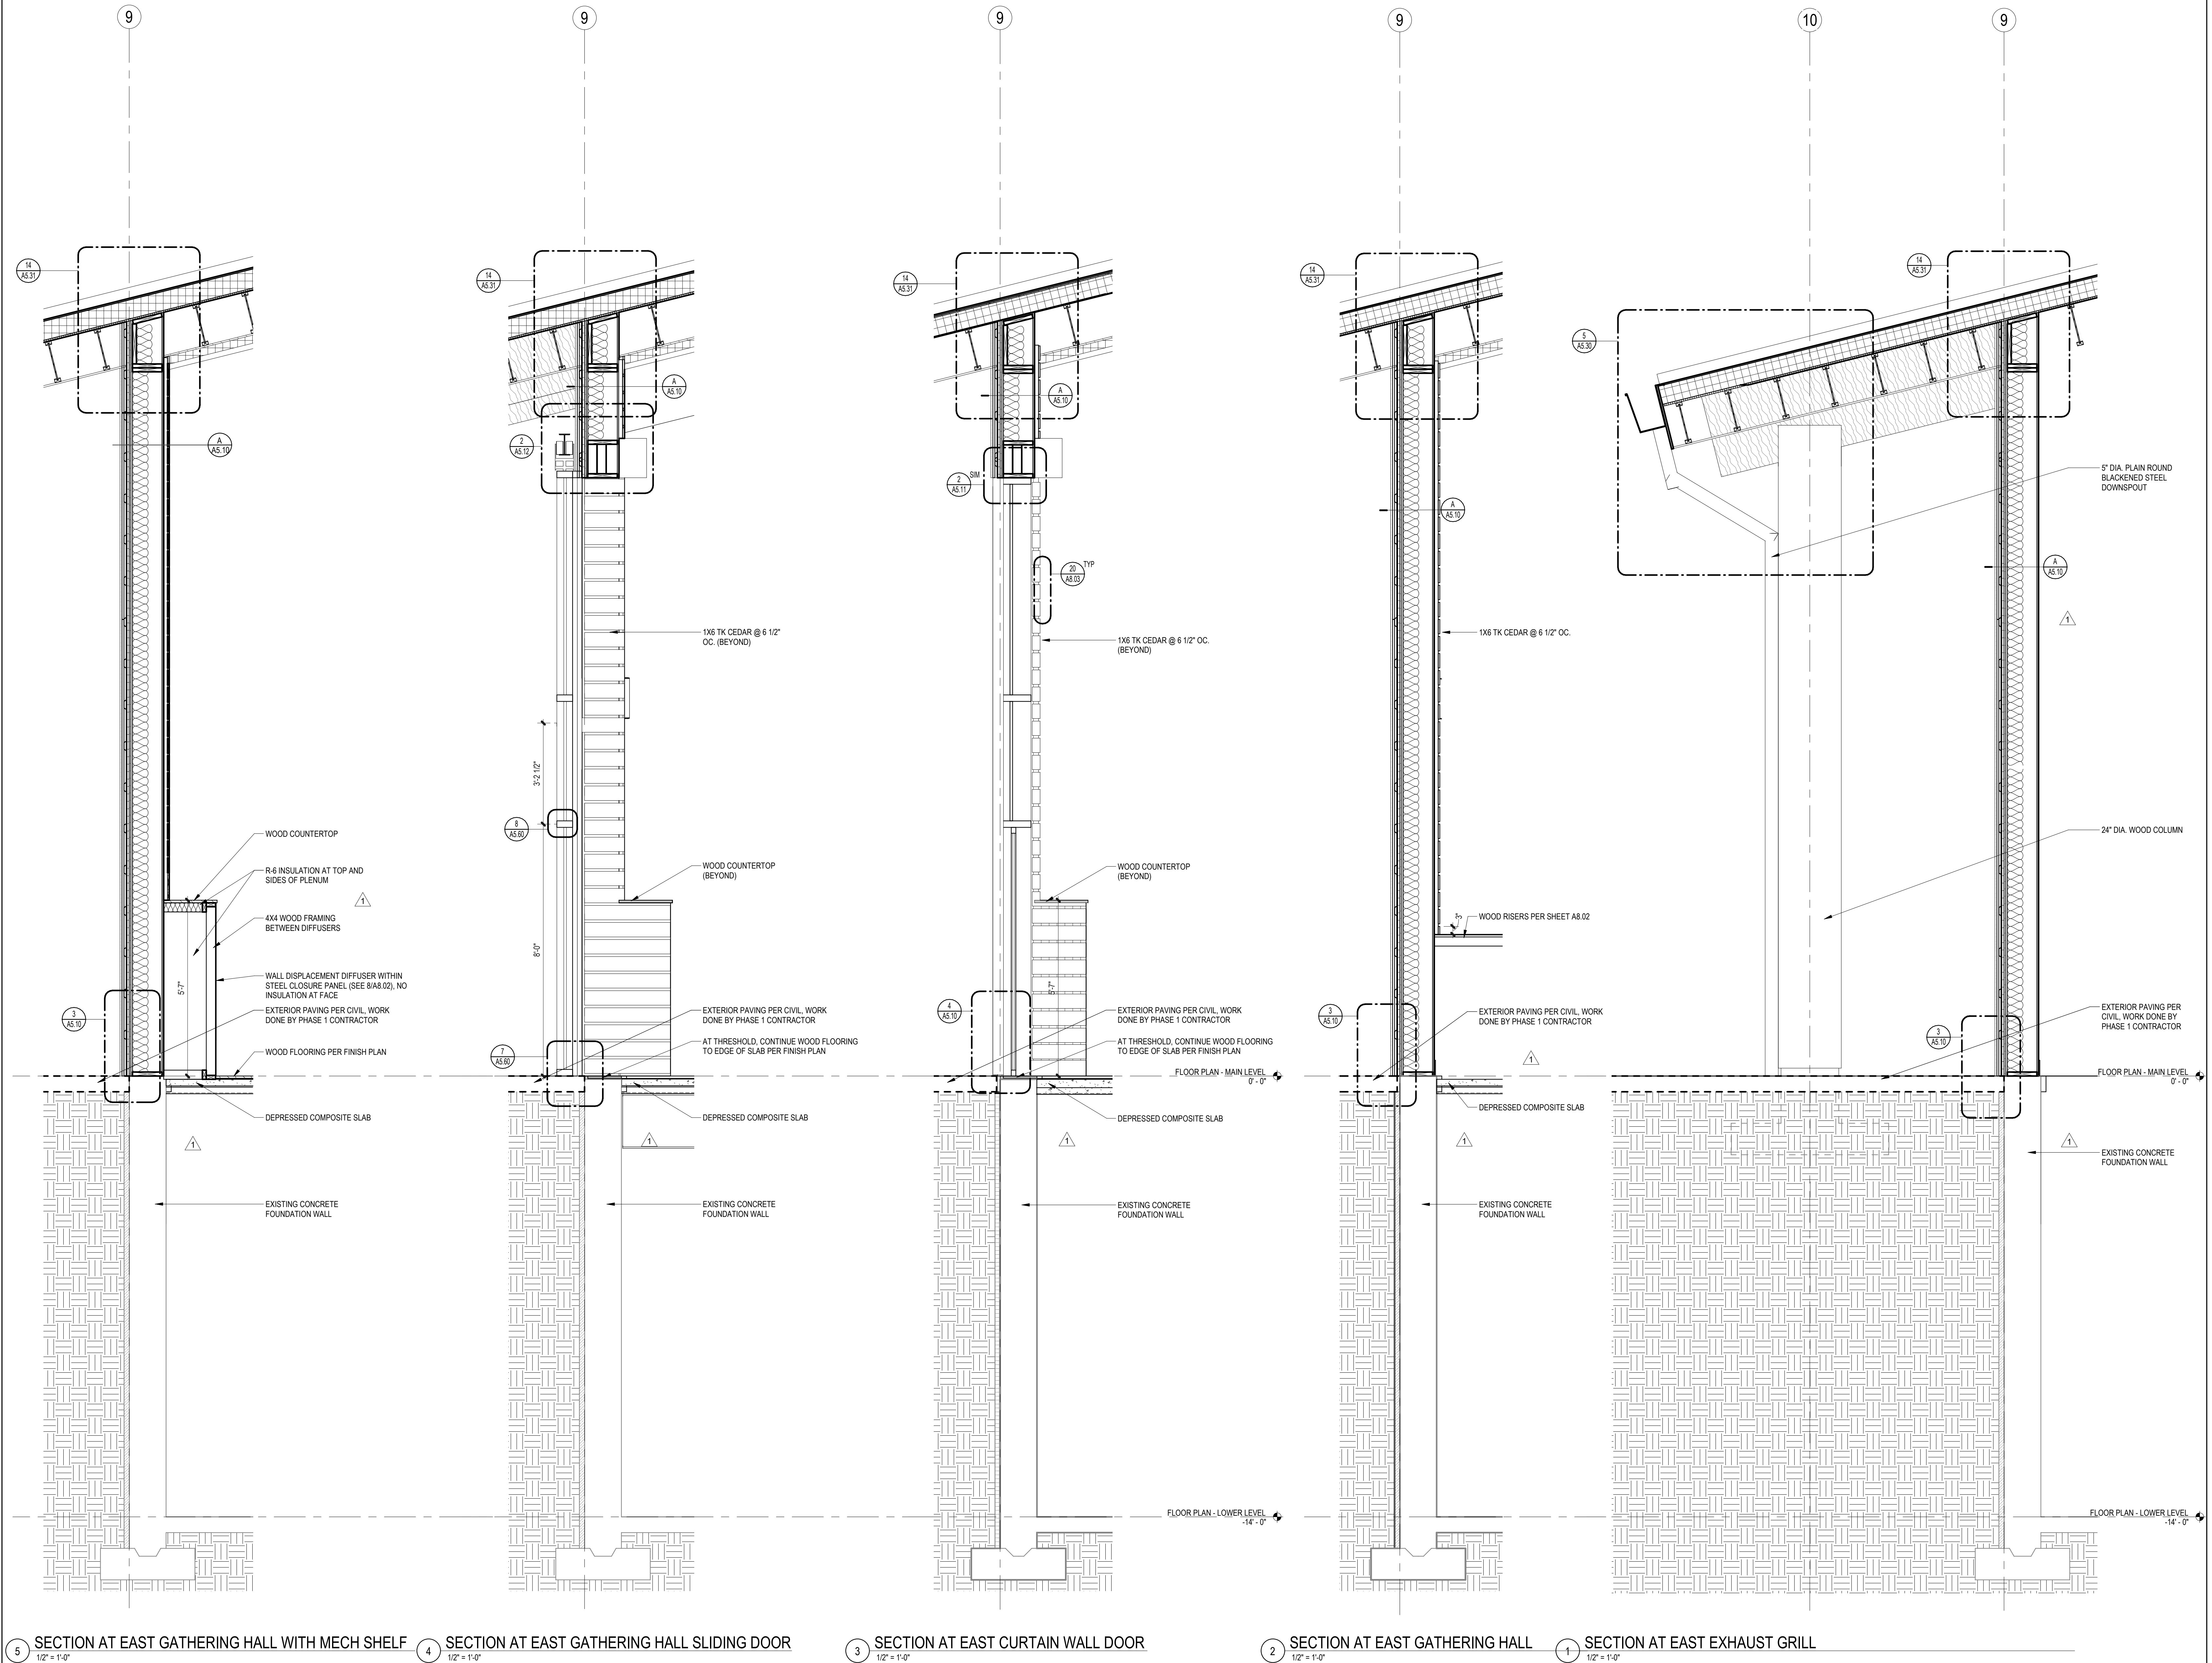


7512 TOTEM BEACH RD
TULALIP, WA 98271

WALL SECTIONS - SOUTH

[illegible]

PROJECT INFORMATION	
PROJECT NUMBER:	17031
PROJECT LEAD:	DC
DRAWN BY:	AB

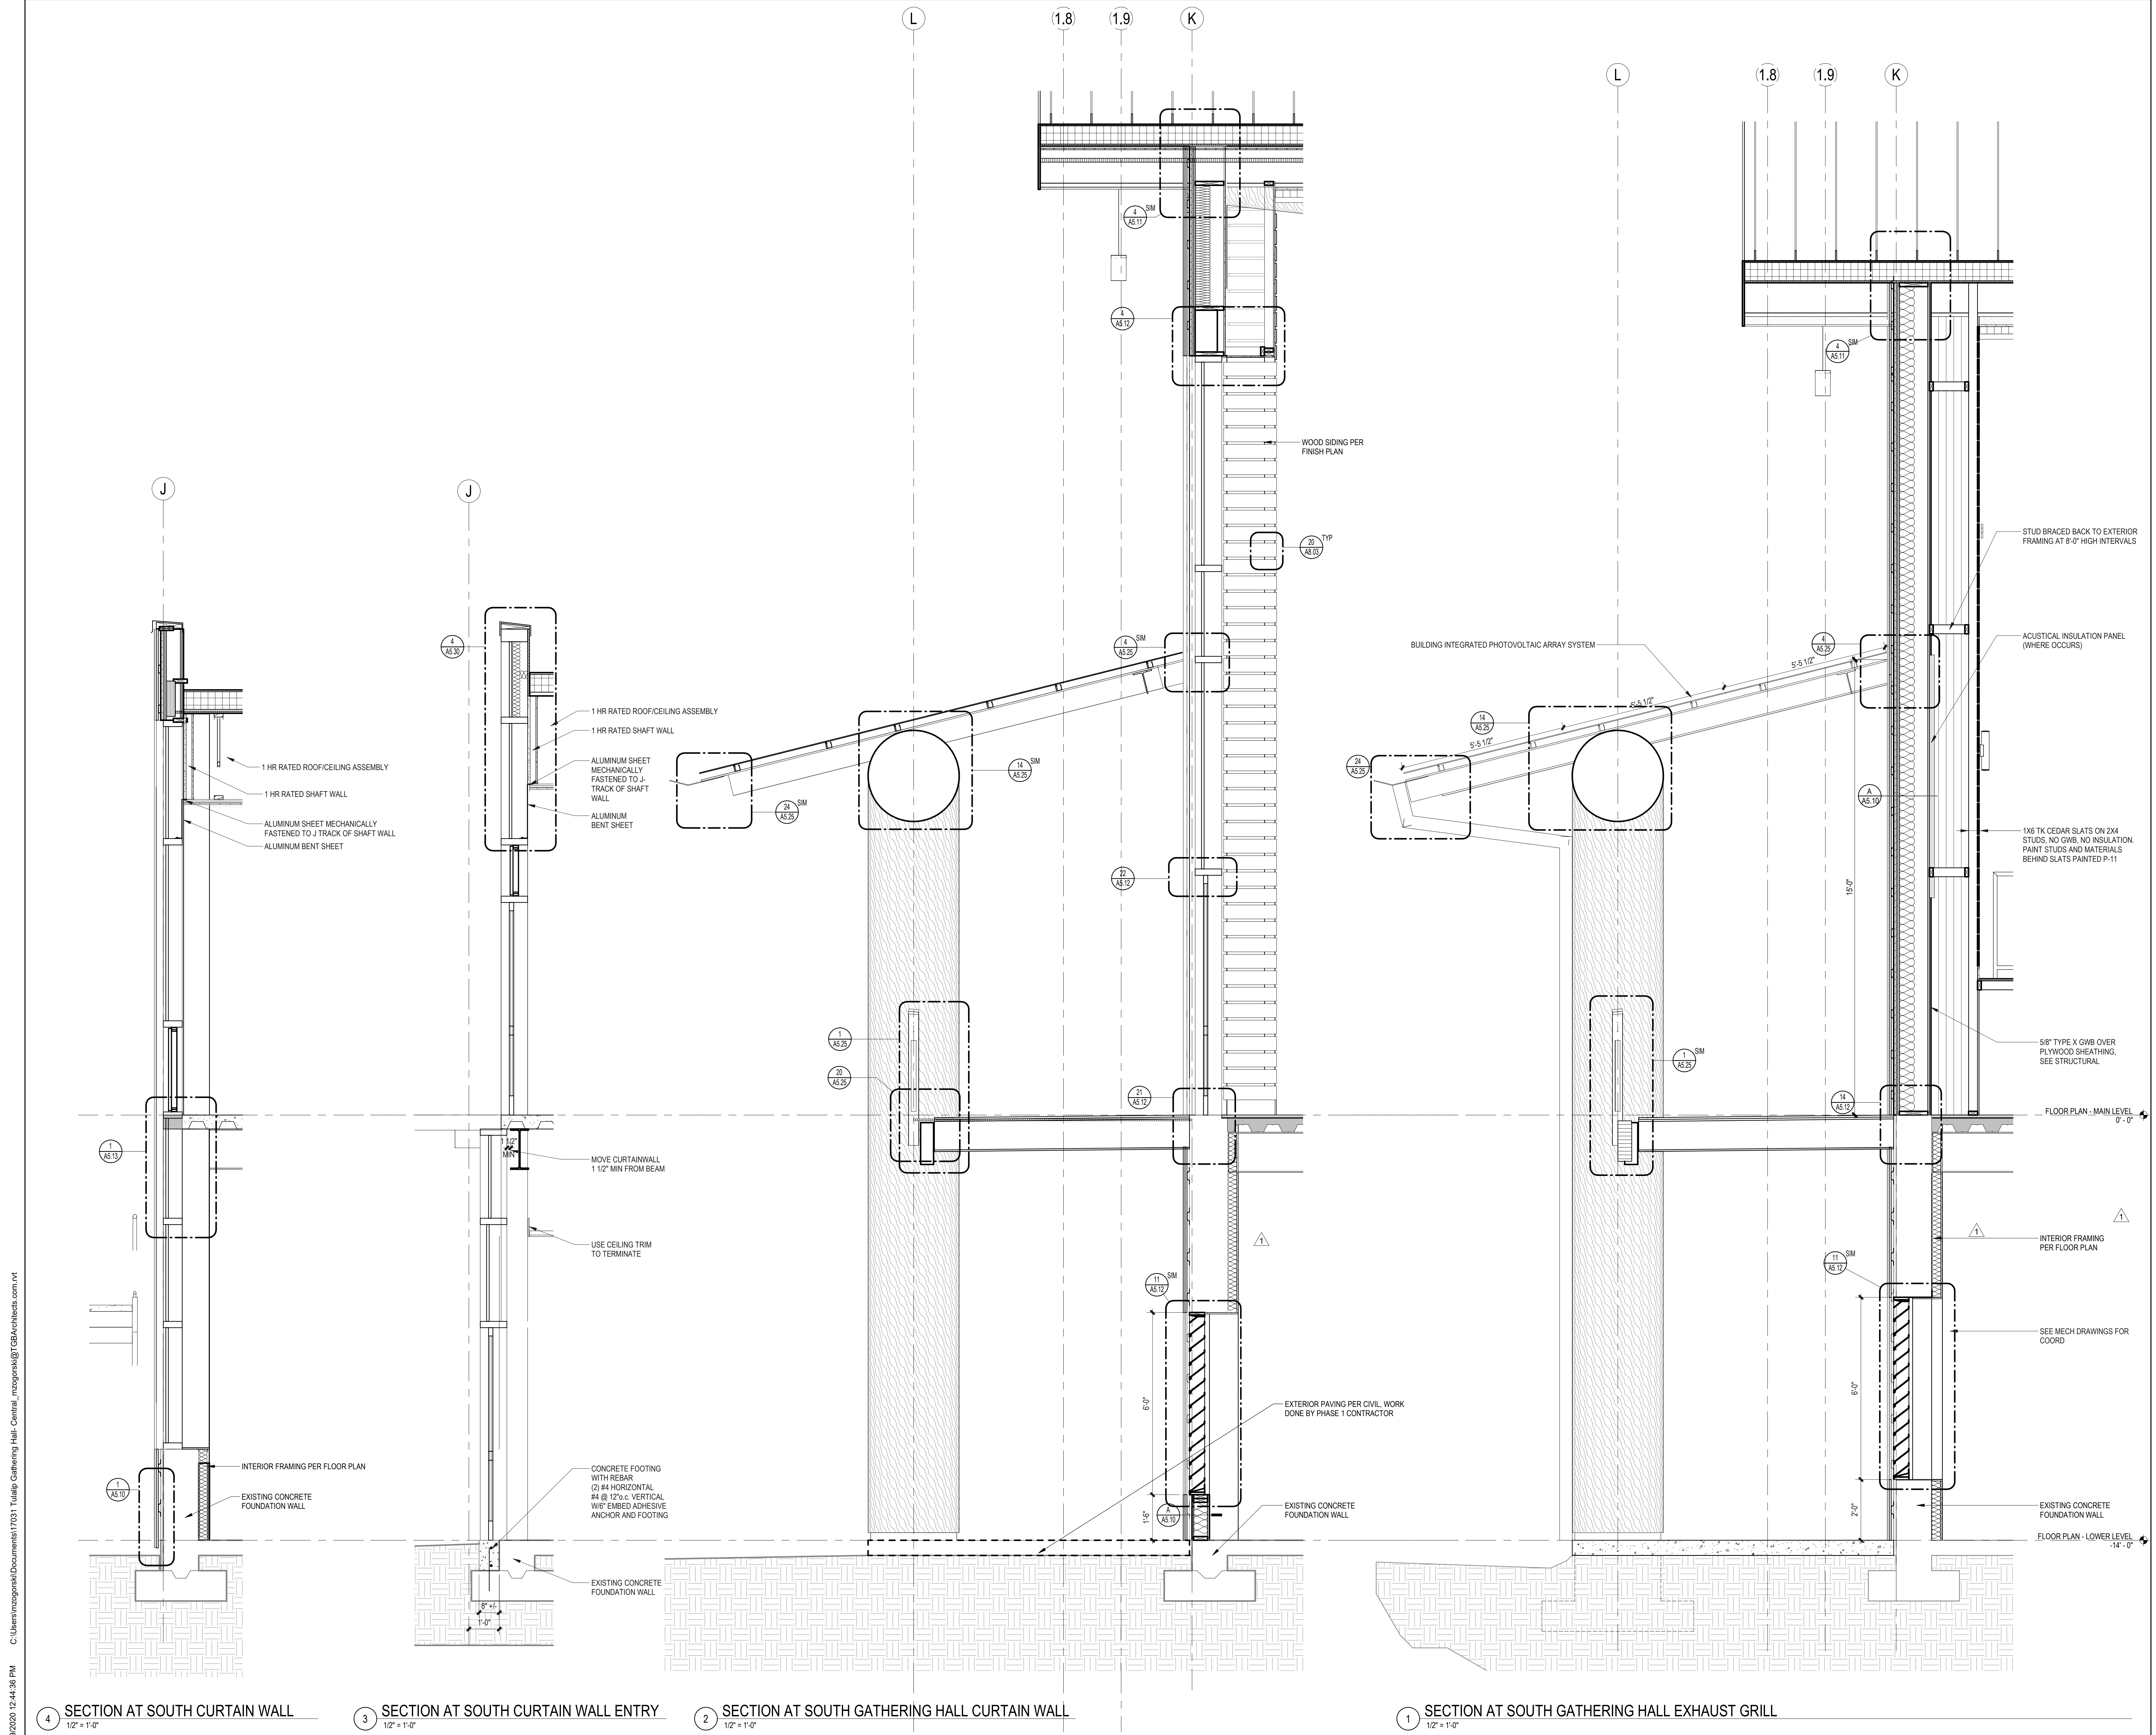

7512 TOTEM BEACH RD
TULALIP, WA 98271


WALL SECTIONS - WEST

[illegible]

PROJECT INFORMATION	
PROJECT NUMBER:	17031
PROJECT LEAD:	DC
DRAWN BY:	AB

SHEET NO

A5.04

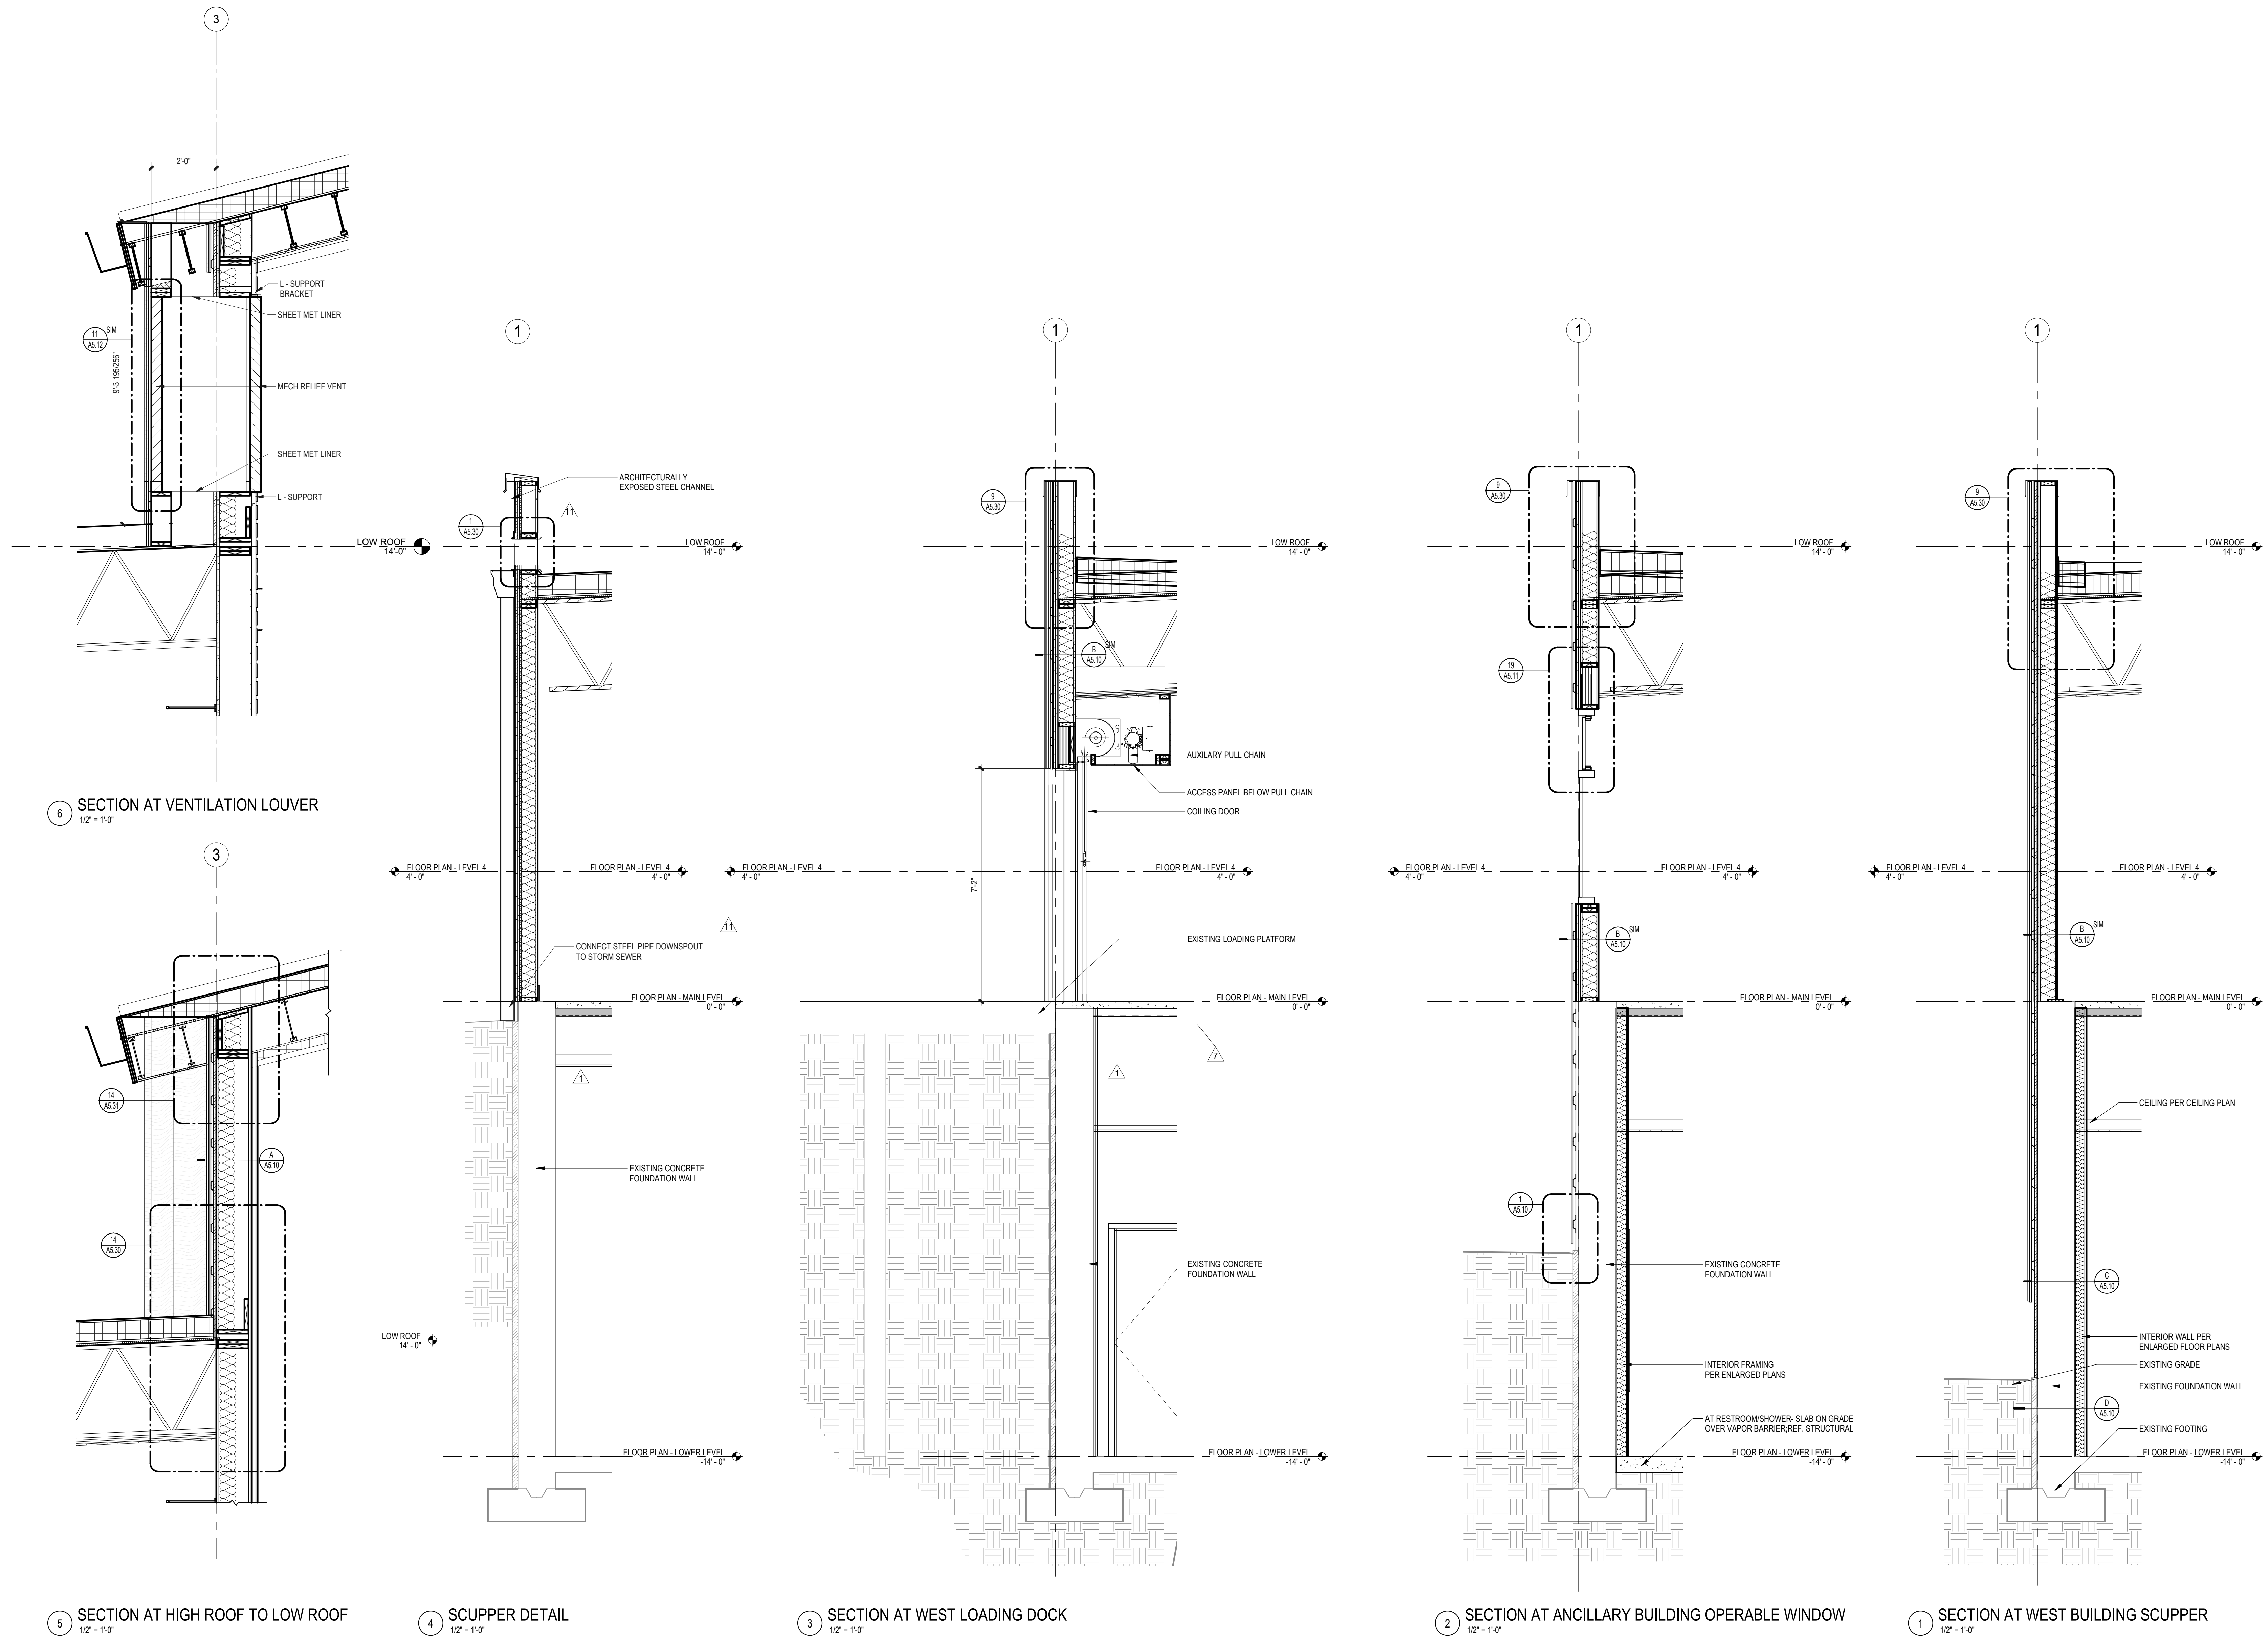

TULALIP TRIBES GATHERING HALL

7512 TOTEM BEACH RD
TULALIP, WA 98271

PHASE 2 - BUILDING AND LANDSCAPING


ELEVATOR AND STAIR PLANS AND SECTIONS

[illegible]


PROJECT INFORMATION	
PROJECT NUMBER:	17031
PROJECT LEAD:	DC
DRAWN BY:	RL

SHEET NO


A5.05

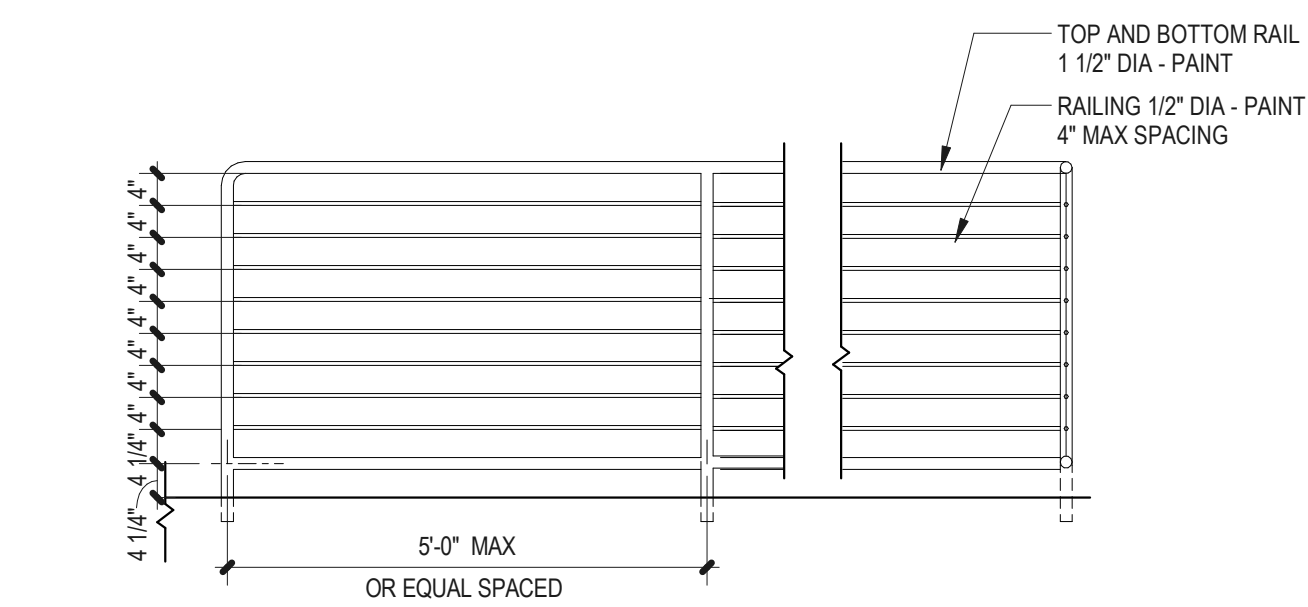


7 TYP GUARD RAIL
1/2" = 1'-0"

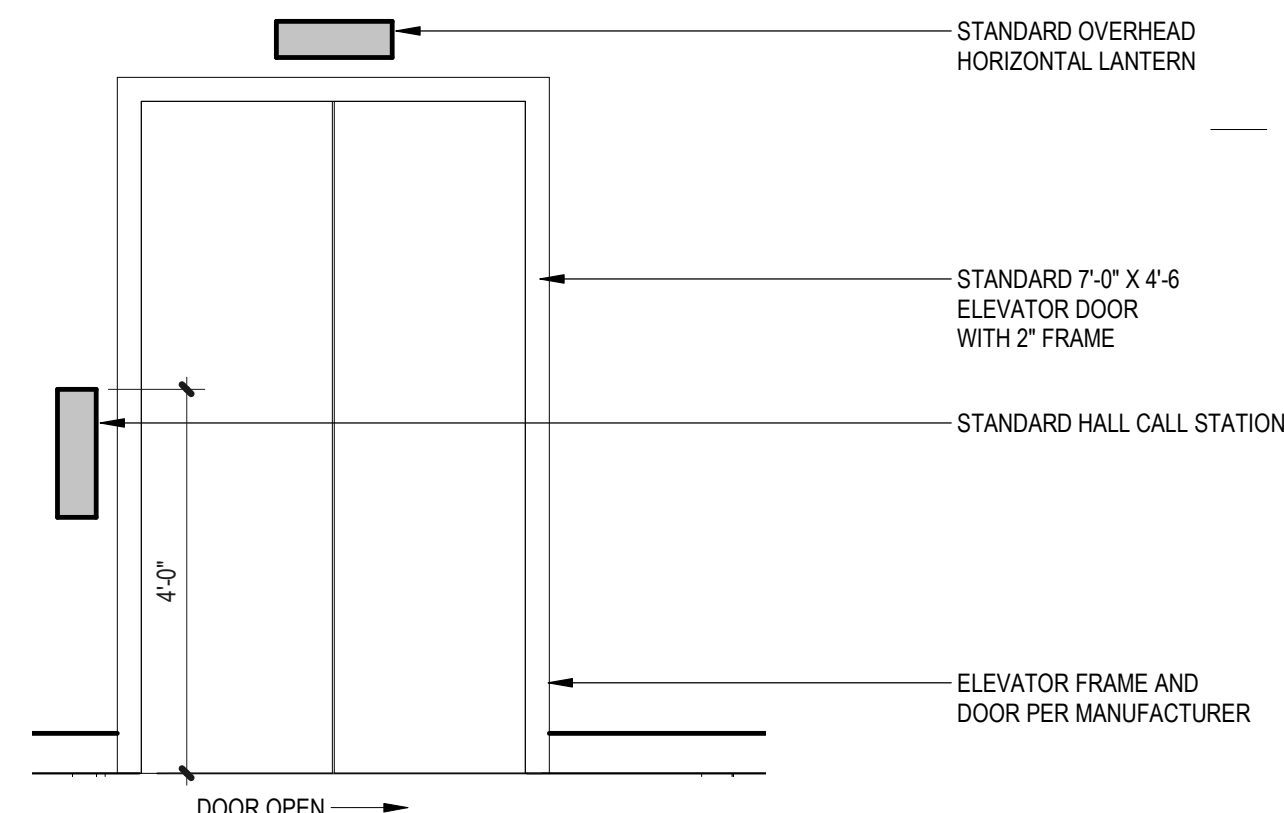


6 ELEVATOR DOOR ELEVATION
1/2" = 1'-0"

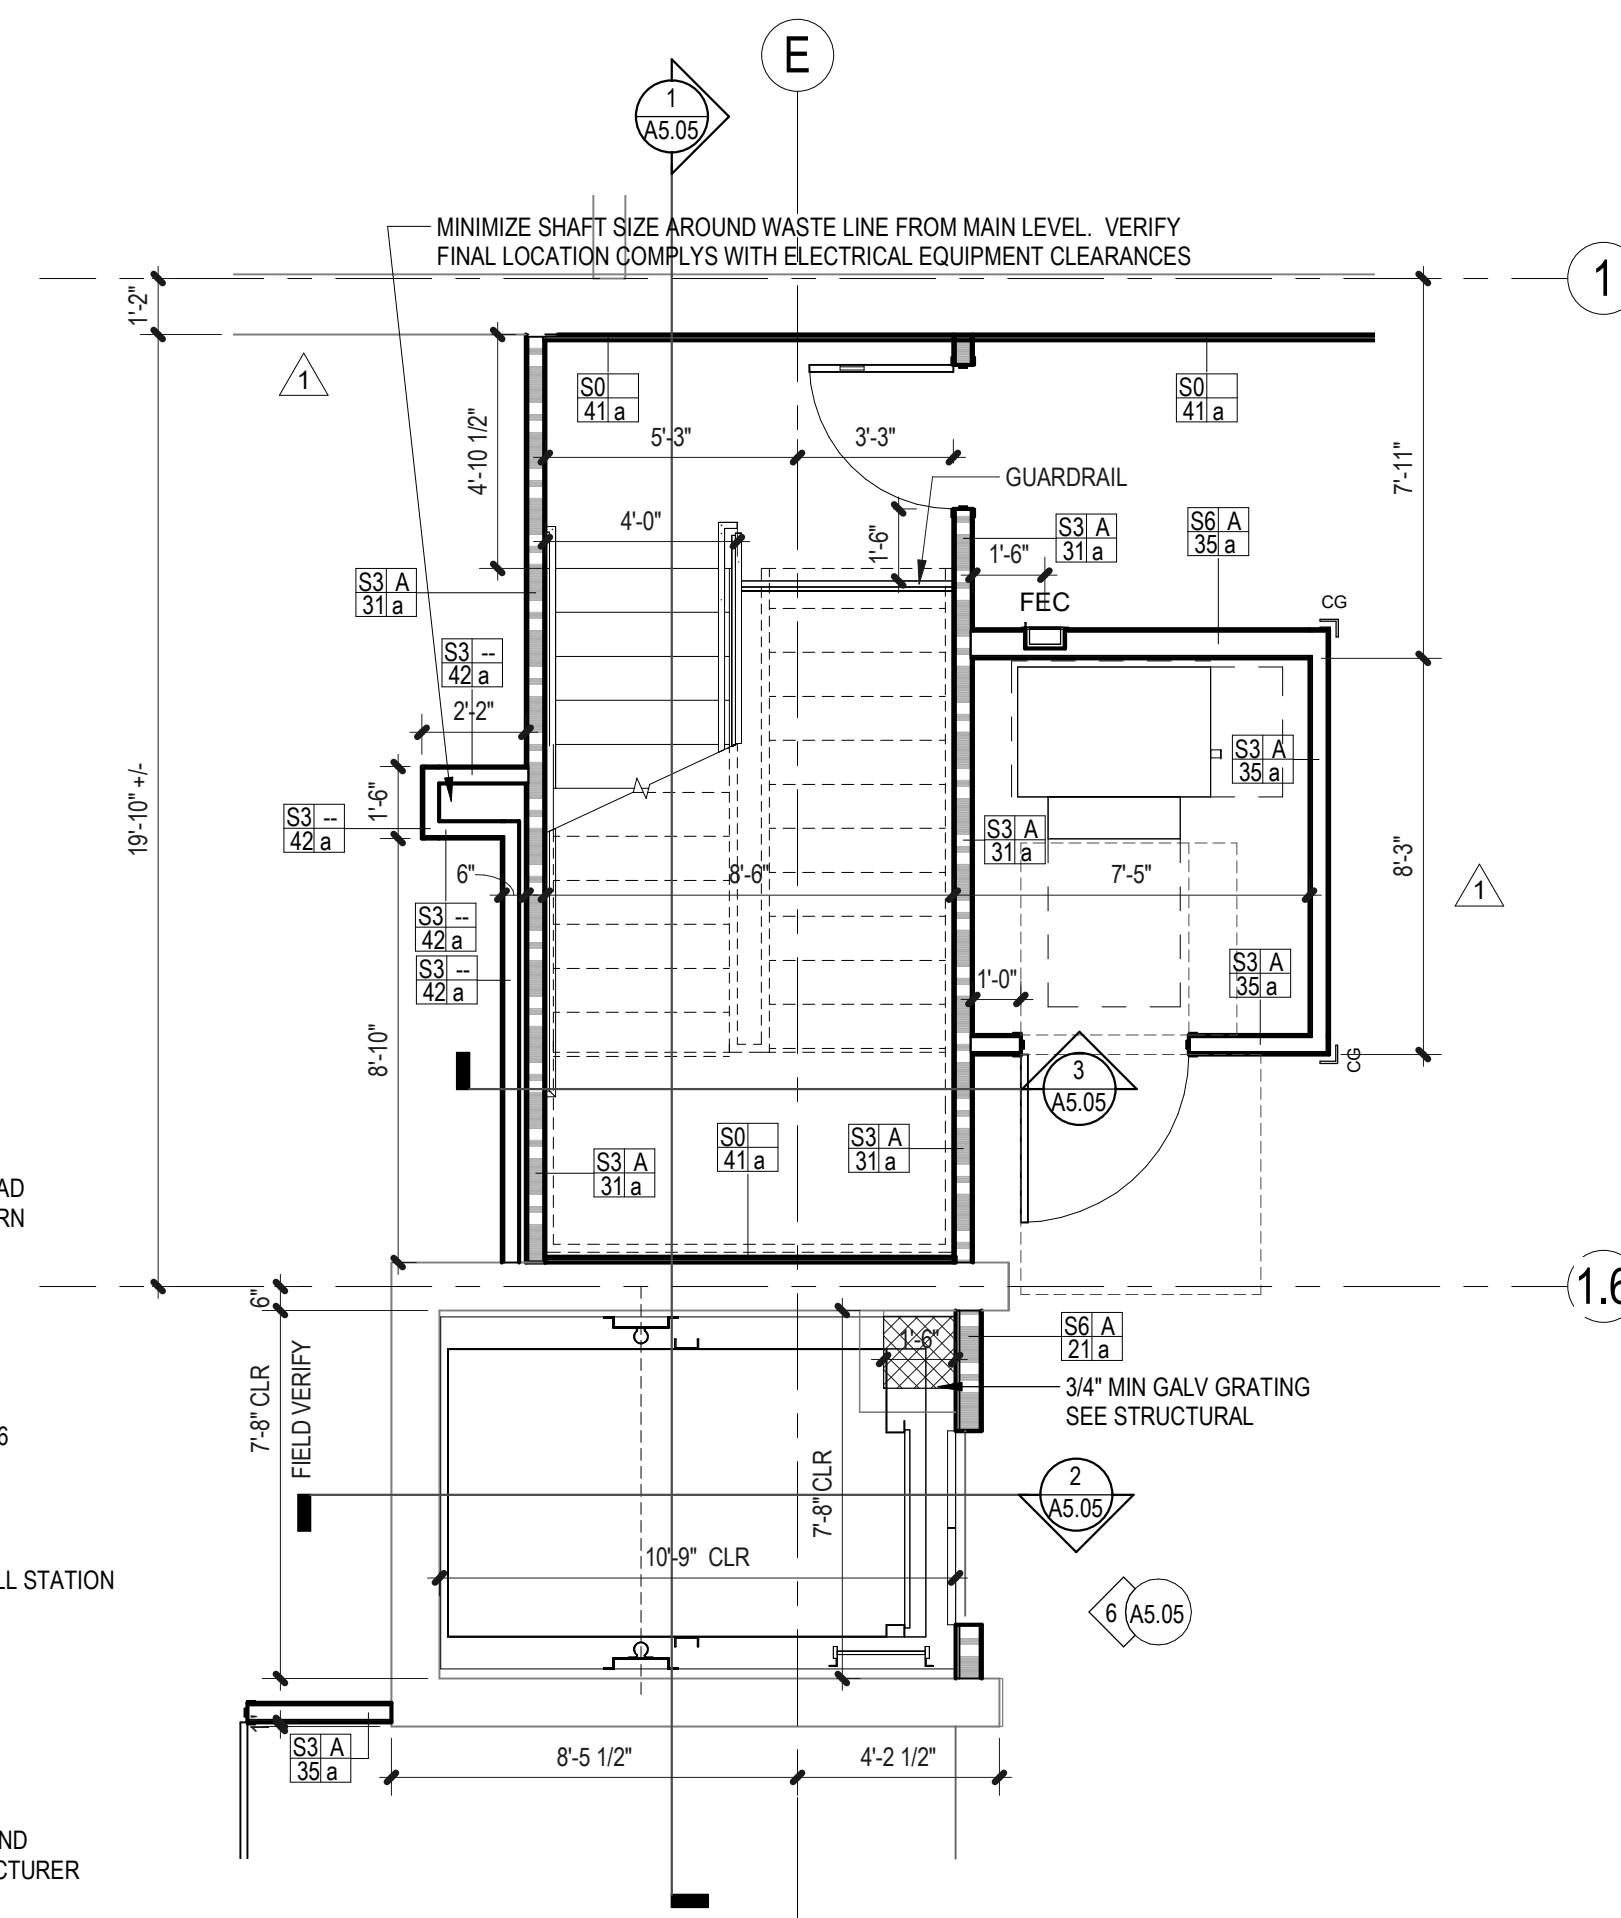


5 ENLARGED PLAN - STAIR AND ELEVATOR LOWER LEVEL
1/4" = 1'-0"

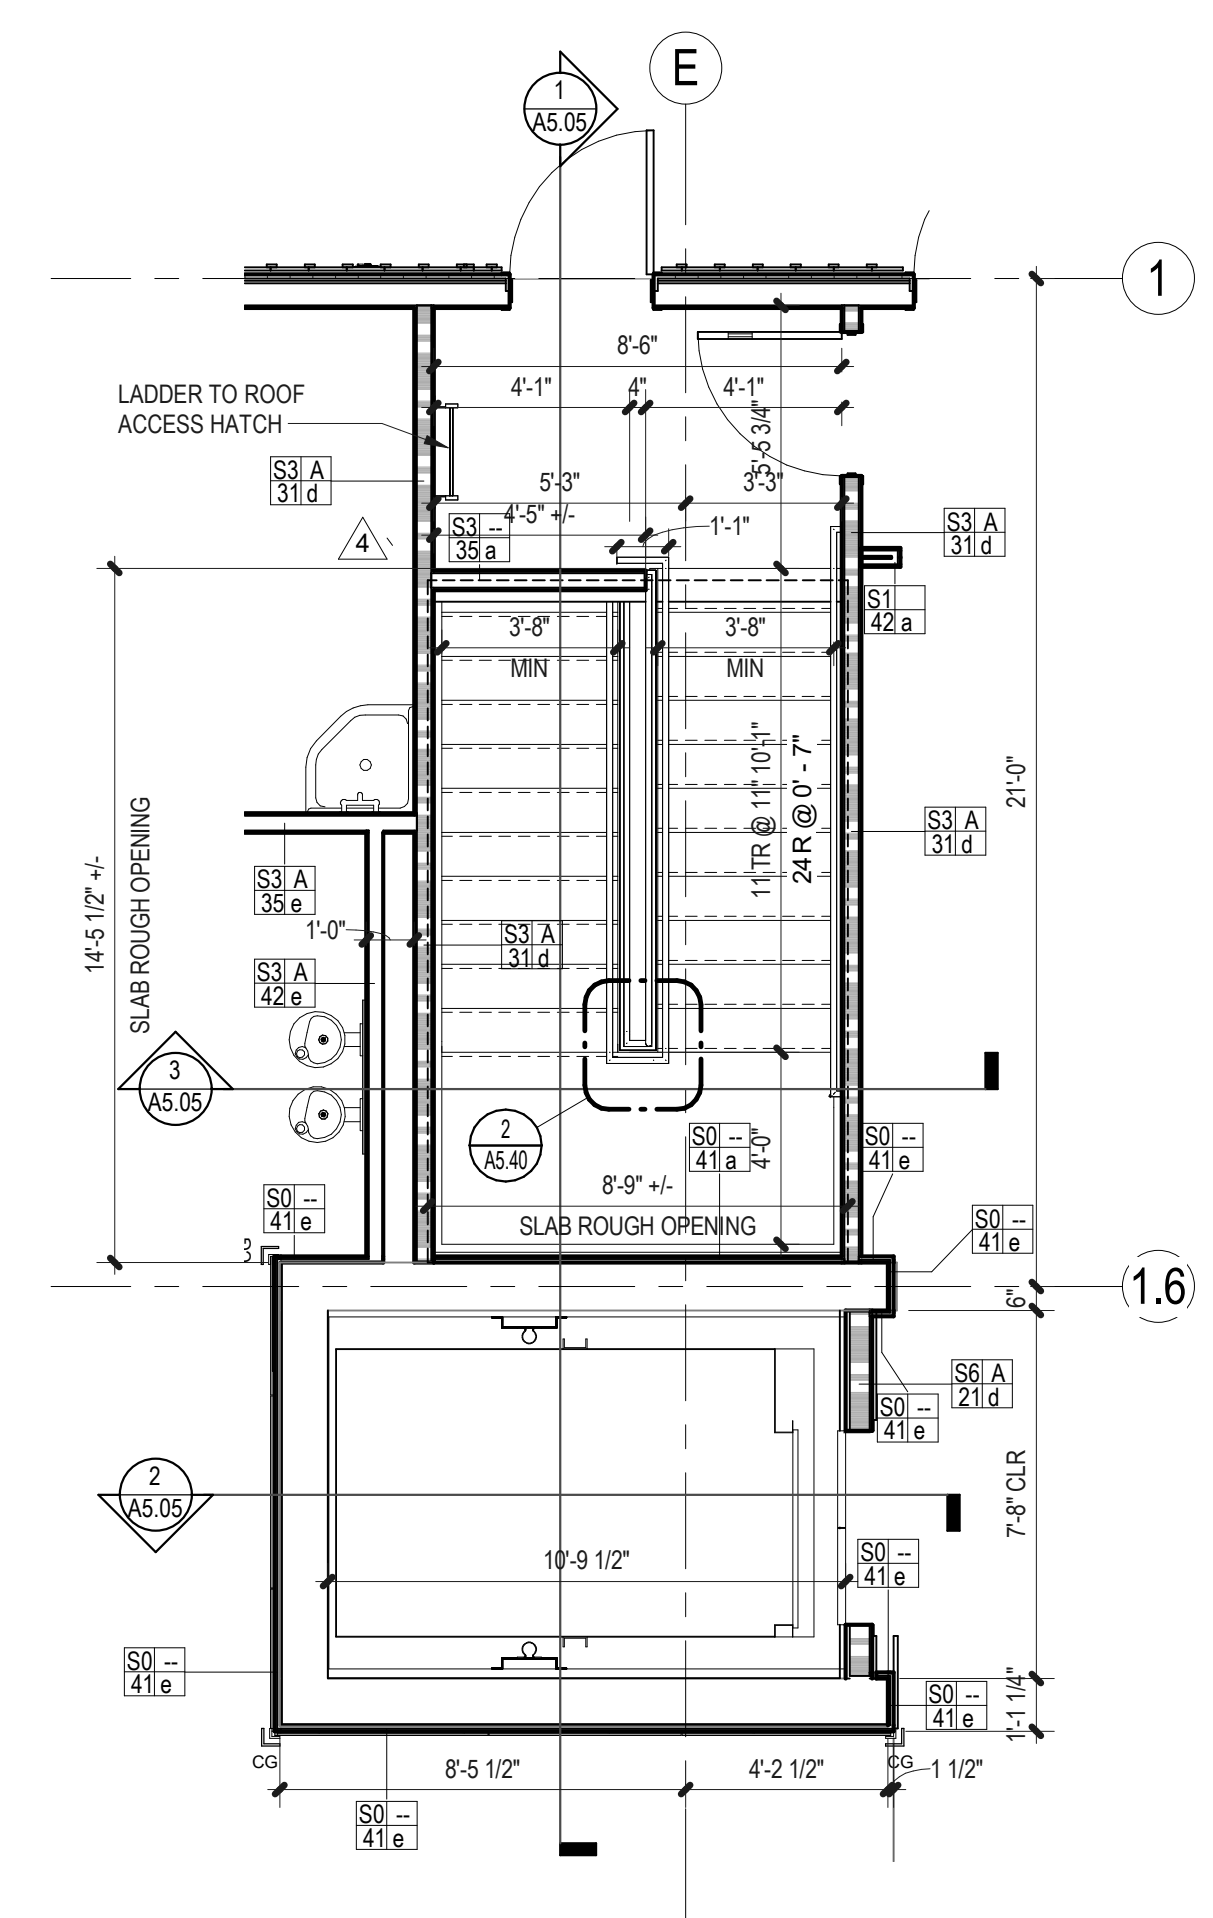


4 ENLARGED PLAN - STAIR AND ELEVATOR MAIN FLOOR
1/4" = 1'-0"

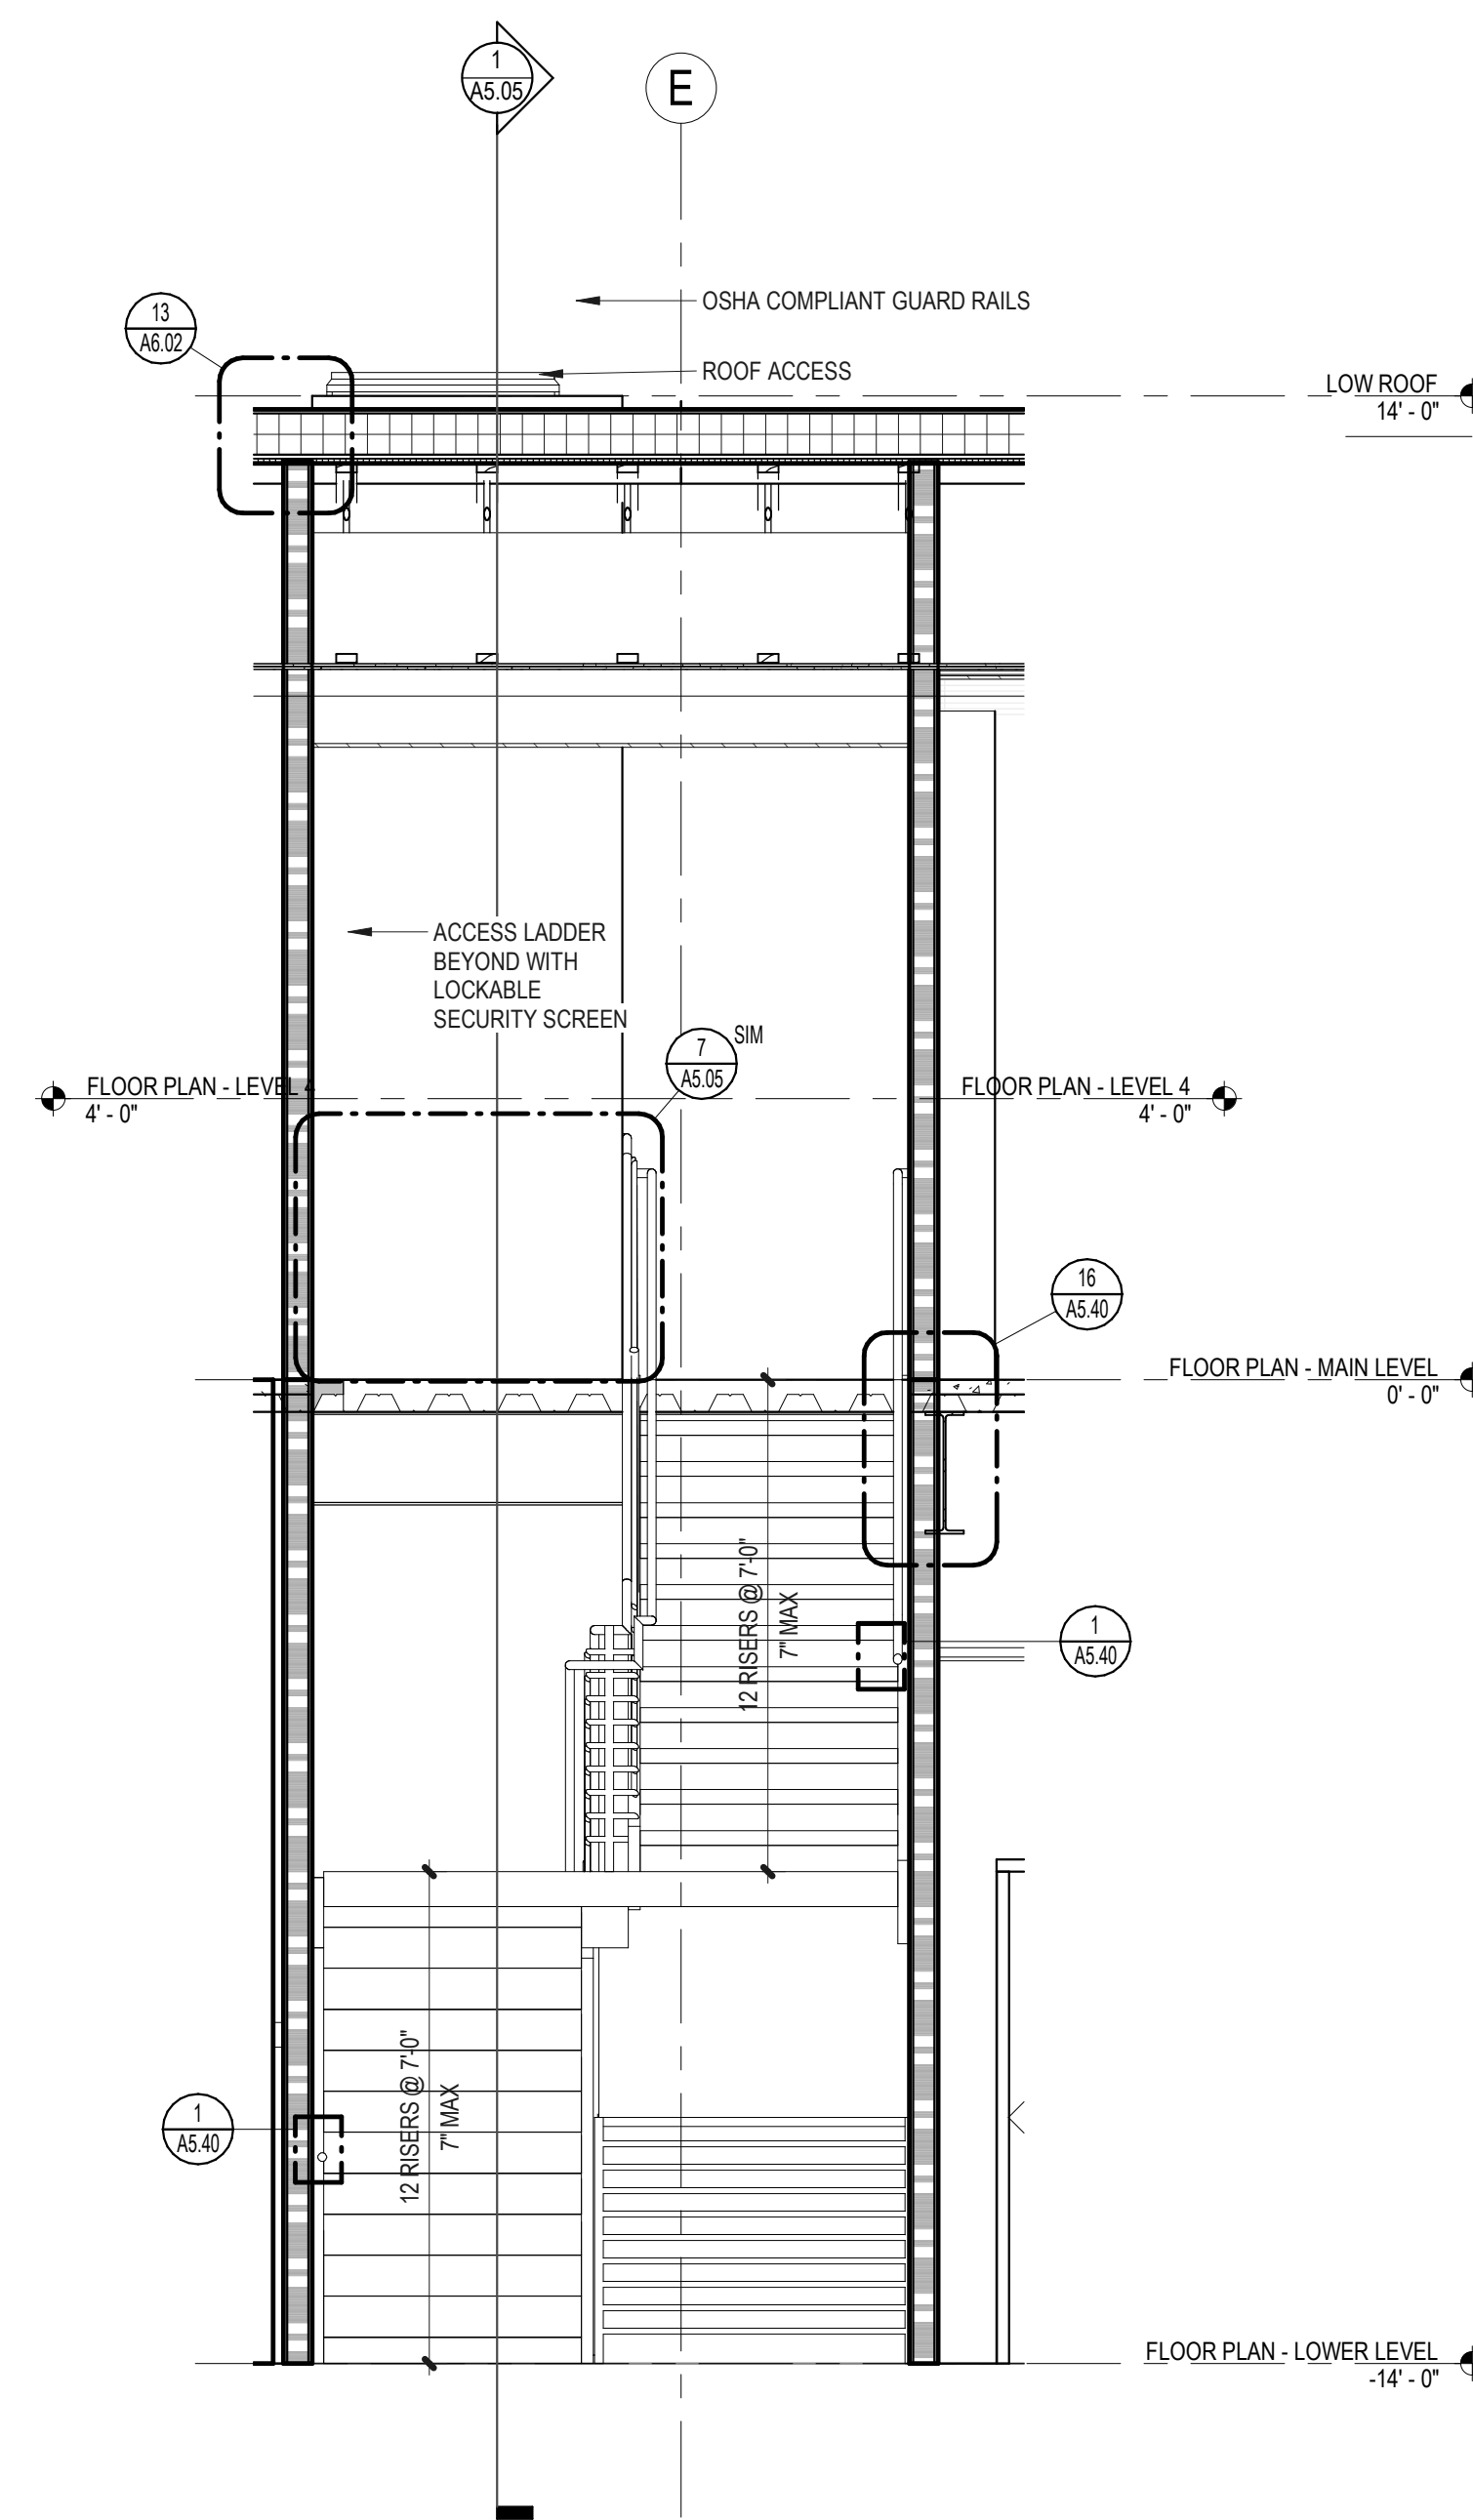

3 STAIR SECTION
3/8" = 1'-0"

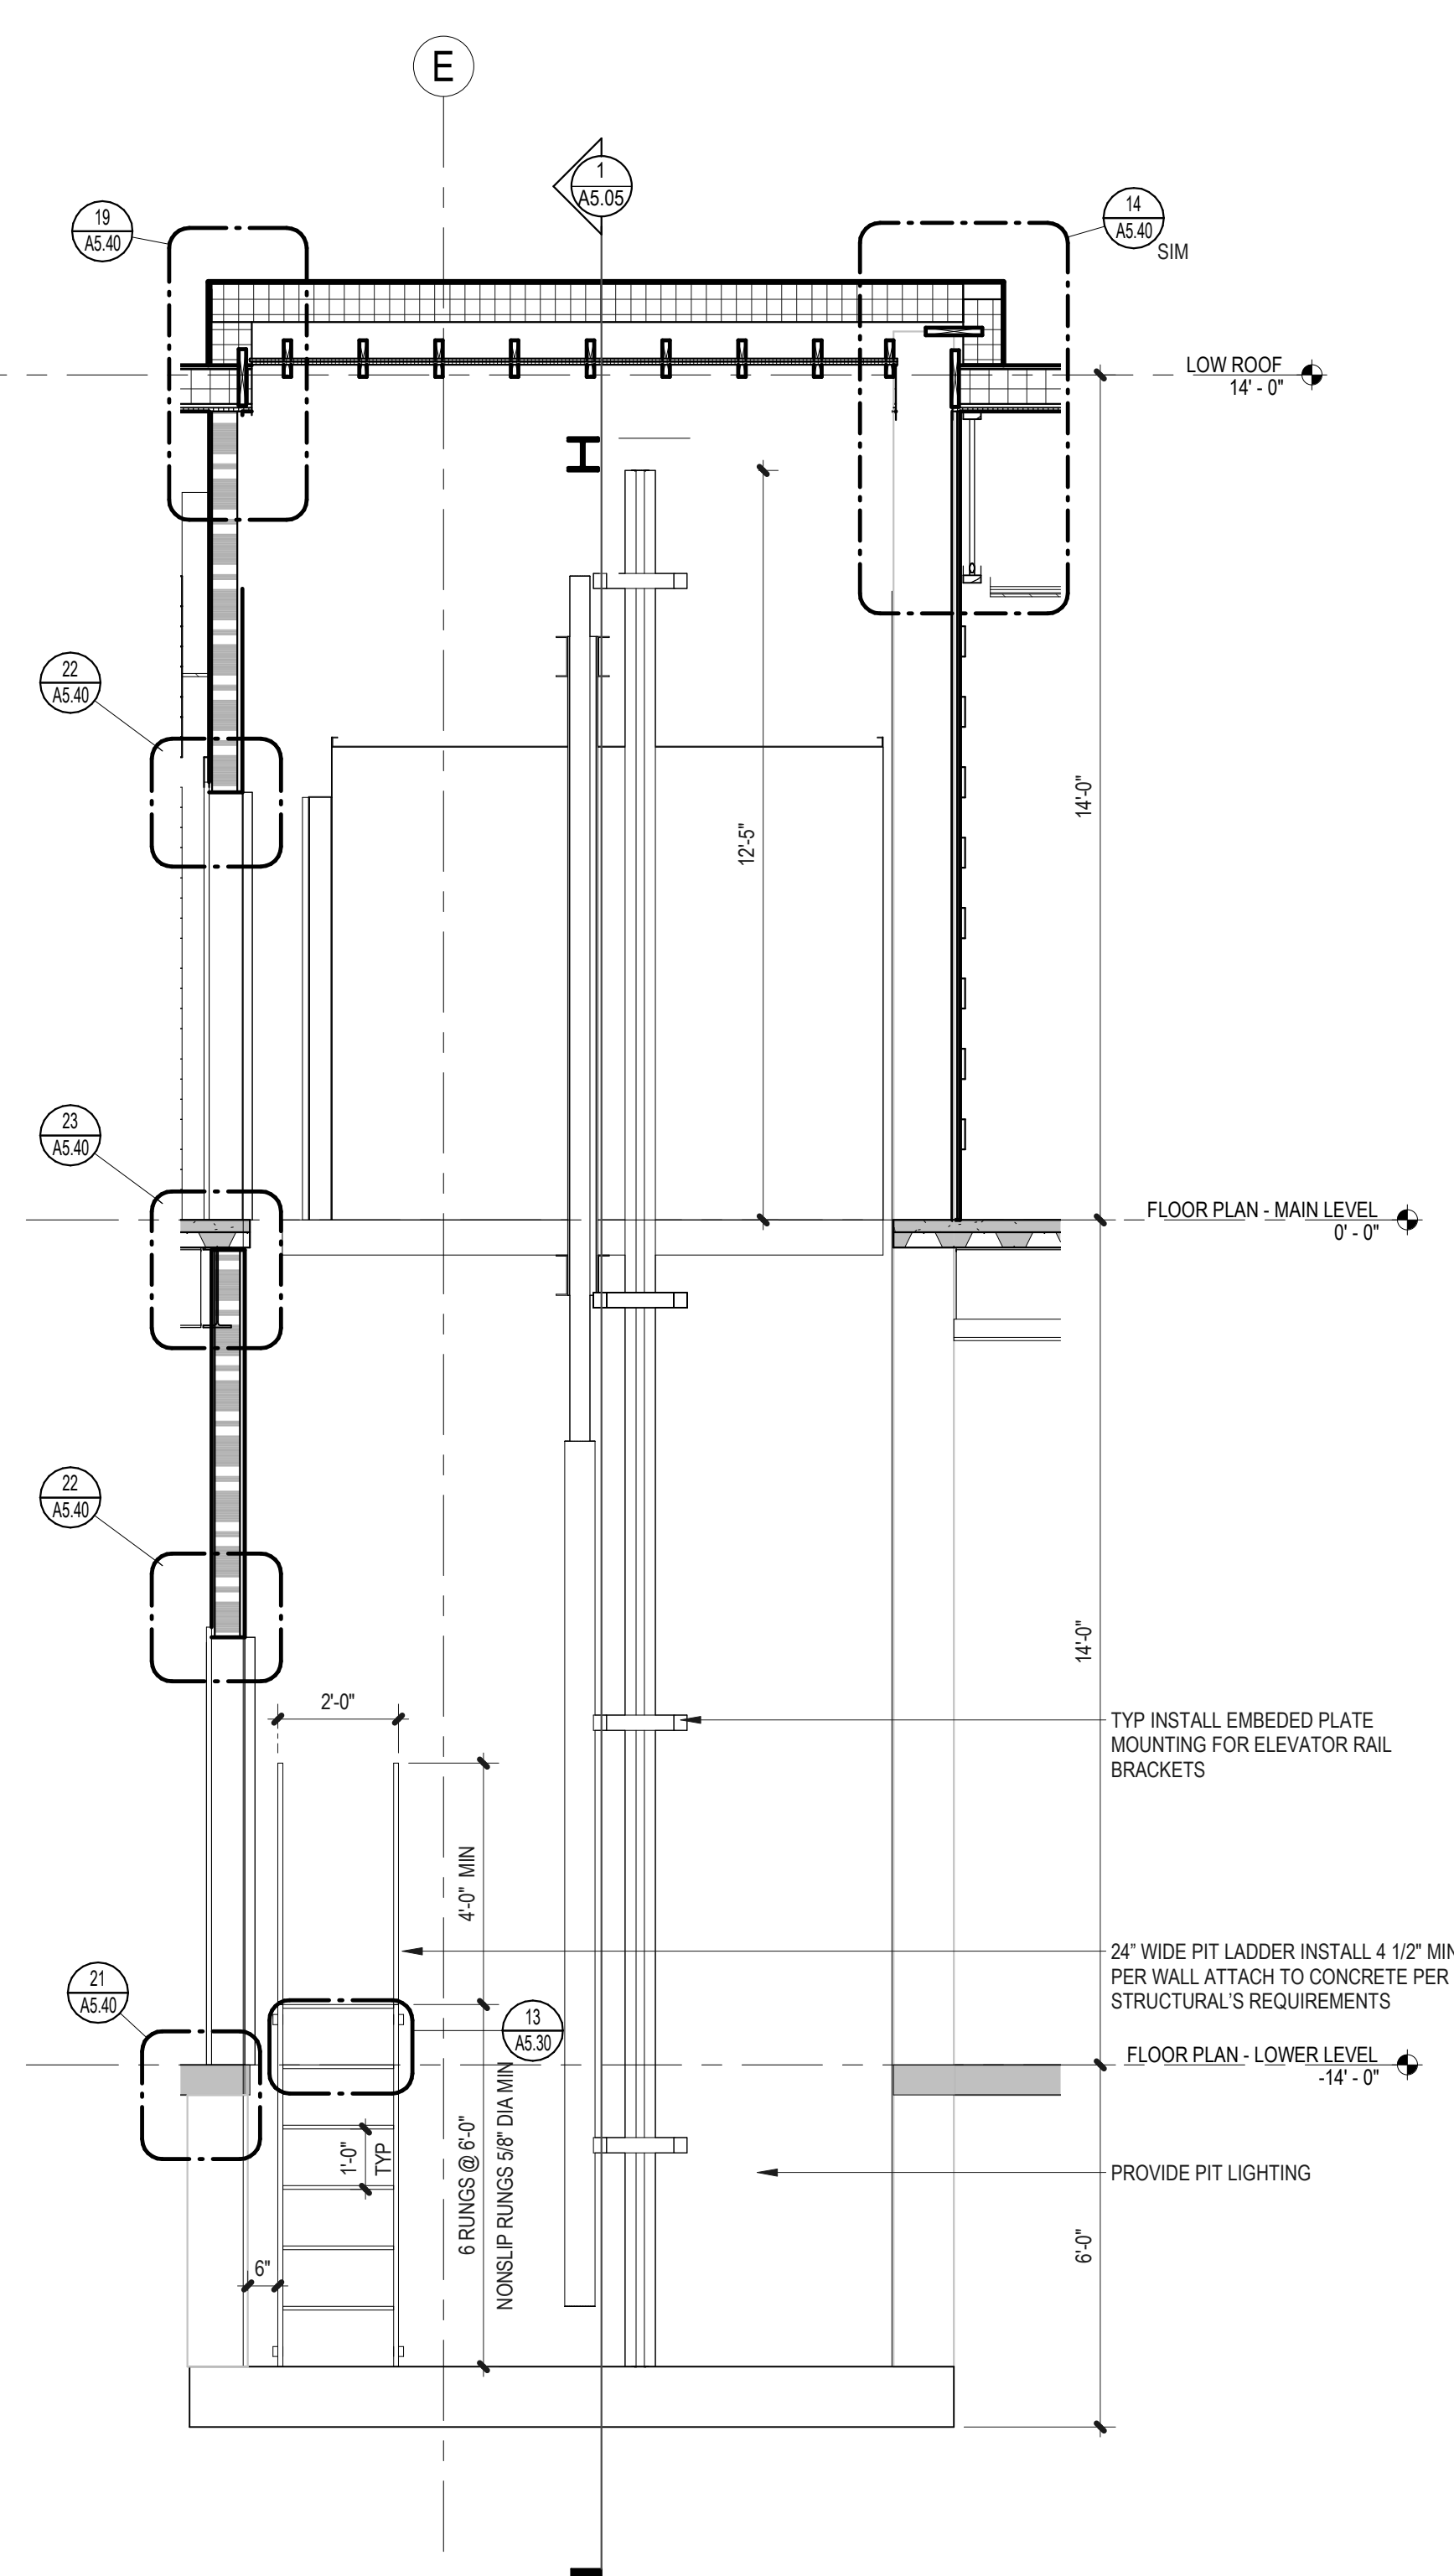

2 ELEVATOR SECTION
3/8" = 1'-0"

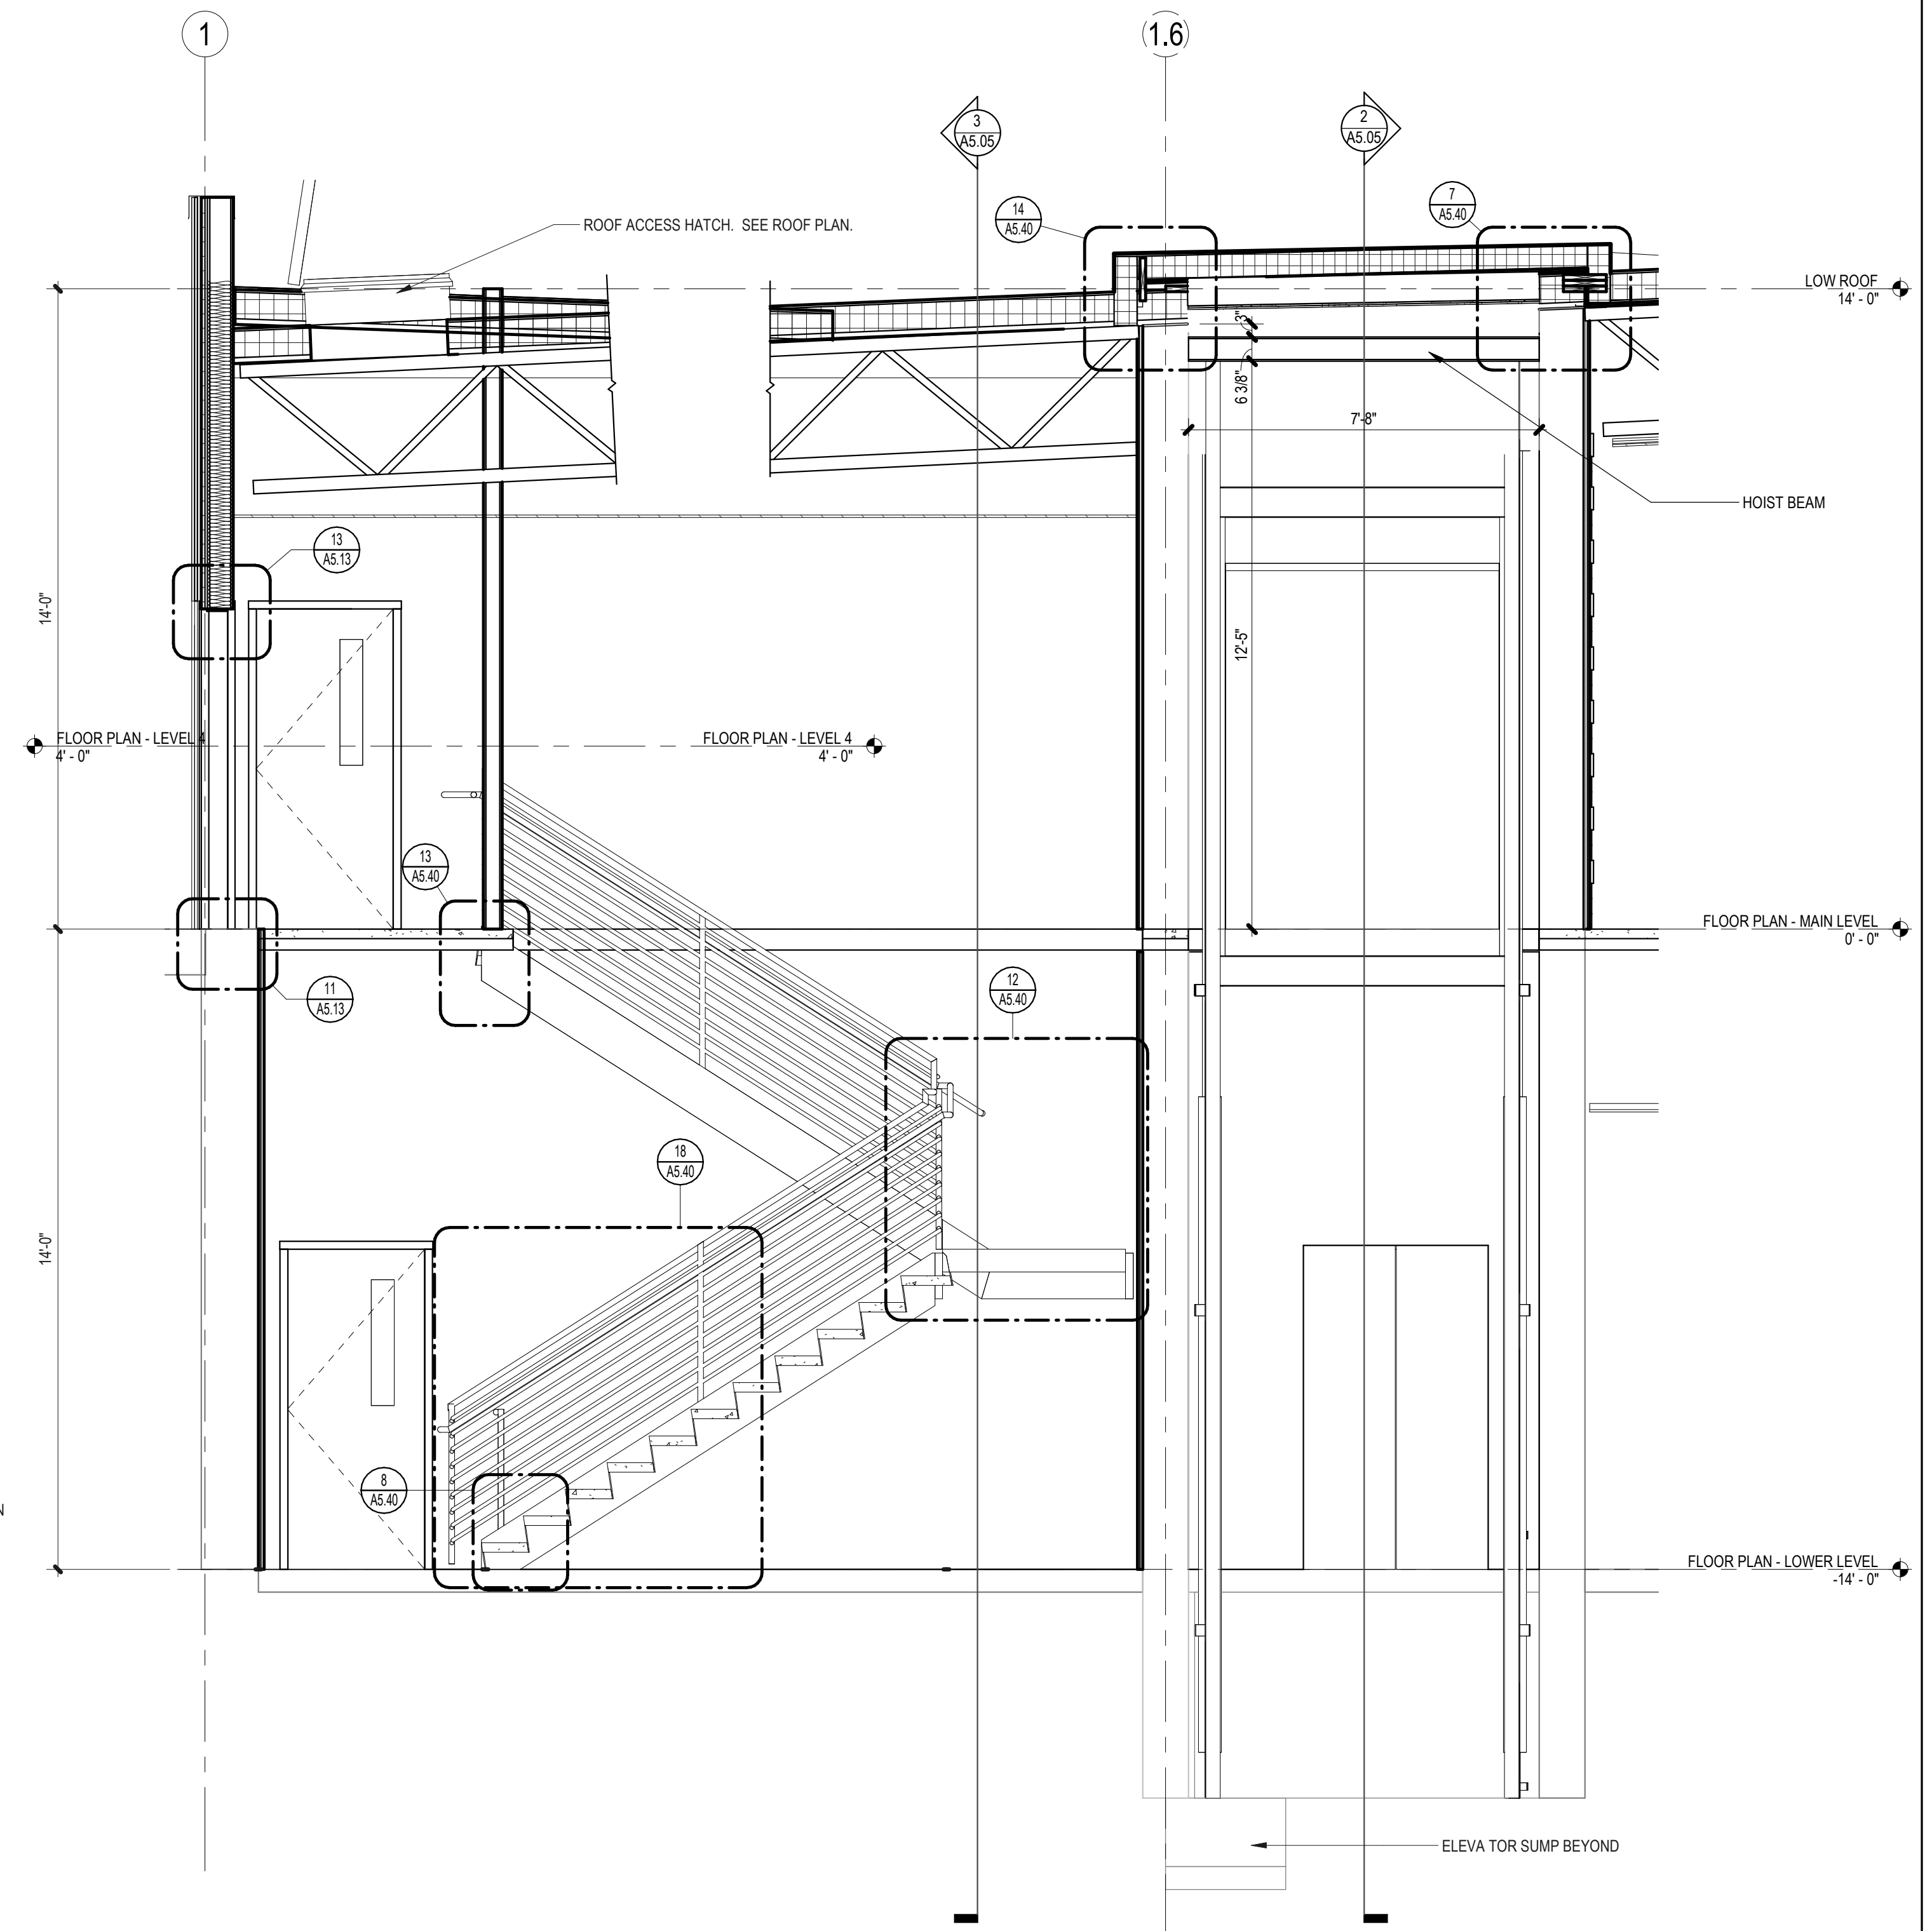

1 STAIR AND ELEVATOR SECTION
3/8" = 1'-0"

TULALIP TRIBES GATHERING HALL

7512 TOTEM BEACH RD
TULALIP, WA 98271

PHASE 2 - BUILDING AND LANDSCAPING


EXTERIOR STAIR PLANS AND SECTIONS


[illegible]

PROJECT INFORMATION	
PROJECT NUMBER:	17031
PROJECT LEAD:	DC
DRAWN BY:	AB





SHEET NO

A5.06

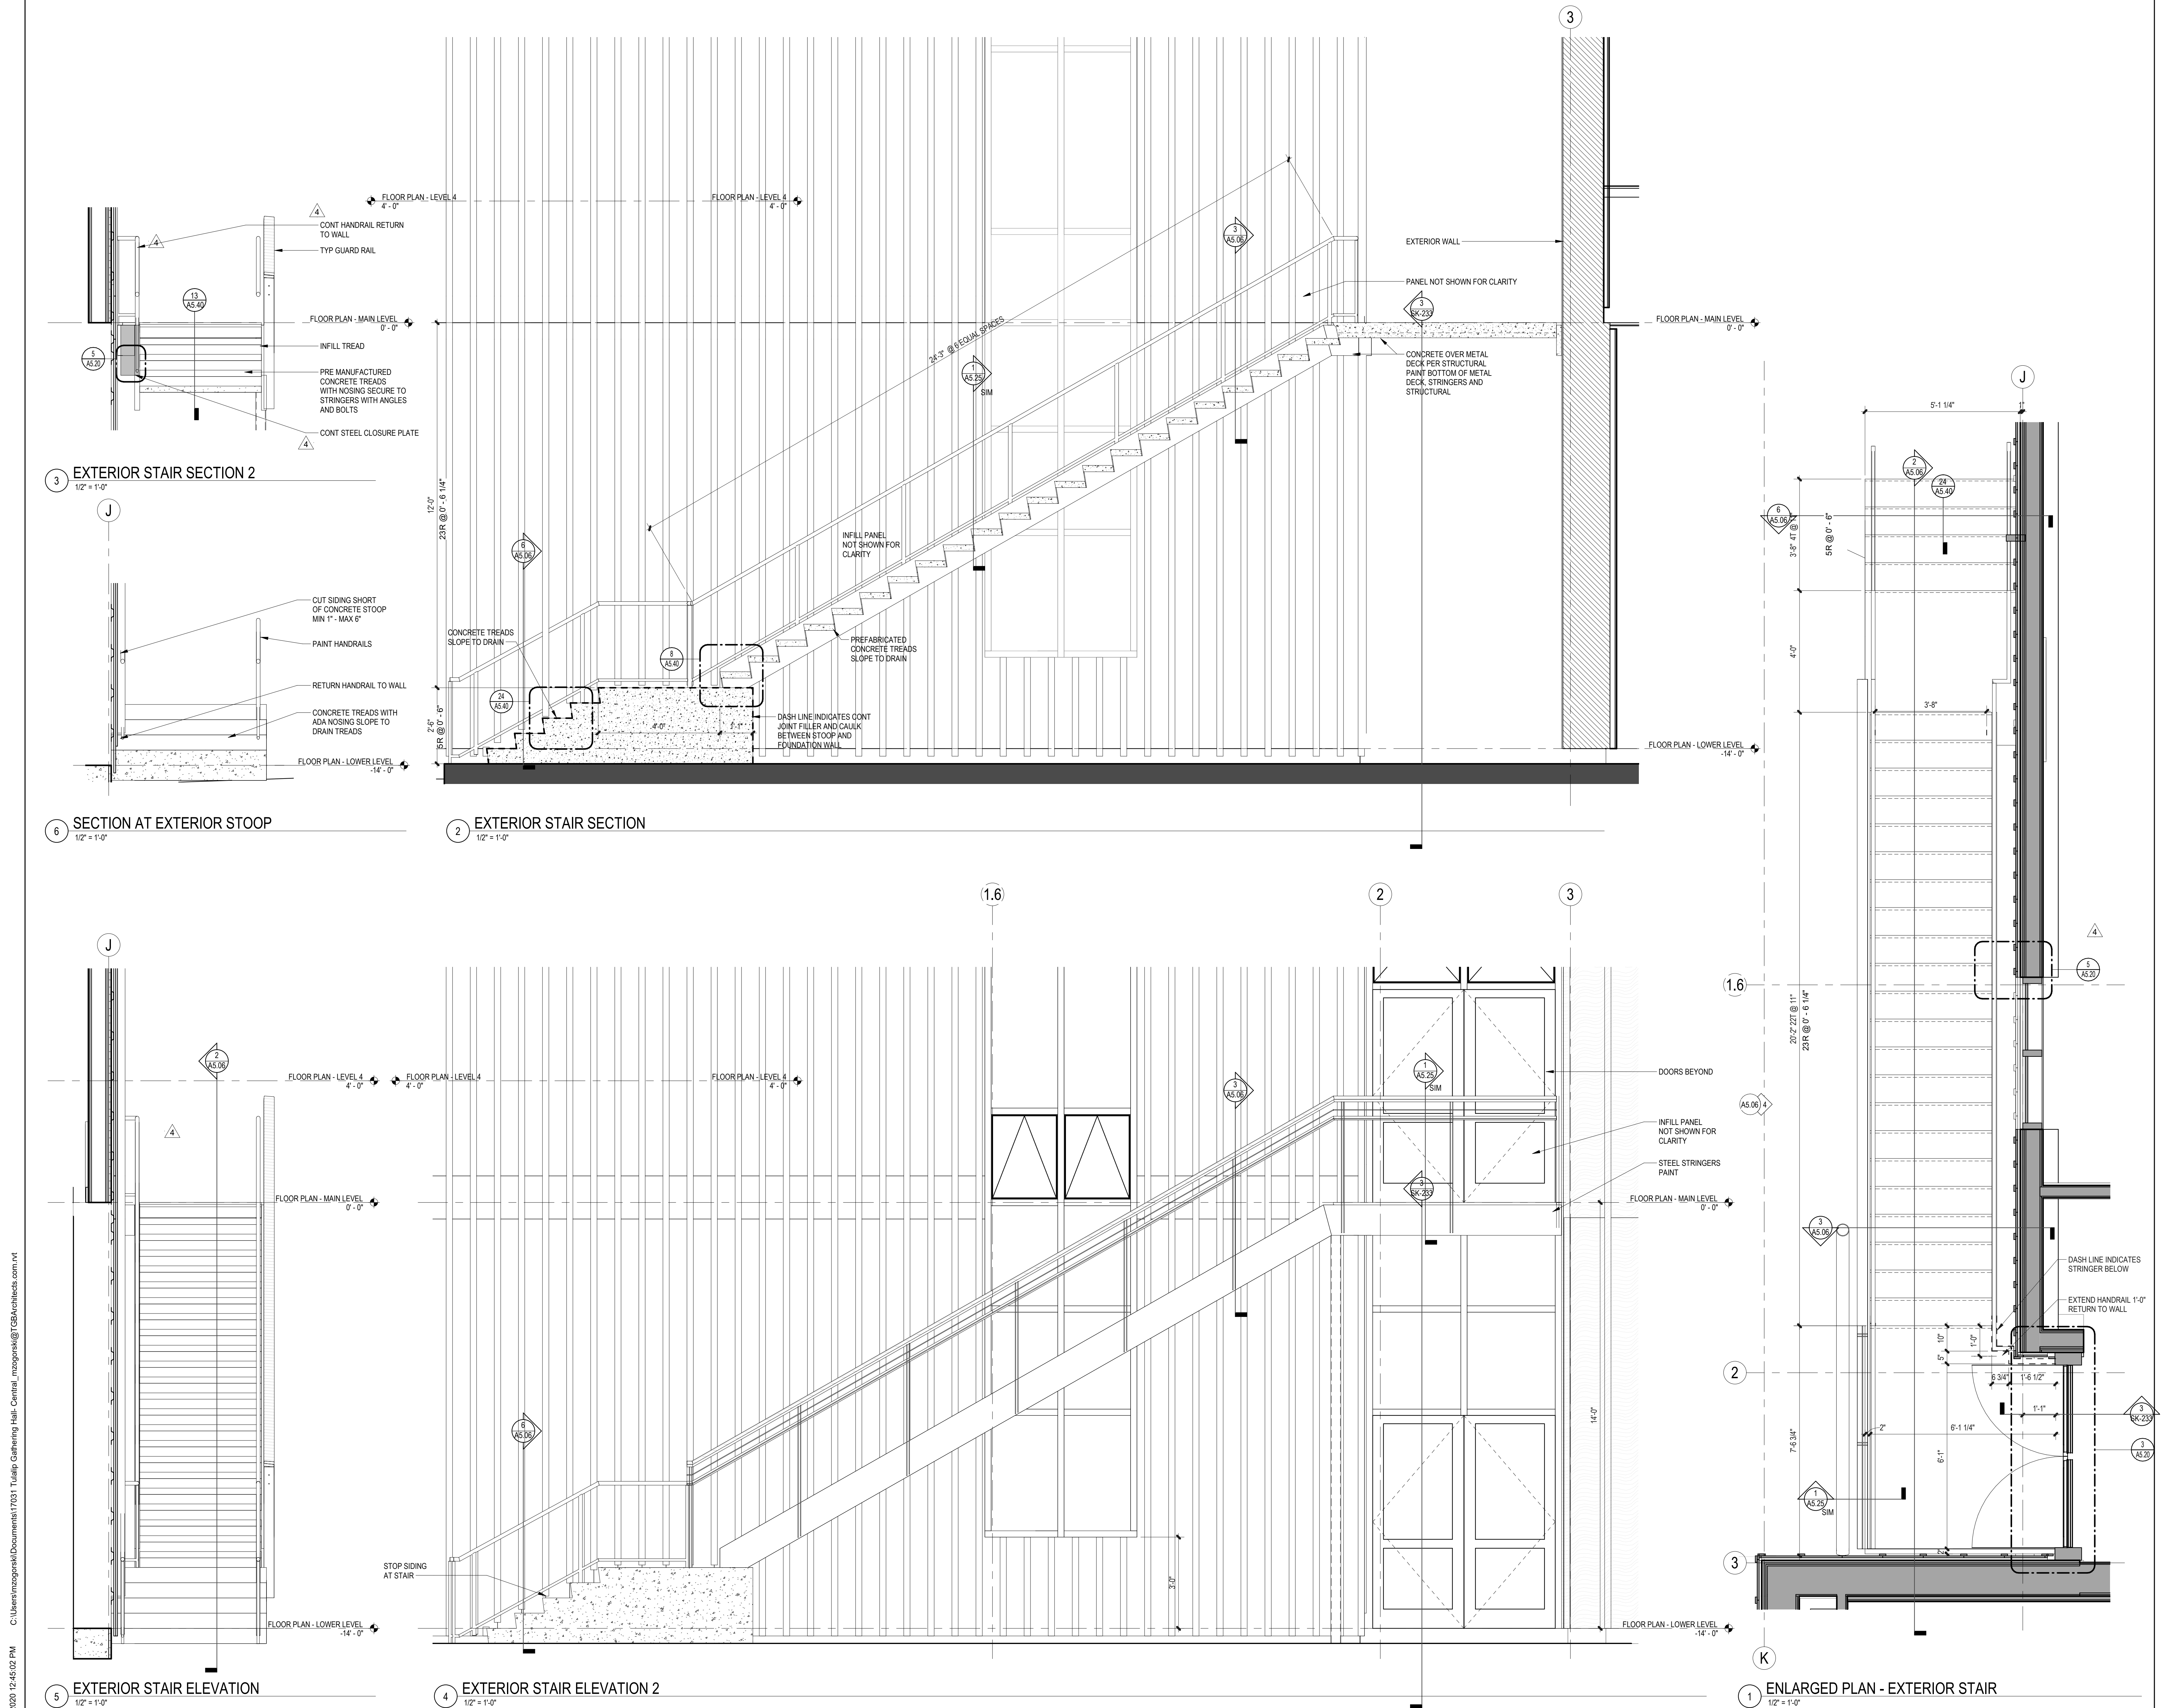

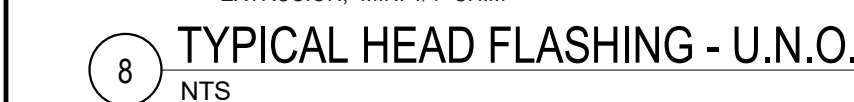

(E) POLY-ASH BOARD END CONDITION
1 1/2" = 1'-0"

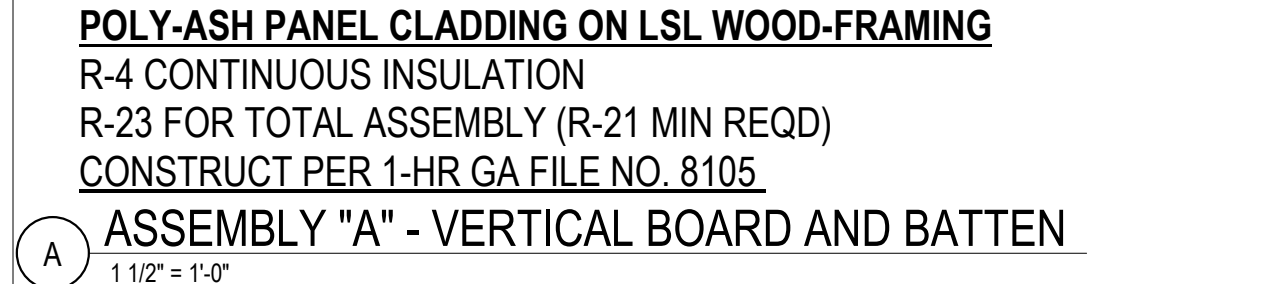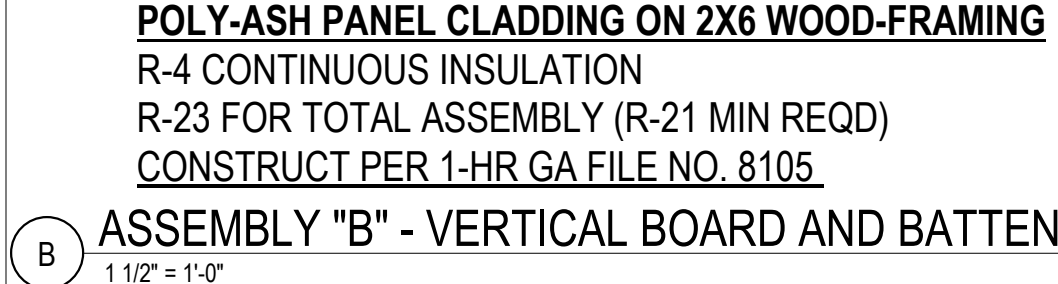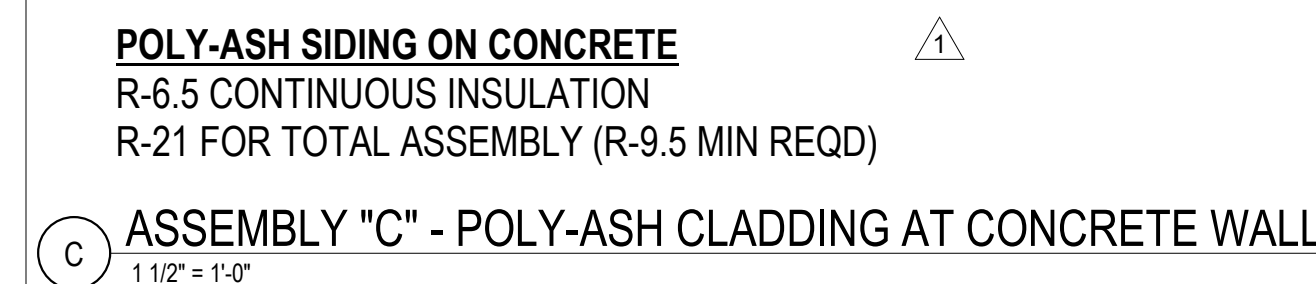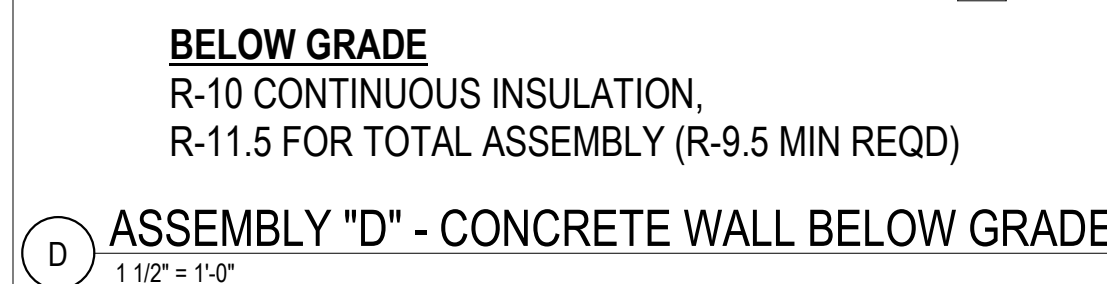

A5.11



16 EXT 3" = 1'-0"

13 TYPE
3" = 1'-0"

11 TYPE
3" = 1'-0"

1 SEC
3" = 1'-0"

Technical drawing K shows a cross-section of a curtain wall mullion and a swinging door. The drawing includes the following labels and components:

- K**: A circled letter 'K' at the top center, identifying the detail.
- CURTAIN WALL SWINGING DOOR**: A label with a line pointing to the upper part of the door frame assembly.
- CURTAIN WALL MULLION**: A label with a line pointing to the vertical mullion component.

The drawing illustrates the structural connection between the door frame and the mullion, showing various seals, gaskets, and structural elements.

SHIM

CURTAIN WALL SYSTEM

SEALANT AND BACKER ROD

PREFINISHED BRAKE METAL FLASHING

BATTEN IF OCCURS

FRAMING PER STRUCTURAL

SEALANT TO MATCH WINDOW SYSTEM

WOOD SIDING PER FINISH PLAN

GYPSUM WALL BOARD

2X3 WOOD FRAMING

AS TO

K

Diagram illustrating the cross-section of a window installation, showing the integration of various materials and components for structural integrity and weatherproofing.

Labels and components shown in the diagram:

- VAPOR BARRIER
- STRUCTURAL STEEL; REFER TO STRUCTURAL DRAWINGS
- AIR/WATER BARRIER
- 1" RIGID INSULATION
- POLY-ASH BOARD AND TRIM
- STEEL TUBE PER STRUCTURAL, PAINT WITH INTUMESCENT PAINT
- BATTEN, IF OCCURS
- SEALANT AND BACKER ROD
- BRAKE METAL TO MATCH WINDOW SYSTEM
- OVERLAP SELF-ADHERED MEMBRANE ON JAMB FLASHING
- FRICTION FIT BRAKE METAL INTO CLIP; CLOSE ANY GAP WITH SEALANT TO MATCH
- BRAKE METAL JAMB FLASHING
- SEALANT AND BACKER ROD
- TERMINATE AIR/WATER BARRIER FLUSH WITH ROUGH OPENING; WRAP CORNER WITH FOIL-FACED SELF-ADHERED MEMBRANE
- SHIM
- SEALANT AND BACKER ROD
- WOOD SIDING PER FINISH PLAN
- 2X3 WOOD FRAMING
- GYPSUM WALL BOARD
- SEALANT TO MATCH WALL SYSTEM

EXTERIOR WALL

STRINGER

BELOW

HAND RAIL SUPPORT SEE STAIR SECTION FOR LOCATION

NOTCH PLATE FOR PIPE

RAILING BALLUSTER

STAIR TREAD

STAIR NOSING

BOLT AND WASHER

BUTT STEEL PLATE - PAINT

WINDOW FRAME

1 1/2

2' MIN

10 1/2

2'

2'

EXTERIOR GYPSUM BASED SHEATHING

AIR/WATER BARRIER

RIGID INSULATION

POLY-ASH BOARD AND TRIM

RAINSCREEN FRAMING

SELF-ADHERED MEMBRANE

BRAKE METAL FLASHING

SEALANT AND BACKER ROD

SWINGING CURTAIN WALL DOOR

3'0"

2

COILING DOOR

3 3/8"

7" HIGH STAINLESS STEEL CORNERGUARD, OCCURS AT BOTH INSIDE CORNERS OF OVERHEAD COILING DOOR FRAMING

2 3/4"

1'-0"

2"

WRAP WEATHER BARRIER AROUND JAMB

CAULK

POLYASH CLADDING ASSEMBLY AT EXTERIOR WALL

CORNER GUARD

(EXISTING) CONCRETE

5/8" GYP BOARD OVER 7/8" FURRING CHANNEL

2X BLOCKING

BACKER AND SEALANT

ALUMINUM CURTAIN WALL JAMB

THERMALLY BROKEN ASSEMBLY

PROVIDE ENFORCEMENT AS REQUIRED

5'-0"


SIMILAR CONDITION AT OPPOSITE JAMB

BUTT HINGED THERMAL DOOR PER CURTAIN MANUFACTURER STANDARD


1" THERMAL SAFETY GLAZING

CL


NOTE: TERMINATE ALL WRB / AIR BARRIER SIMILARLY AT ALL WINDOW / DOOR ROUGH OPENINGS TO MAINTAIN CONSISTENCY OF INSTALLATION METHODS IN THE FIELD. TERMINATE AIR BARRIER / WRB WITH SEALANT BEAD AND BACKER ROD INSTALLED AT MINIMUM IN PLANE WITH INNERMOST EDGE OF INSTALLED WINDOW / DOOR COMPONENT.

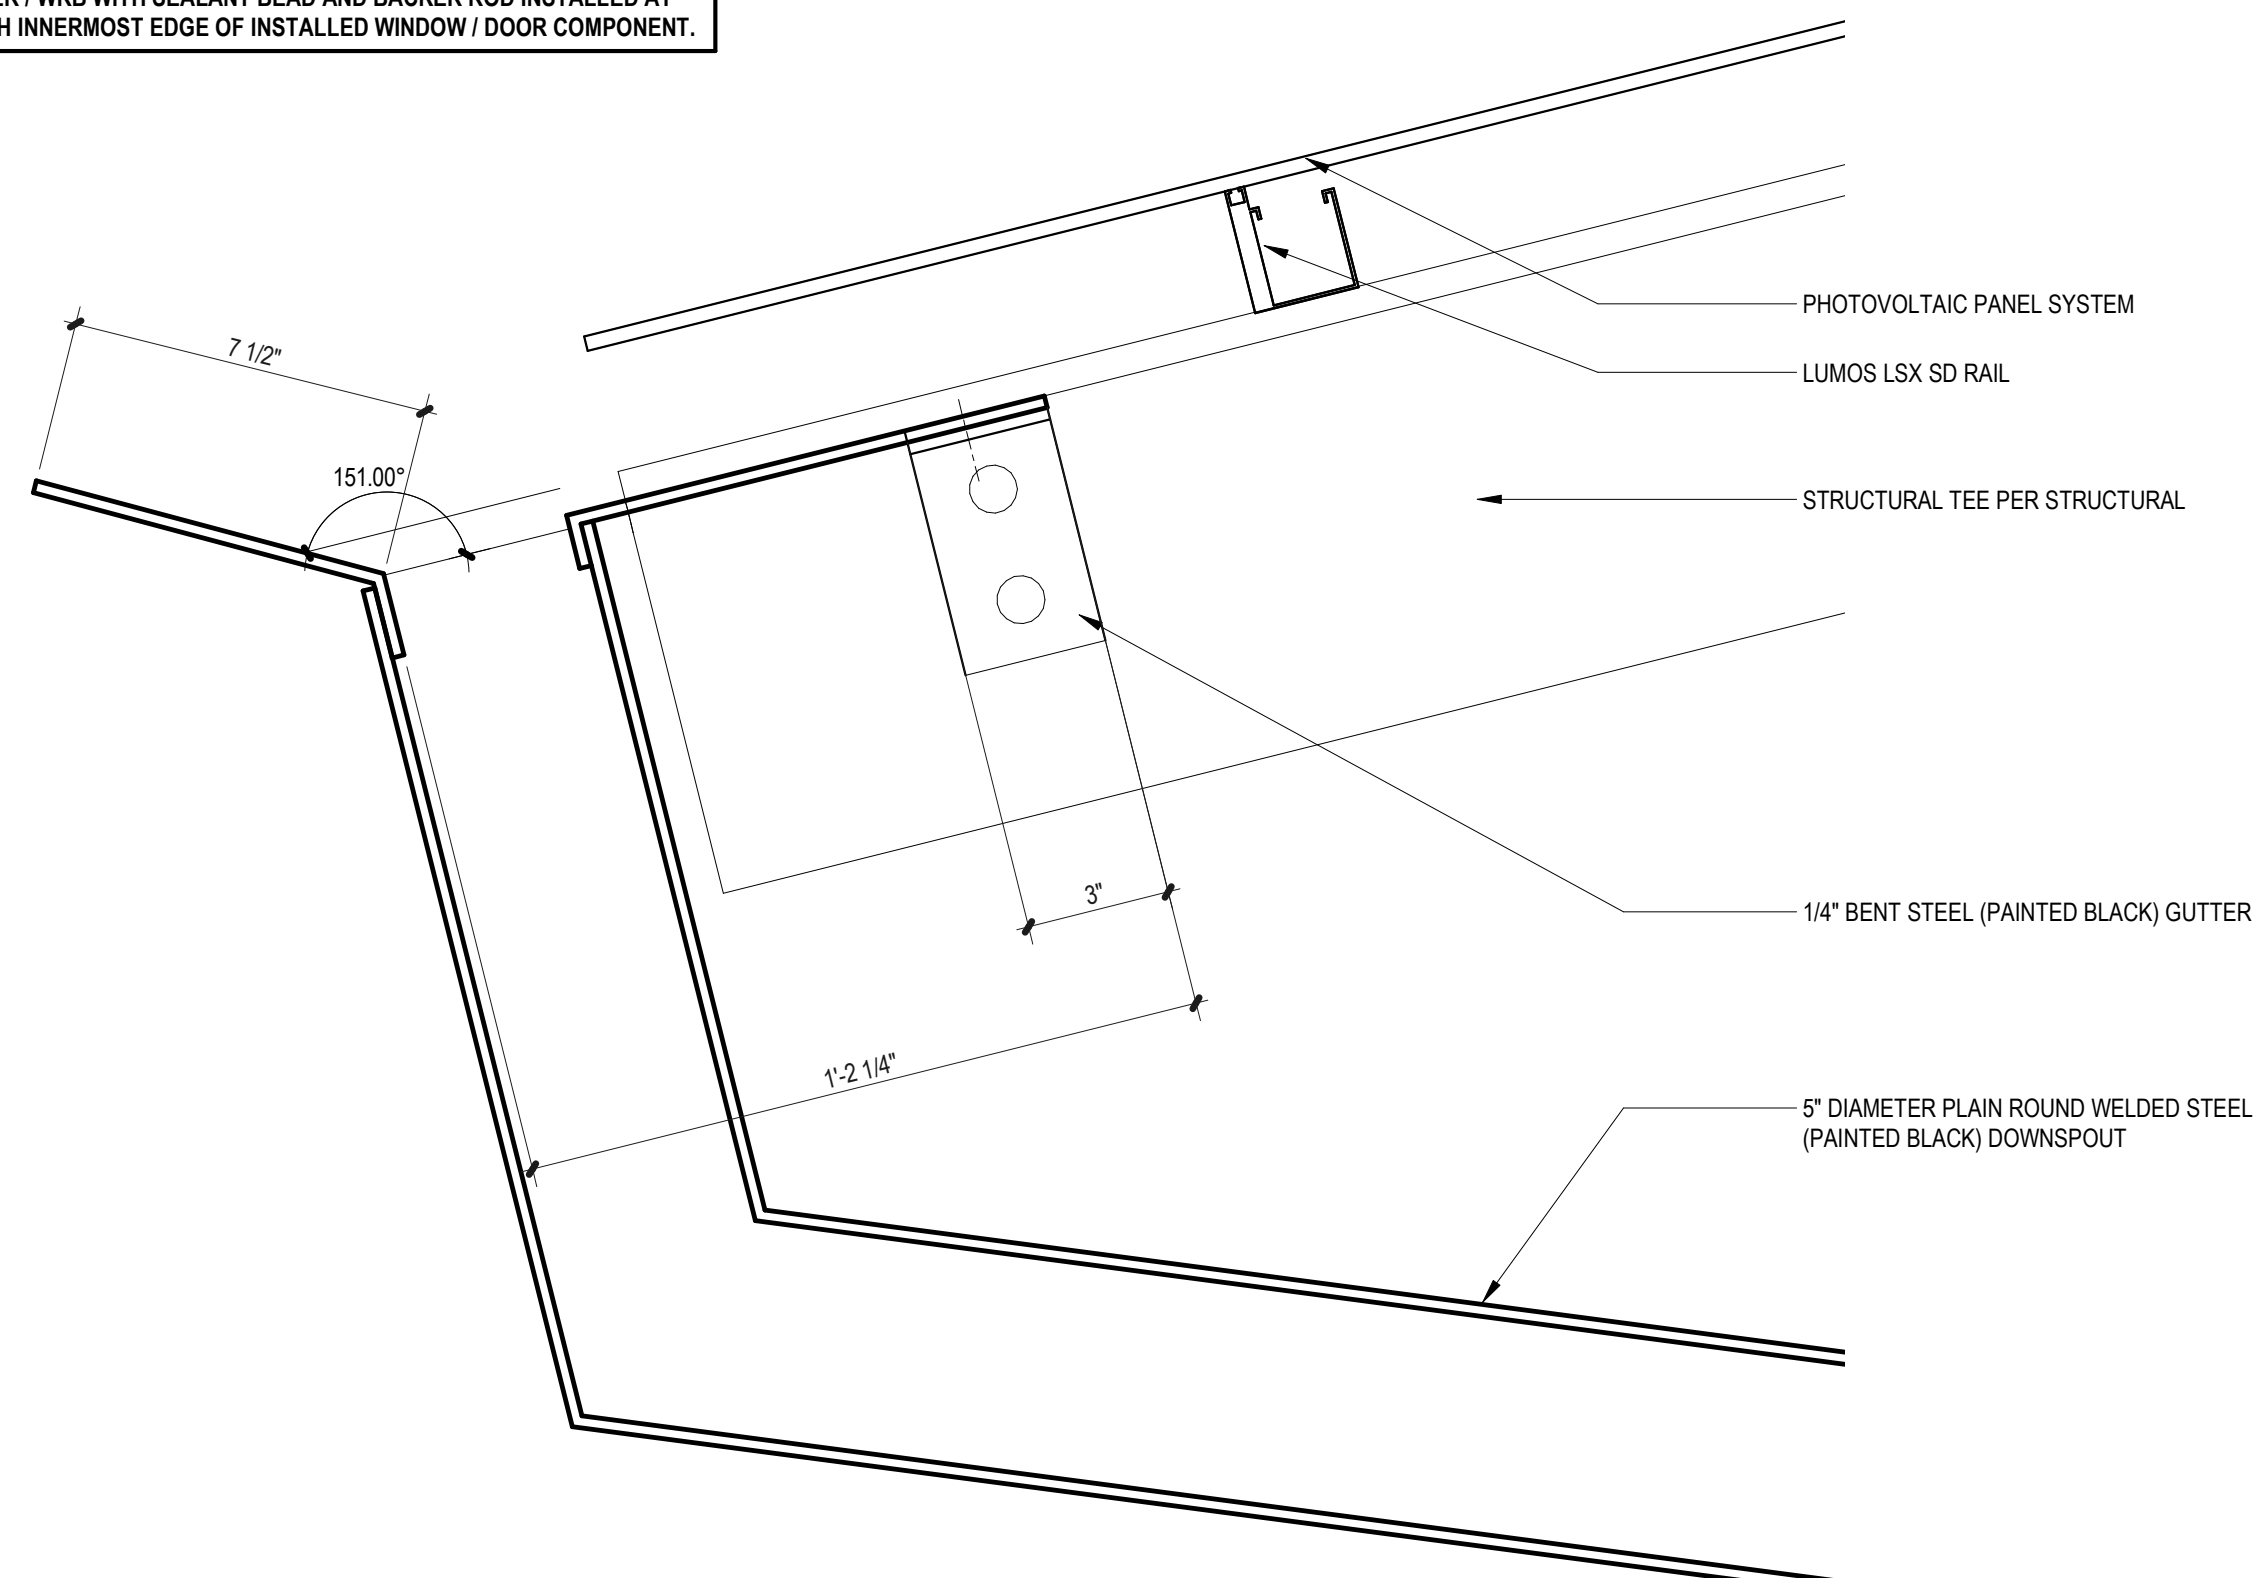


24 SOUTH CANOPY GUTTER
3" = 1'-0"

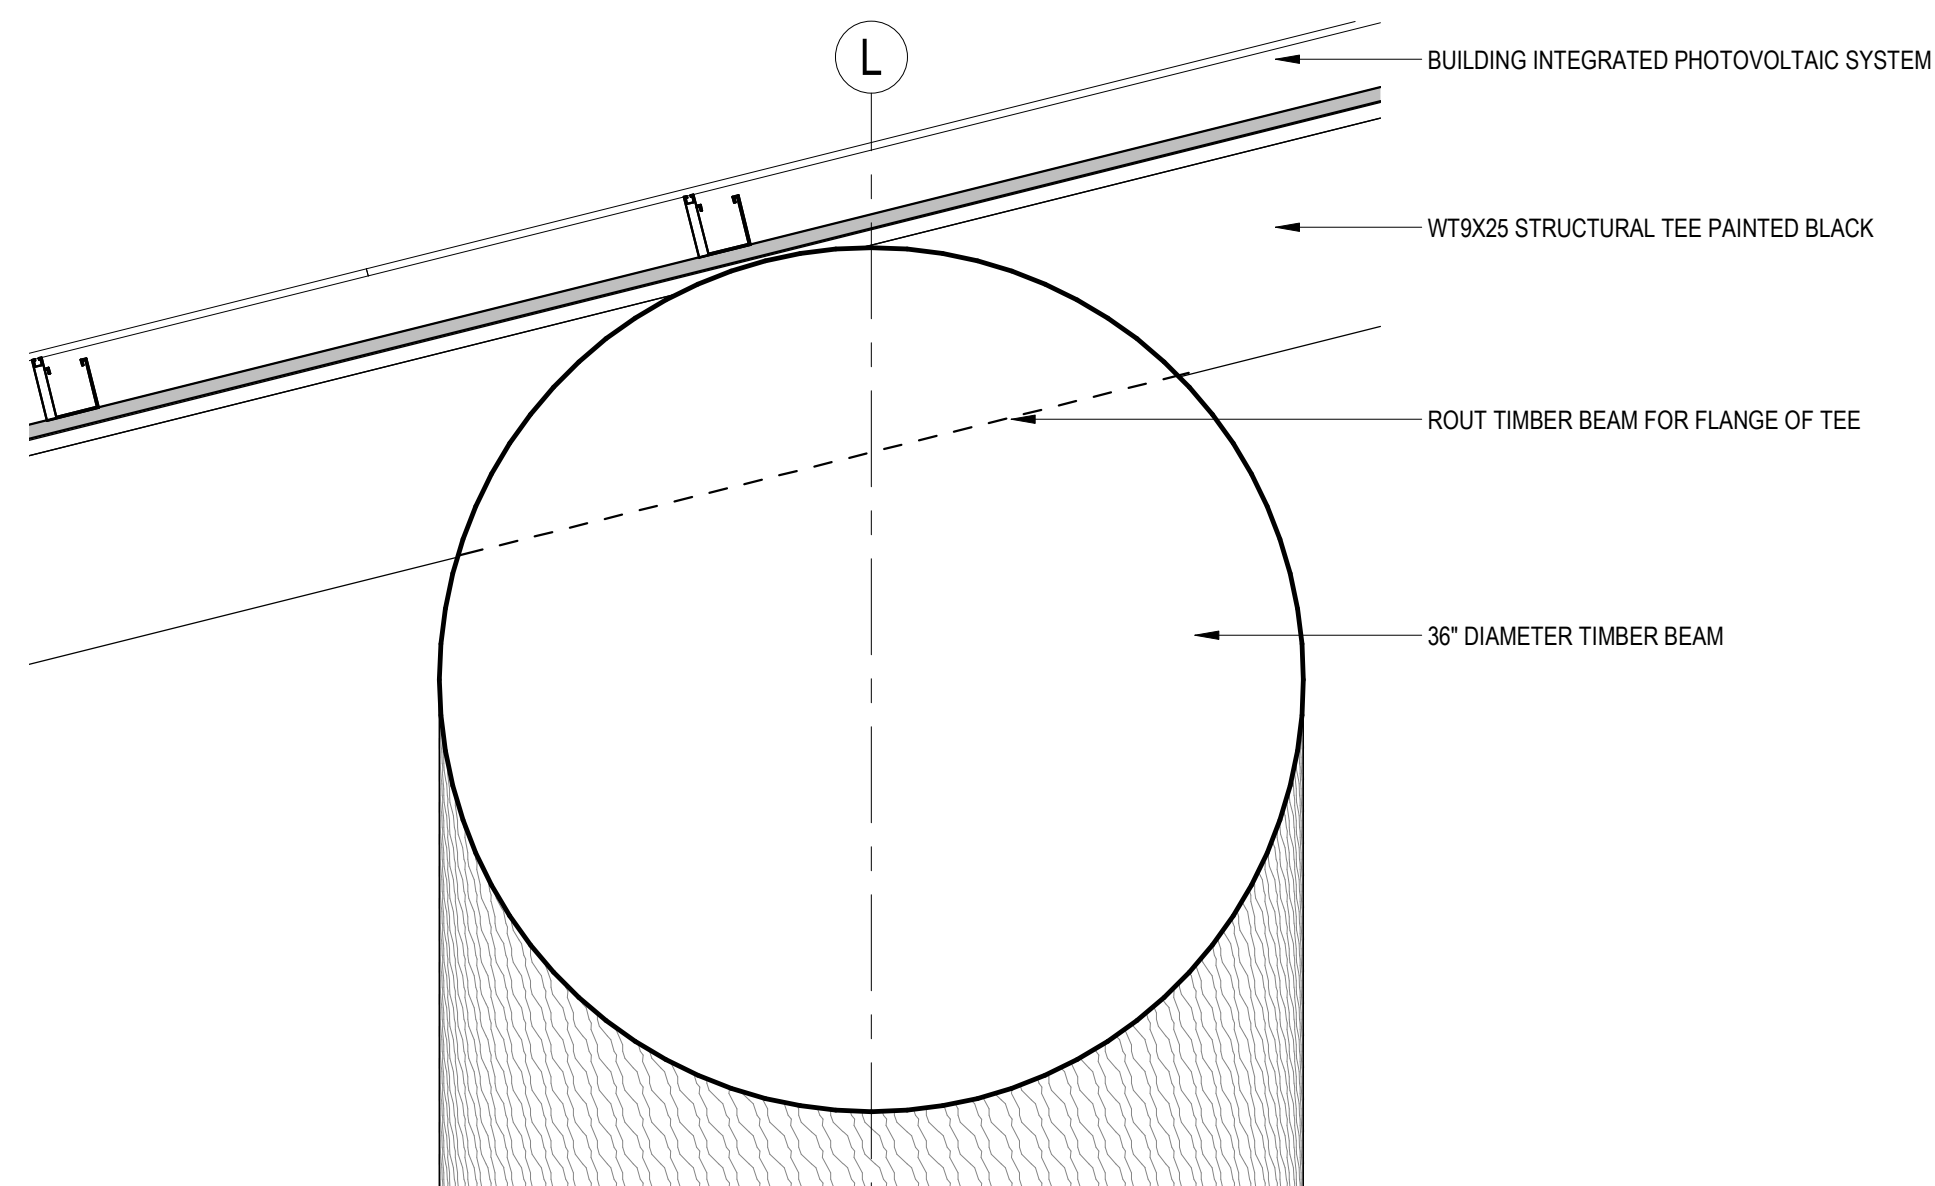


14 SOUTH CANOPY TO BEAM CONNECTION
1 1/2" = 1'-0"

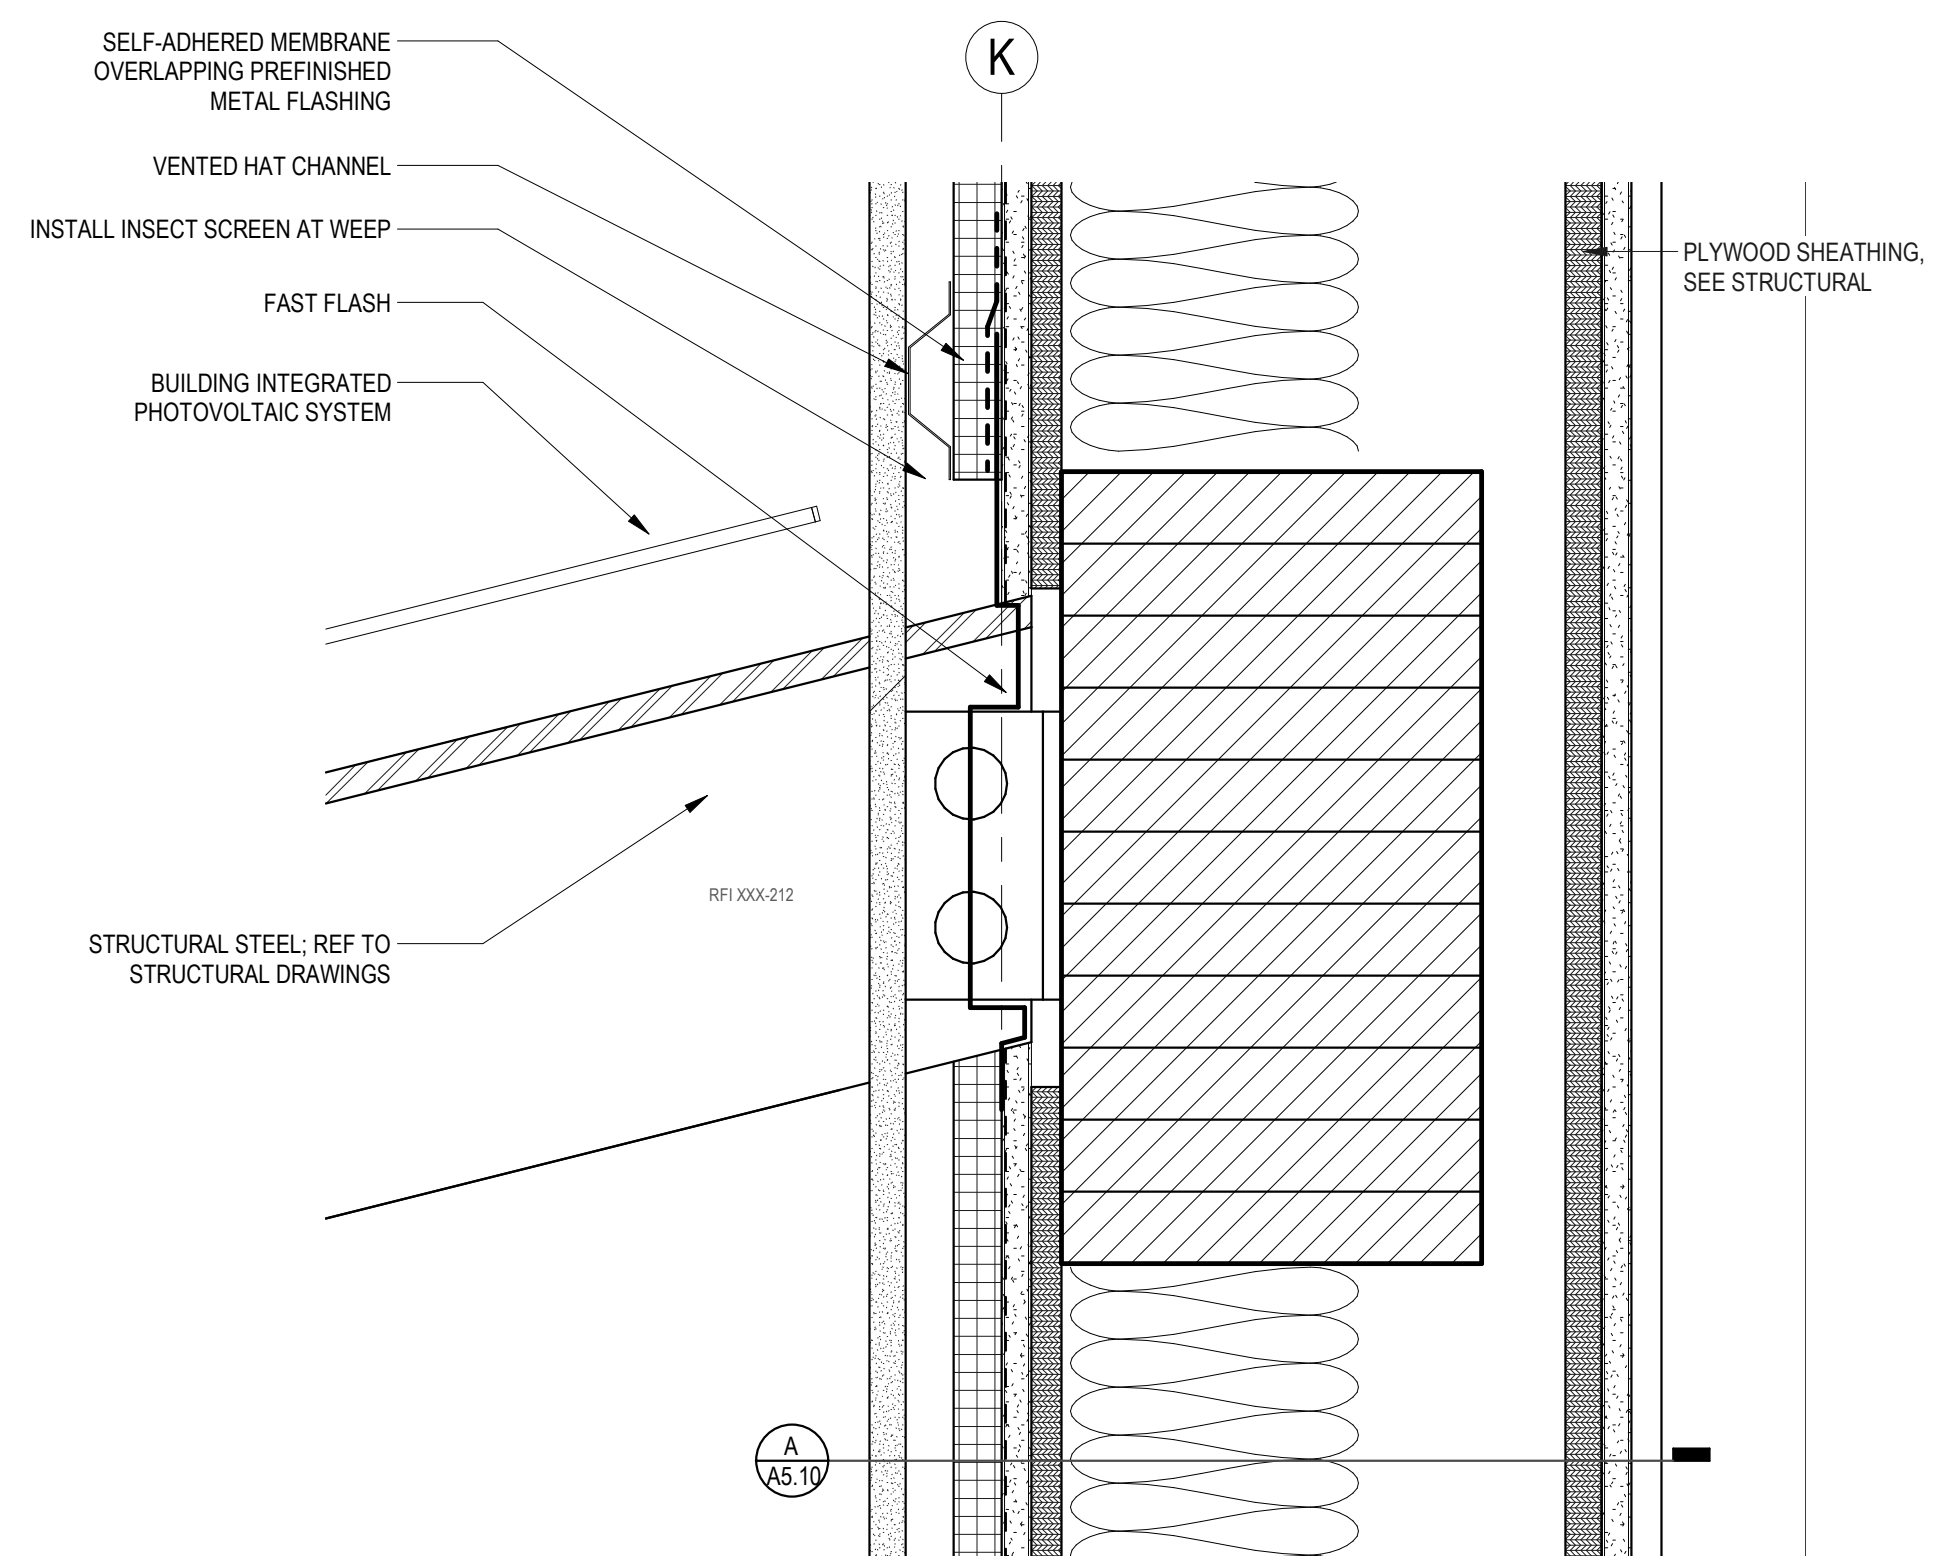


4 SOUTH CANOPY TO BUILDING CONNECTION

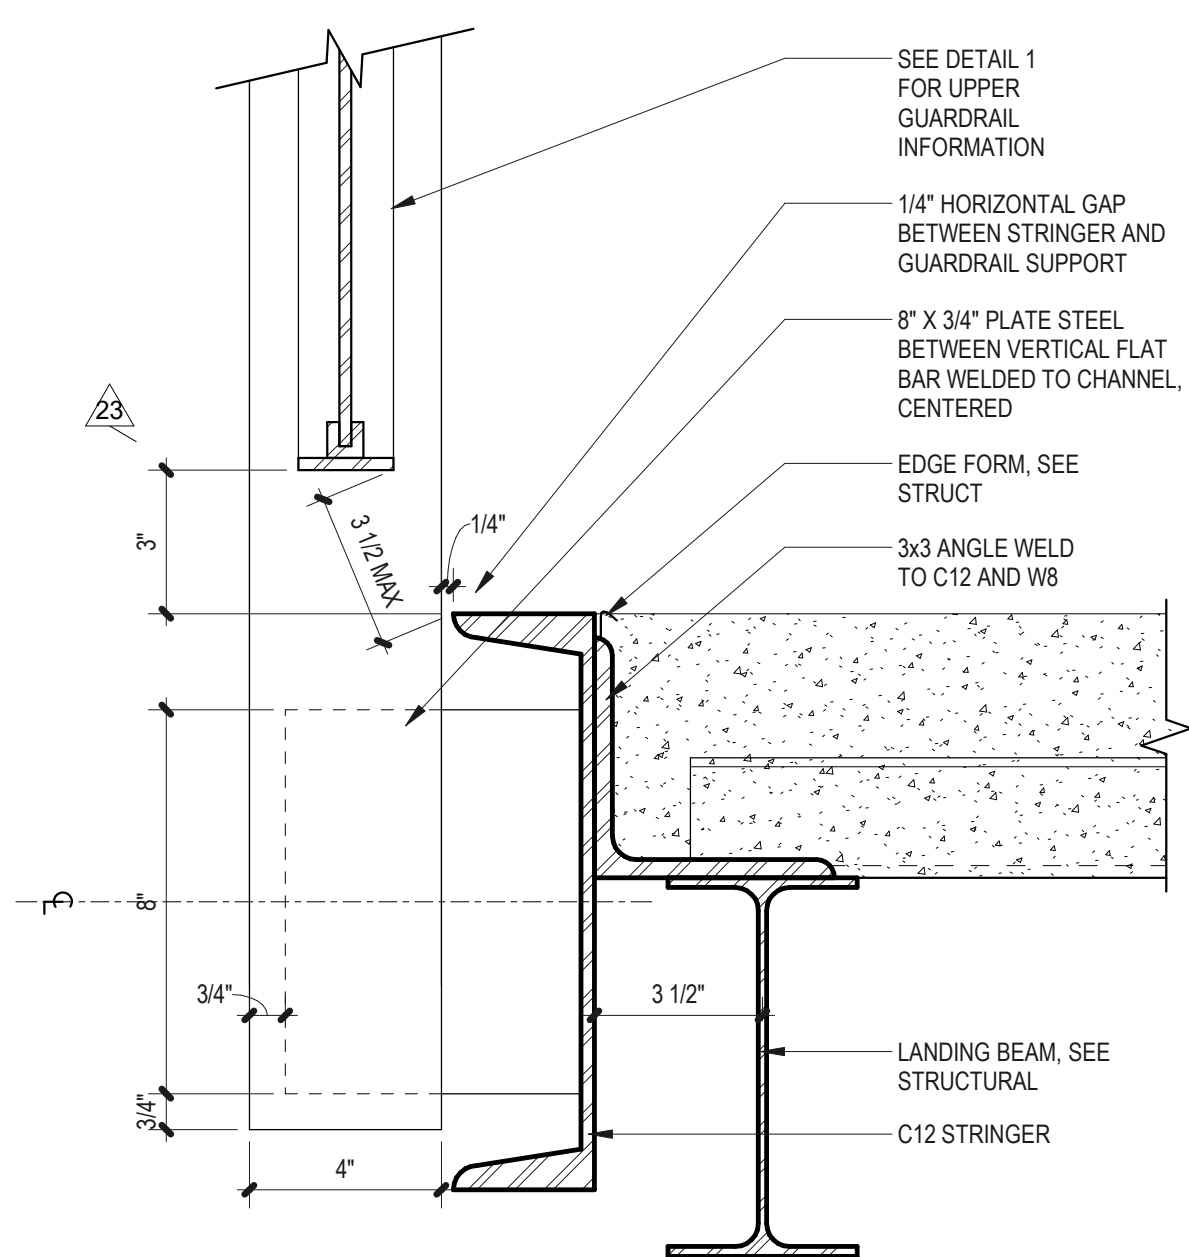


20 GUARDRAIL CONNECTION AT STAIR LANDING (STRINGER SIM)
3" = 1'-0"

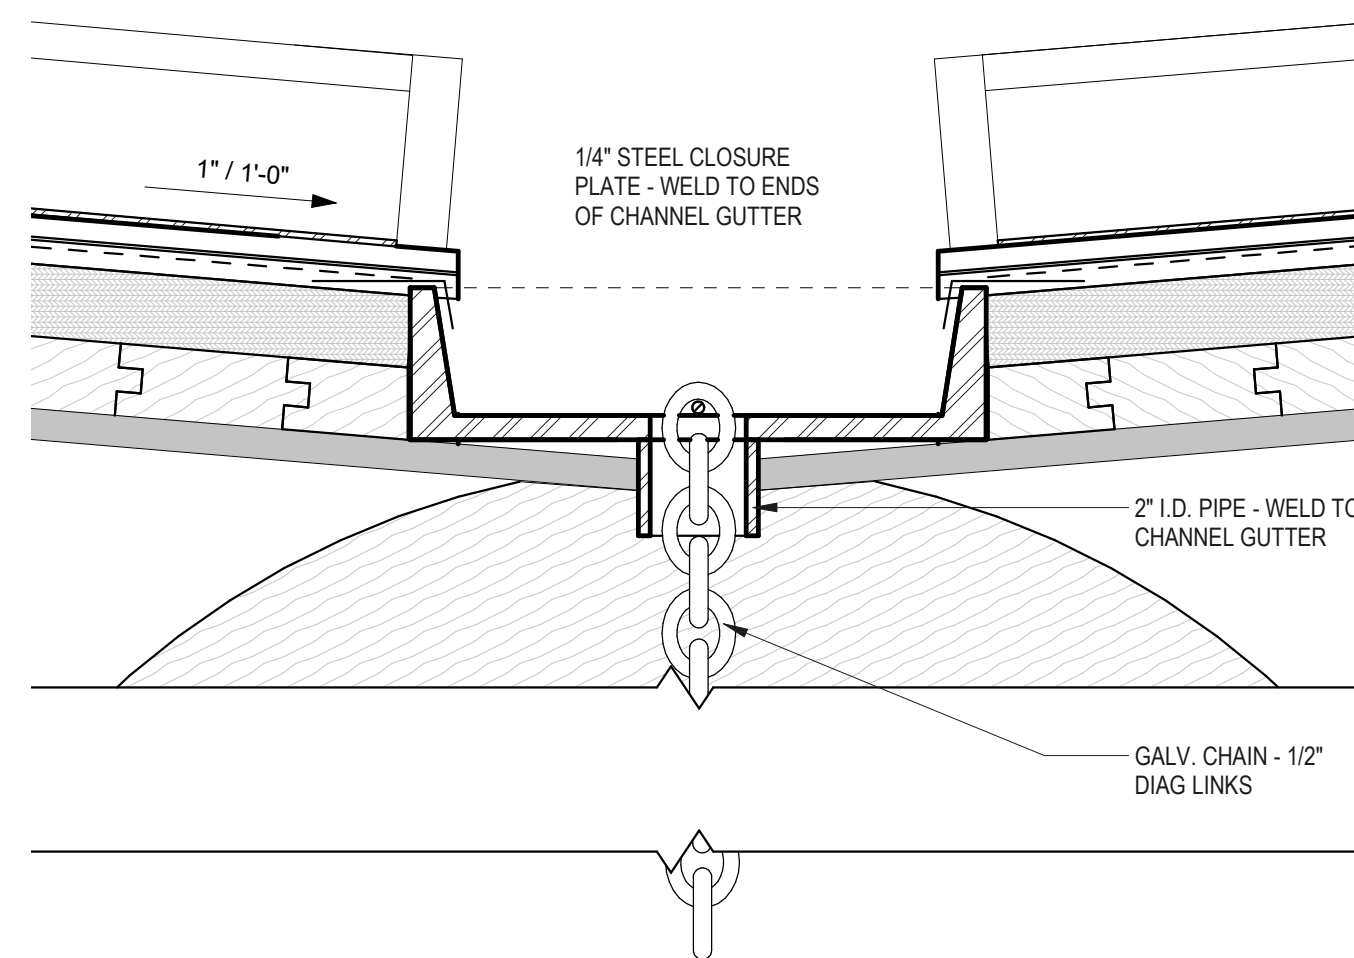


22 RAIN CHAINS @ ENTRY CANOPY
3" = 1'-0"

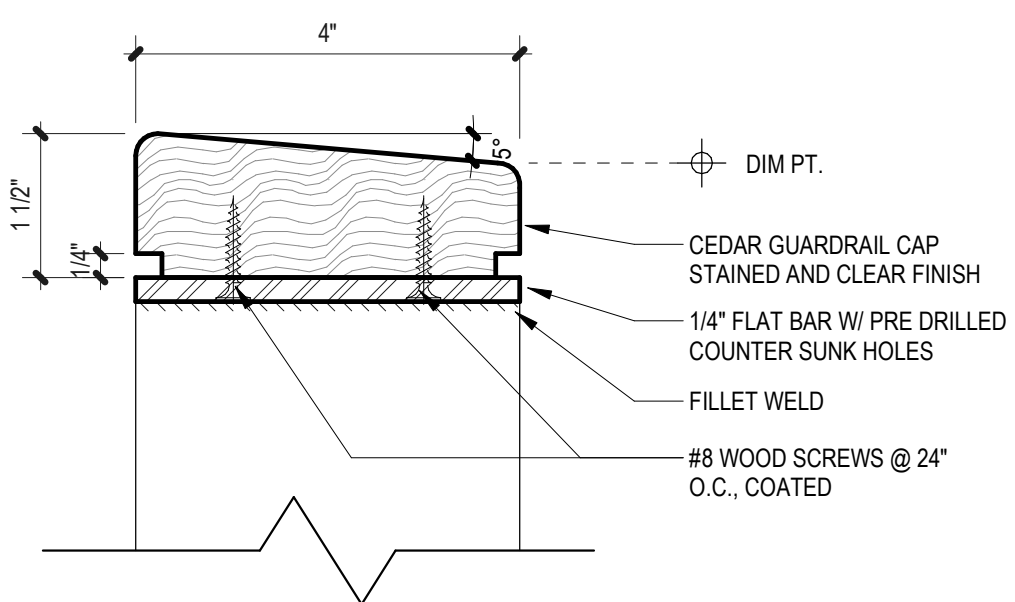


12 BALCONY HANDRAIL DETAIL
6" = 1'-0"

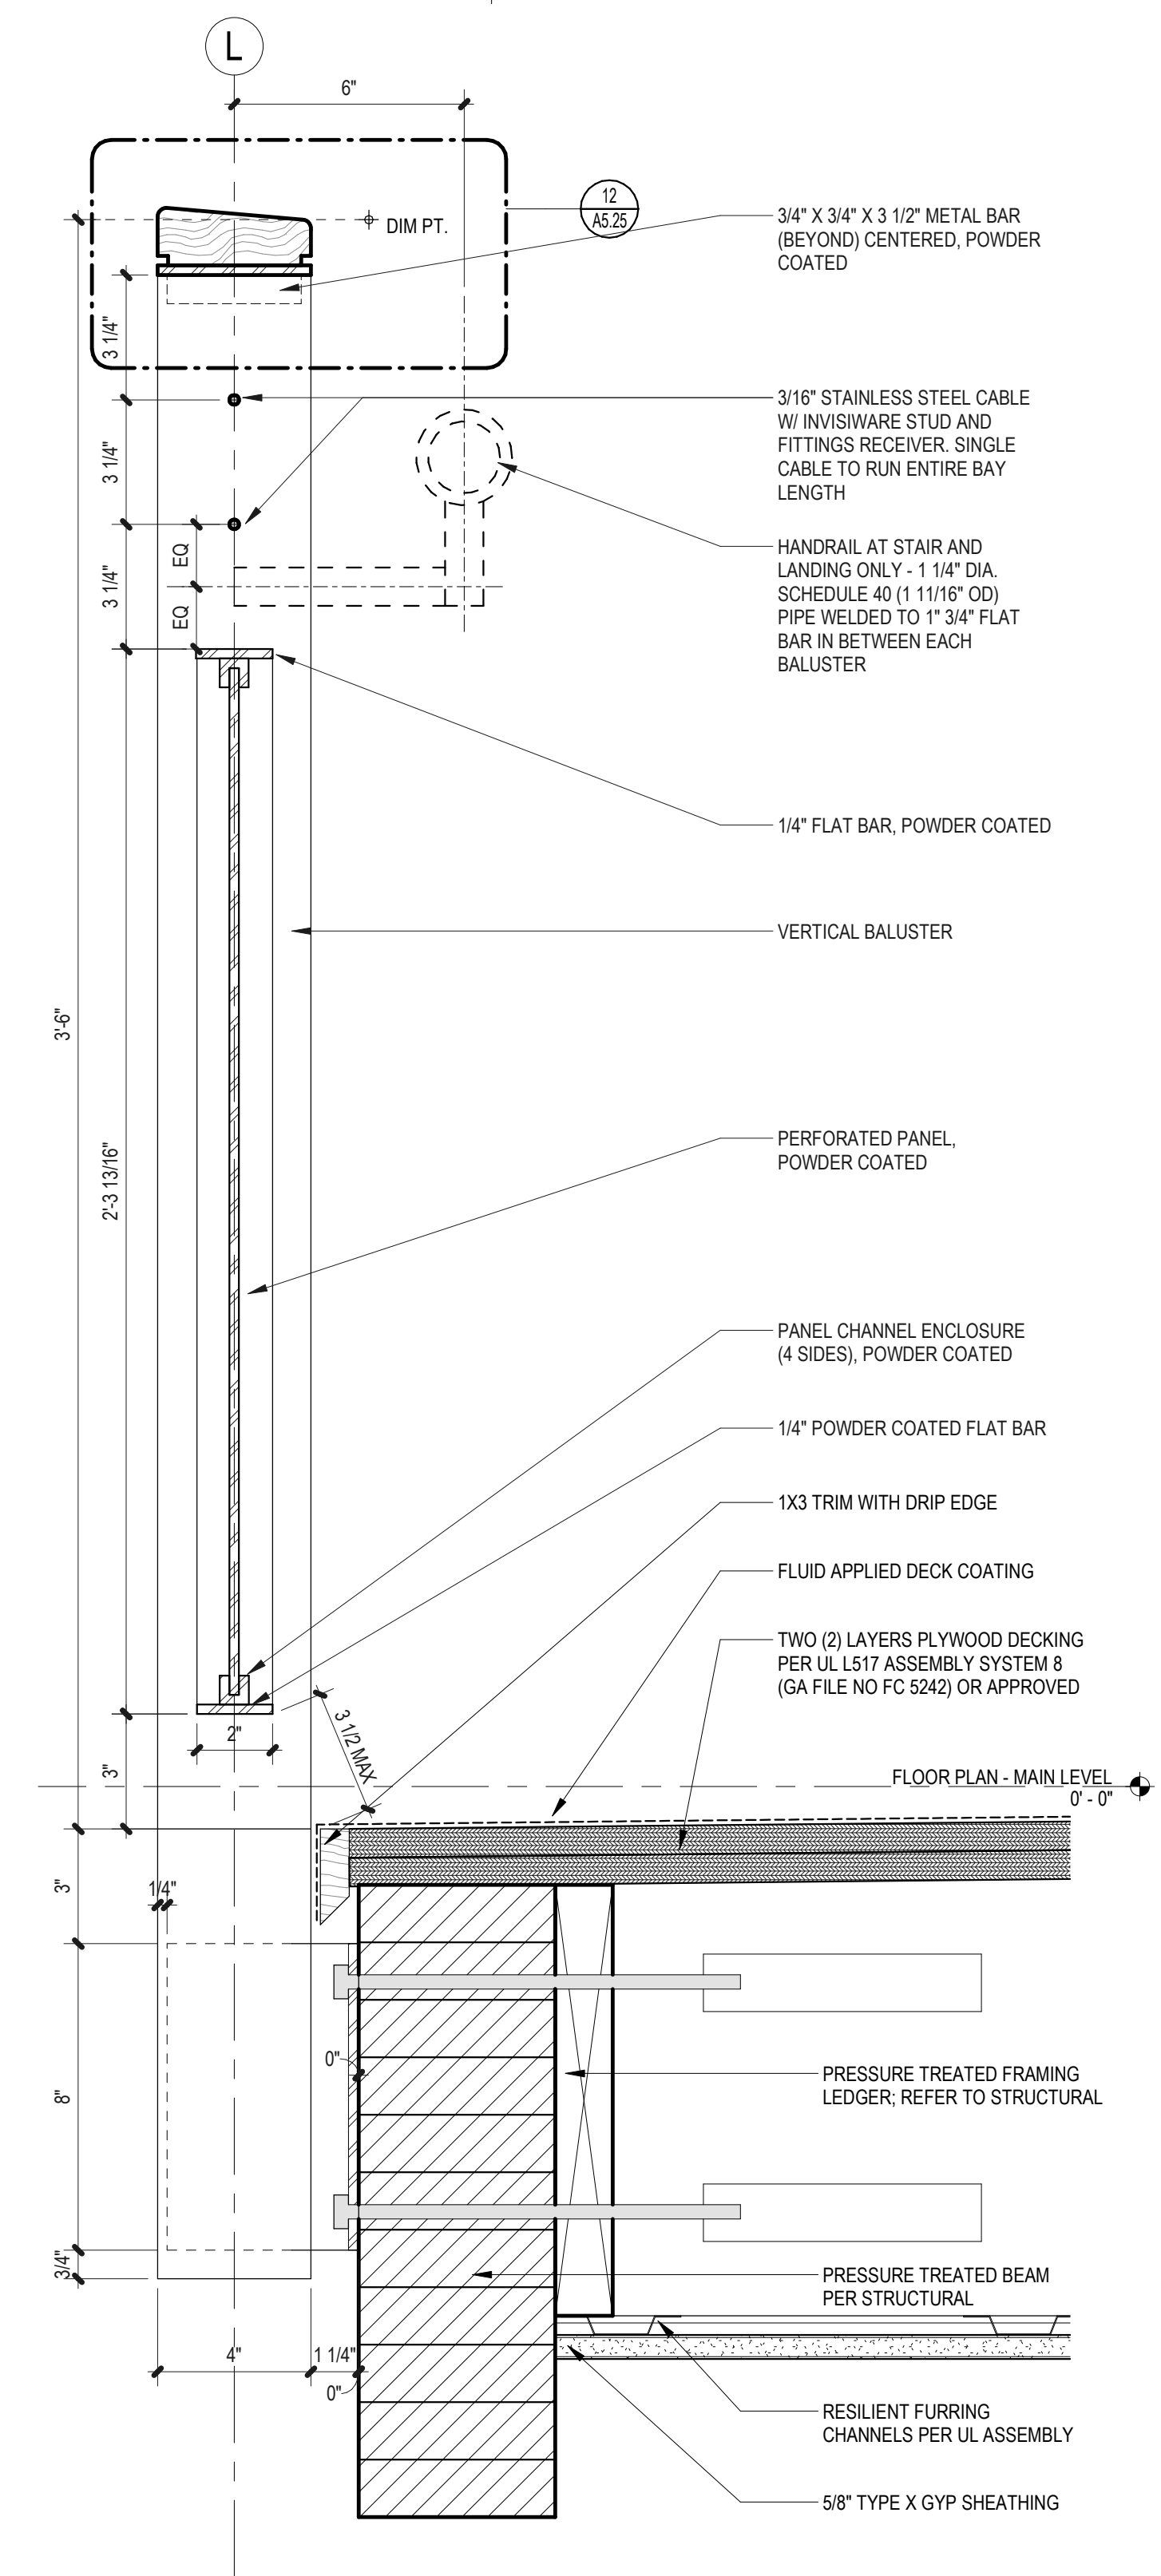


1 RAILING AND SOUTH BALCONY DETAIL
3" = 1'-0"

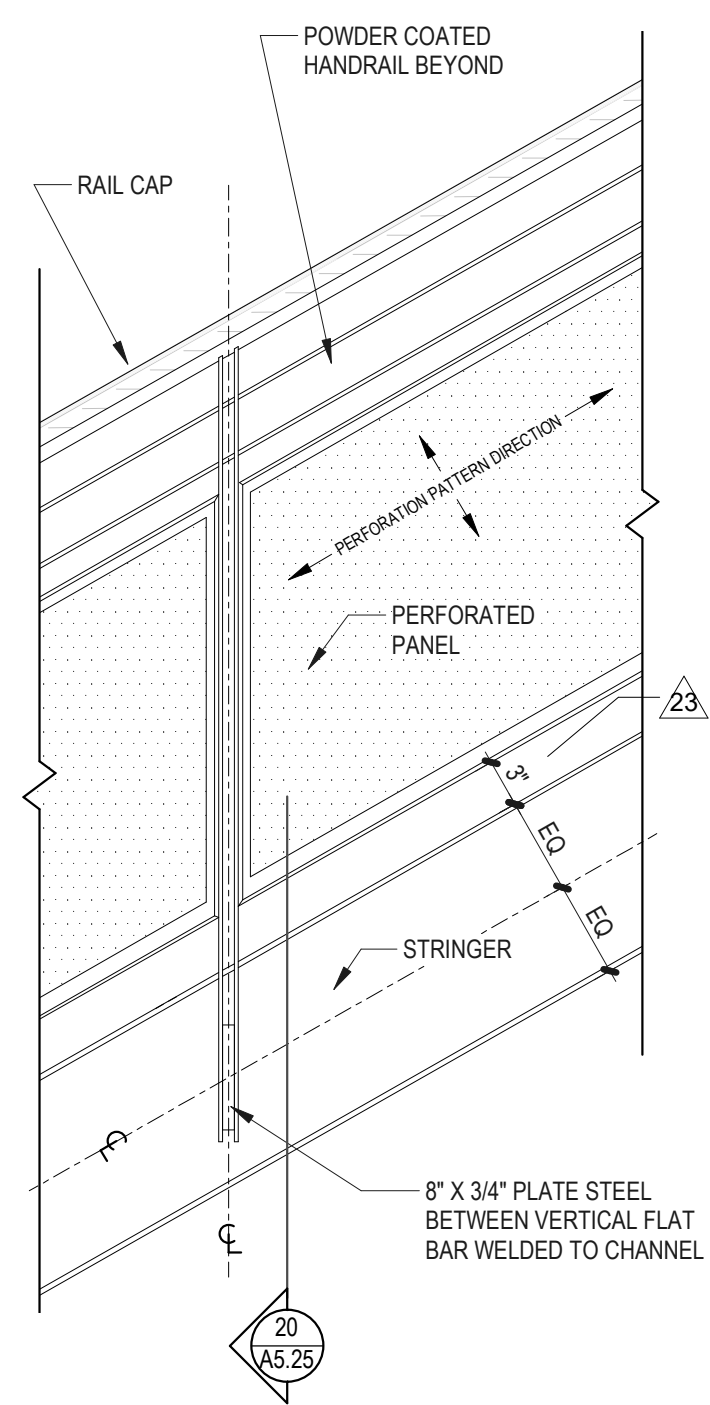


19 GUARDRAIL AT EXTERIOR STAIR
1" = 1'-0"

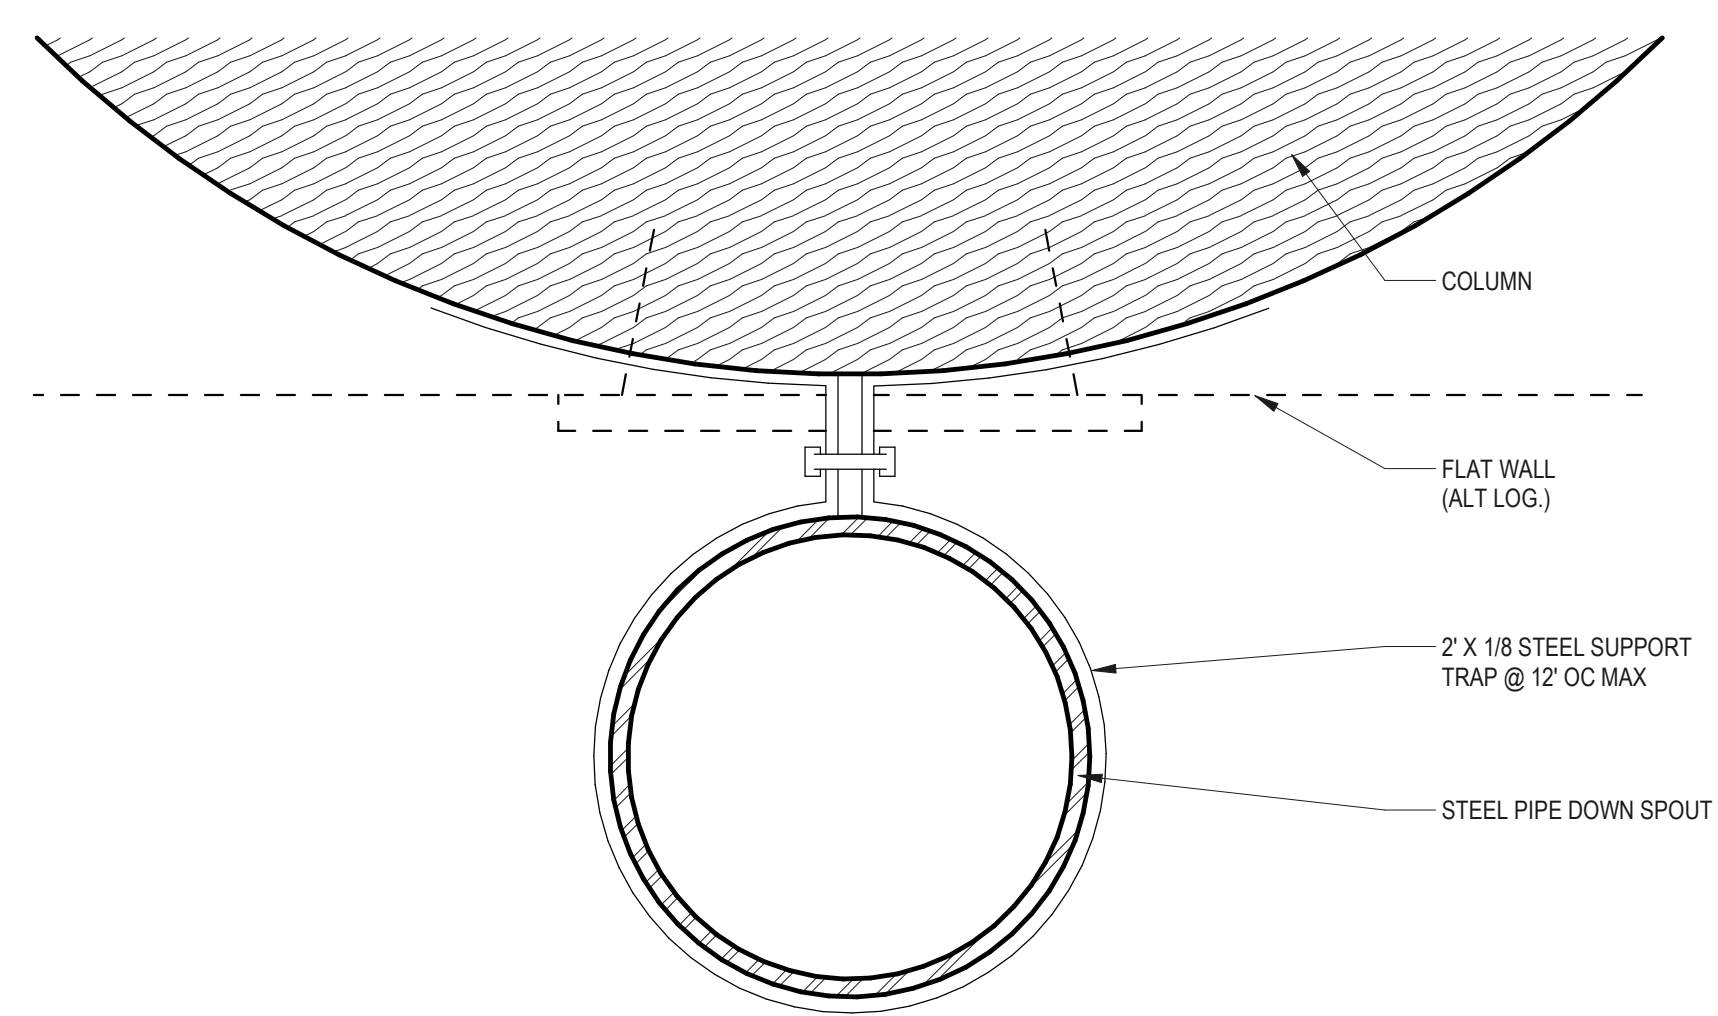

18 TYP. DOWN SPOUT SUPPORT
3" = 1'-0"

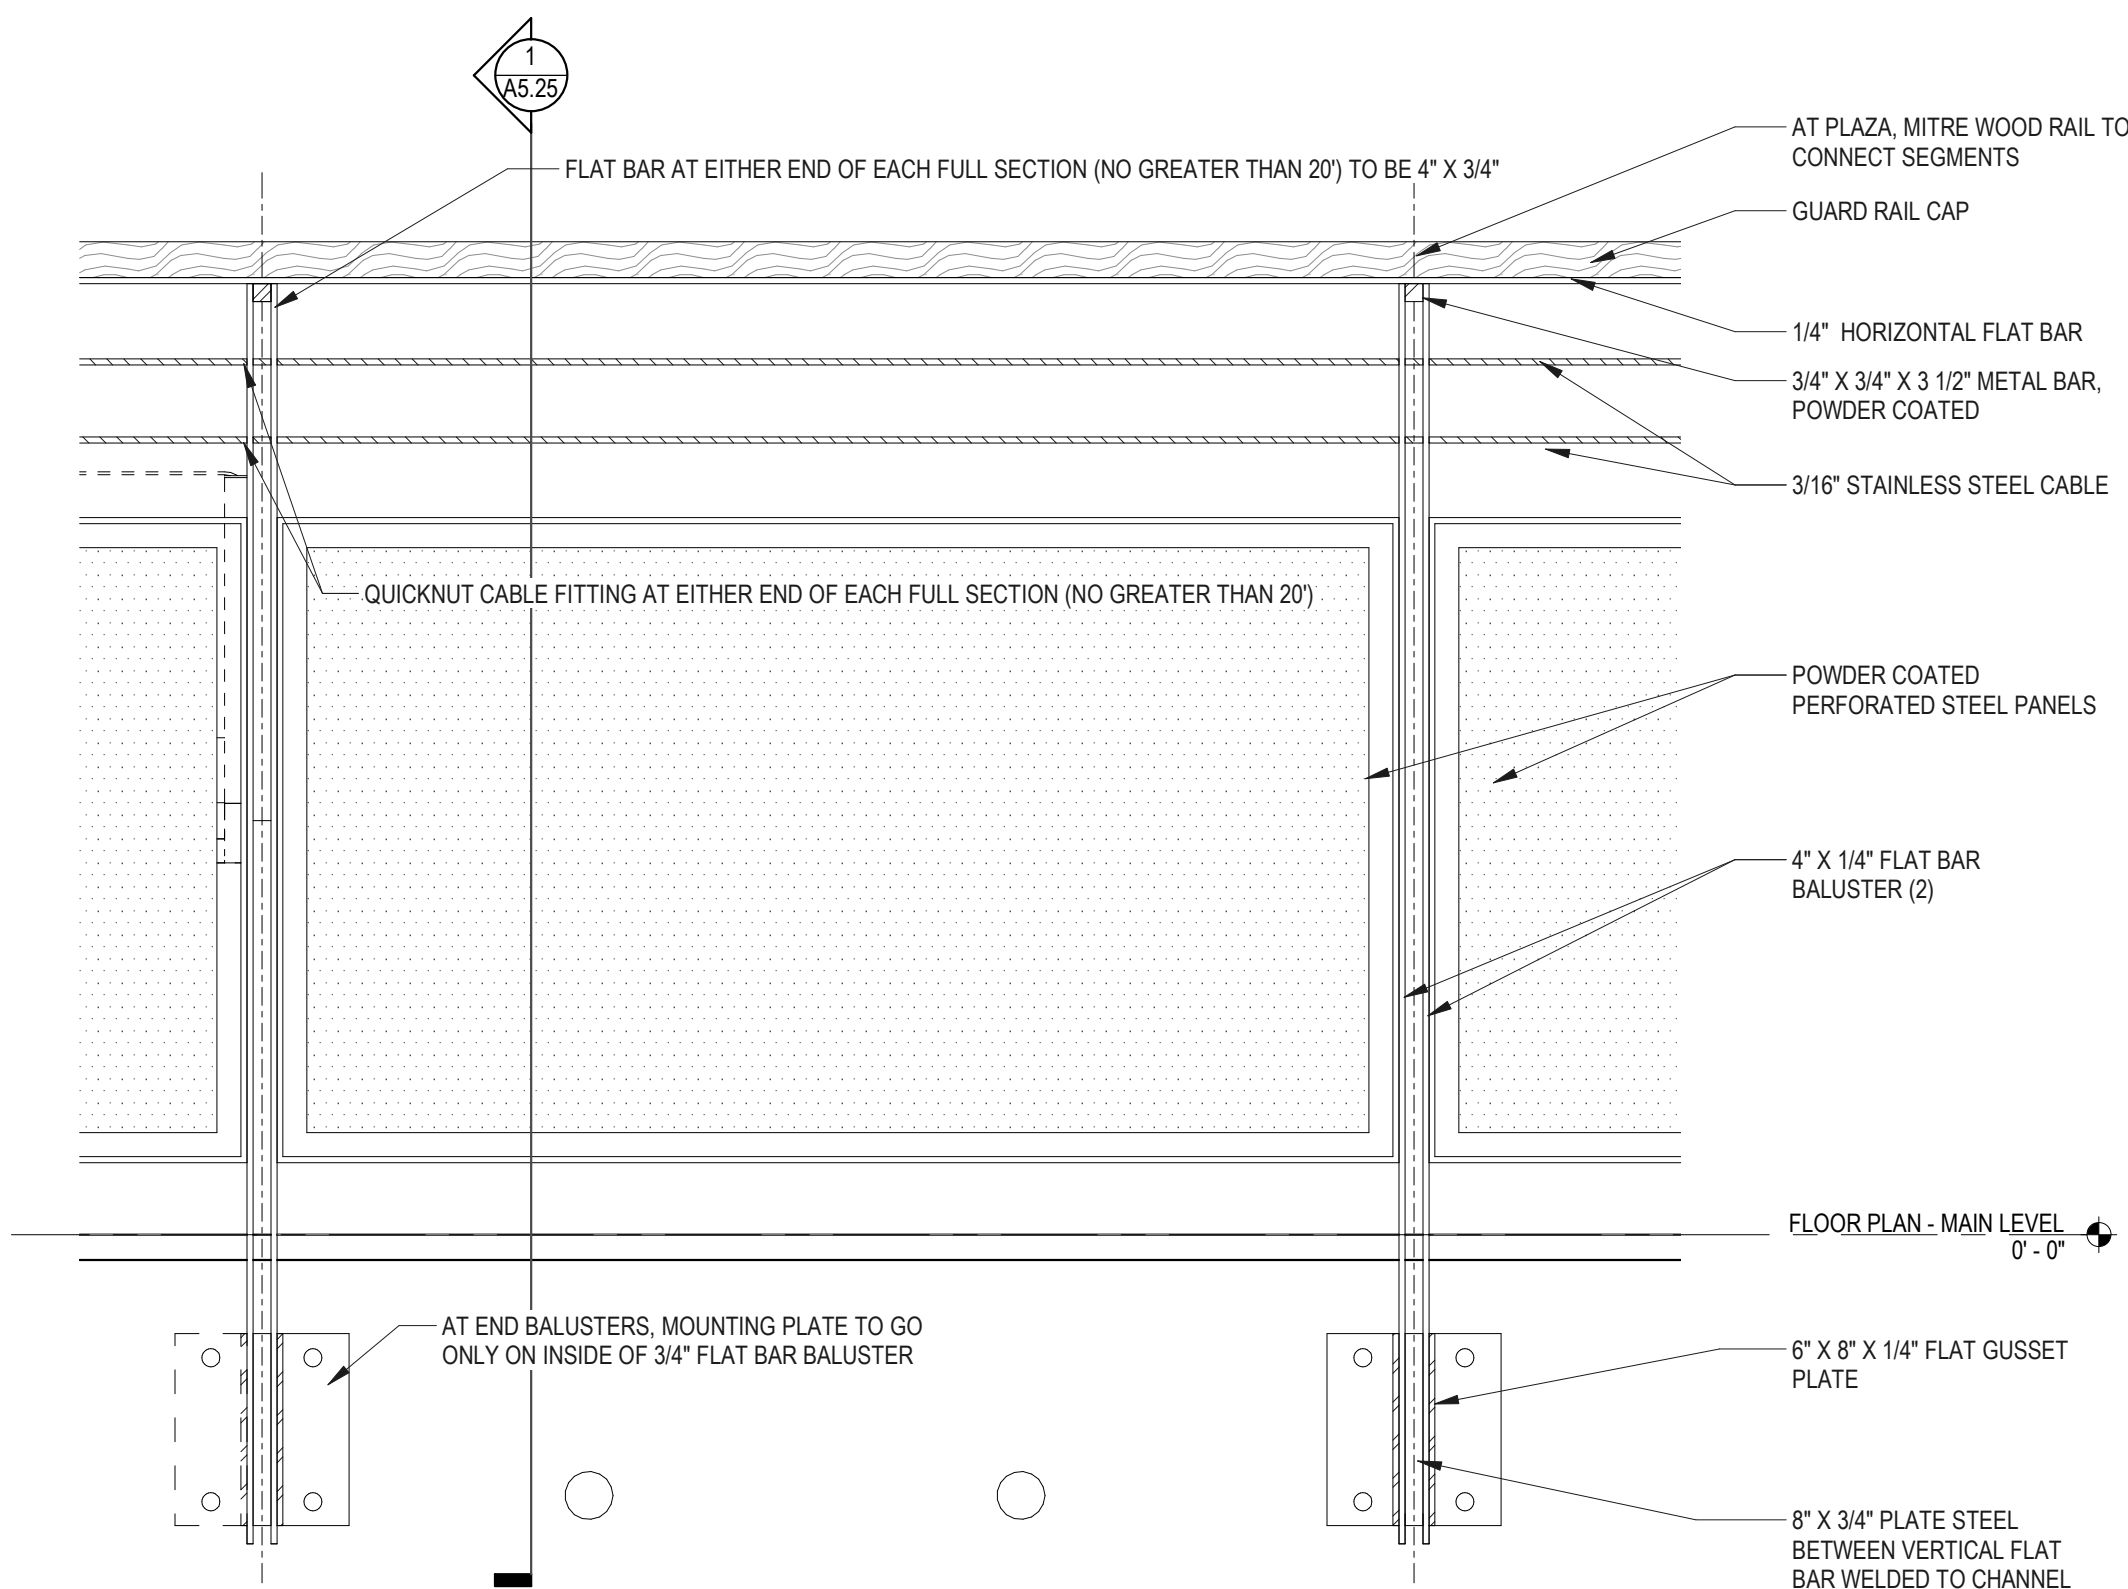

11 BALCONY HANDRAIL ELEVATION
1 1/2" = 1'-0"

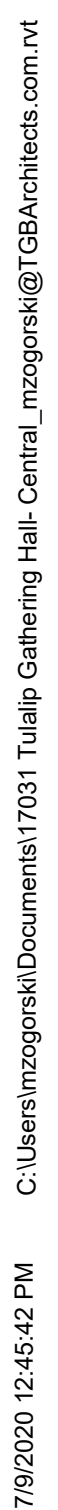

TULALIP TRIBES GATHERING HALL

7512 TOTEM BEACH RD
TULALIP, WA 98271

PHASE 2 - BUILDING AND LANDSCAPING


ROOF DETAILS

ISSUANCE		
No.	Description	Date
	PH 2 PERMIT SET	08/16/18
	PH 2 BID SET	10/08/18
	PH 2 PERMIT REVIEW 2019	01/04/19
11	PH 2 CCD 1	08/13/19
	PH 2 CONFORM SET	10/14/19
	PH 2 RECORD SET	06/02/20


PROJECT INFORMATION
PROJECT NUMBER: 17031
PROJECT LEAD: DC
DRAWN BY: RL

SHEET NO


A5.30

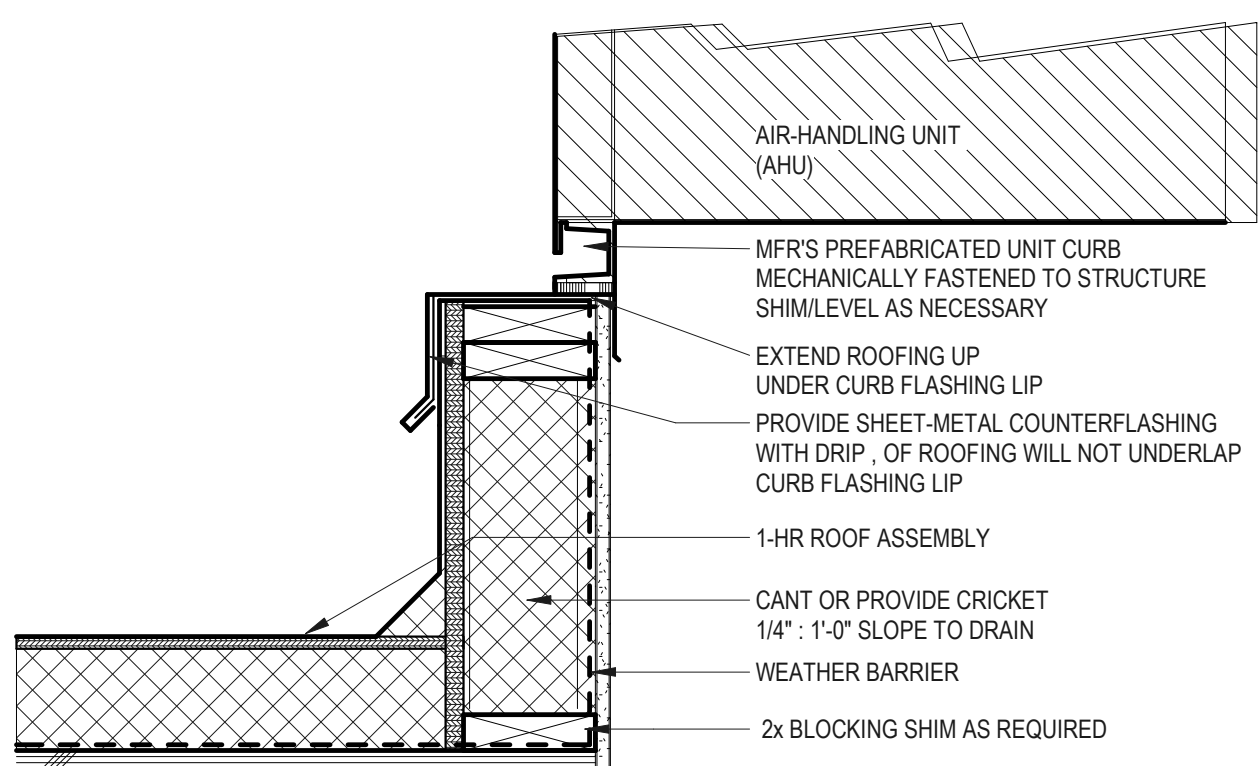


20 RTU CURB
1 1/2" = 1'-0"

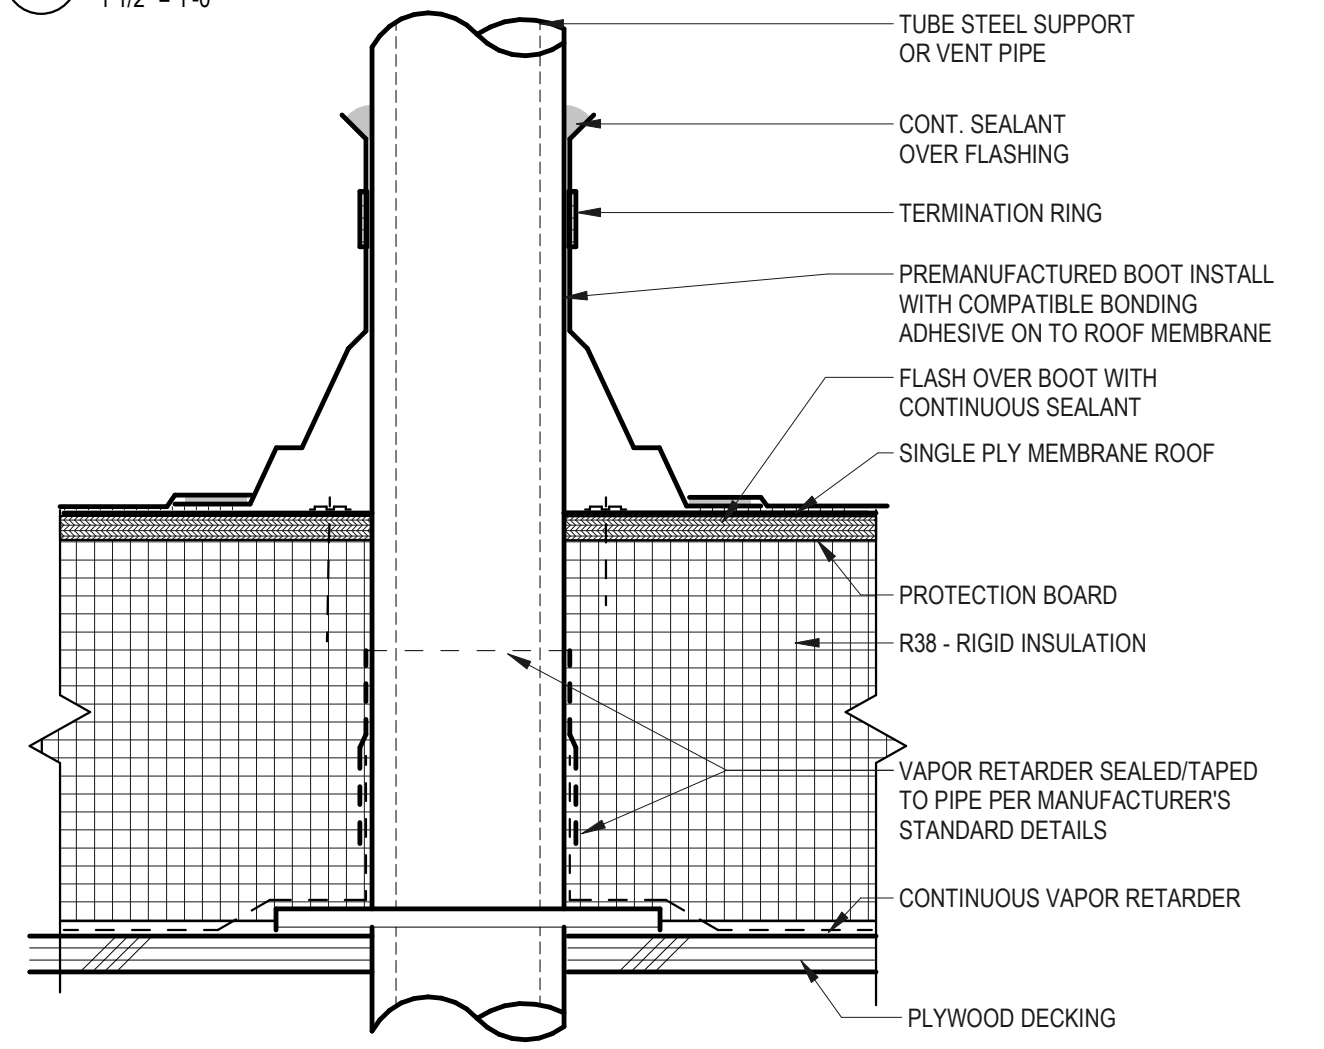


19 B3020.03 PIPE FLASHING
3" = 1'-0"

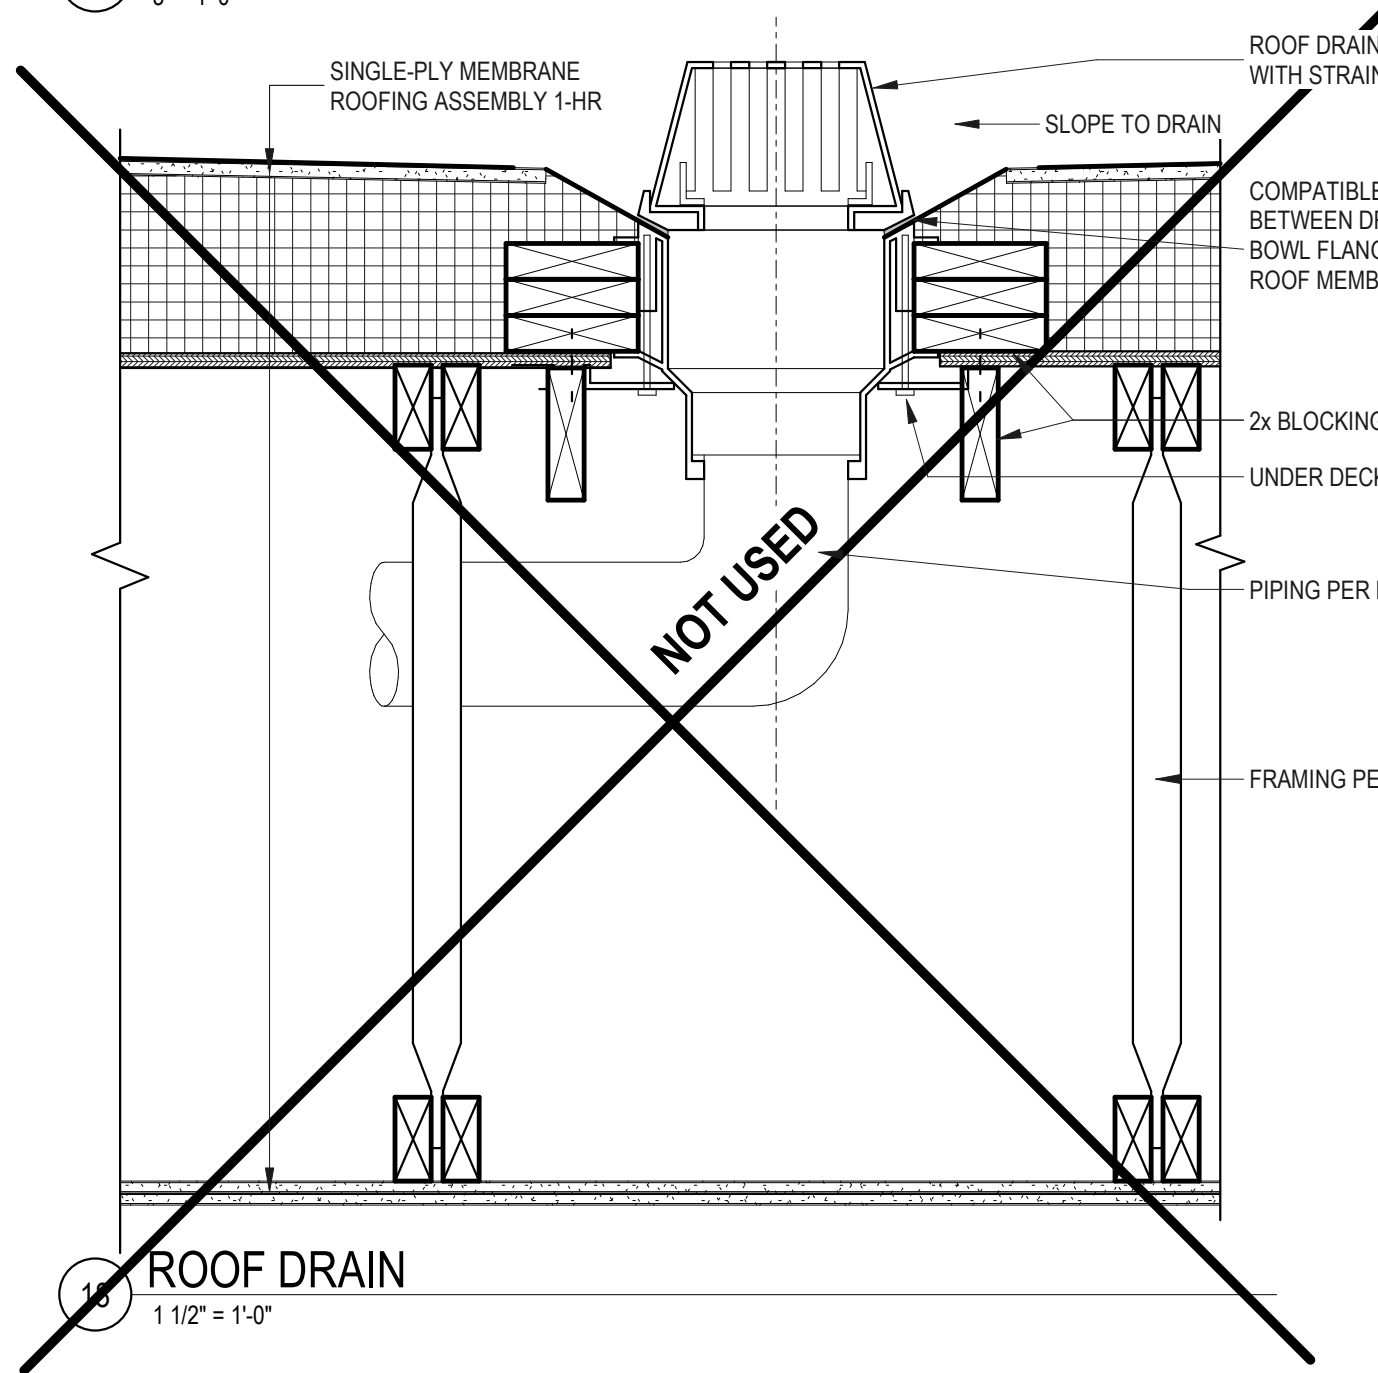


18 ROOF DRAIN
1 1/2" = 1'-0"

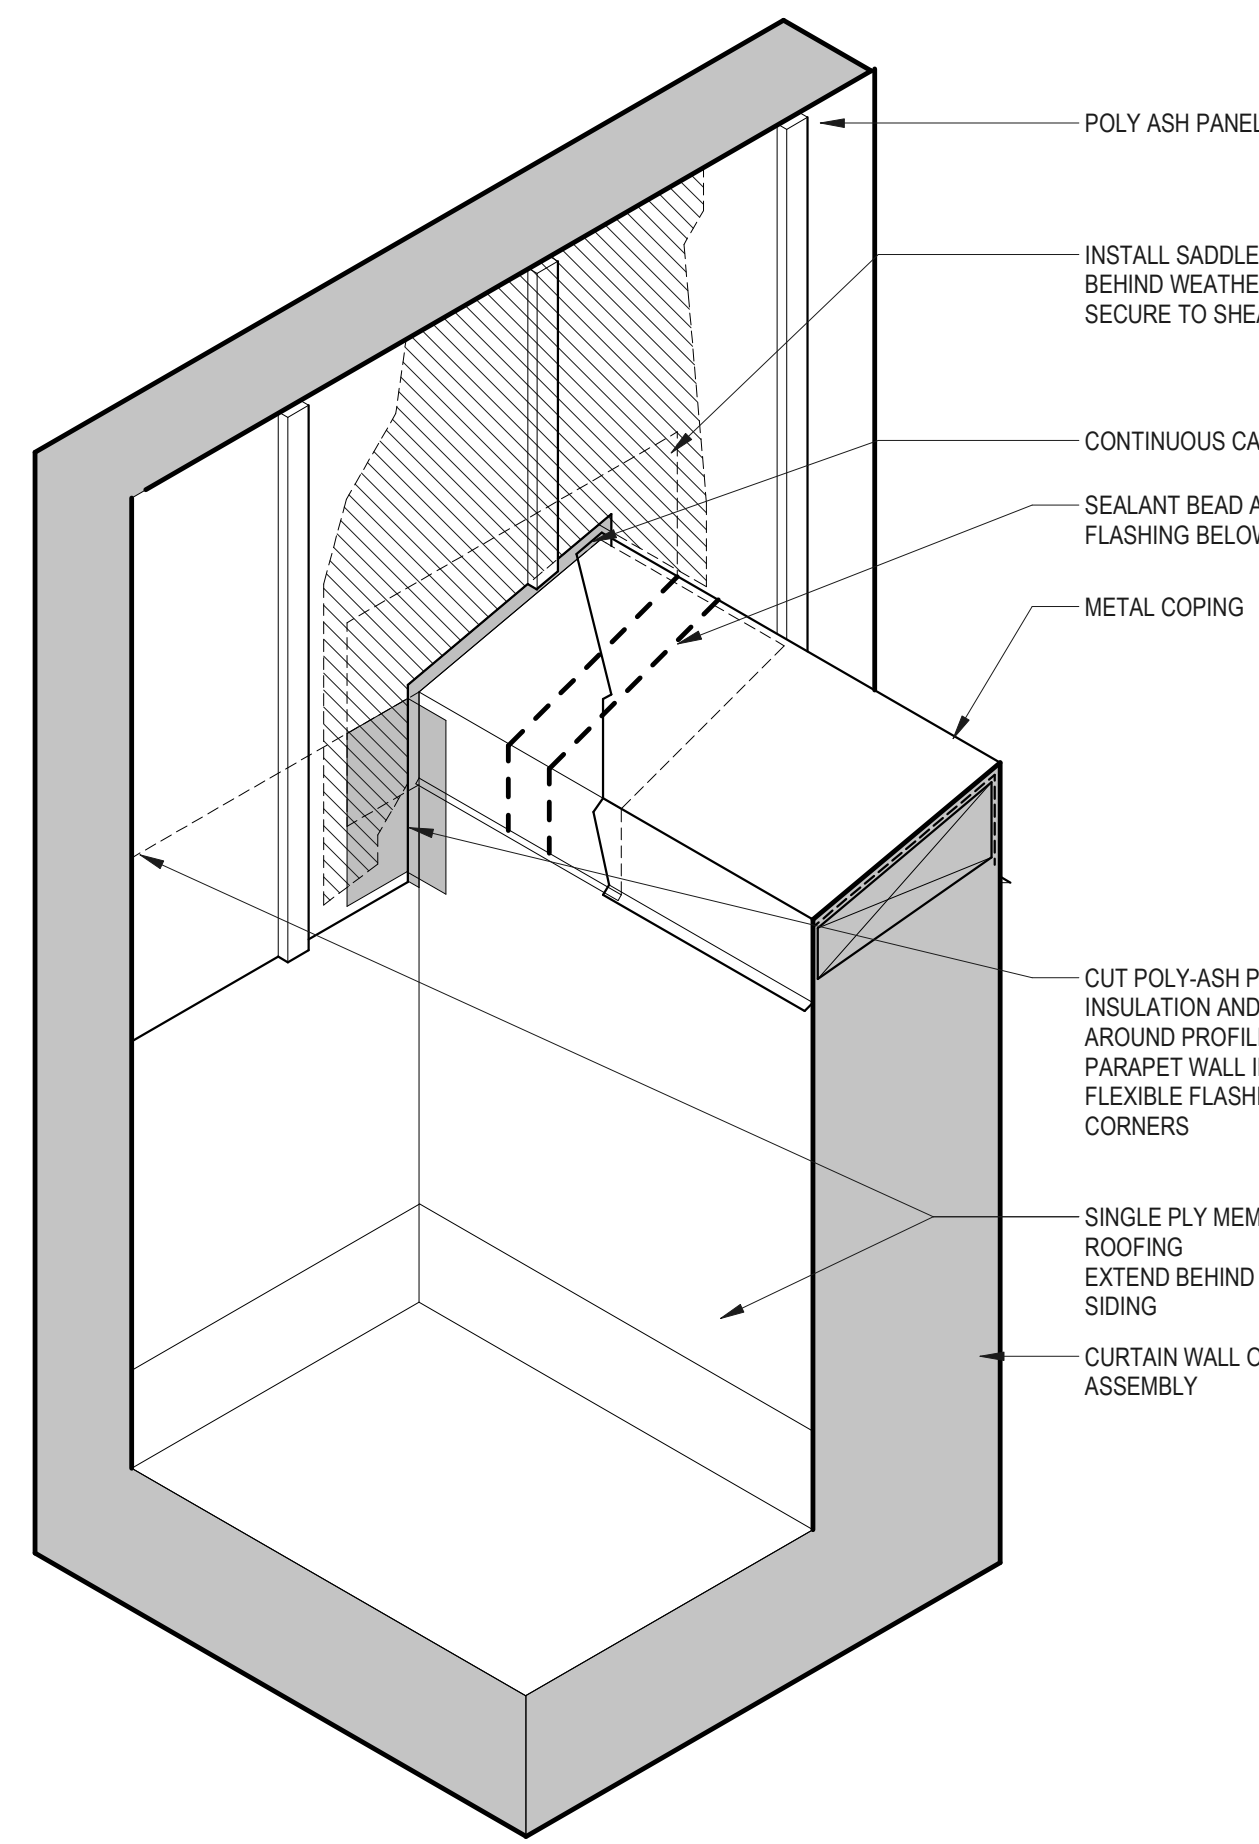


11 SADDLE FLASHING DETAIL
1 1/2" = 1'-0"

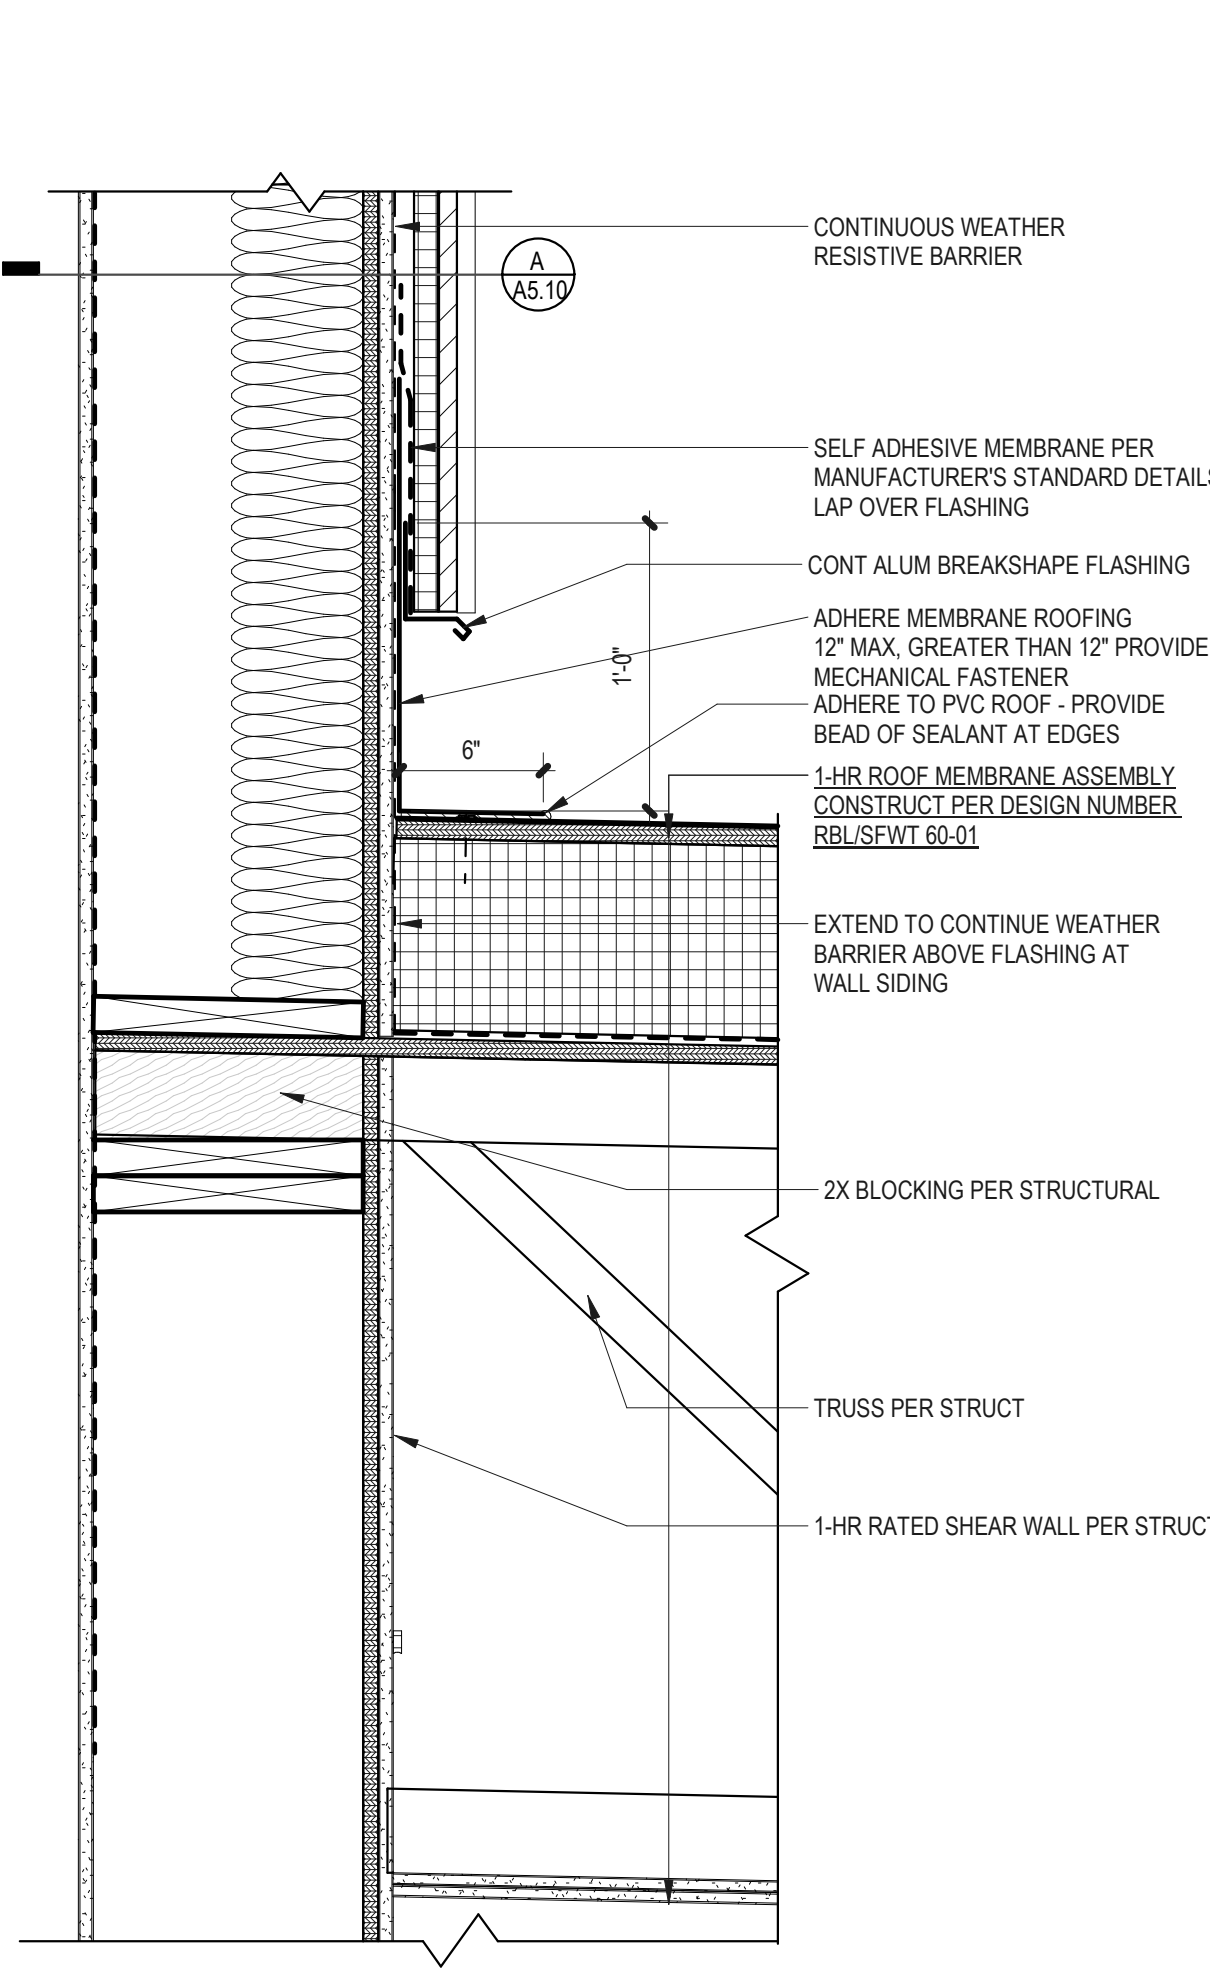


14 MEMBRANE ROOF TO WALL
1 1/2" = 1'-0"

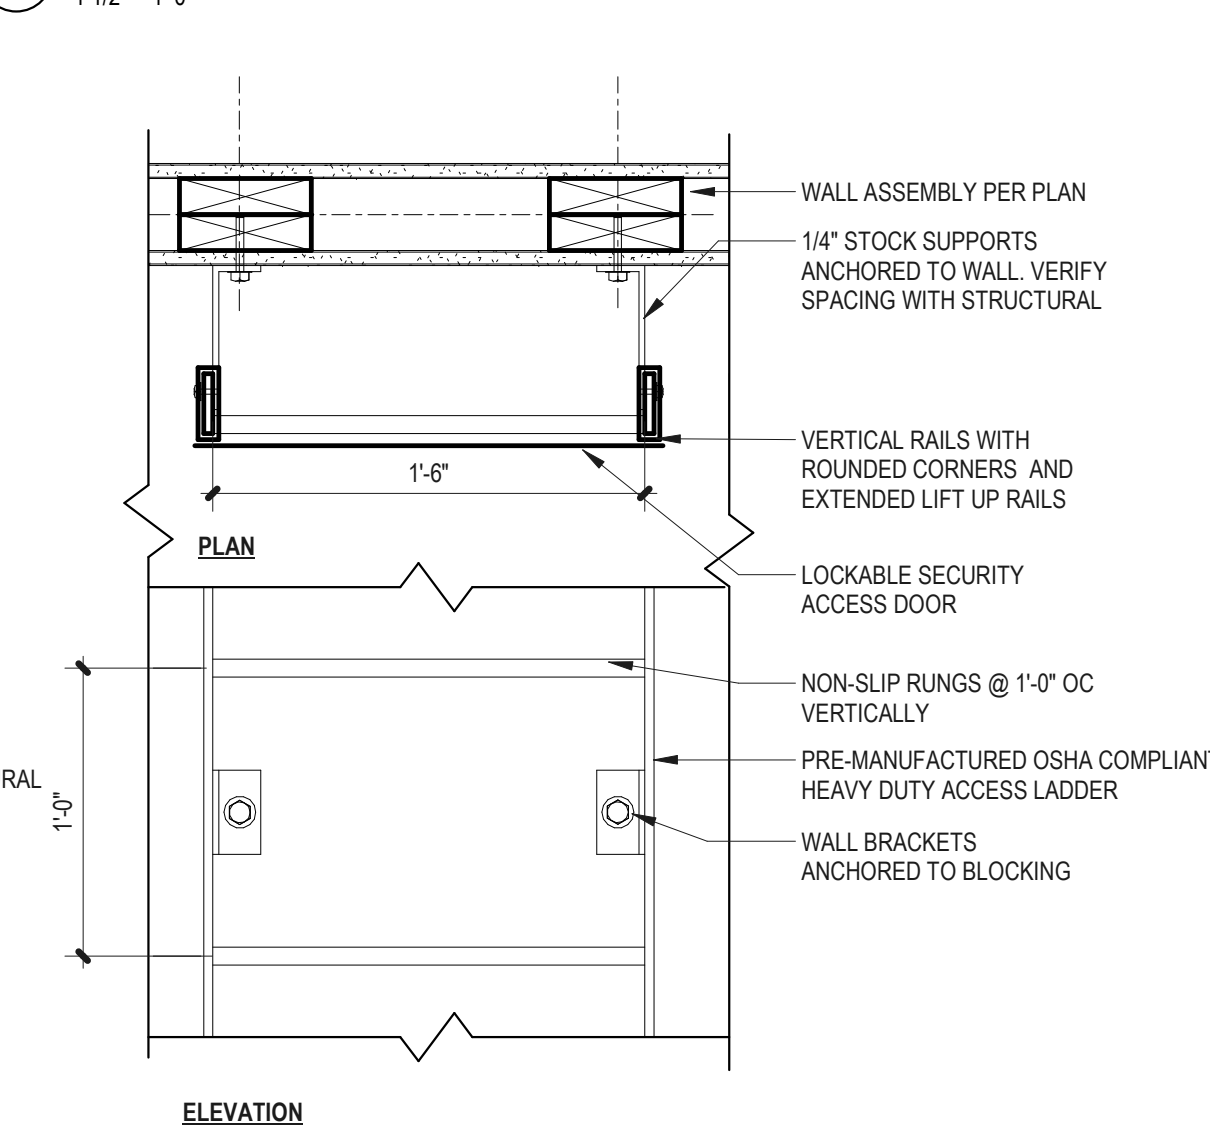


13 ACCESS LADDER
1 1/2" = 1'-0"

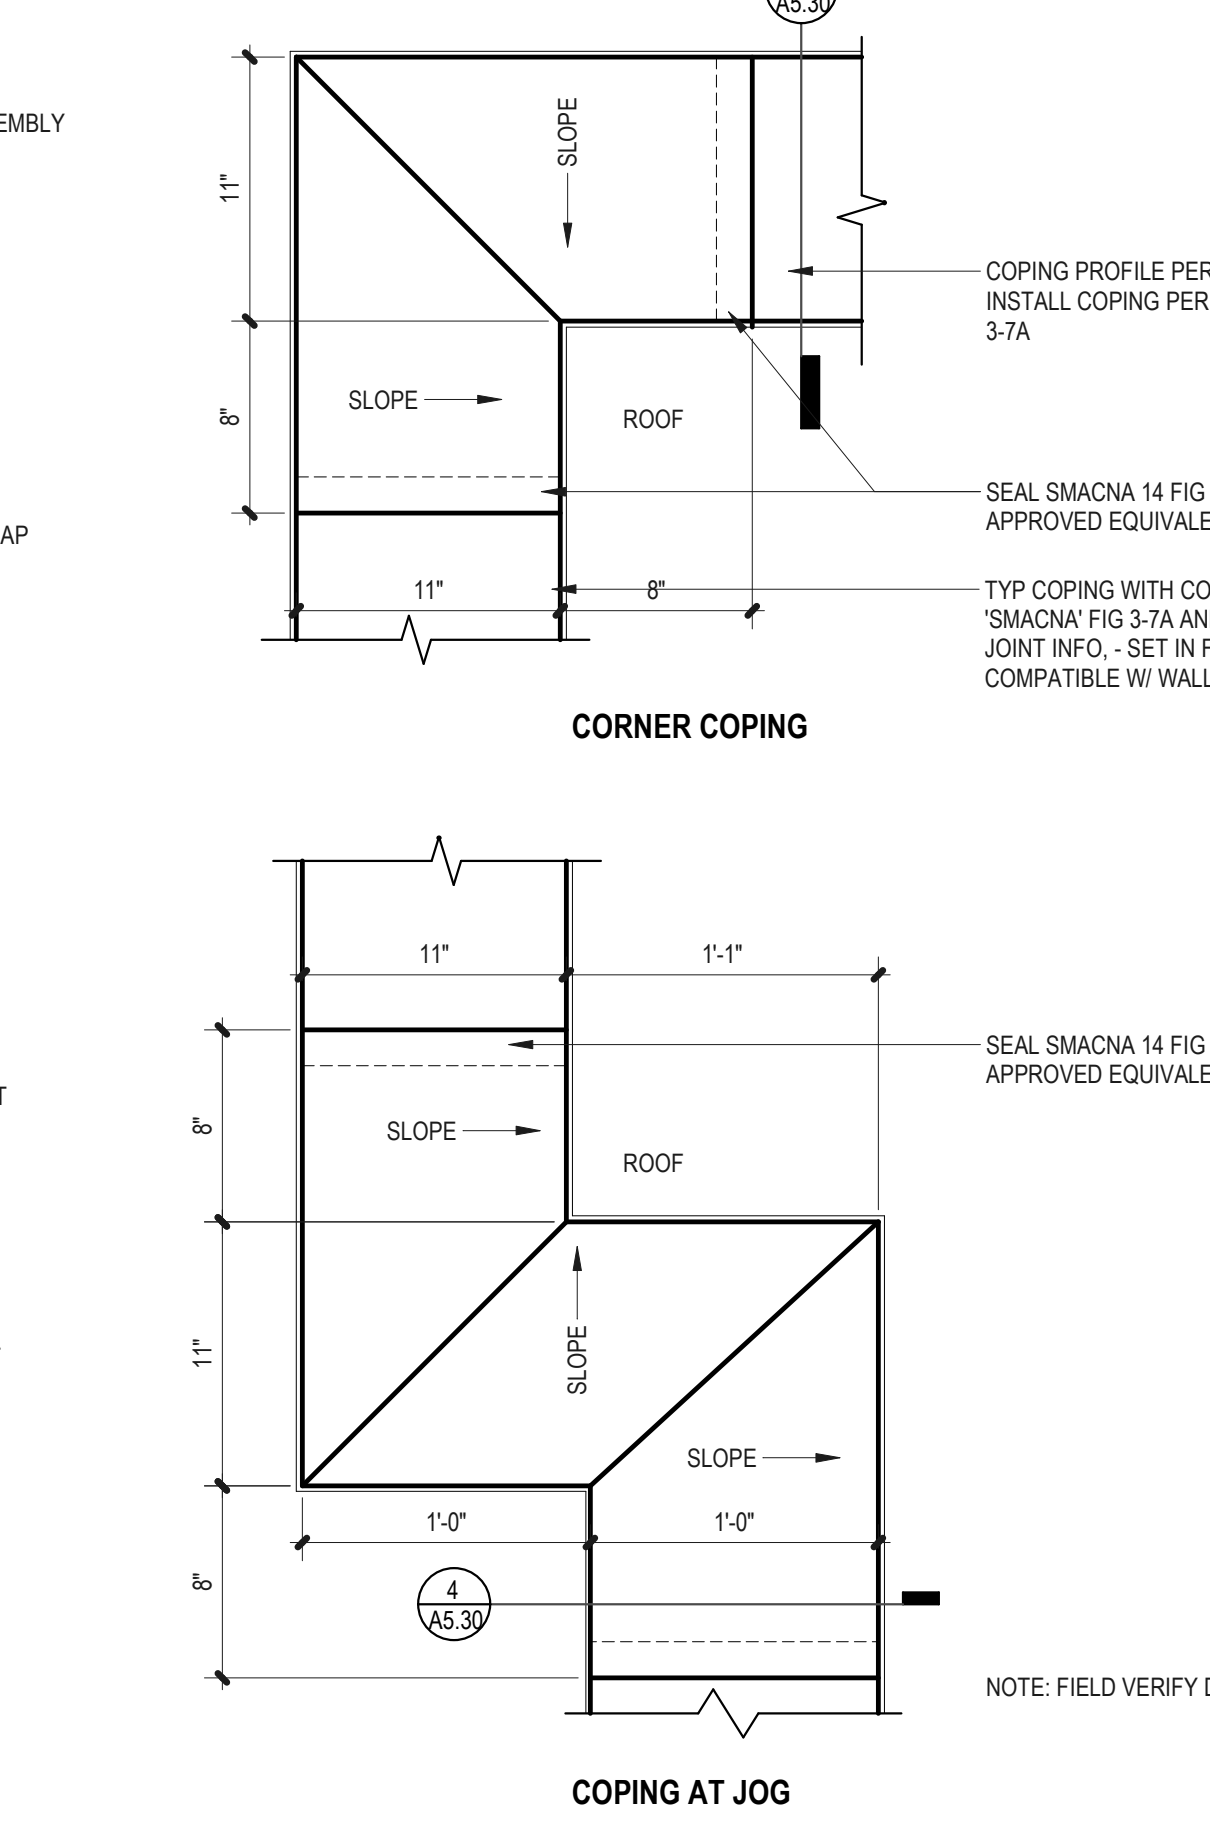


6 COPING PLAN VIEW
1 1/2" = 1'-0"

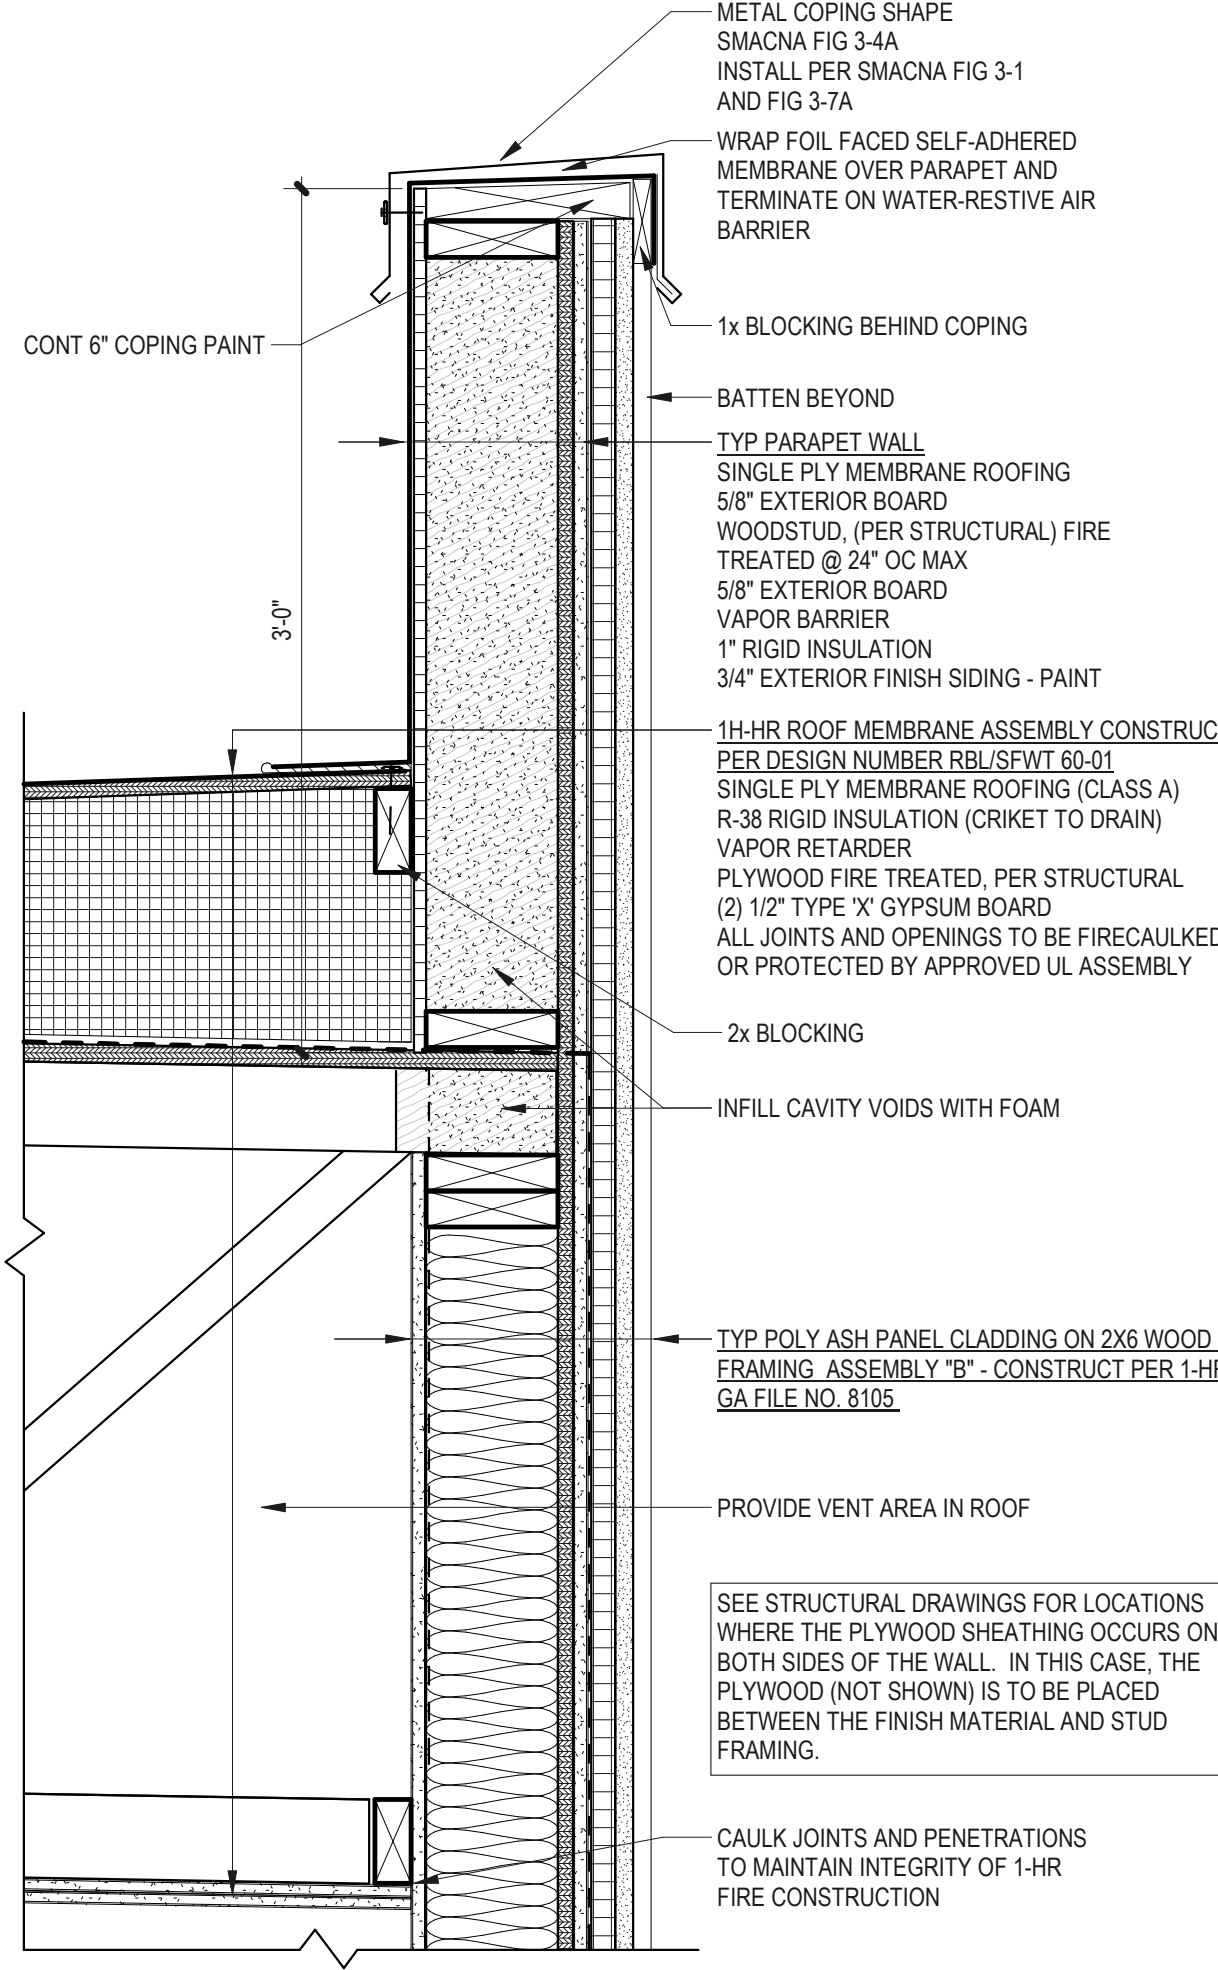


9 PARAPET AT LOW ROOF
1 1/2" = 1'-0"

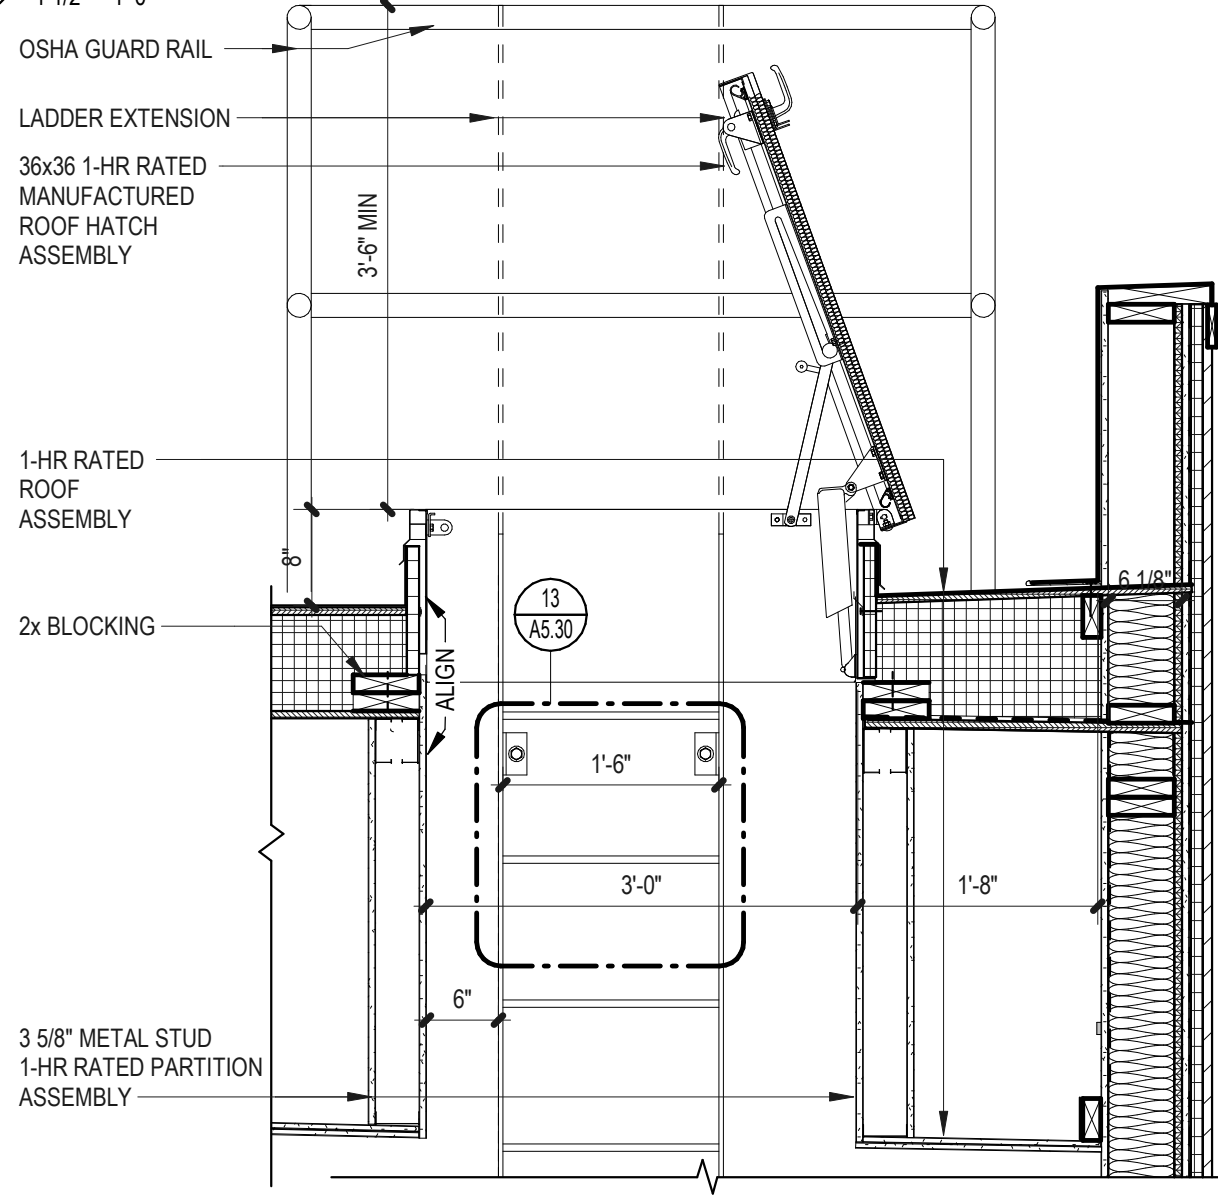


8 B3020.04 ROOF HATCH
3/4" = 1'-0"

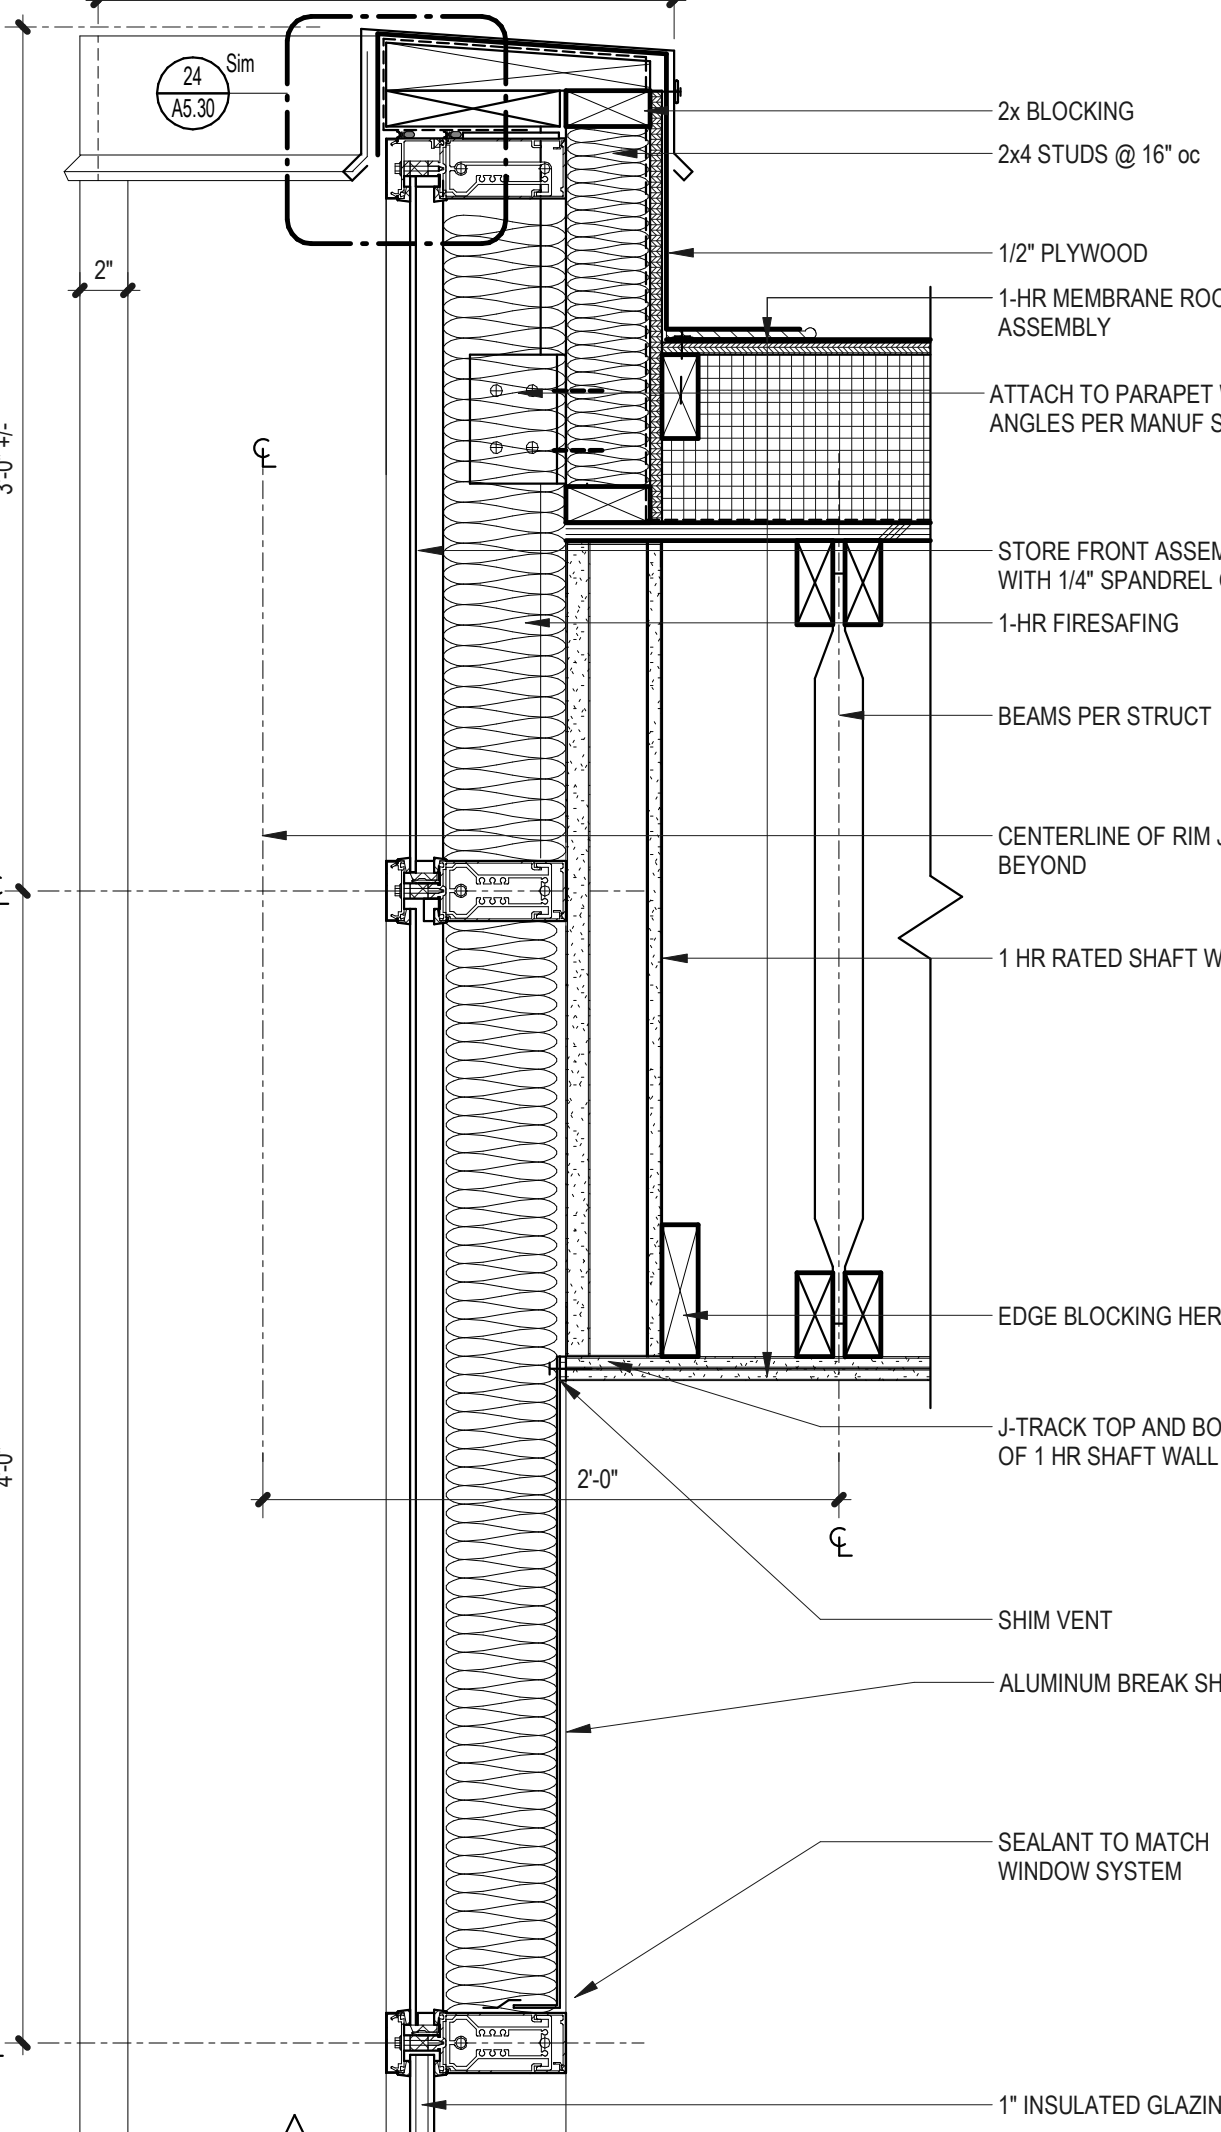


4 CURTAIN WALL AT ROOF
1 1/2" = 1'-0"

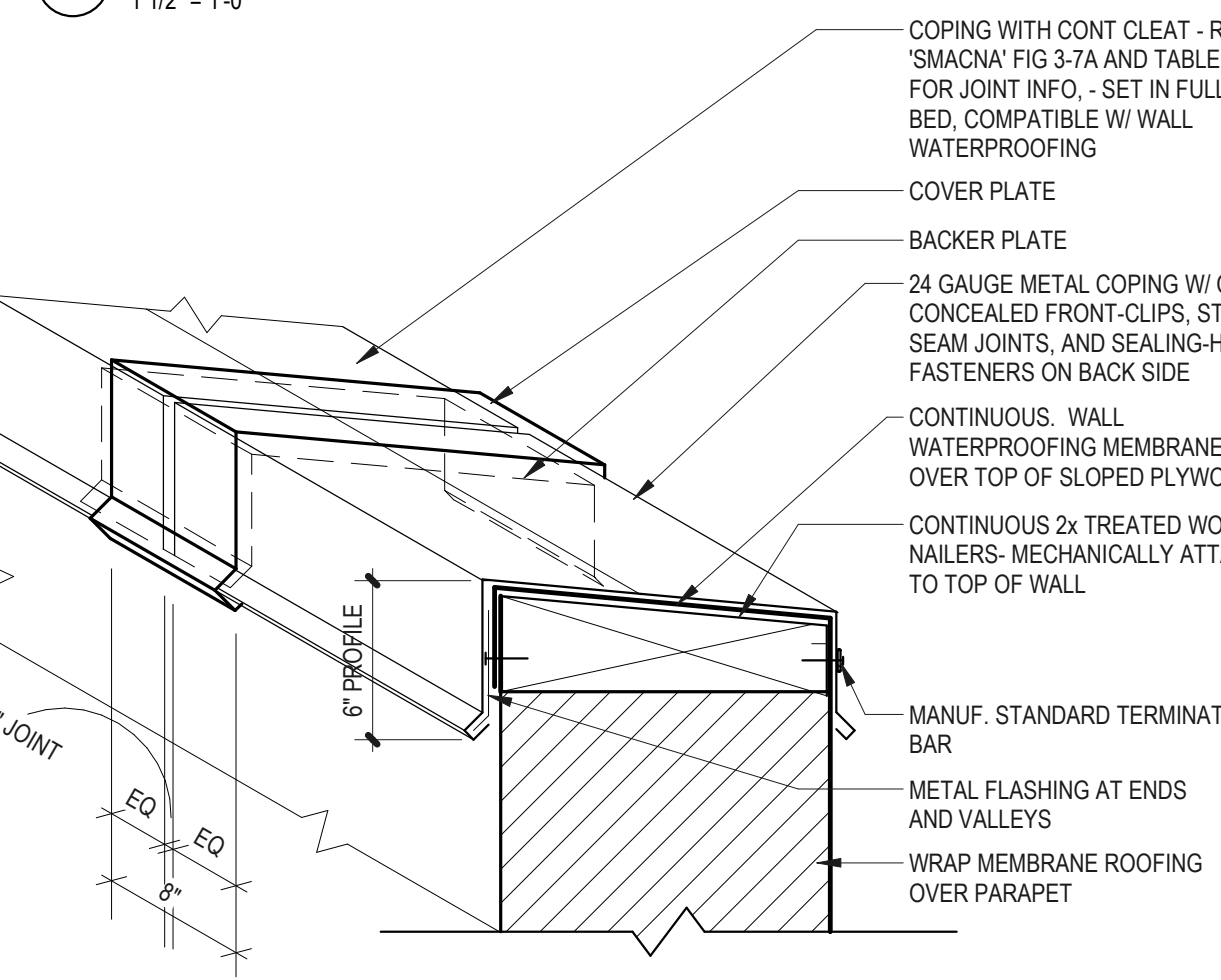


3 PARAPET CAP JOINT DETAIL
1 1/2" = 1'-0"

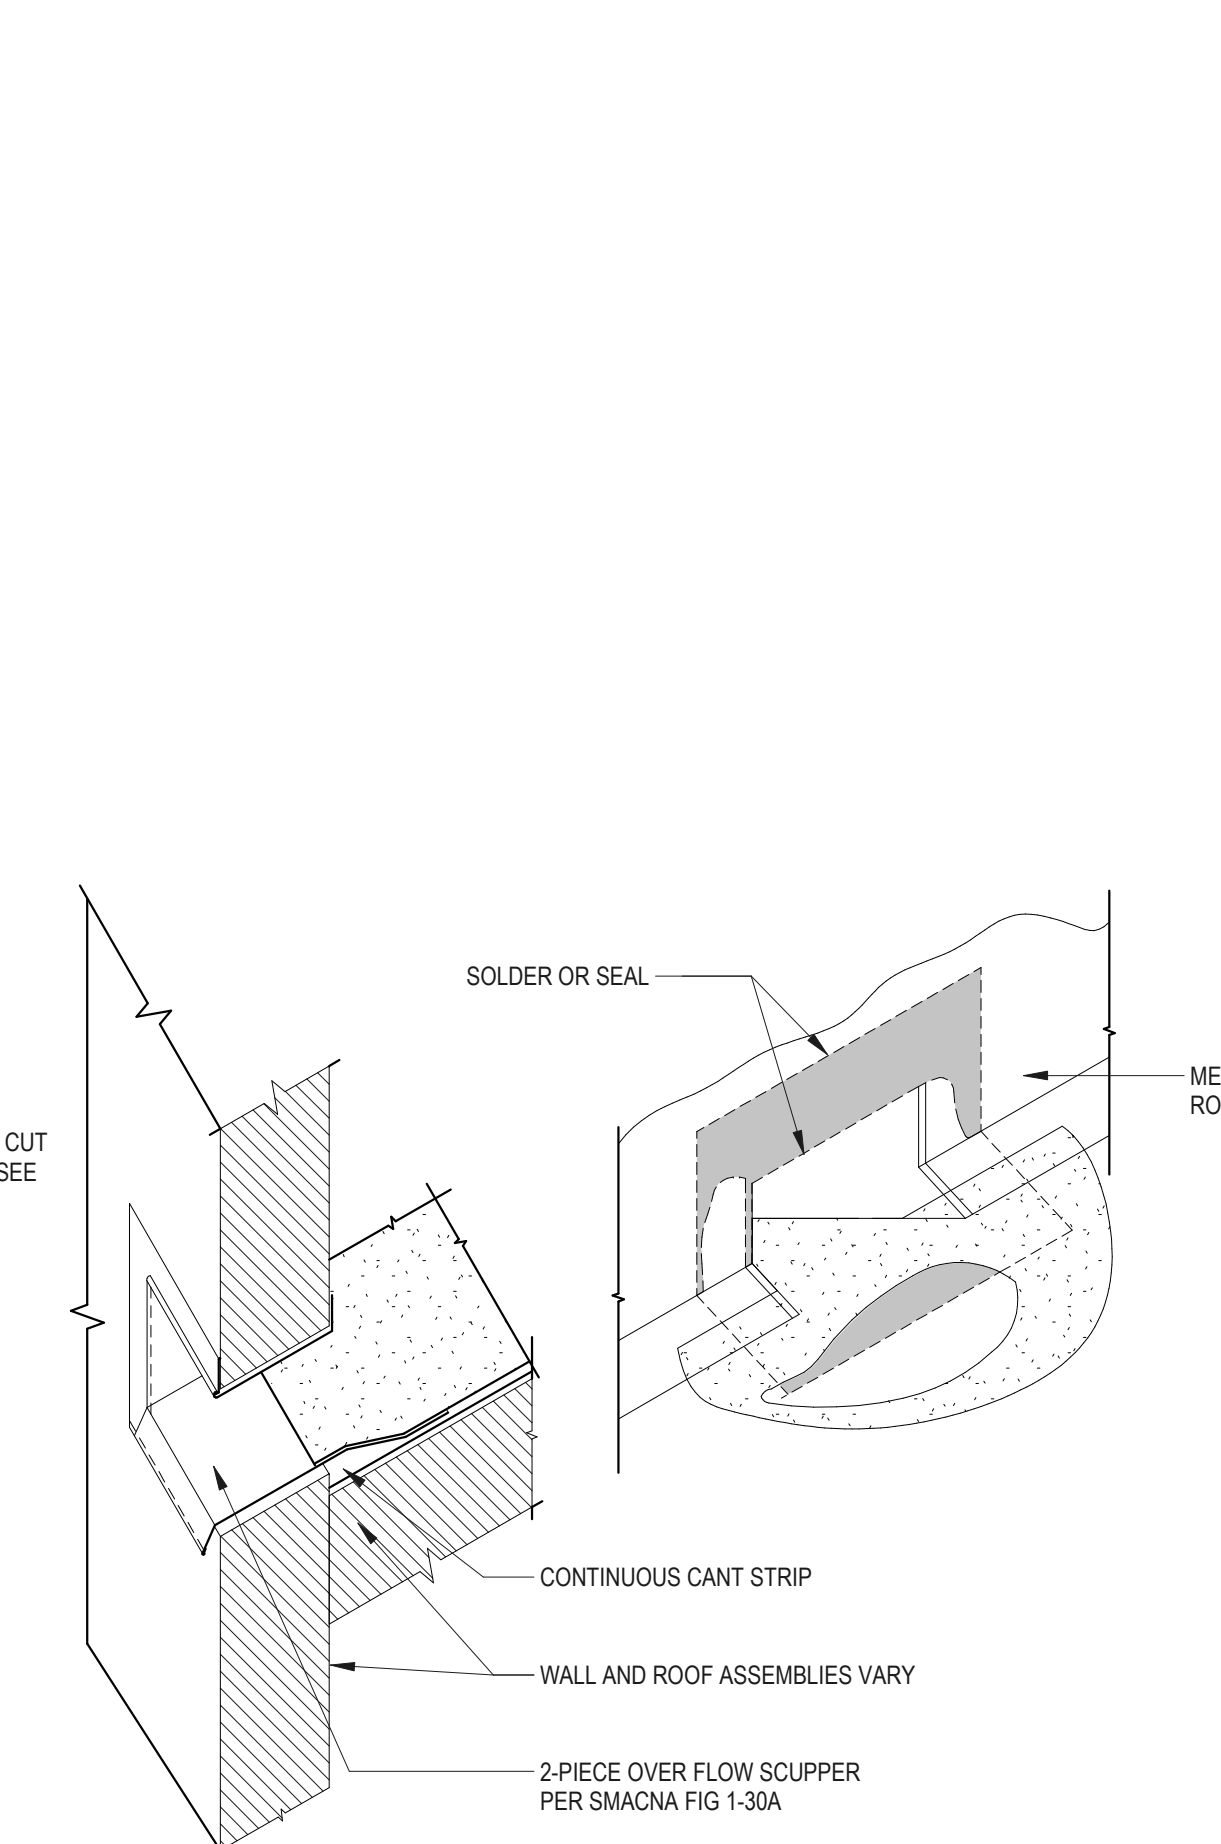


1 THROUGH WALL SCUPPER
NTS

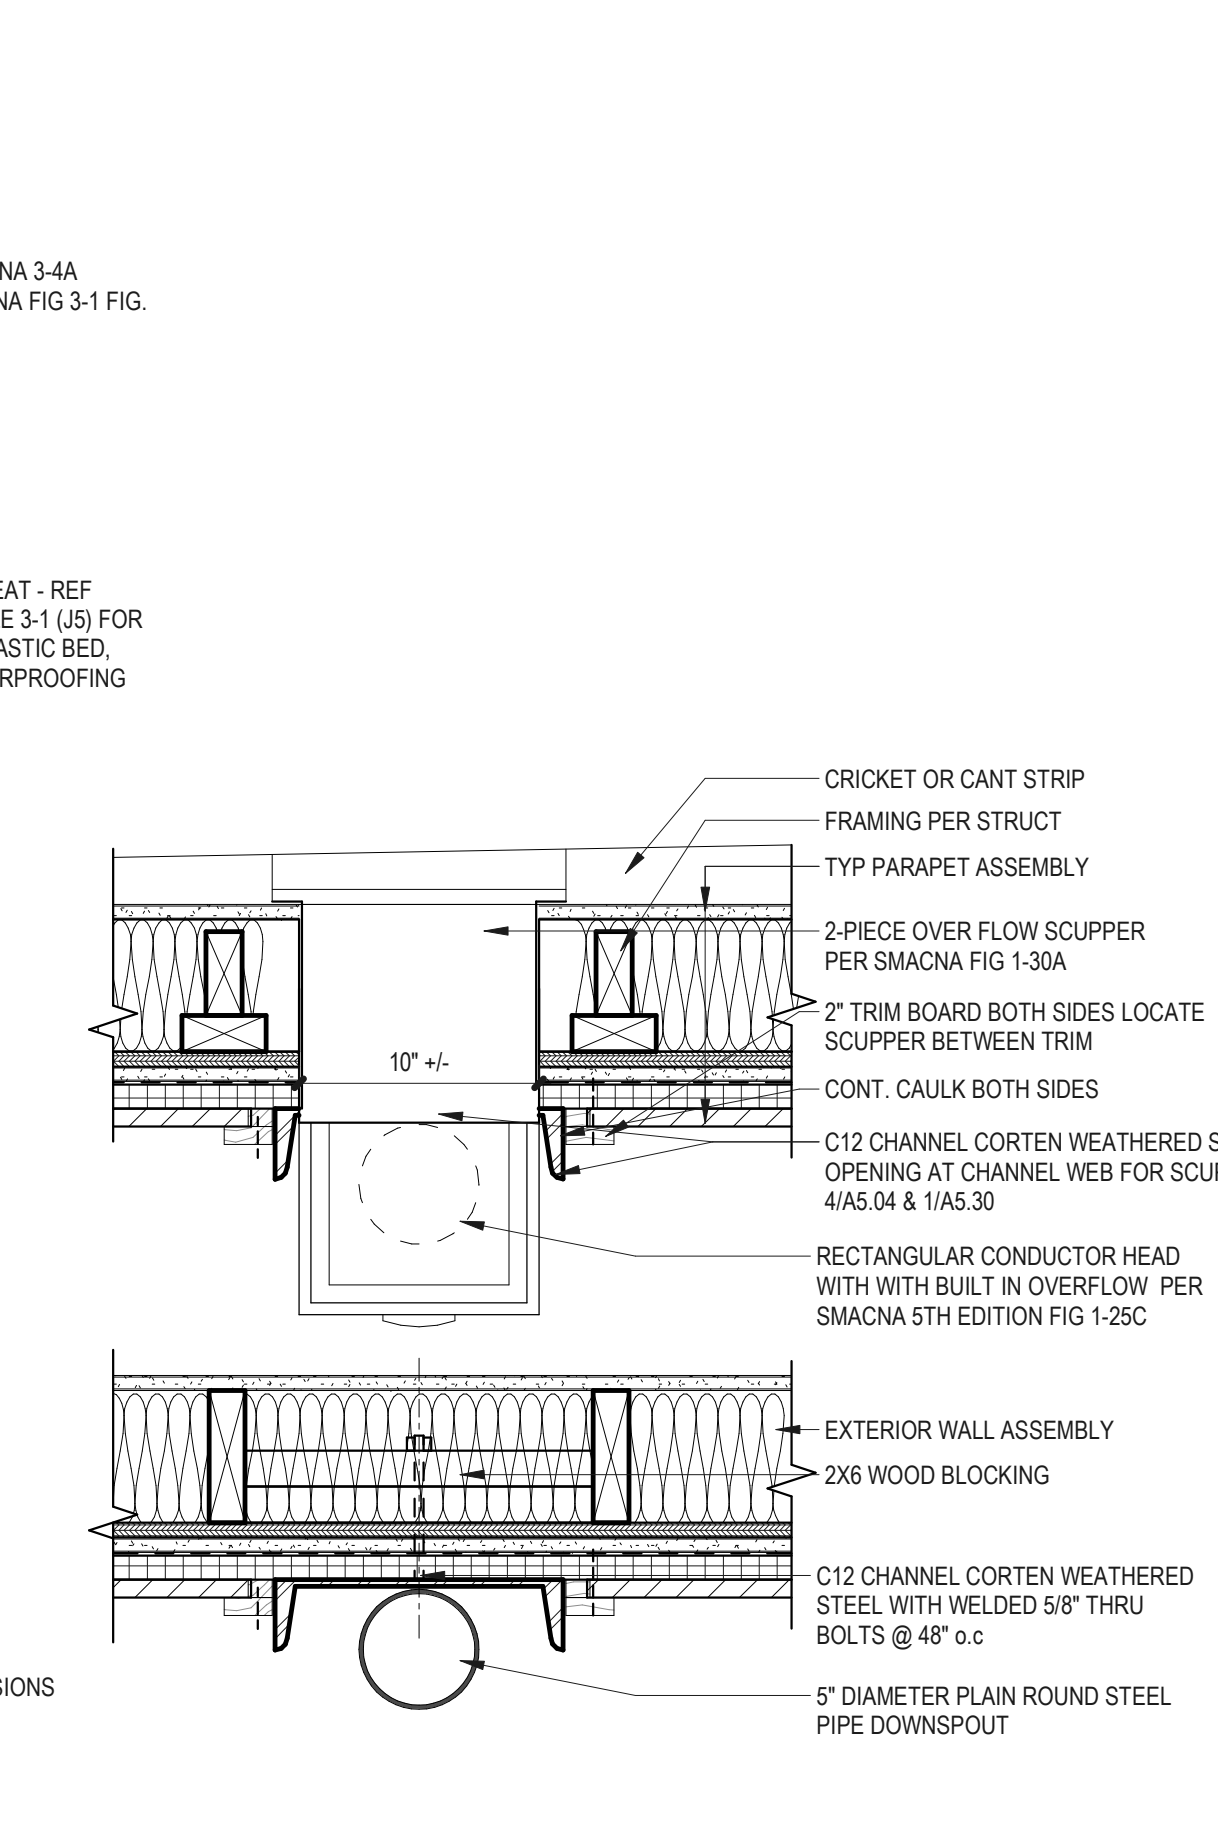


2 SCUPPER DETAIL - PLAN VIEW
1 1/2" = 1'-0"

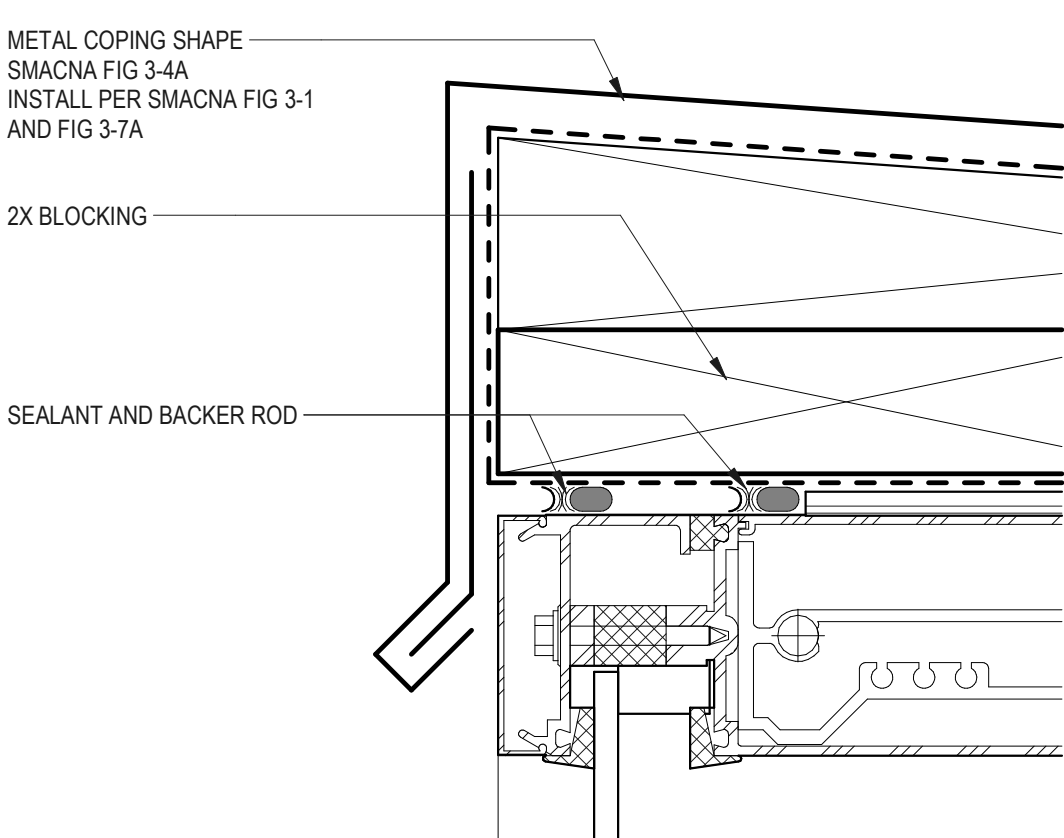

24 PARAPET CAP AT CURTAINWALL
6" = 1'-0"

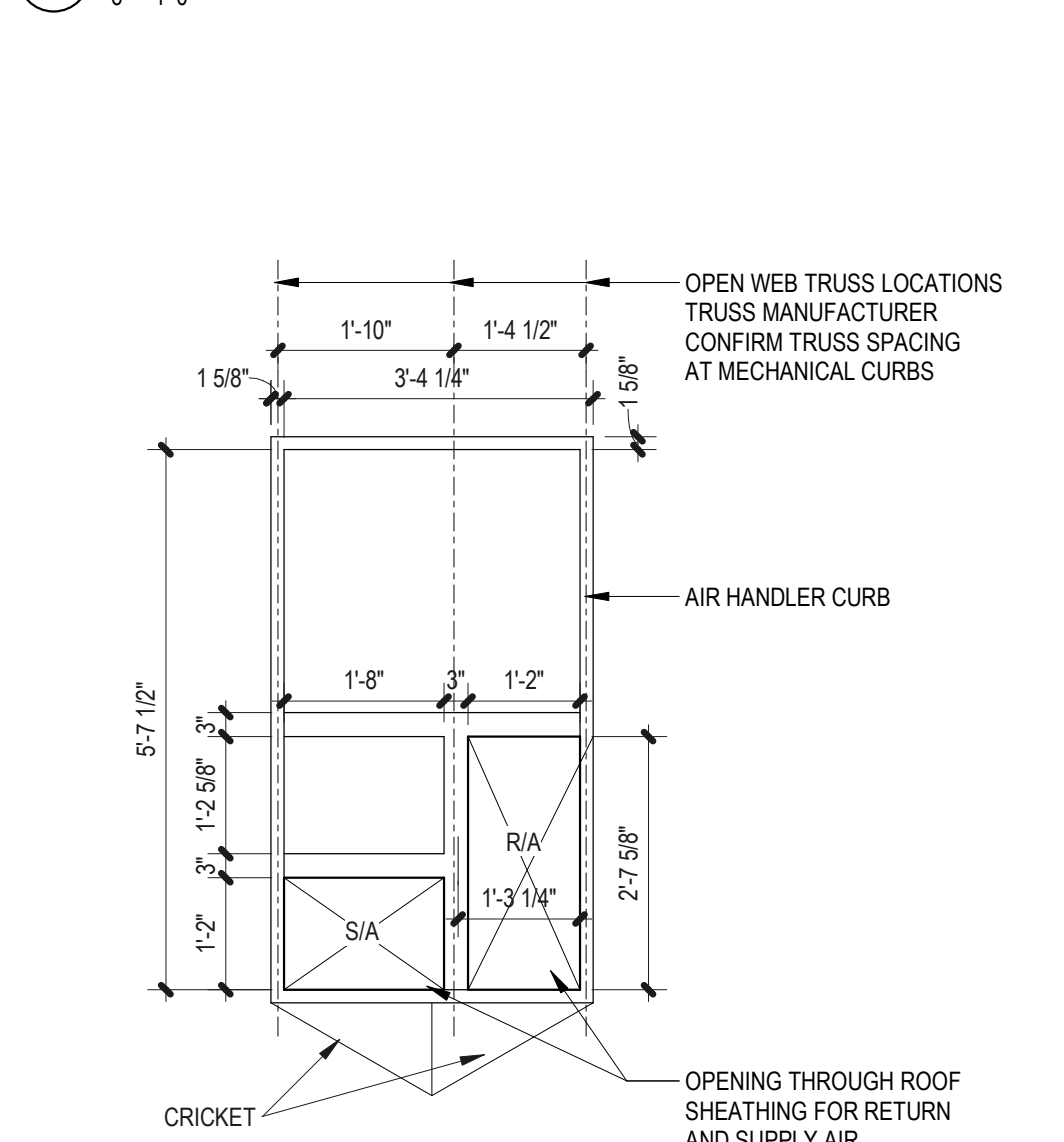

23 TYP RTU CURB
1/2" = 1'-0"

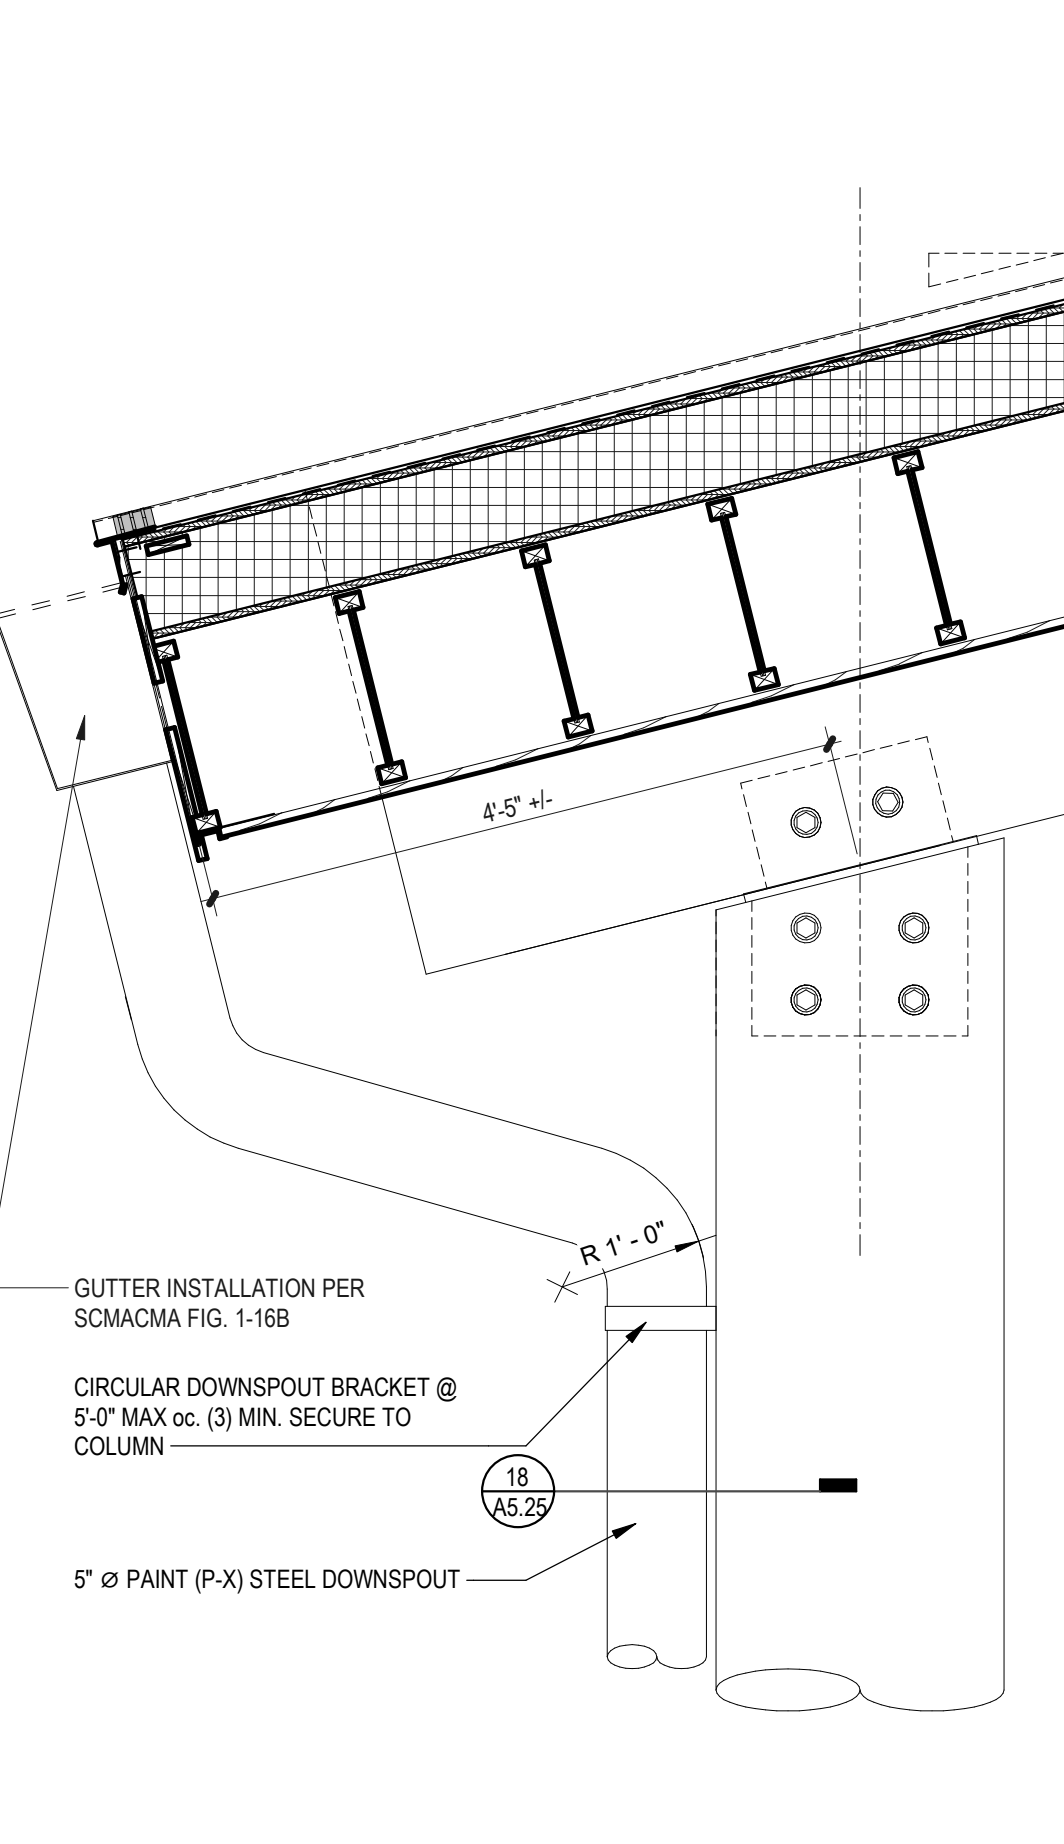

5 ROOF DOWNSPOUT
3/4" = 1'-0"

TULALIP TRIBES GATHERING HALL

7512 TOTEM BEACH RD
TULALIP, WA 98271

PHASE 2 - BUILDING AND LANDSCAPING


METAL ROOF AND SKYLIGHT FRAMING AND DETAILS

[illegible]

PROJECT INFORMATION	
PROJECT NUMBER:	17031
PROJECT LEAD:	DC
DRAWN BY:	RL

SHEET NO

A5.31

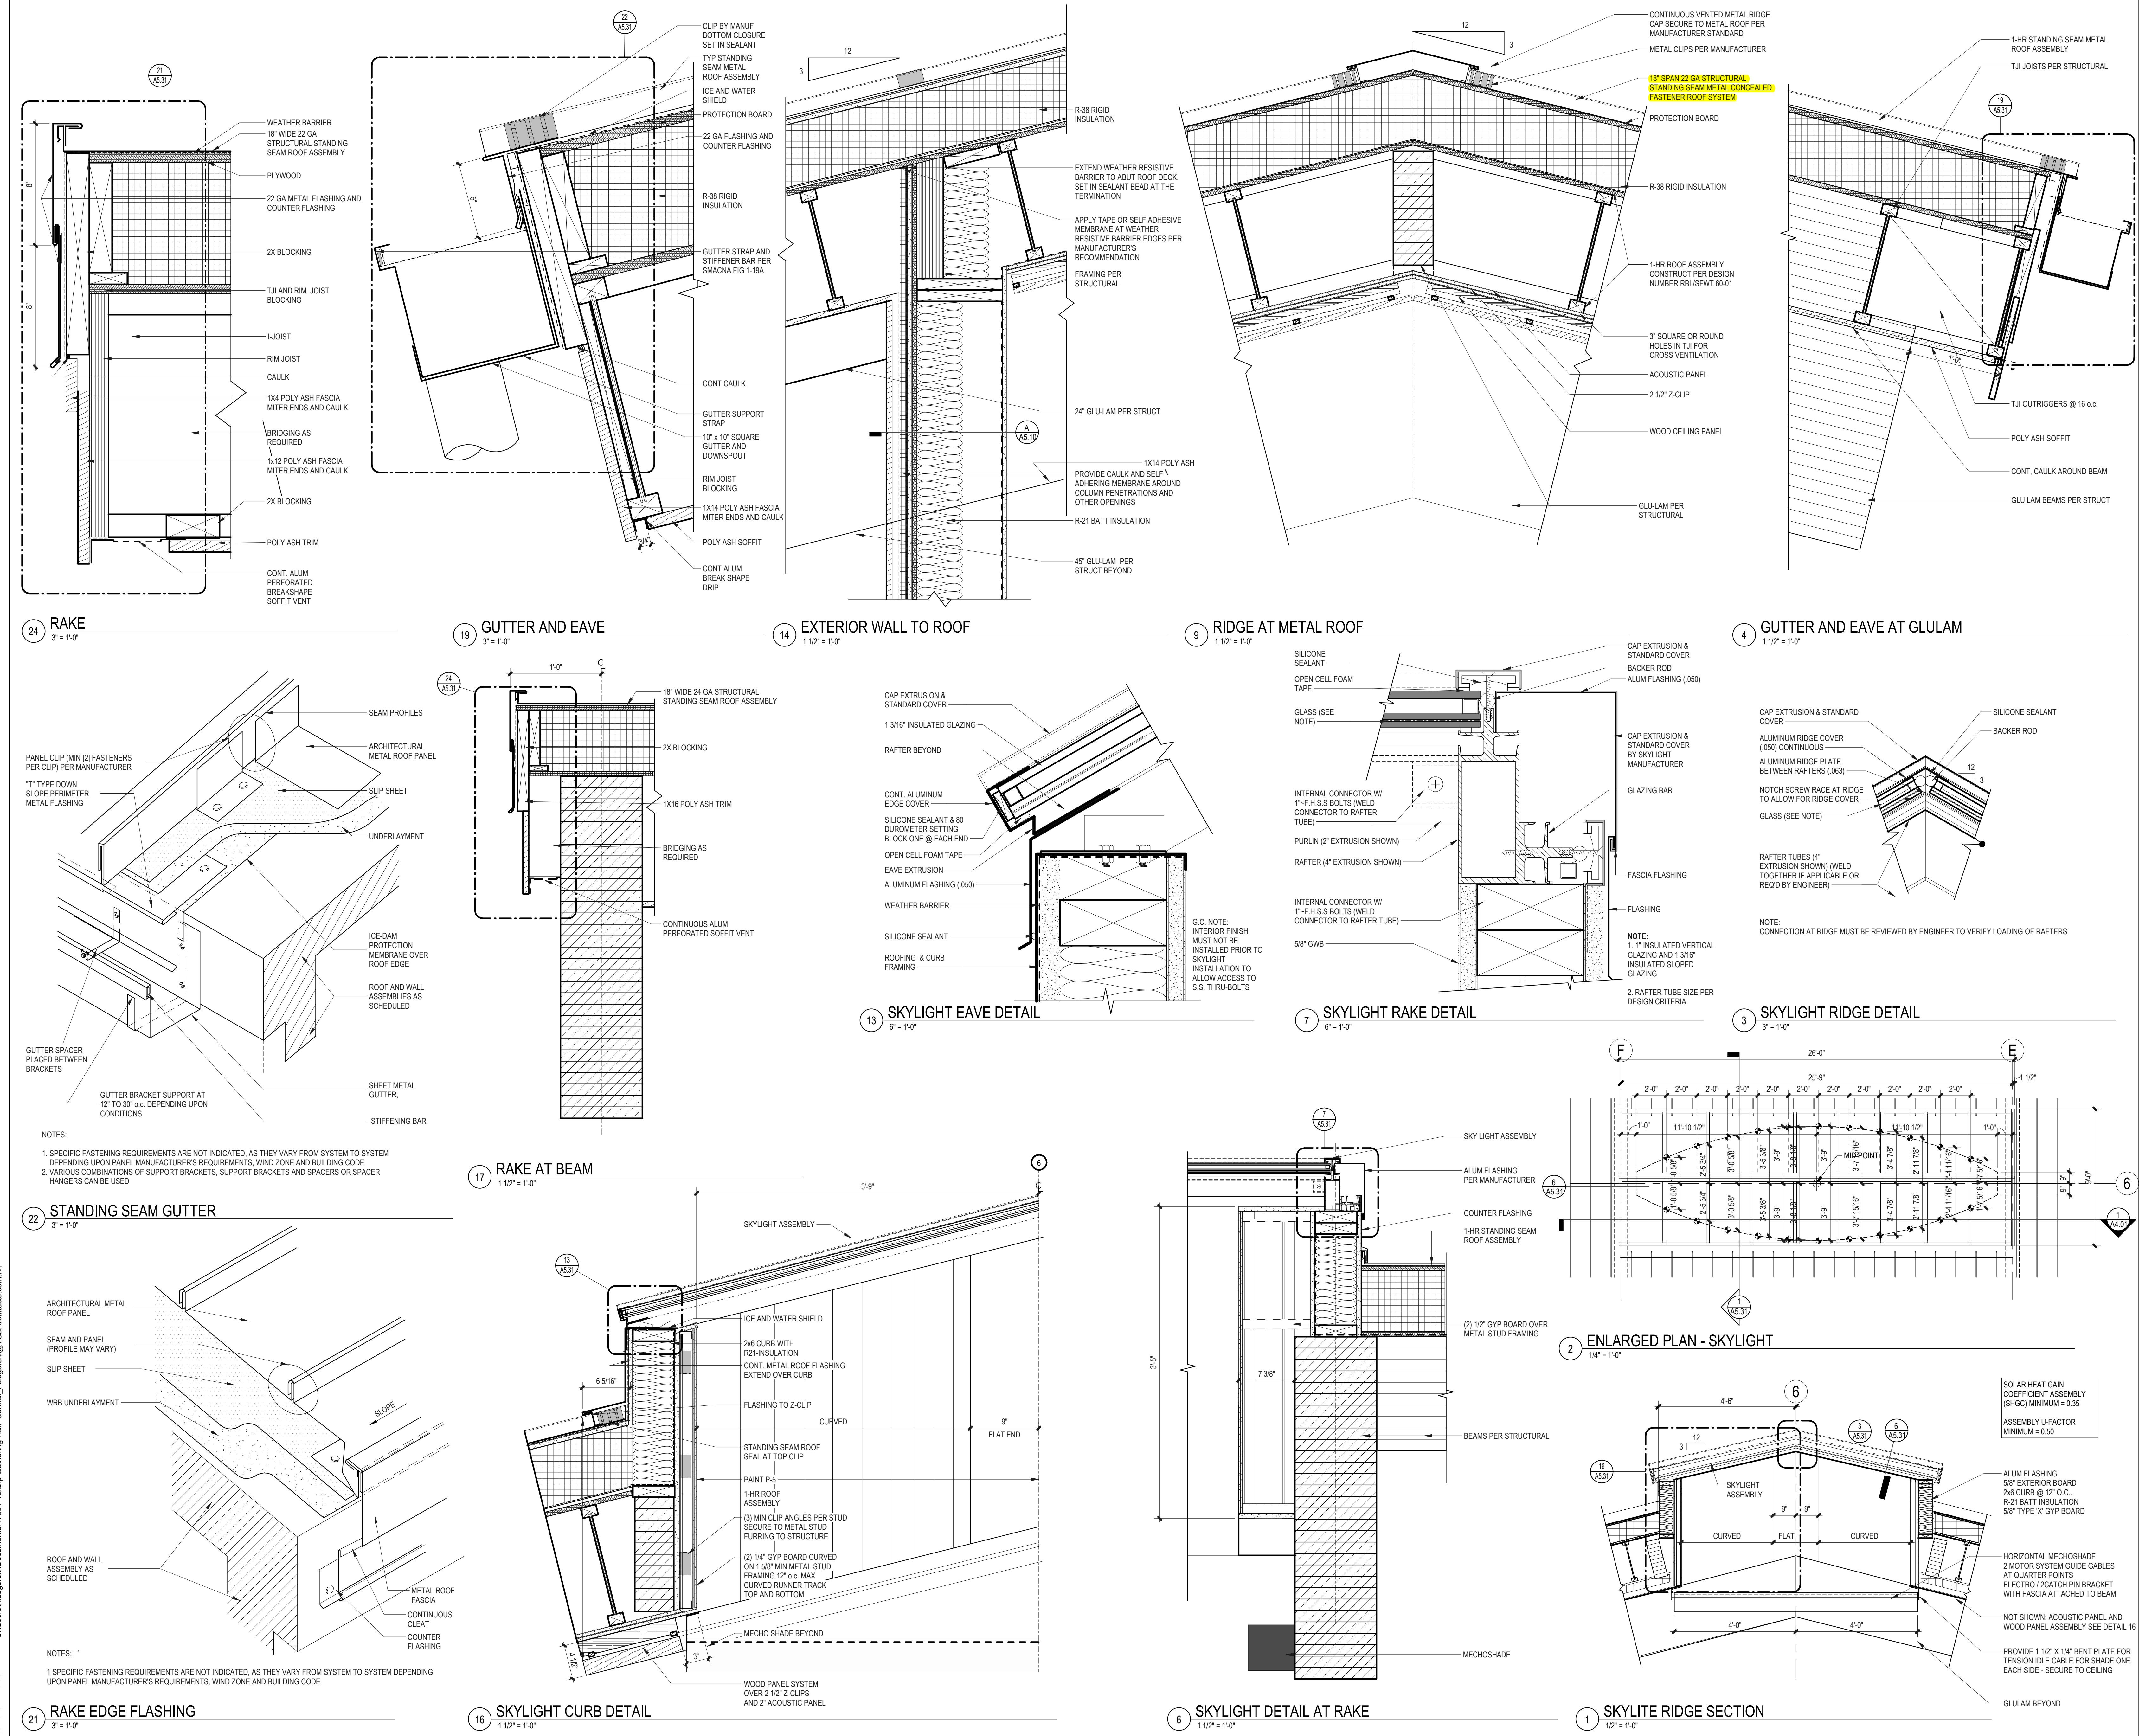

TULALIP TRIBES GATHERING HALL

7512 TOTEM BEACH RD
TULALIP, WA 98271

PHASE 2 - BUILDING AND LANDSCAPING


ELEVATOR AND STAIR DETAILS



[illegible]

PROJECT INFORMATION	
PROJECT NUMBER:	17031
PROJECT LEAD:	DC
DRAWN BY:	RL


SHEET NO

A5.40

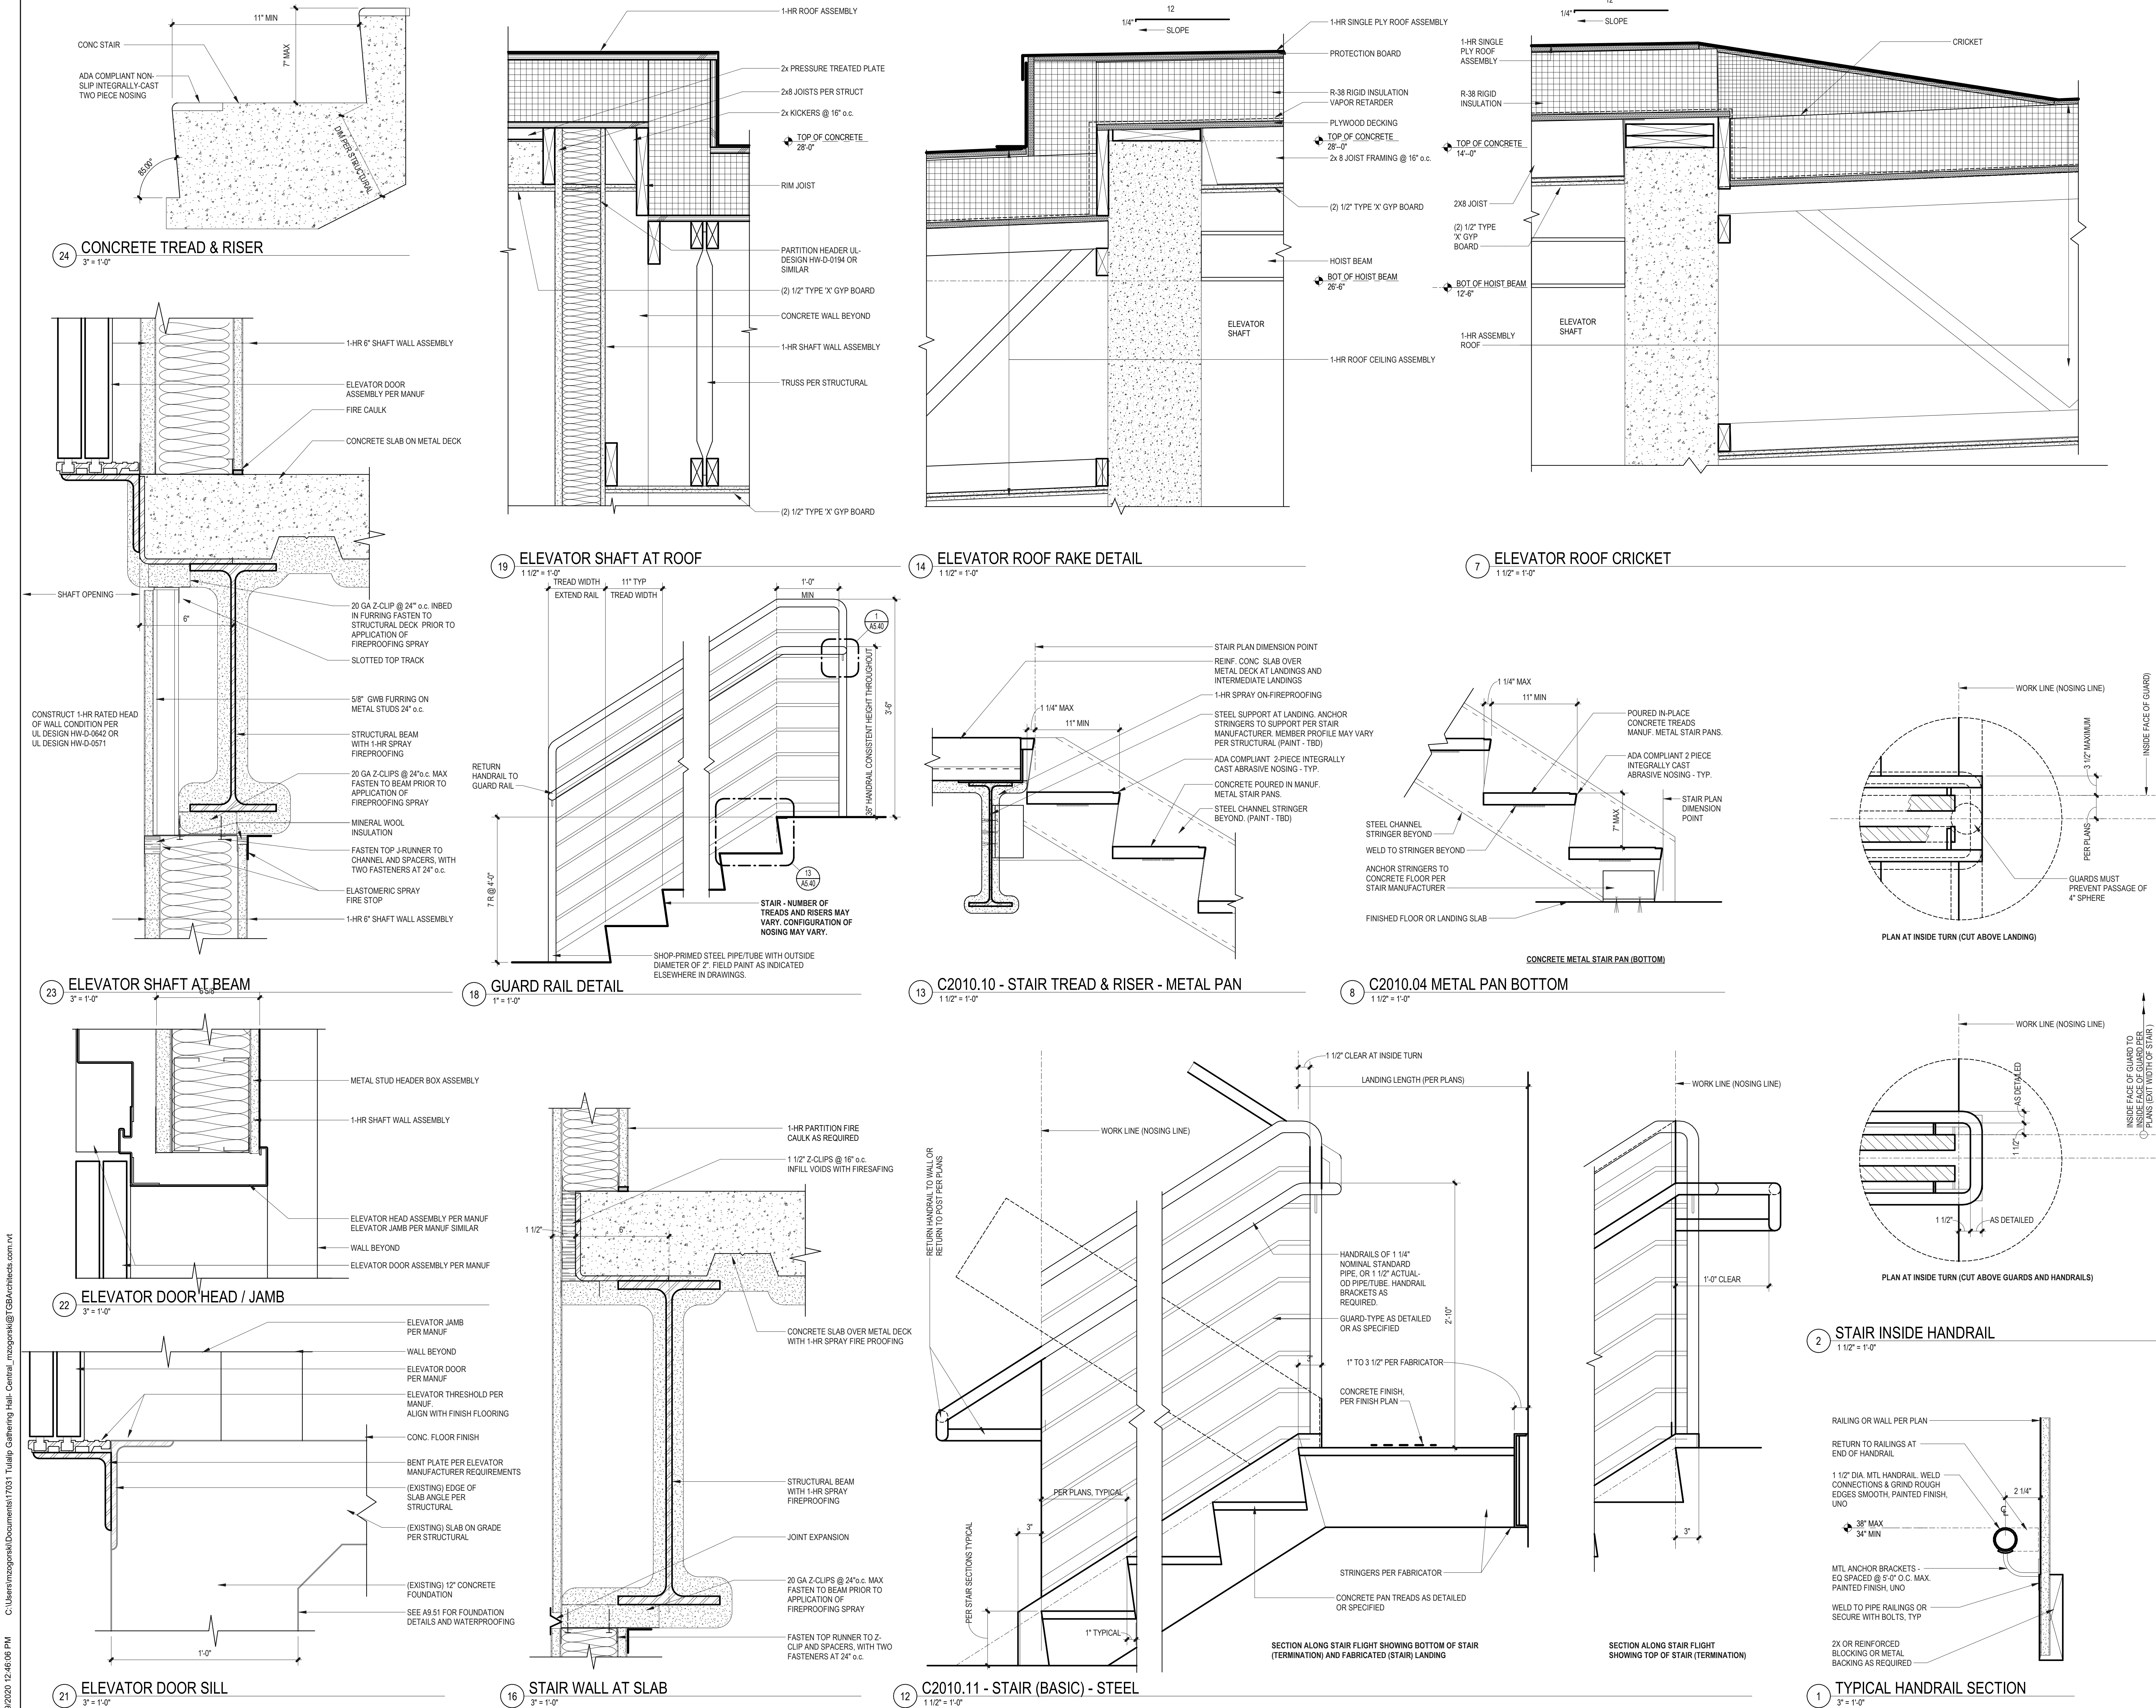

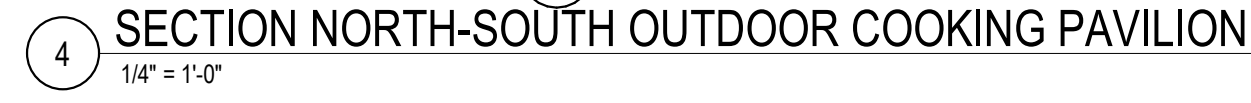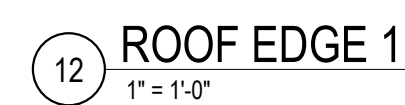




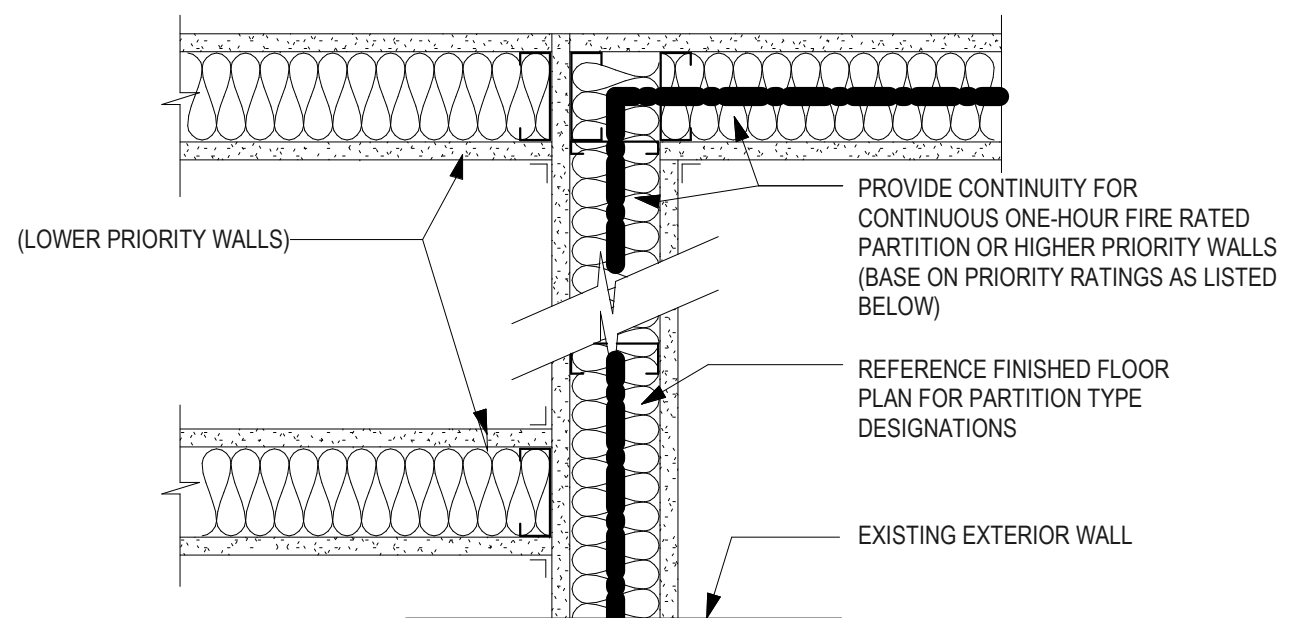


- WALL CONSTRUCTION SEQUENCE LEGEND**
- TWO HOUR FIRE AND SMOKE WALL
TWO HOUR FIRE WALL
TWO HOUR SHAFT WALL
ONE HOUR FIRE AND SMOKE WALL
ONE HOUR FIRE WALL
SMOKE TIGHT PARTITION
NON-RATED PARTITIONS
- GENERAL NOTES**
1. SCHEDULE CONSTRUCTION OF WALLS ACCORDING TO PRIORITY.
2. ALL PRIORITY 1 THRU 4 WALLS SHOULD BE FRAMES WITH ONE SIDE DRYWALLED AT THE 40% AHCA CONSTRUCTION SURVEY.
3. BOTH SIDES OF PRIORITY 1 THRU 4 WALLS SHALL BE SEALED AND STICKED AT THE 80% AHCA CONSTRUCTION SURVEY.
4. REFER TO FLOOR PLAN AND PROJECT MANUAL FOR ANY SPECIFIC LEAD LINING REQUIREMENTS, (IF ANY).


25 FIRE PENETRATION DETAIL 6
12" x 1'-0"

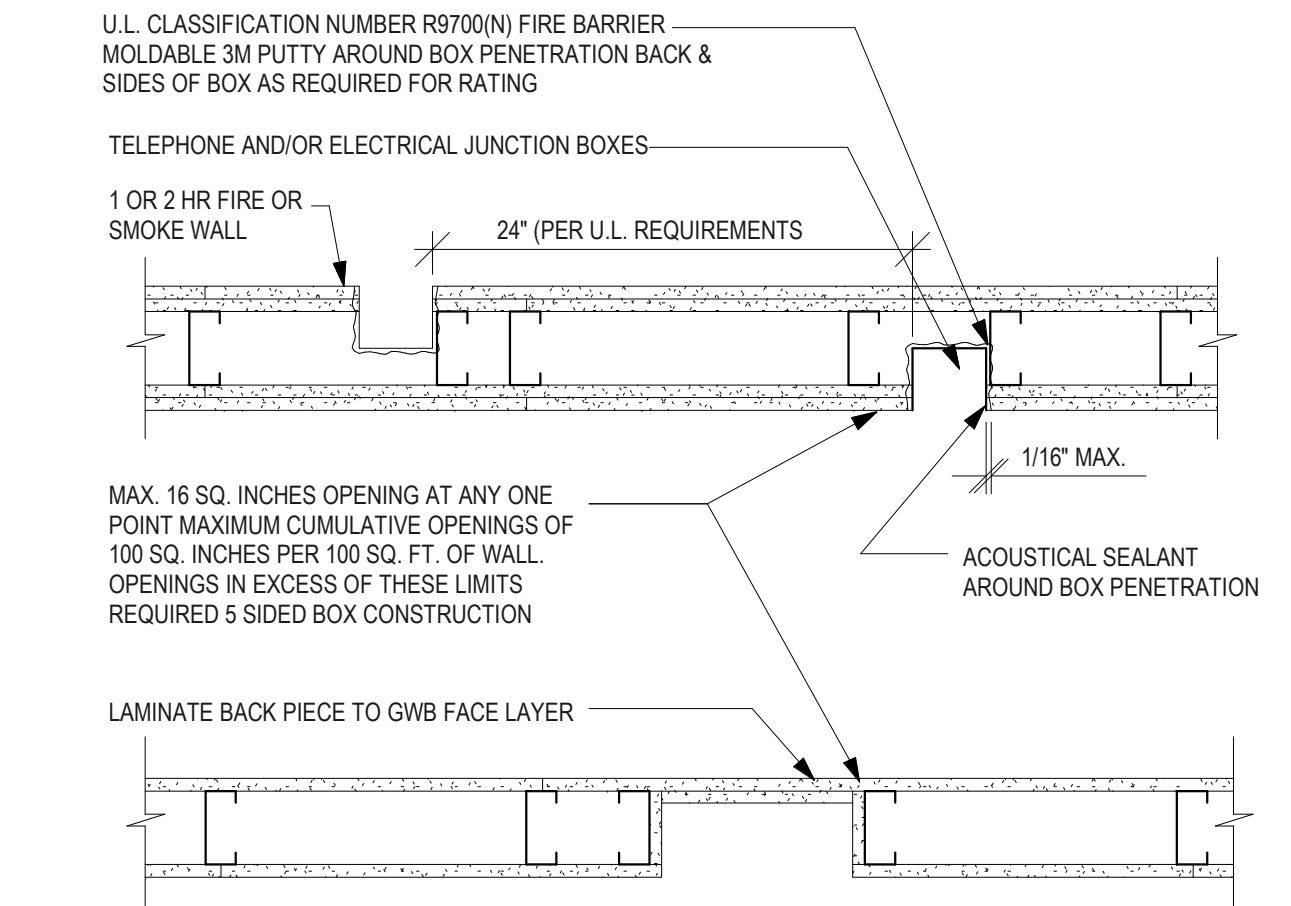


24 FIRE PENETRATION DETAIL 7
12" x 1'-0"

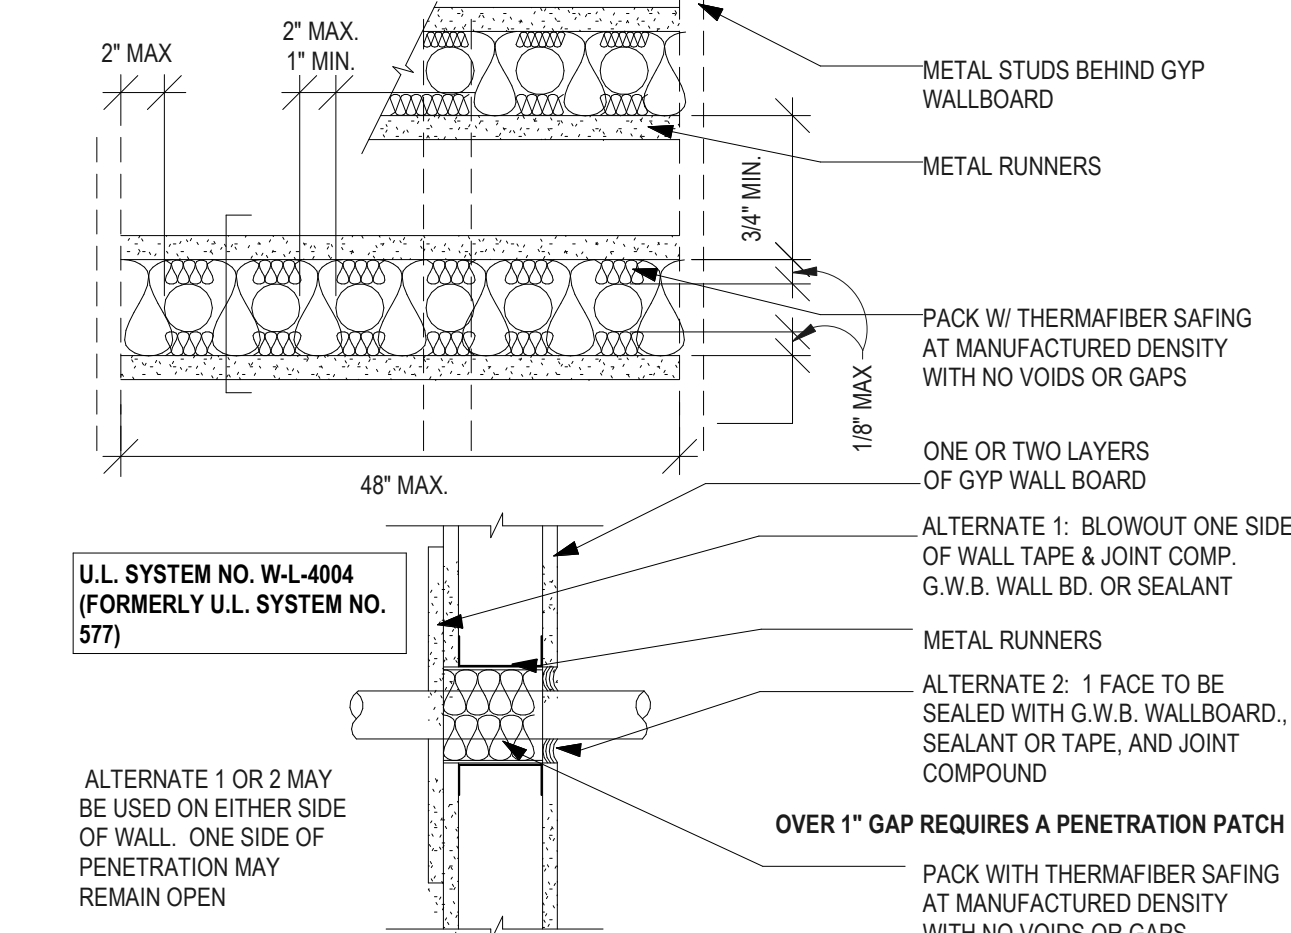


23 FIRE PENETRATION DETAIL 4
12" x 1'-0"

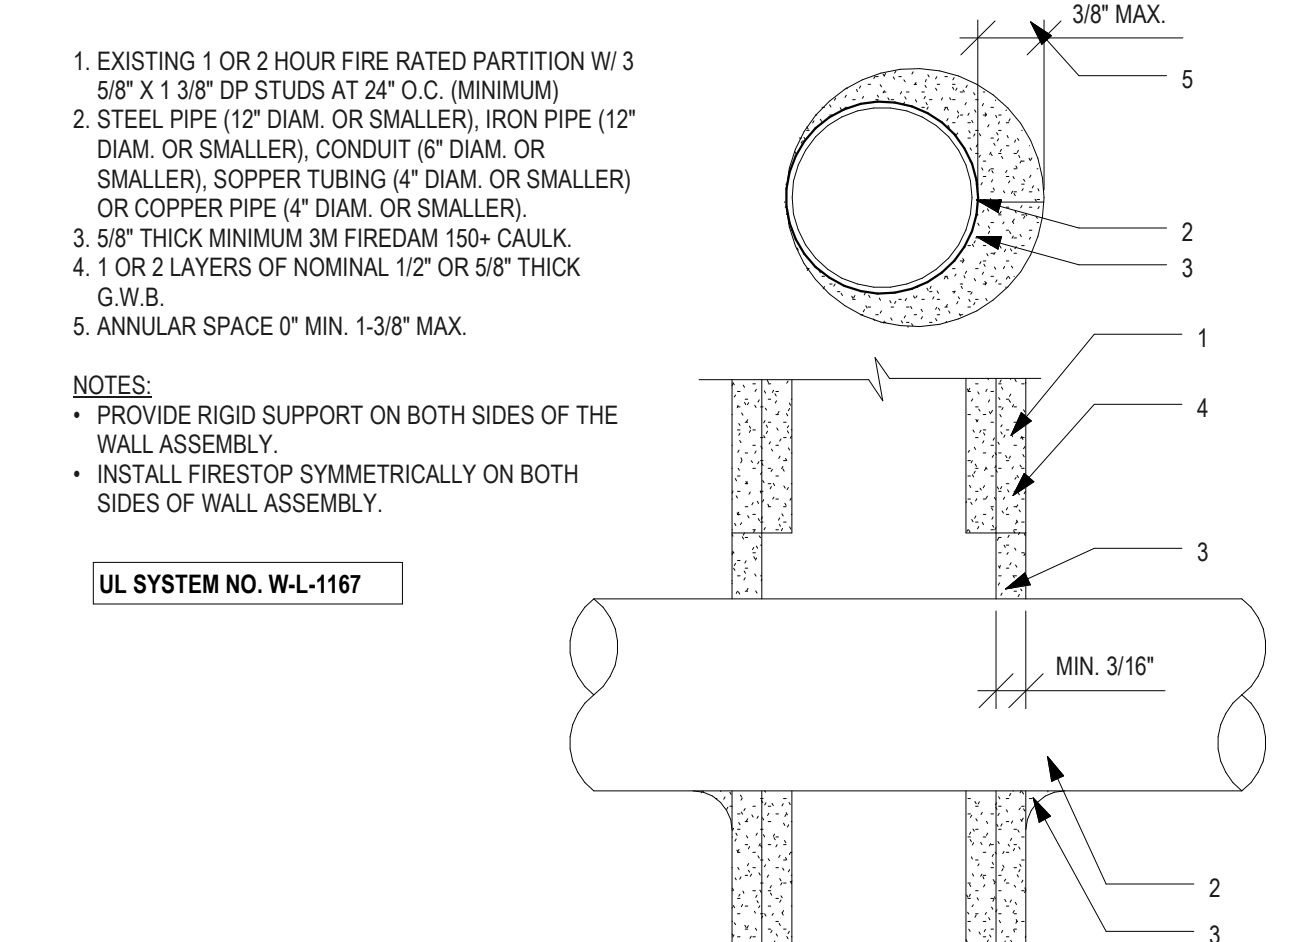


22 FIRE PENETRATION DETAIL 12
12" x 1'-0"

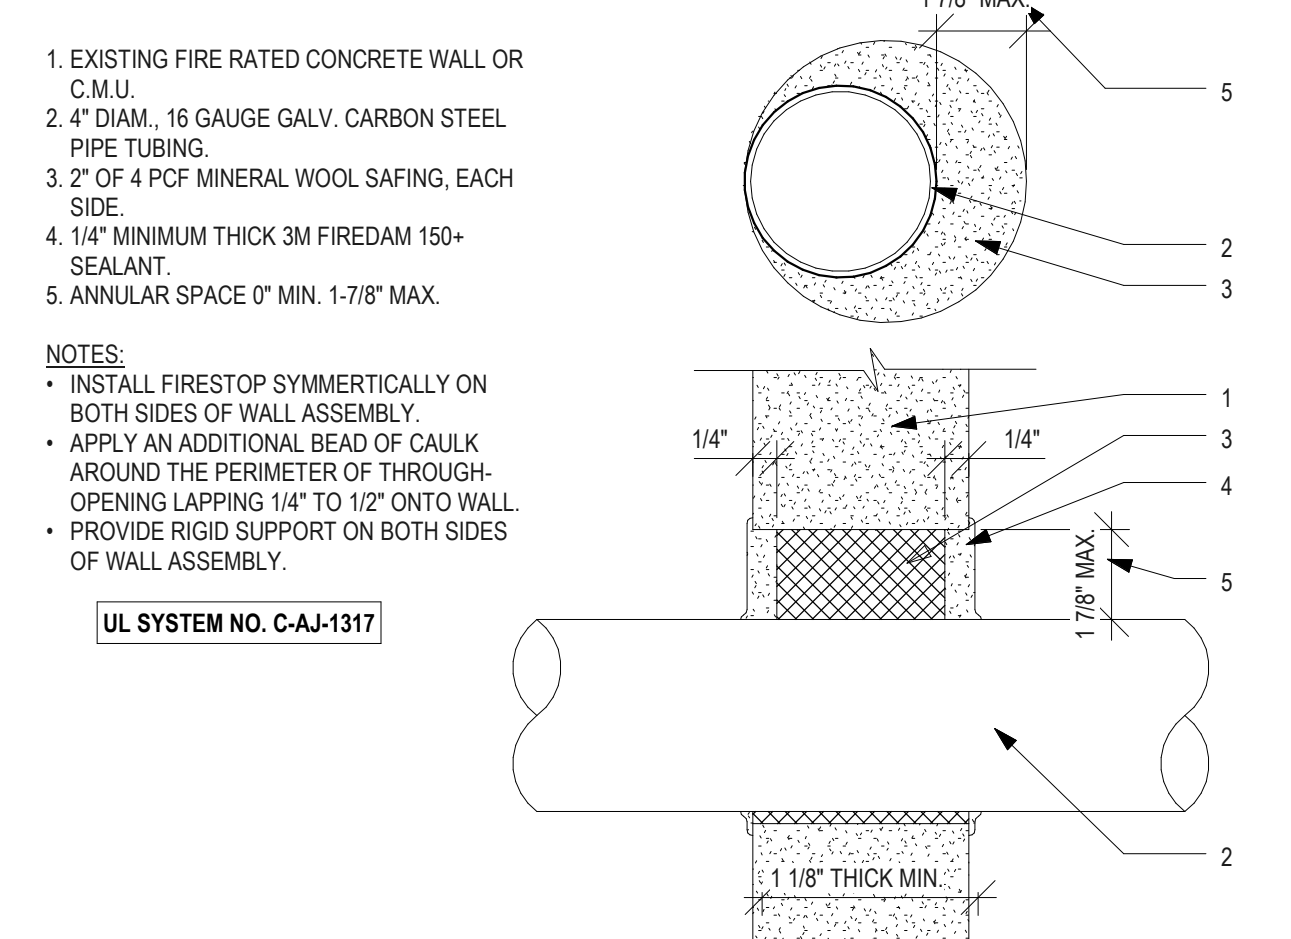


21 FIRE PENETRATION DETAIL 13
12" x 1'-0"

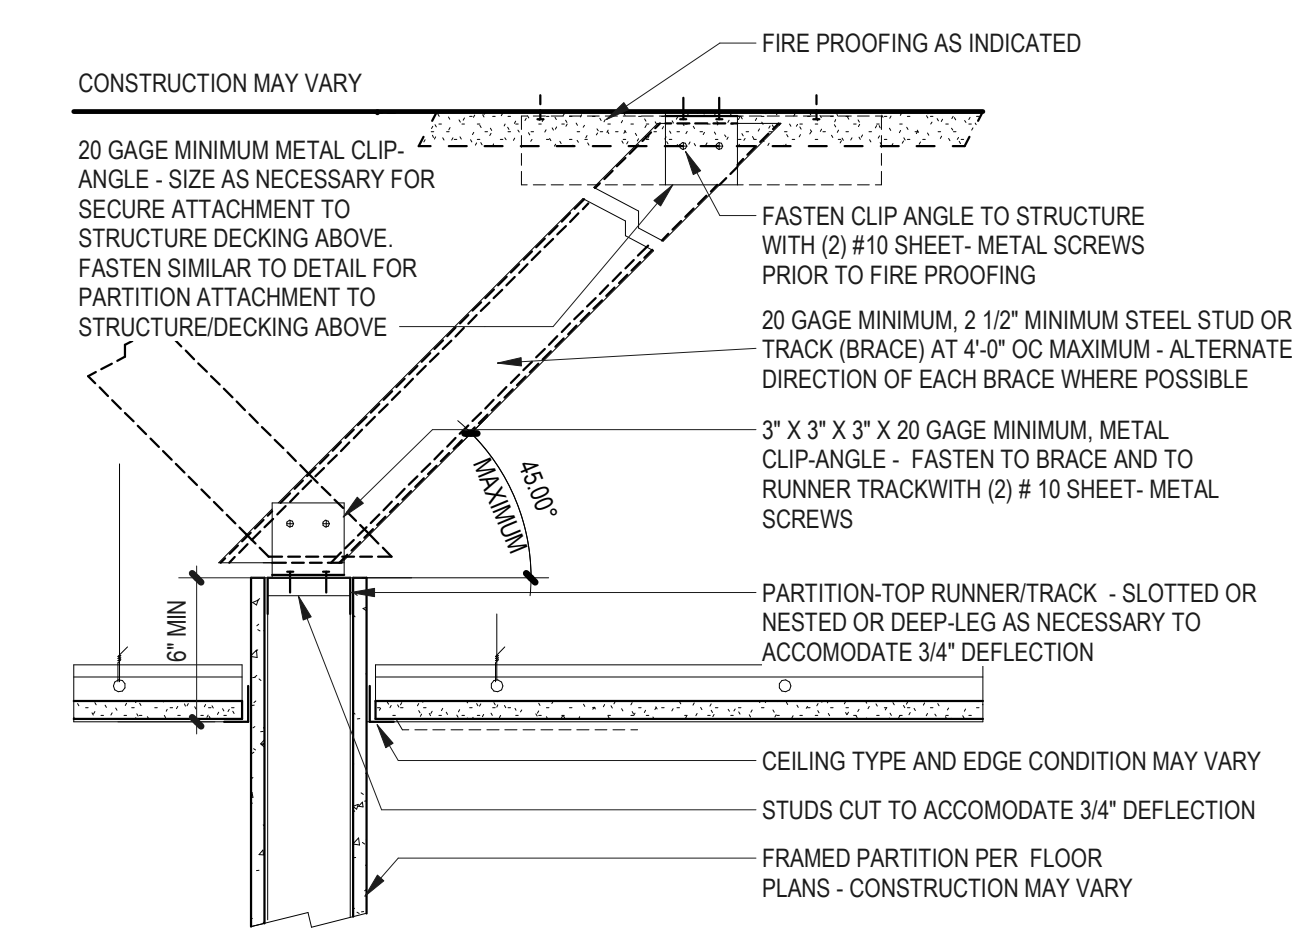


20 C1010.115 PARTITION TOP - BRACED 6" ABOVE CEILING
1 1/2" x 1'-0"

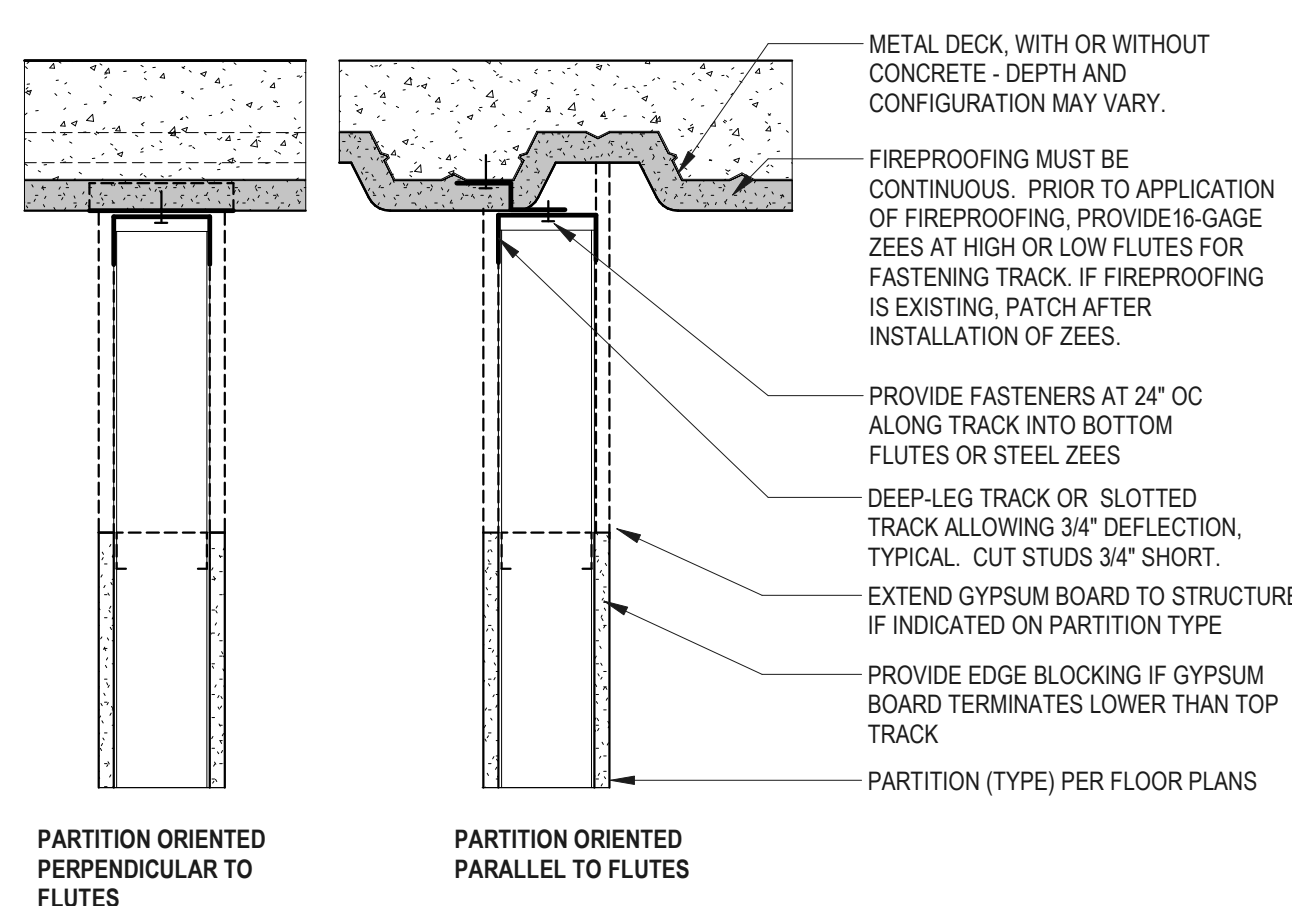

19 C1010.111 UNRATED PTN-HEAD AT FP COMPOSITE SLAB
1 1/2" x 1'-0"

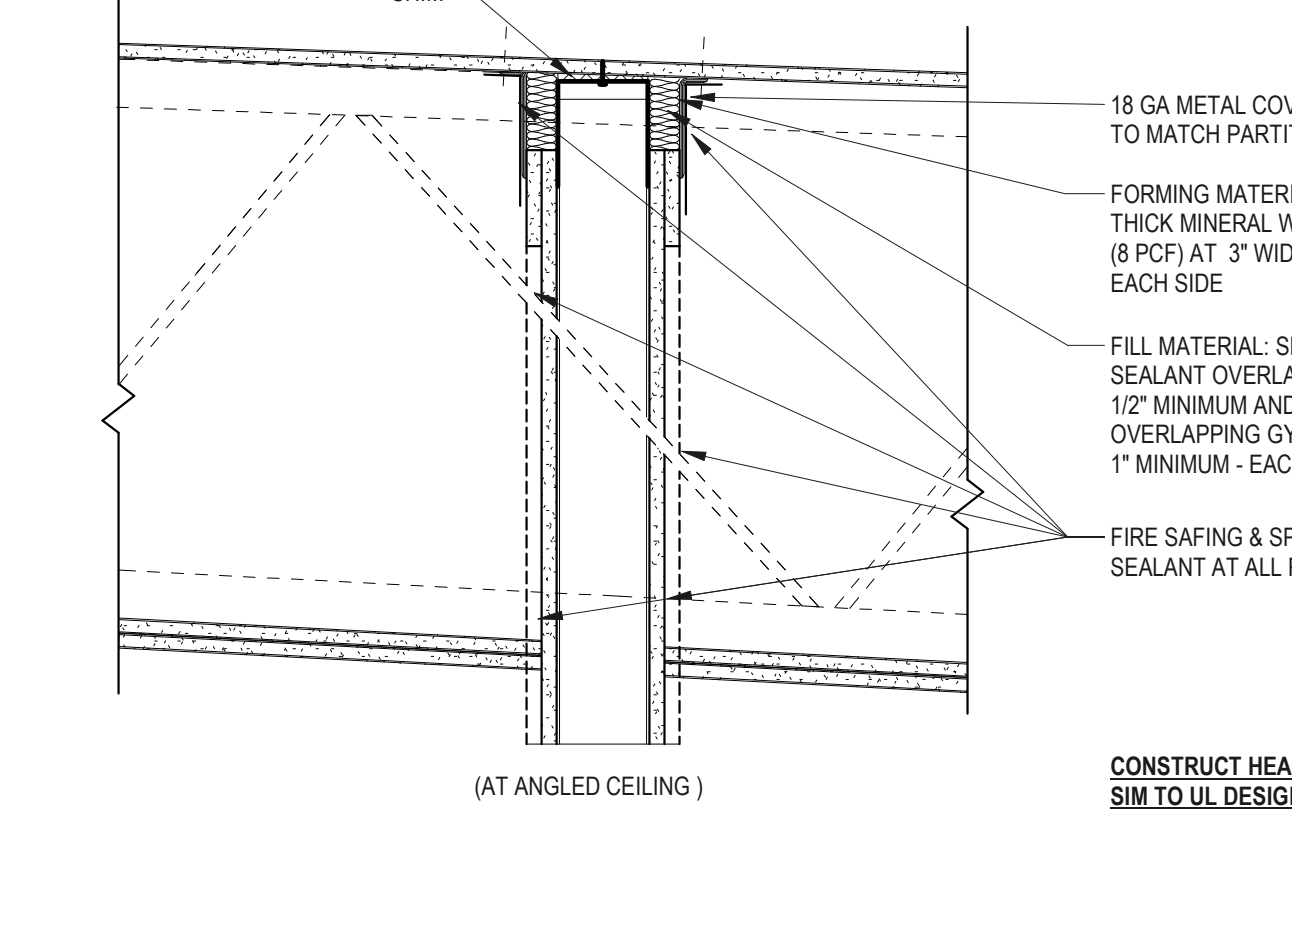


18 FIRE BARRIER AT ROOF DECK - PERPENDICULAR
1 1/2" x 1'-0"

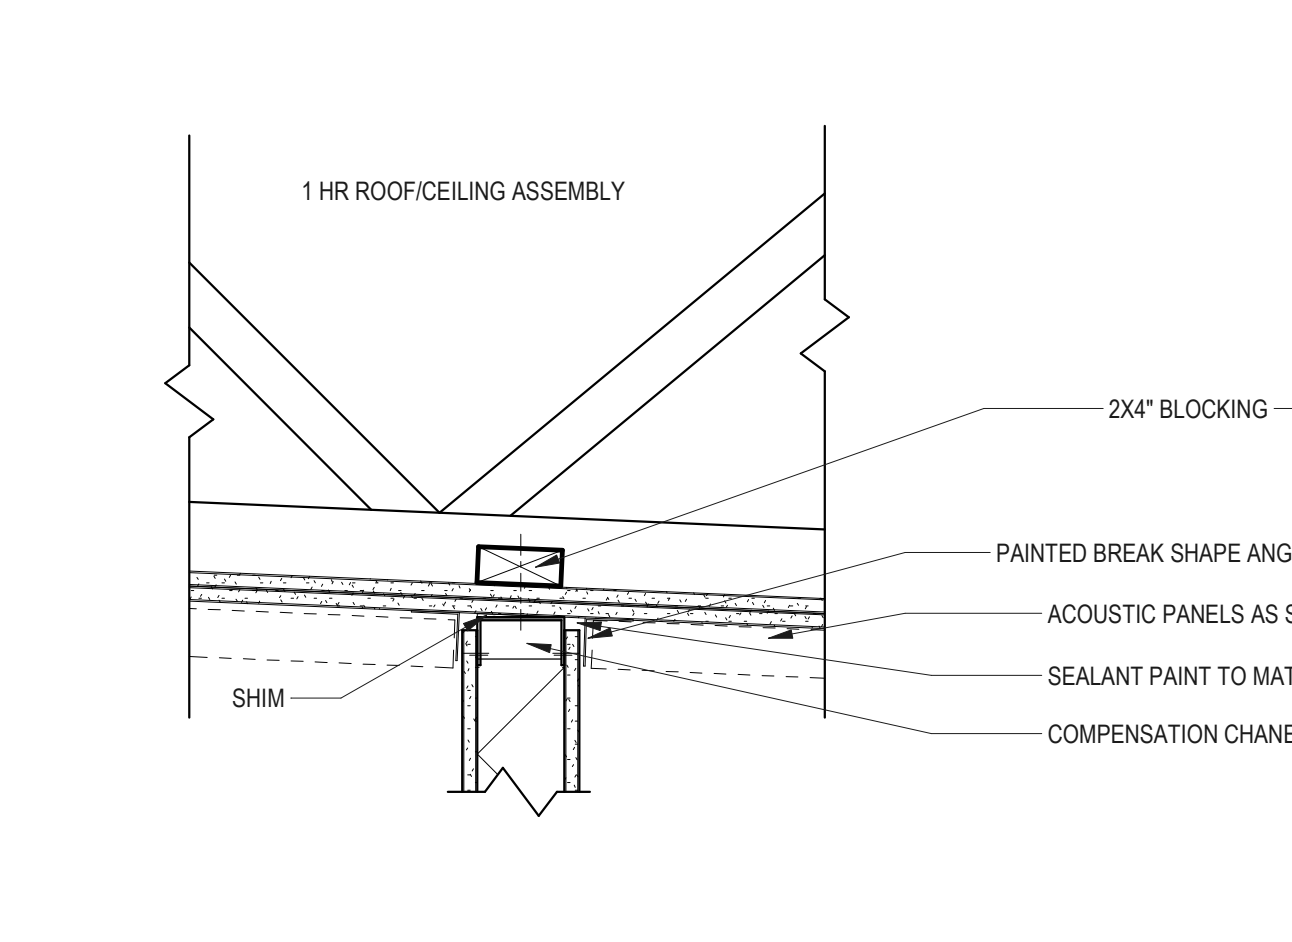


17 NON RATED HEAD CONNECTION AT RATED CLG PERP
1 1/2" x 1'-0"



 
16 NON RATED HEAD CONNECTION AT RATED CLG PARALLEL
1 1/2" x 1'-0"




14 C1010.116 PTN-HEAD (FIRE-RATED) AT STRUCTURE ABOVE
1 1/2" x 1'-0"

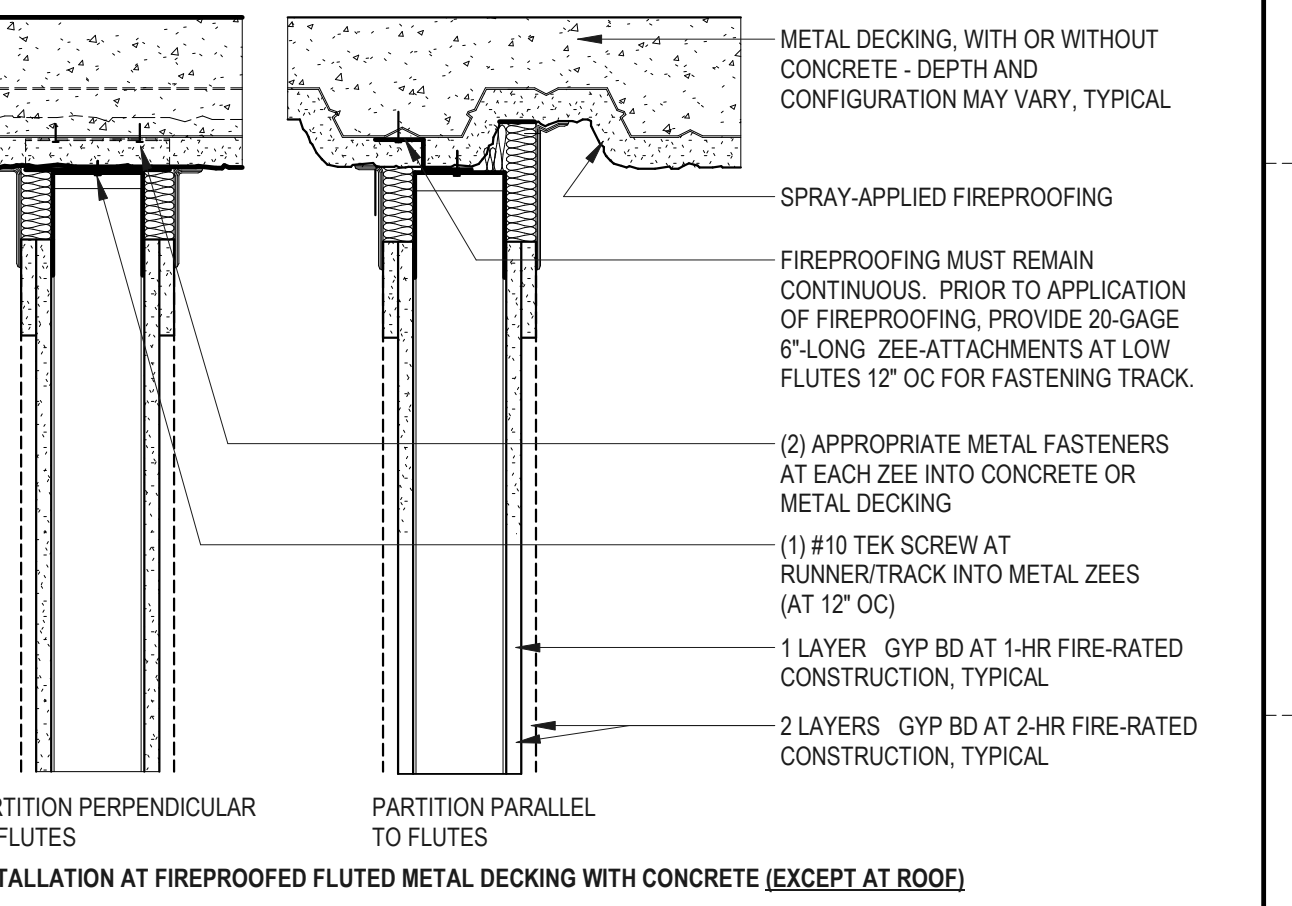

13 FIRE BARRIER AT ROOF DECK - PARALLEL
1 1/2" x 1'-0"

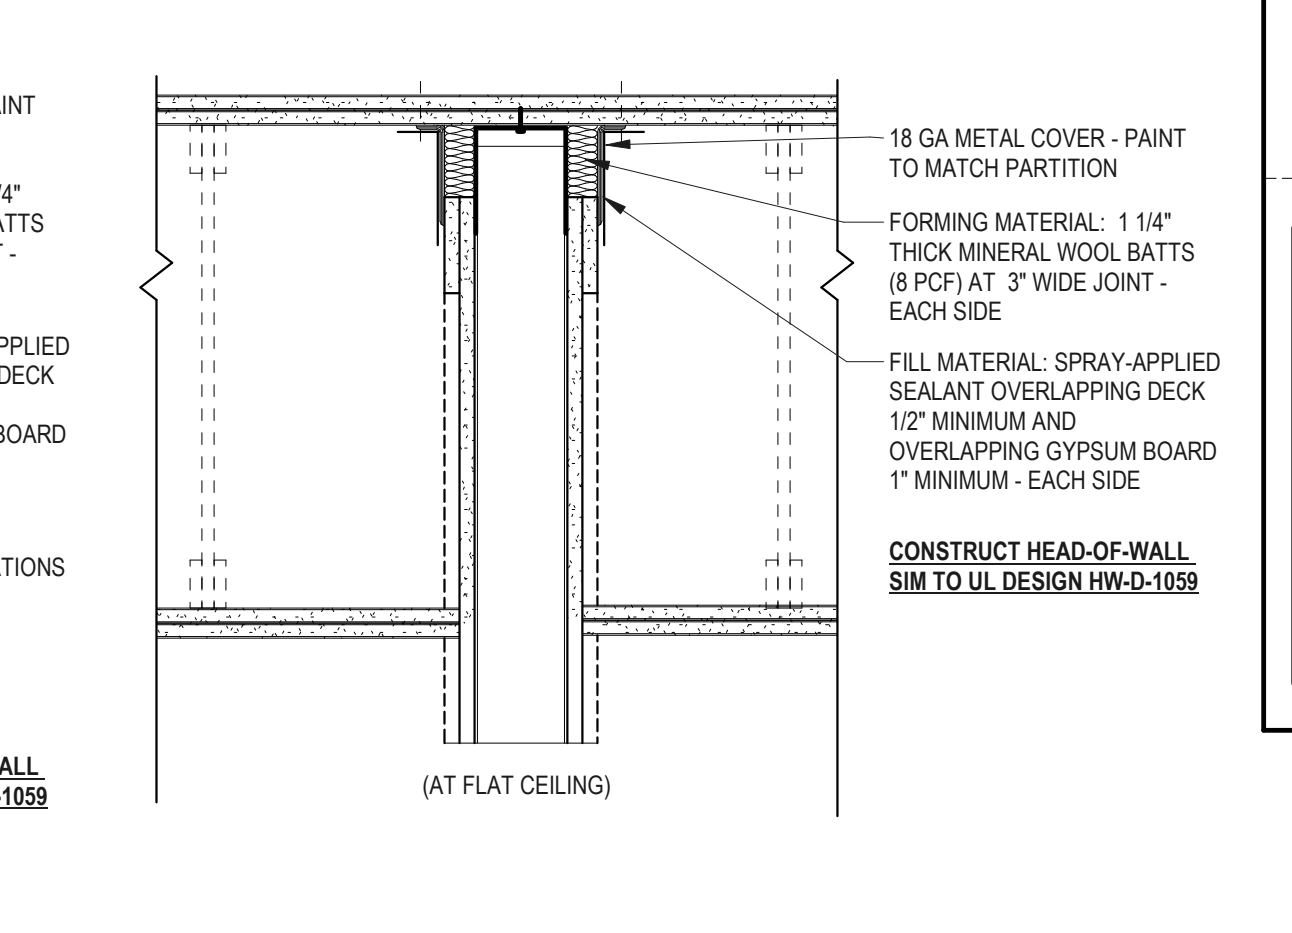

12 NON RATED HEAD CONNECTION AT RATED CLG PARALLEL
1 1/2" x 1'-0"


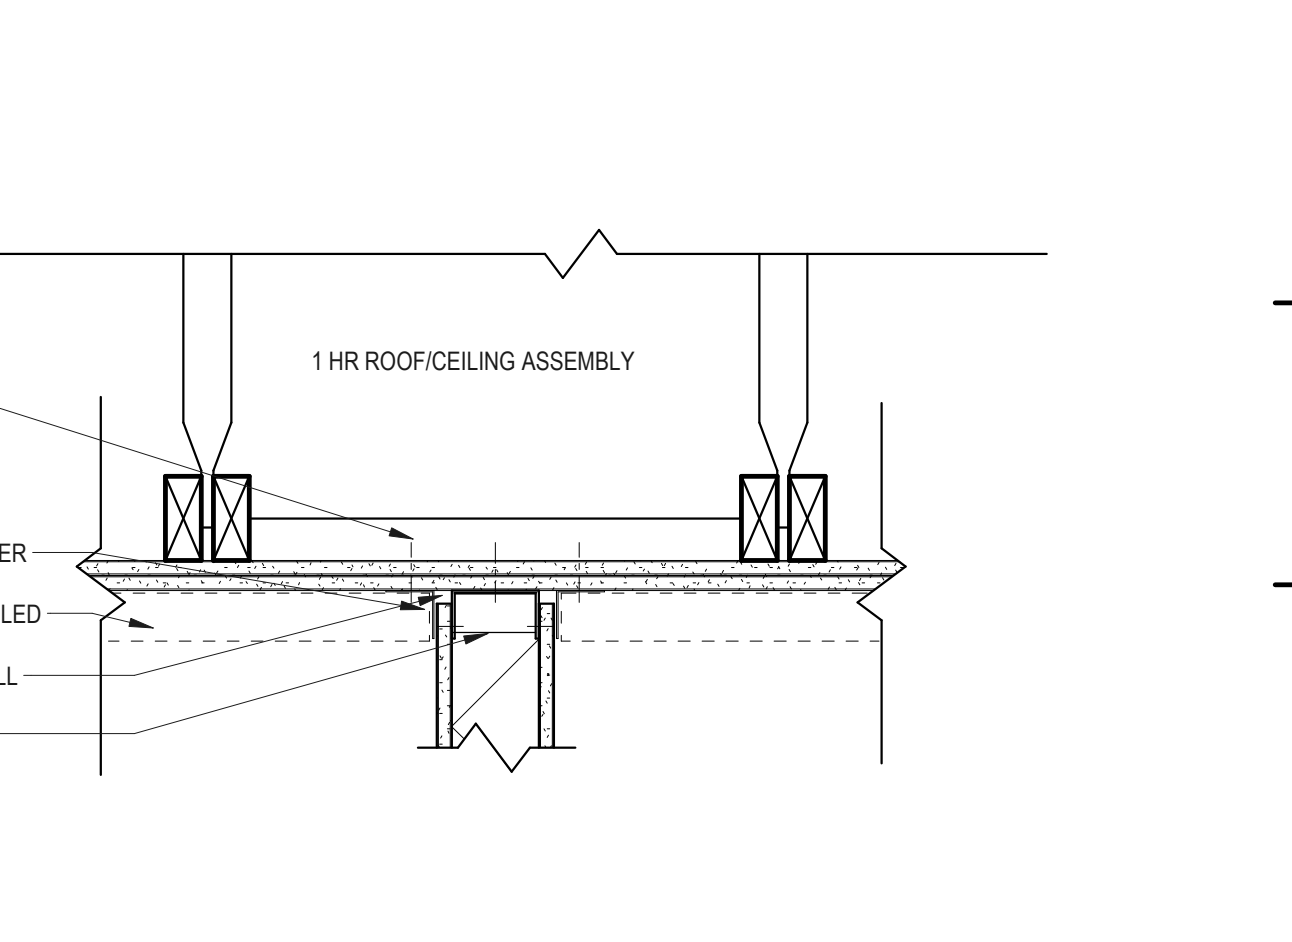


11 FIRE DAMPER DETAIL
1 1/2" x 1'-0"




10 C1010.120 BACKING PLATE TYPE 'A'
1 1/2" x 1'-0"

PARTITION-TYPES

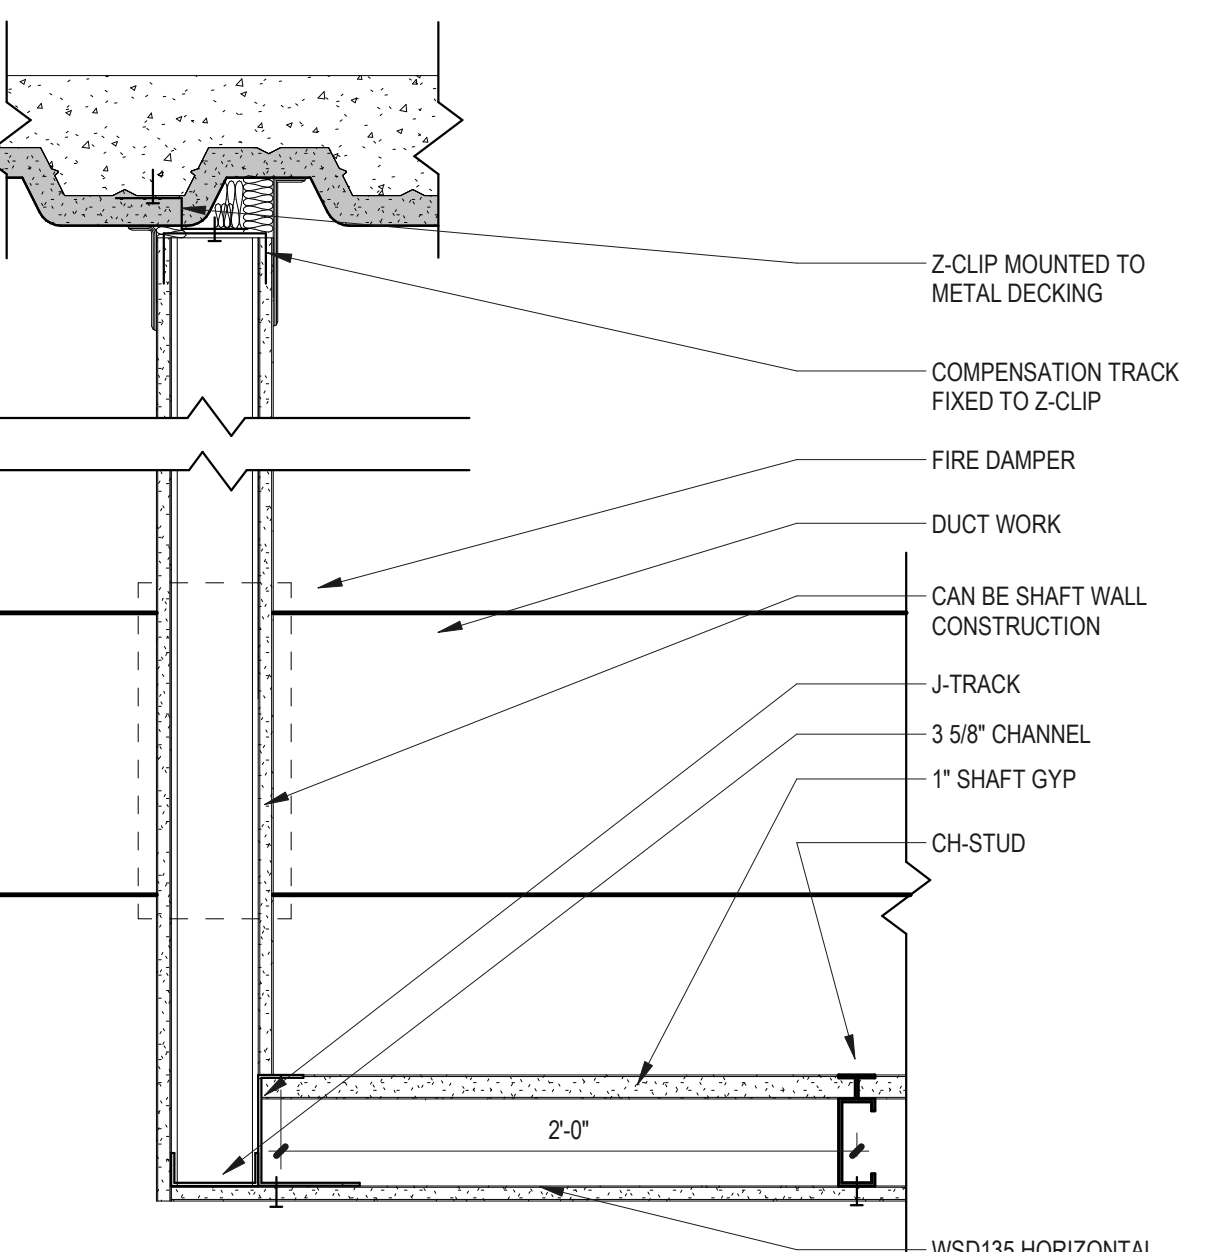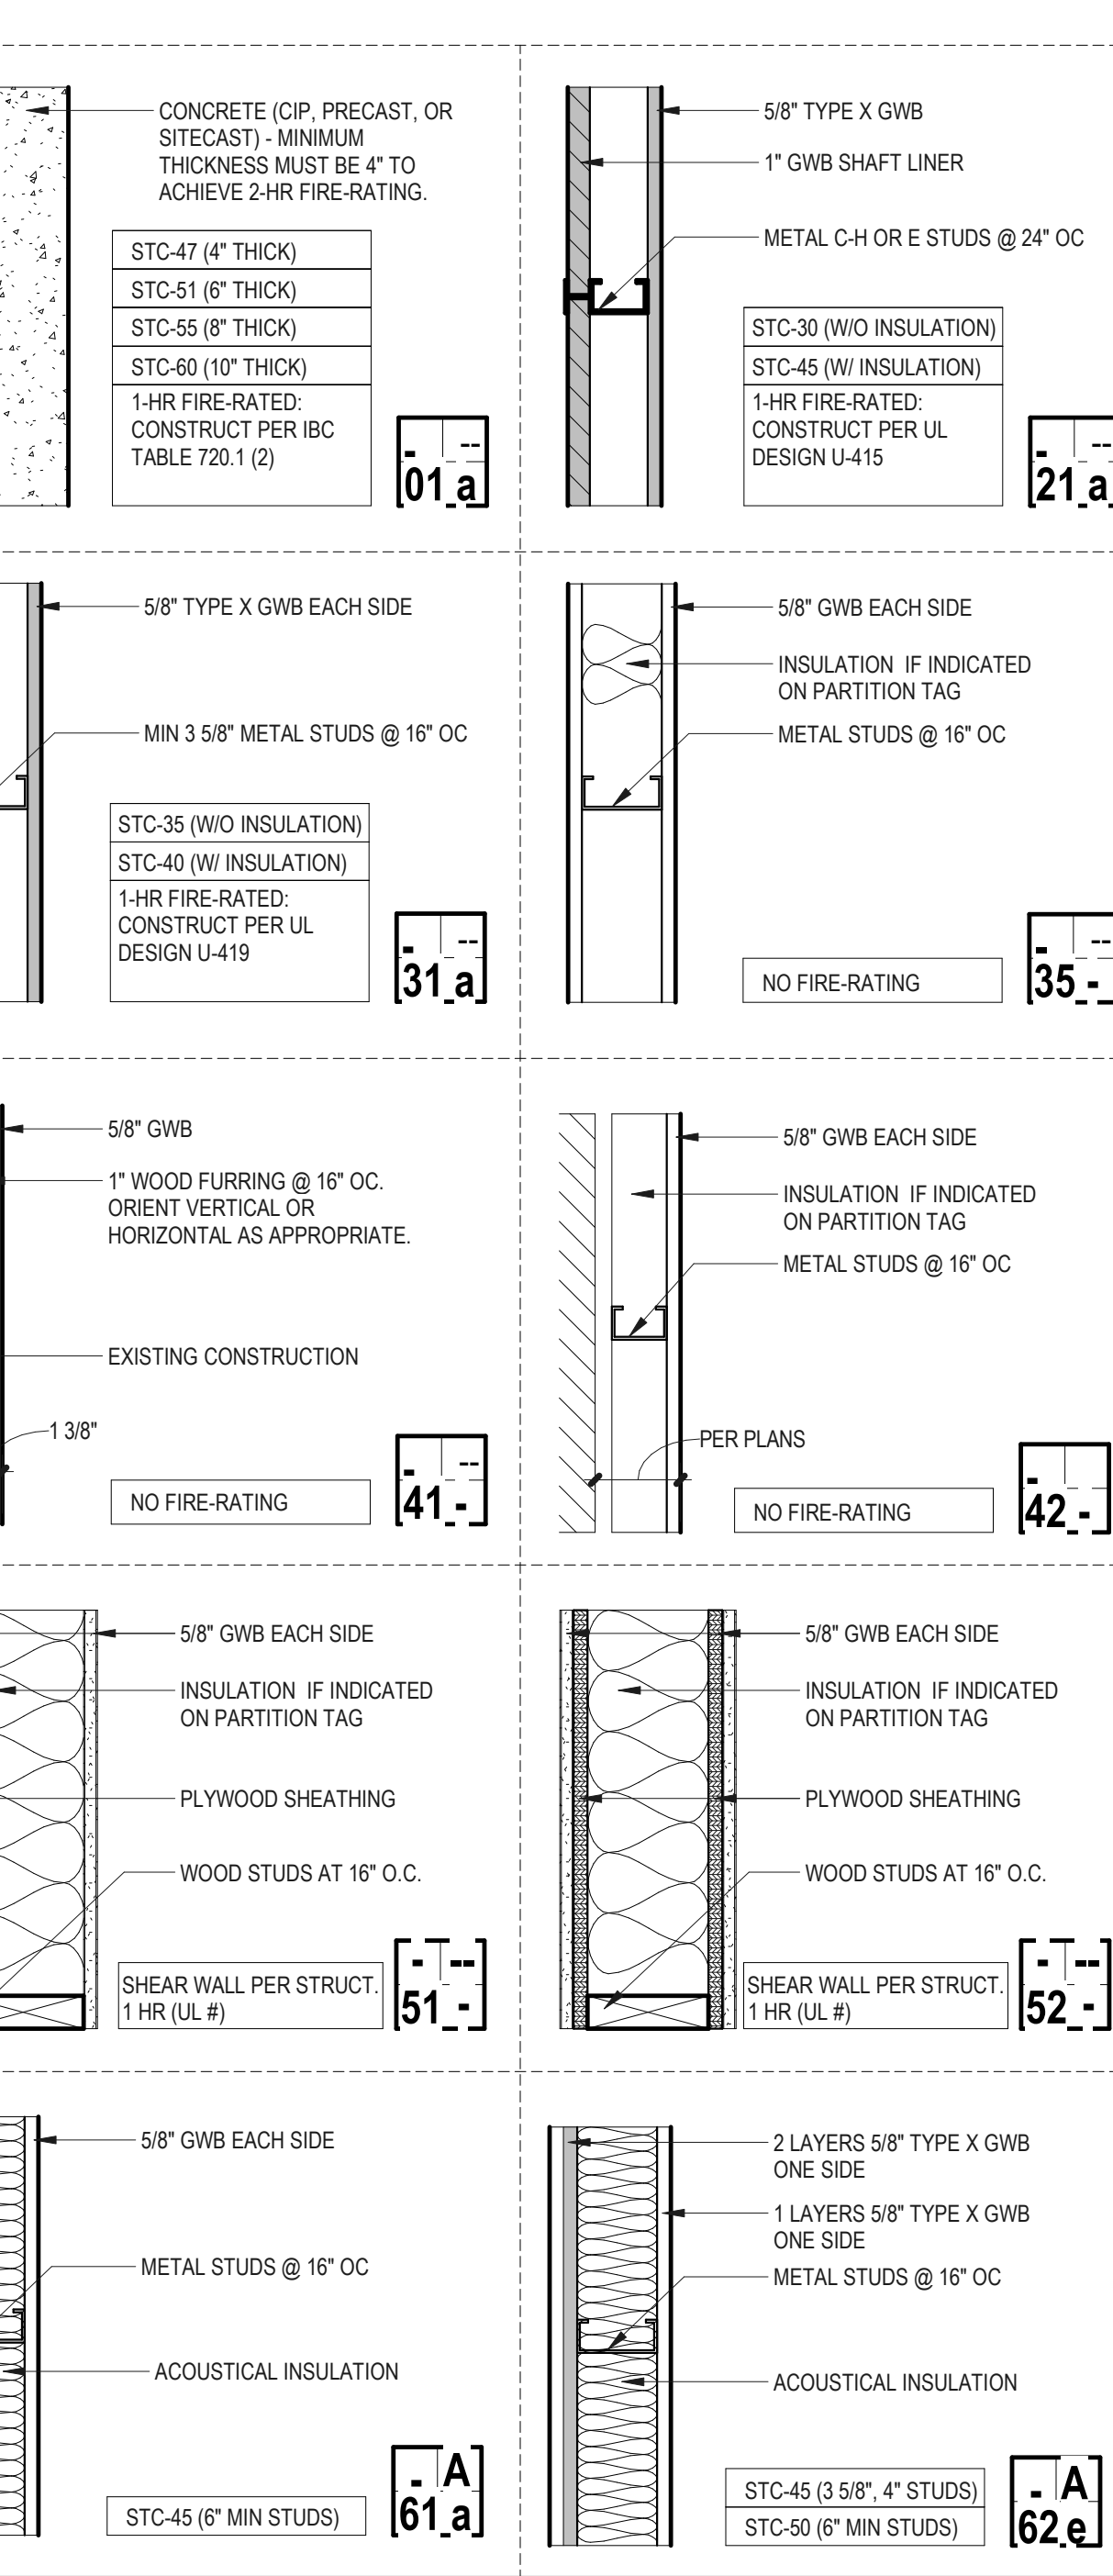


7 FIRE DAMPER DETAIL
1 1/2" x 1'-0"

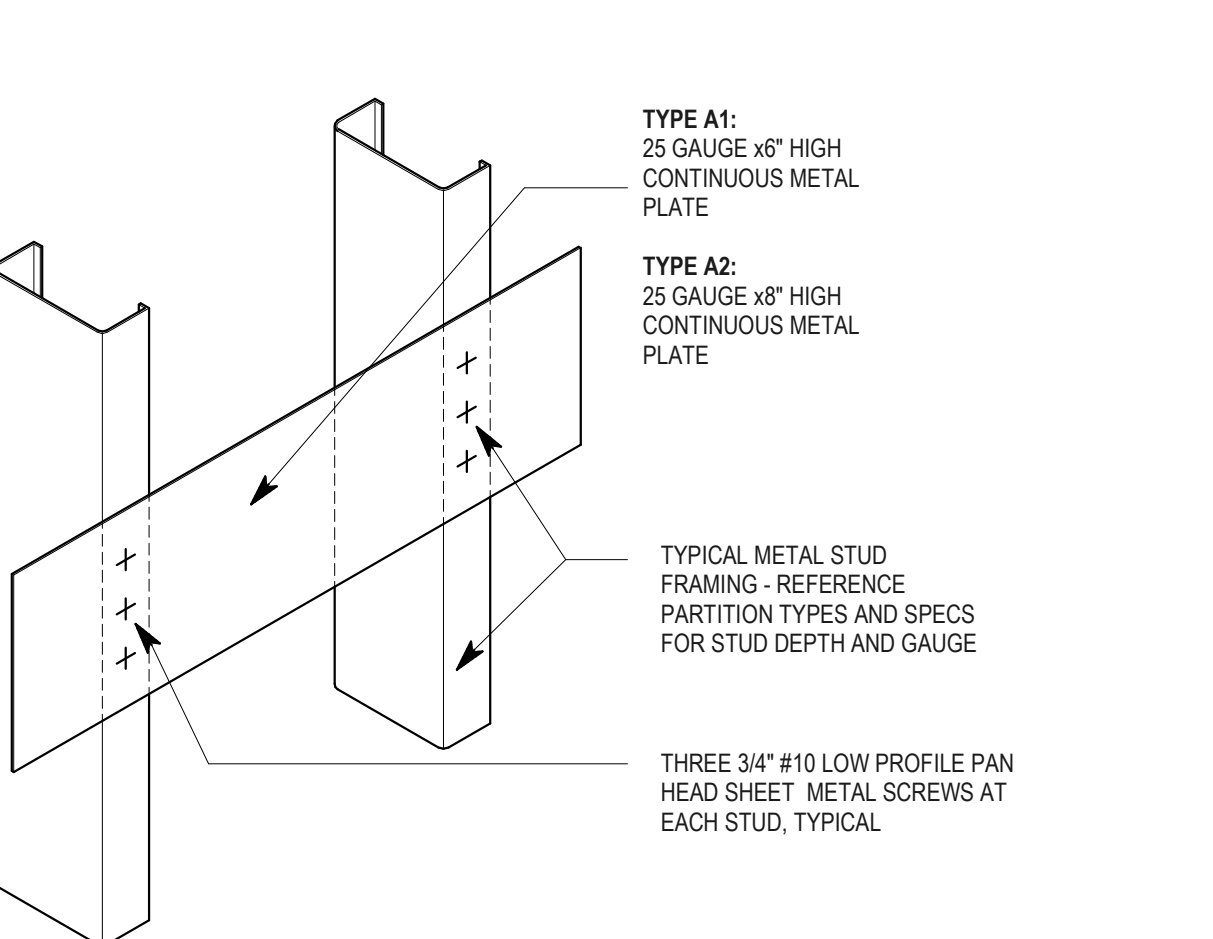


6 C1010.120 BACKING PLATE TYPE 'A'
1 1/2" x 1'-0"

PARTITION-TYPE LEGEND

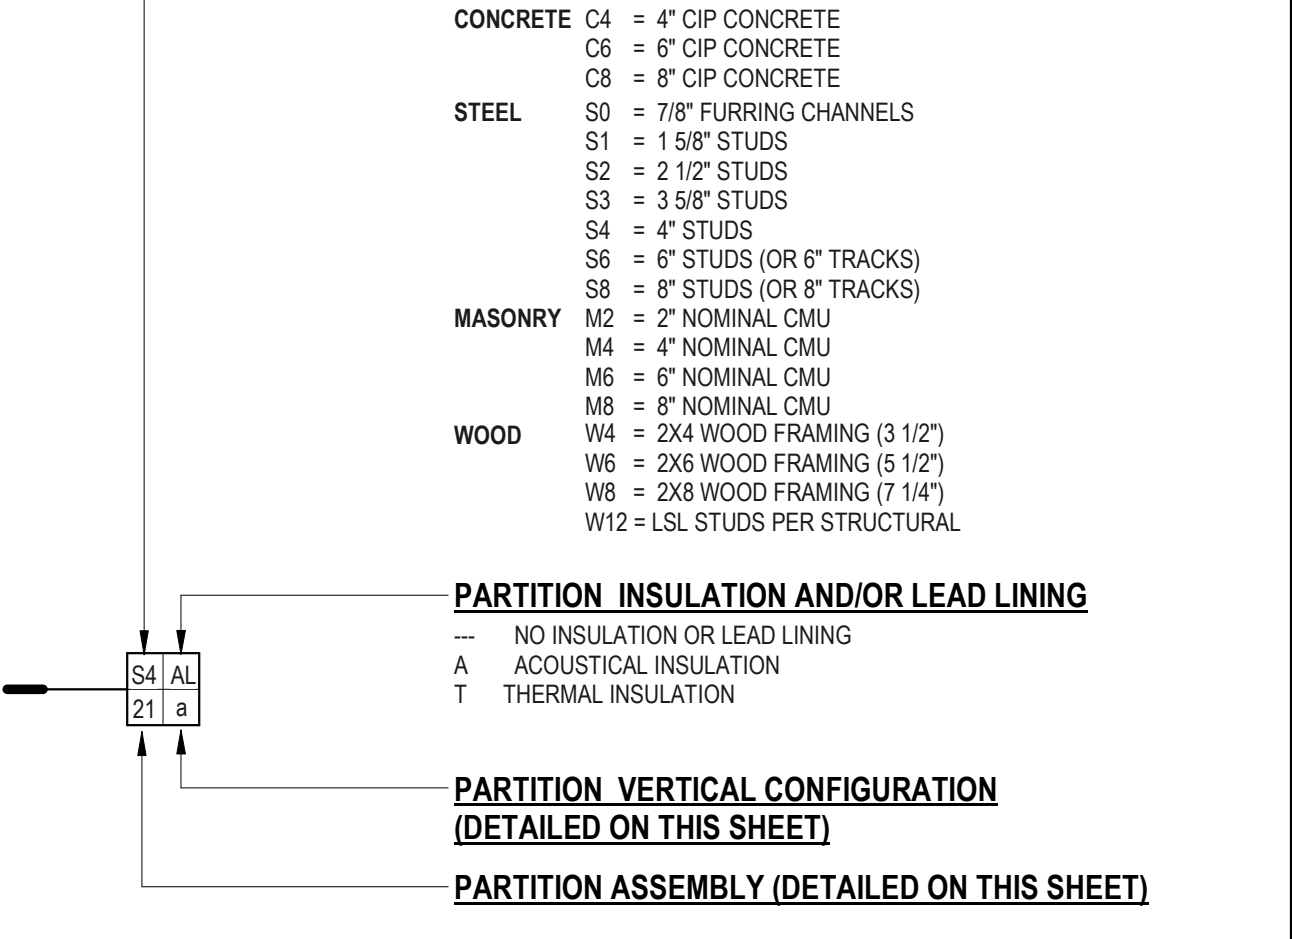

PARTITION-TYPE: VERTICAL CONFIGURATION LEGEND

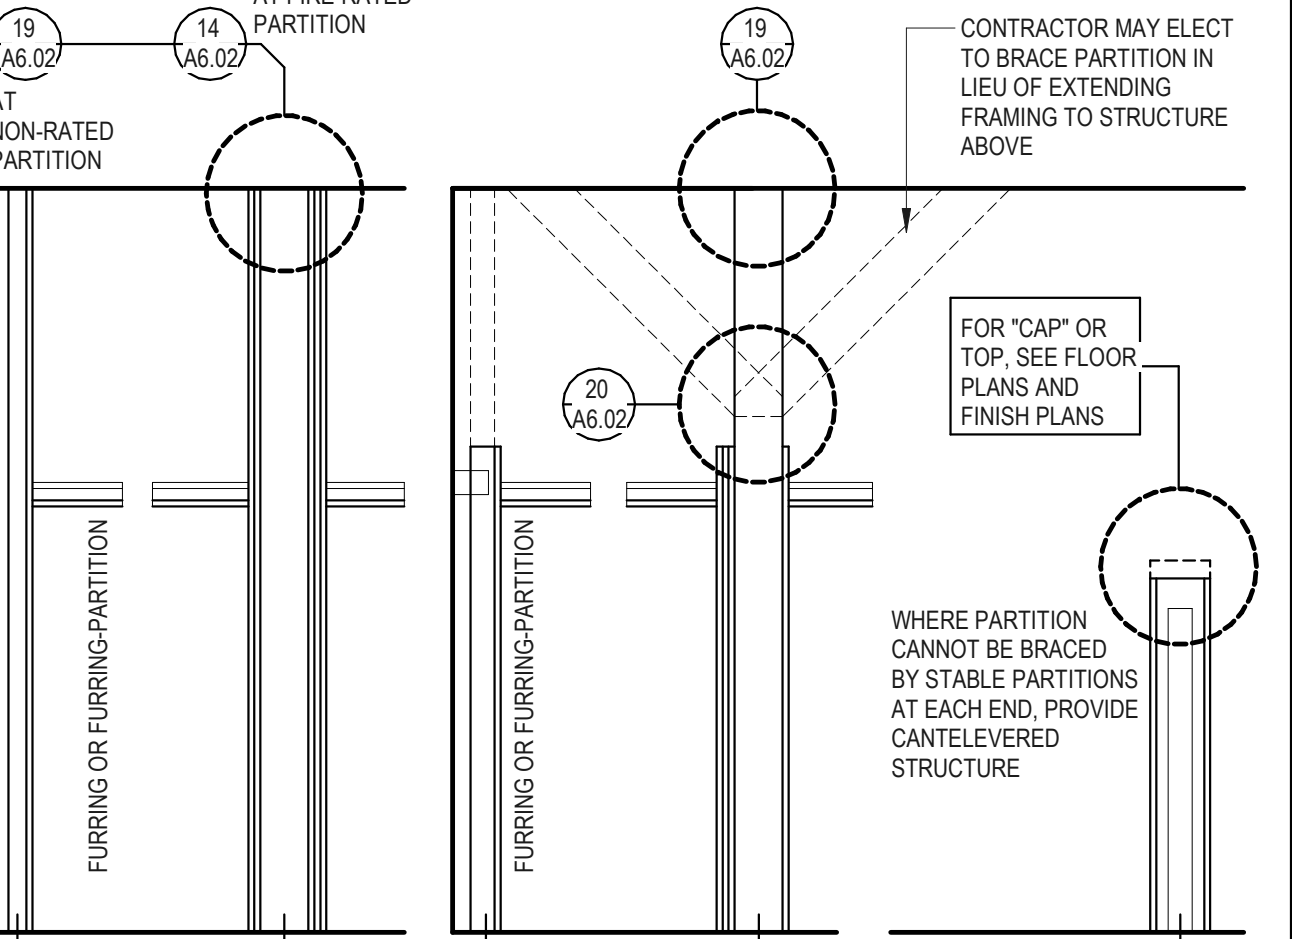

a full-barrier partition

b standard partition

c partial-height partition

d full-barrier truss ptn

e underside truss ptn

f underside rated ceiling

ACOUSTICAL PARTITIONS - NOTES

BACKING PLATES FOR CASEWORK, MILLWORK AND/OR EQUIPMENT:

PROVIDE TYPE A1 OR A2 BACKING PLATES:

PROJECT INFORMATION

ISSUANCE

PROJECT INFORMATION

ISSUANCE

PROJECT INFORMATION

TULALIP TRIBES GATHERING HALL

**7512 TOTEM BEACH RD
TULALIP, WA 98271**

PHASE 2 - BUILDING AND LANDSCAPING

LEGENDS & DETAILS - PARTITIONS

ISSUANCE

PROJECT INFORMATION

ISSUANCE

PROJECT INFORMATION

ISSUANCE


PROJECT INFORMATION

ISSUANCE


PROJECT INFORMATION

ISSUANCE


PROJECT INFORMATION

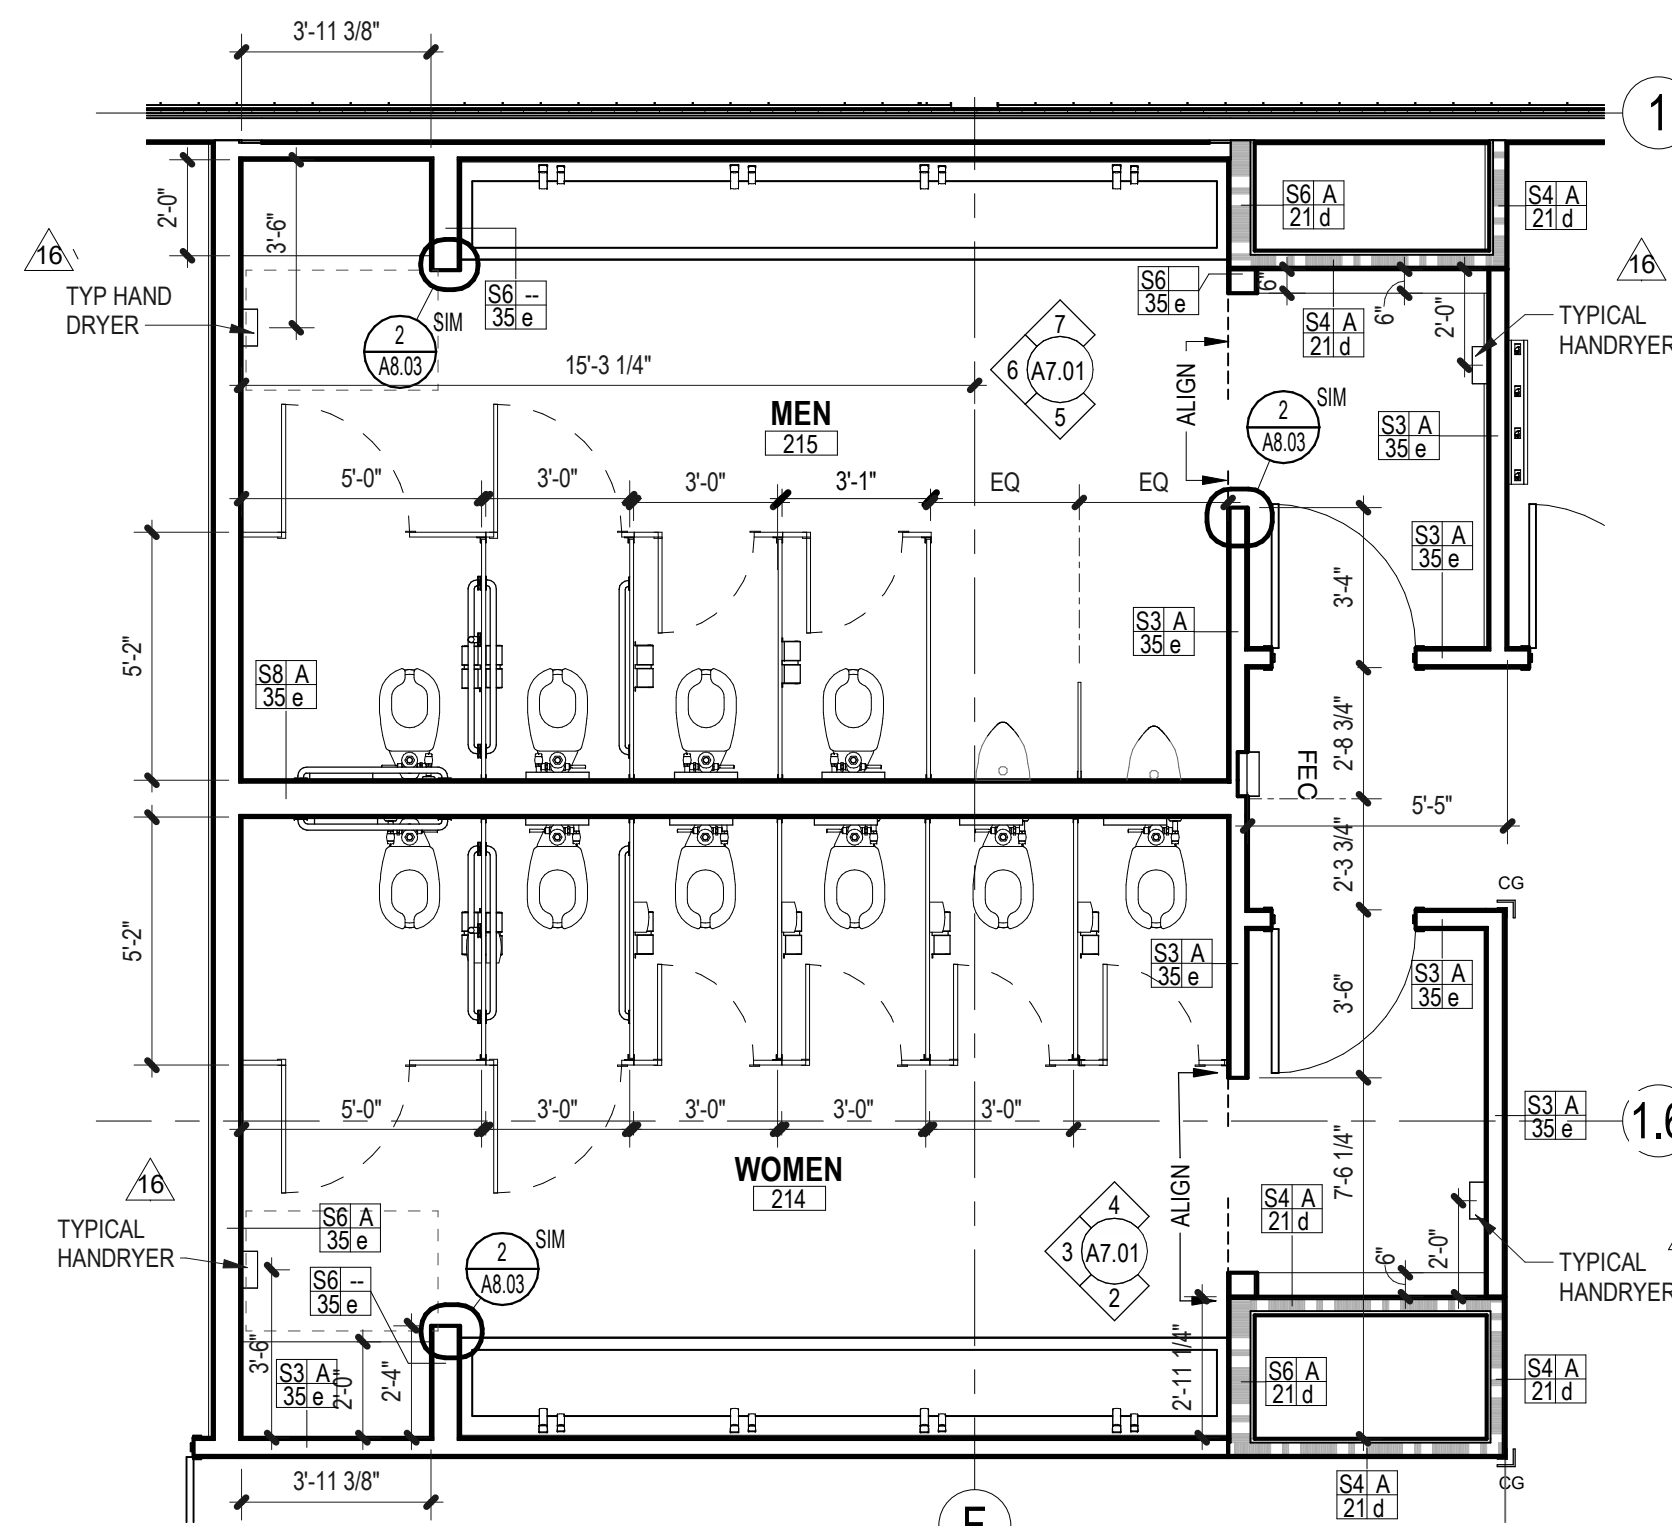


1 ENLARGED FLOOR PLAN - WOMEN AND MEN TL214 & 215
1/4" = 1'-0"

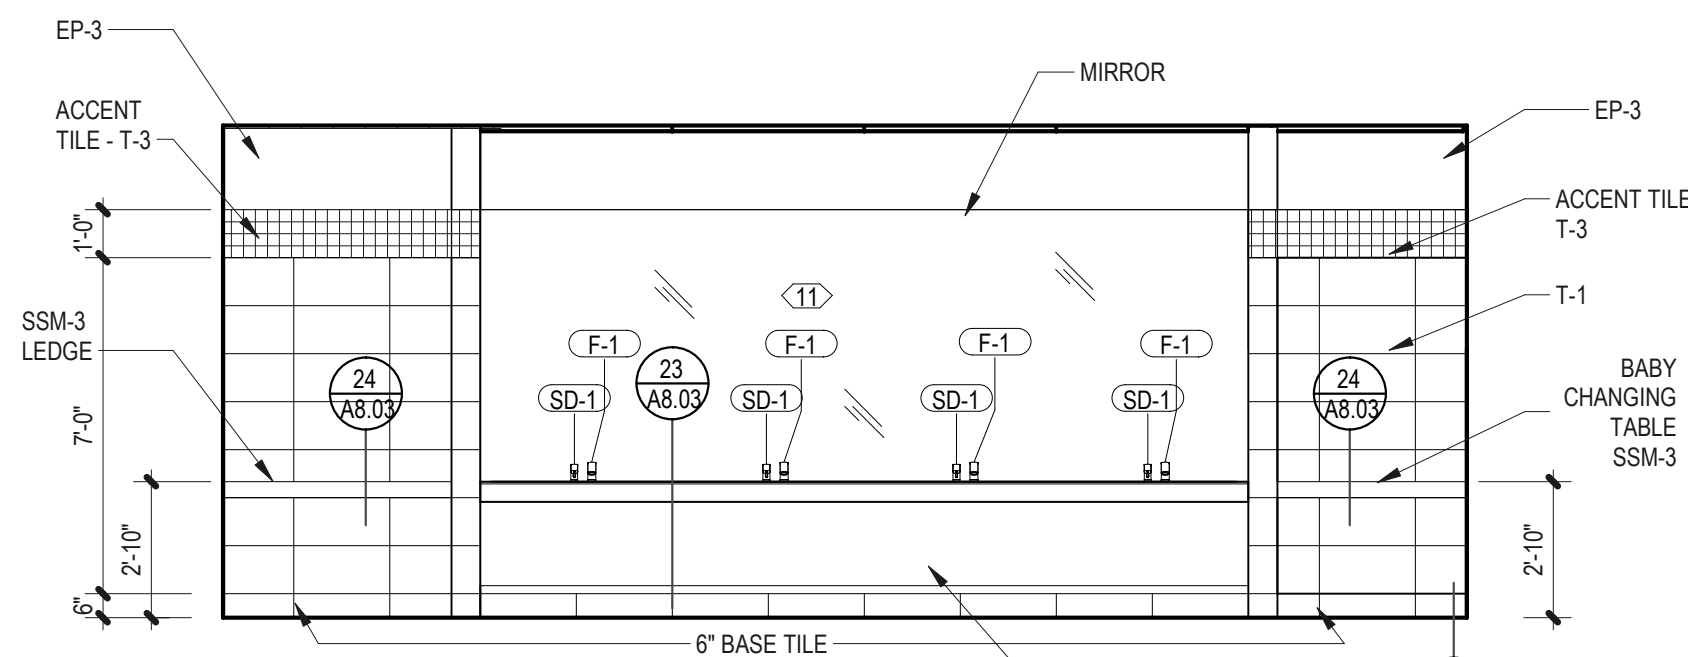


2 WOMEN TL214 EAST
1/4" = 1'-0"

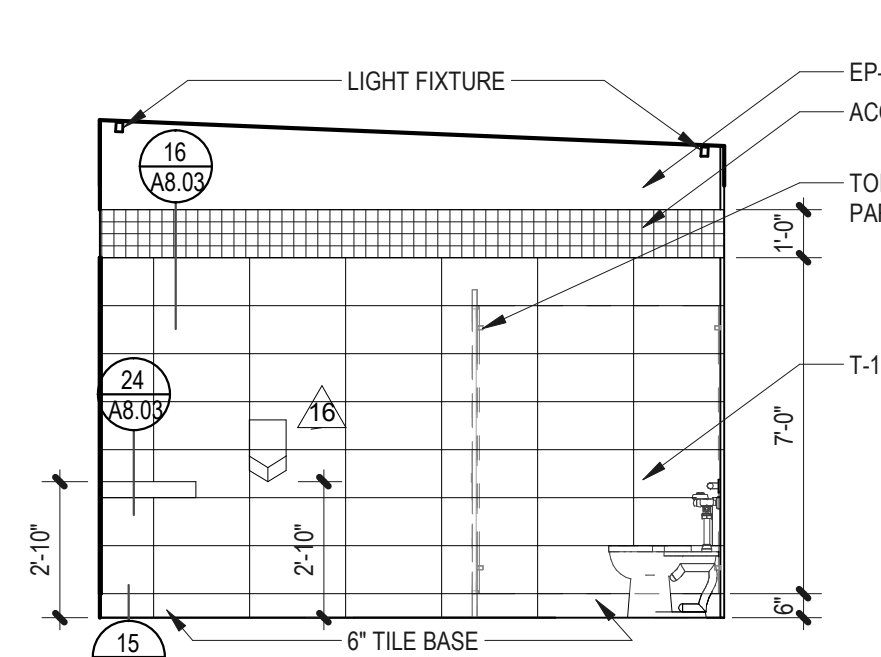


3 WOMEN TL214 SOUTH
1/4" = 1'-0"

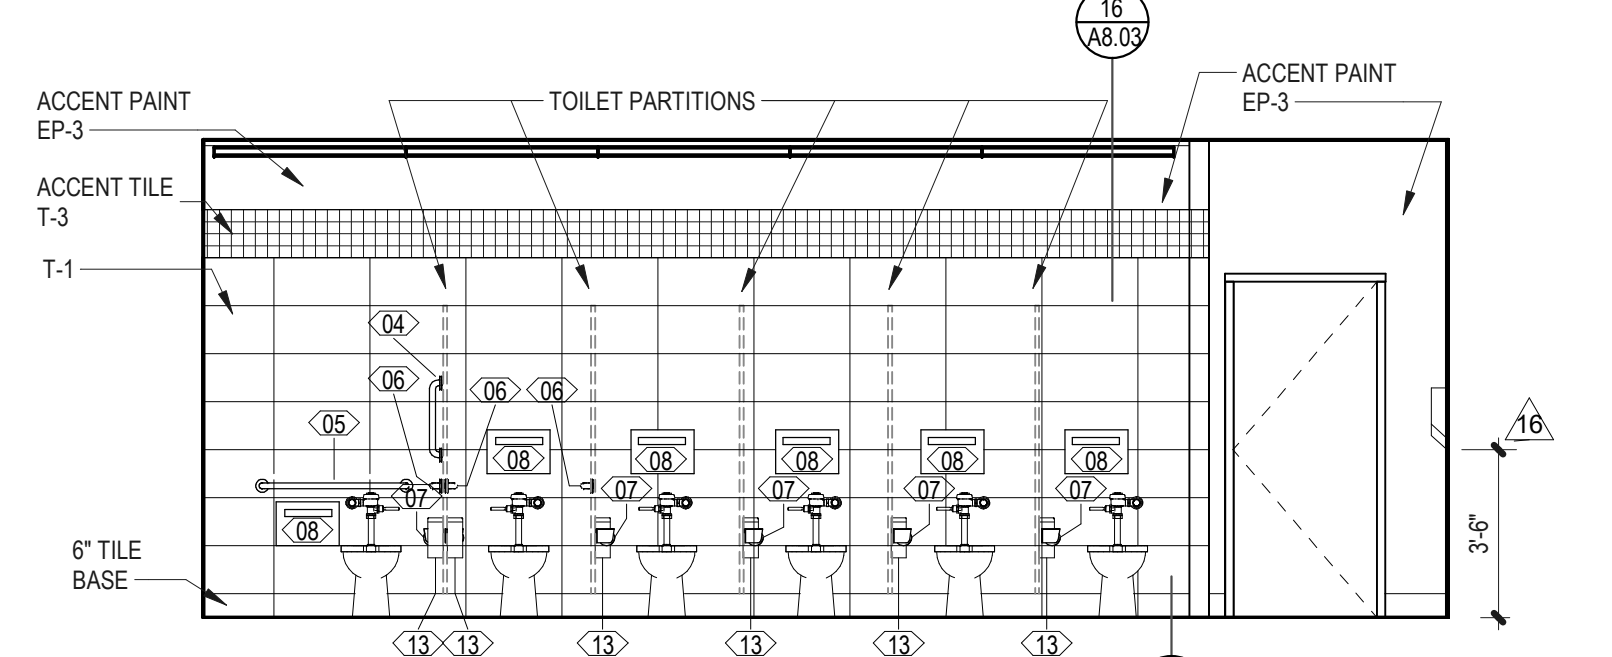


4 WOMEN TL214 WEST
1/4" = 1'-0"

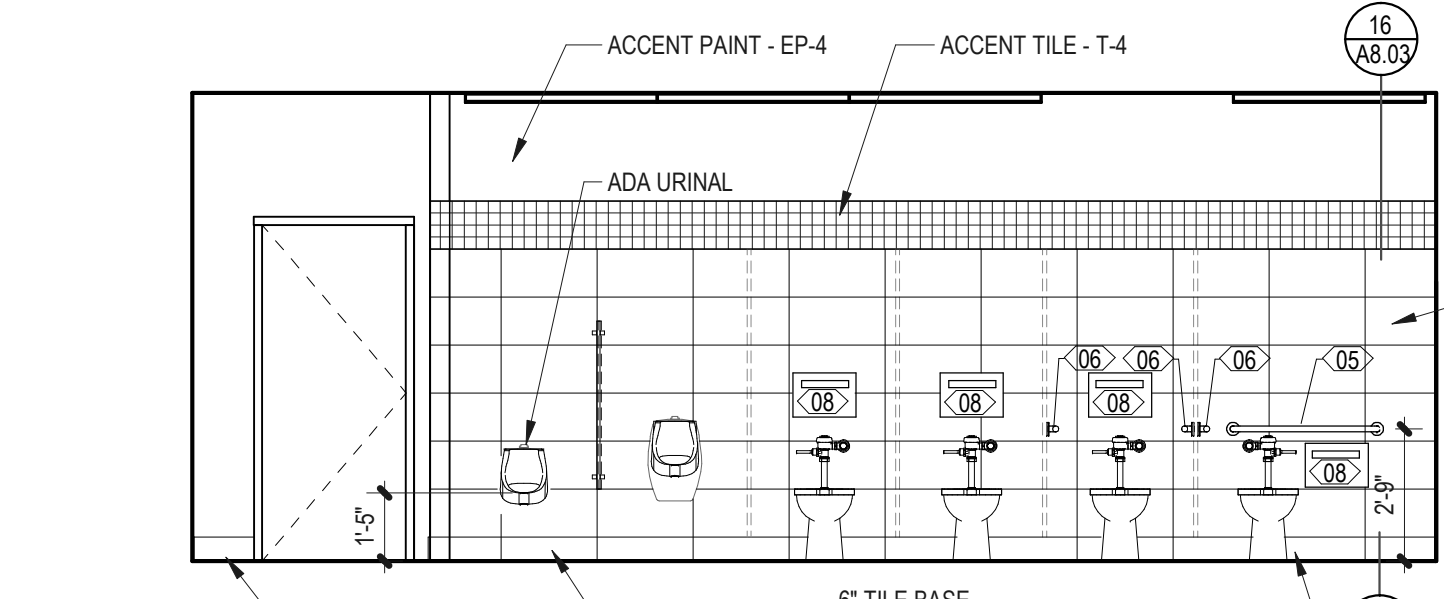


5 MEN TL215 EAST
1/4" = 1'-0"

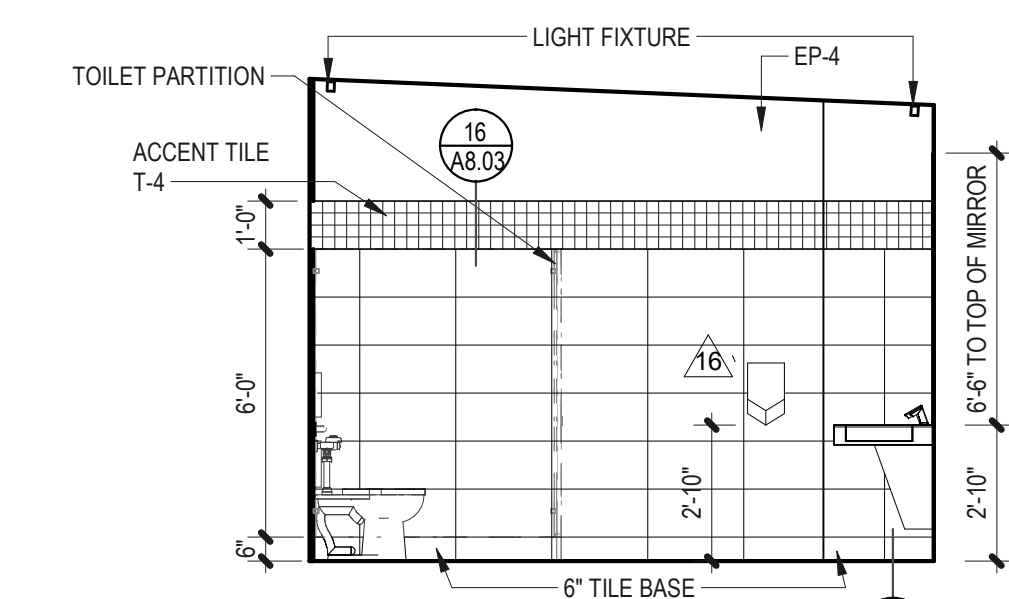


6 MEN TL215 SOUTH
1/4" = 1'-0"

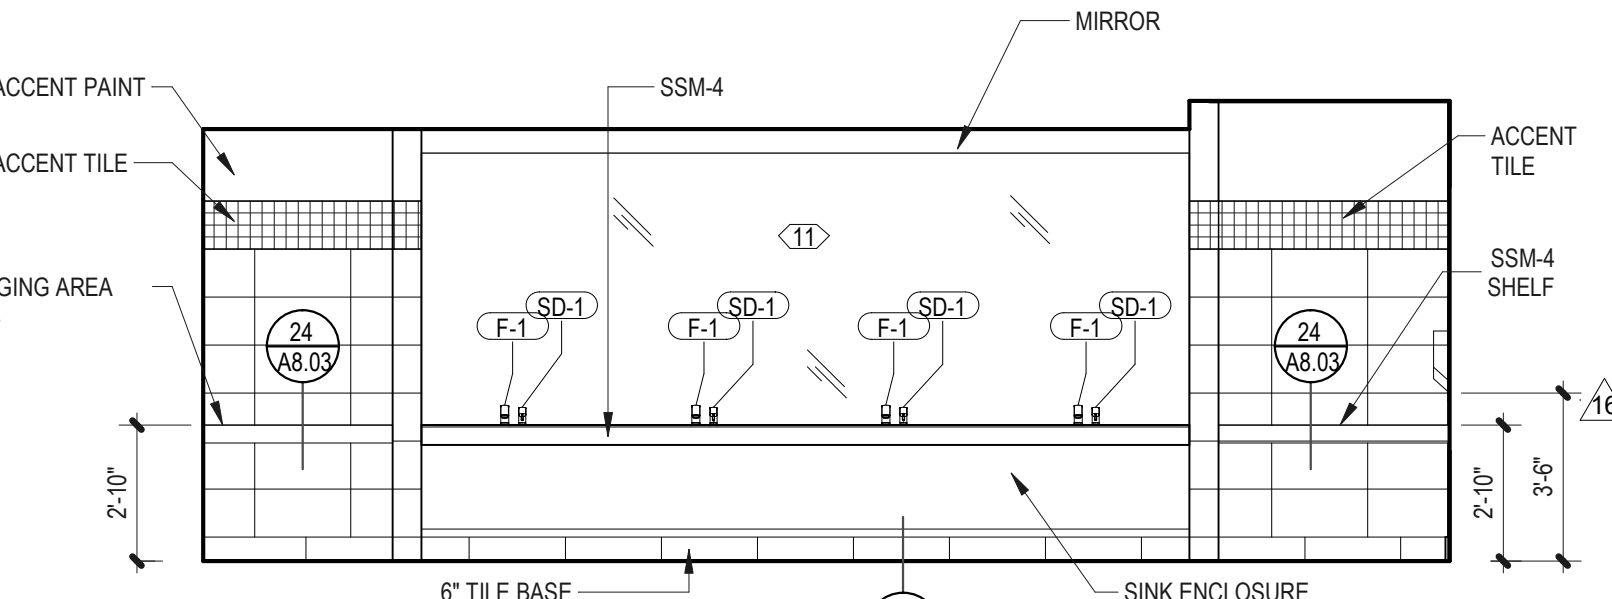


7 MEN TL215 WEST
1/4" = 1'-0"

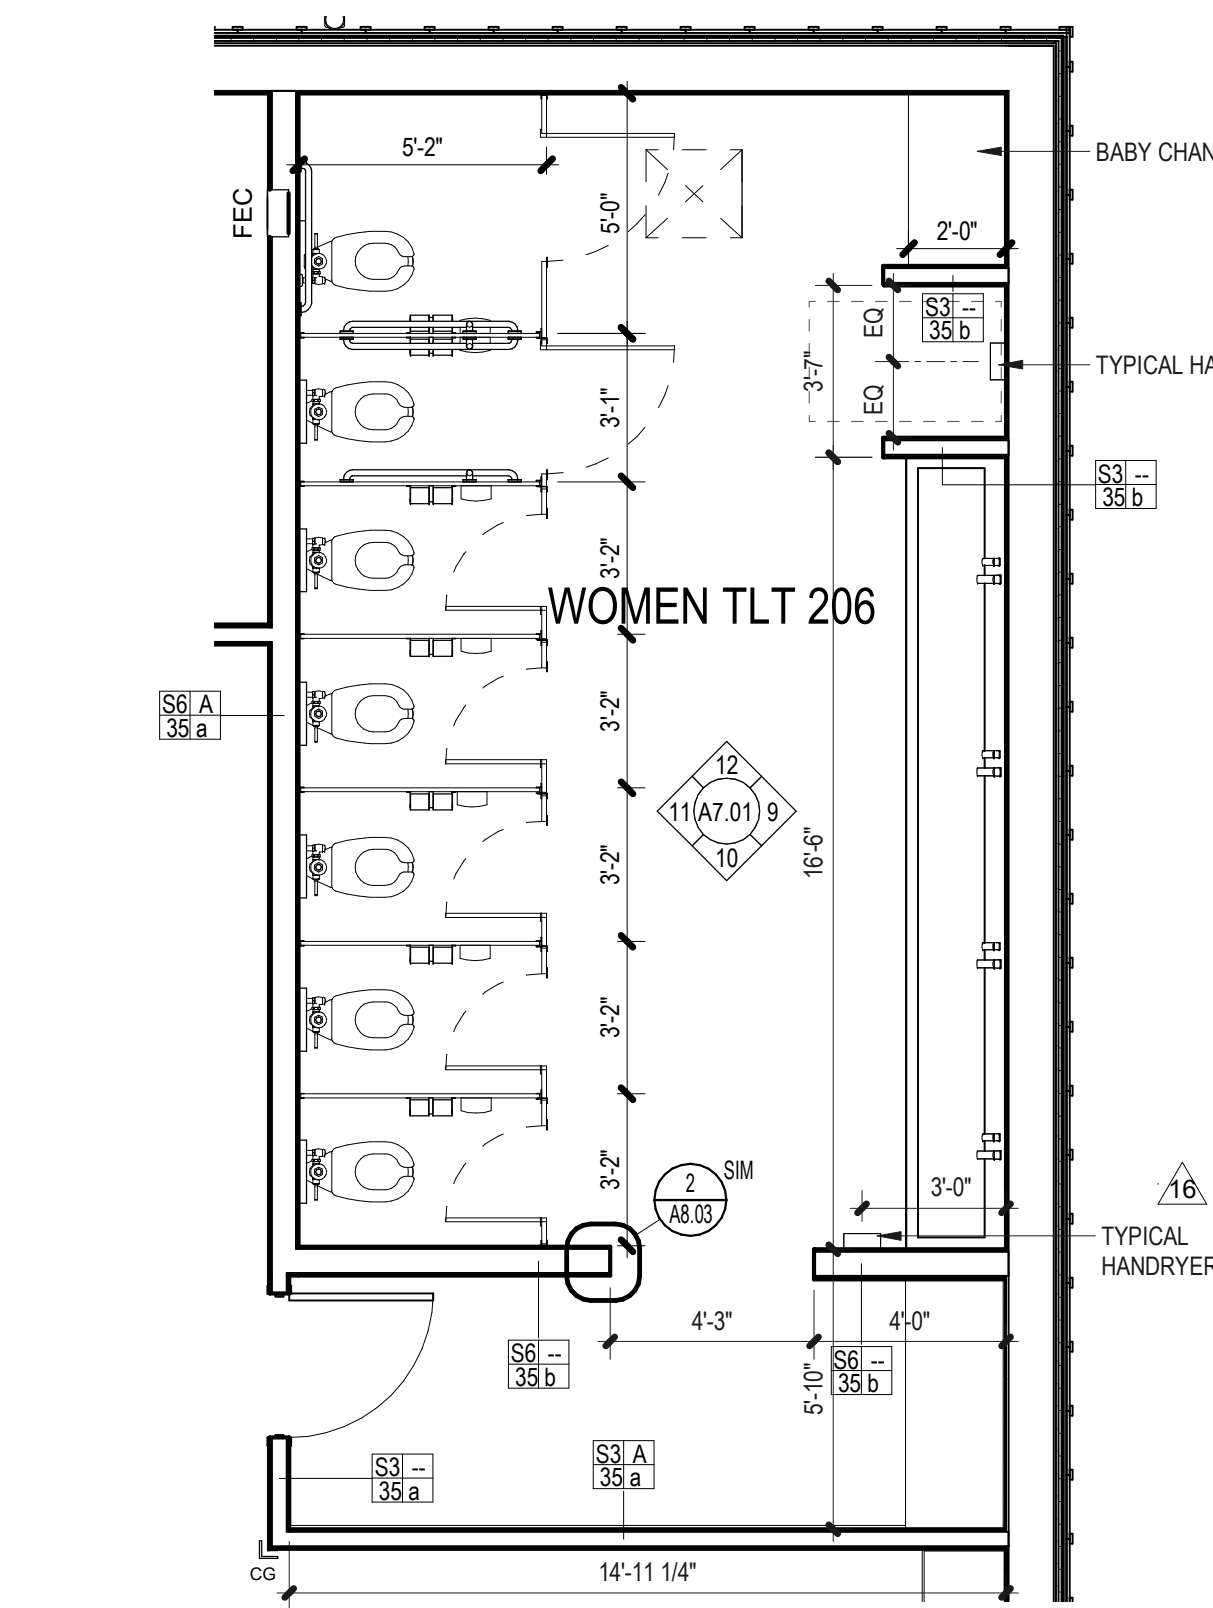


8 ENLARGED FLOOR PLAN - WOMEN TL206
1/4" = 1'-0"

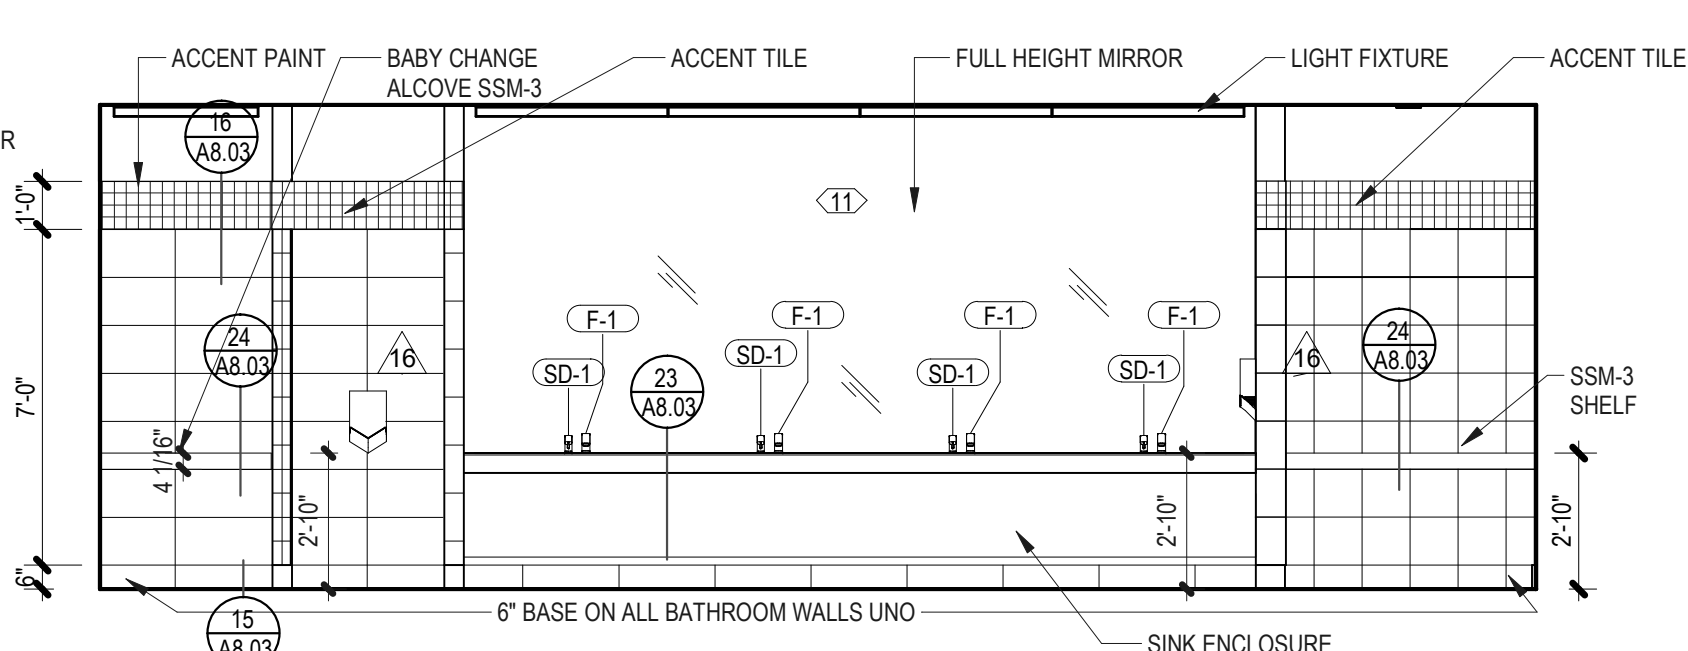


9 WOMEN TL206 NORTH
1/4" = 1'-0"

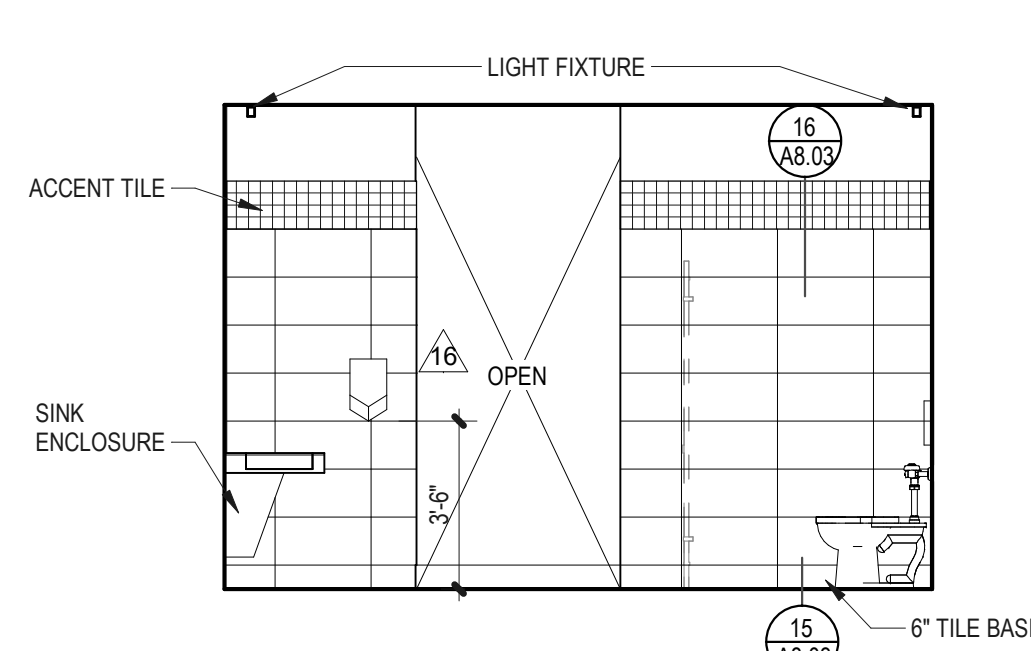

10 WOMEN TL206 EAST
1/4" = 1'-0"

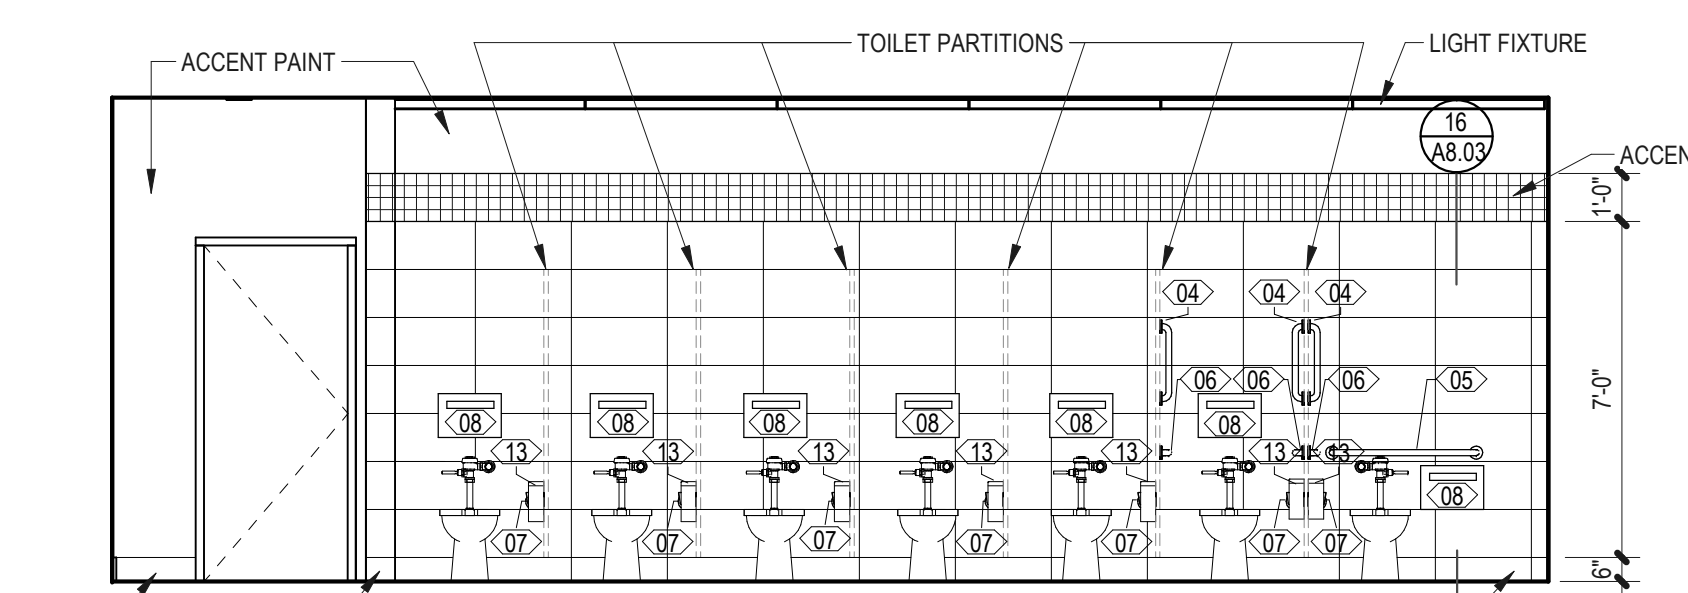


11 WOMEN TL206 SOUTH
1/4" = 1'-0"

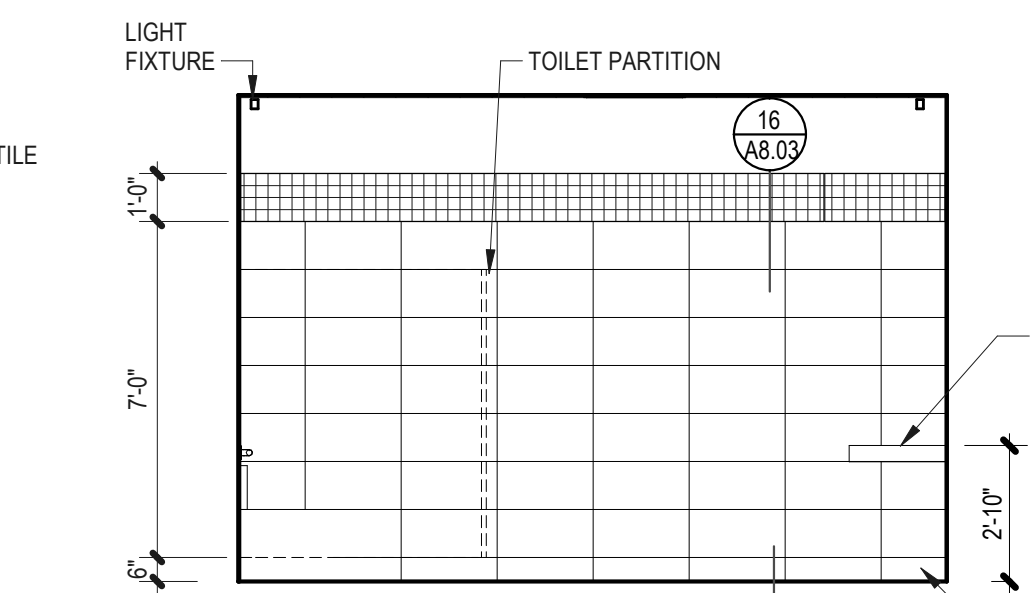


12 WOMEN TL206 WEST
1/4" = 1'-0"

ACCESSORIES SCHEDULE


FF&E NO.	PRODUCT DESCRIPTION	Description
02	MIRROR	PAPER TOWEL DISPENSER
03	GRAB BAR VERTICAL - 18"	24 X 36 MIRROR
04	GRAB BAR HORIZONTAL - 36"	BOBRICK GRAB BAR - 18" VERTICAL - B-6806-18
05	GRAB BAR HORIZONTAL - 42"	BOBRICK GRAB BAR - 36" O B-6806-36
06	TOILET PAPER DISPENSER	BOBRICK GRAB BAR - 42" B-6806-42
07	TOILET SEAT COVER DISPENSER	BOBRICK TOILET PAPER DISPENSER - B-4288
08	MIRROR	BOBRICK TOILET SEAT COVER DISPENSER - B-4221
09	MIRROR	MIRROR - CUSTOM SIZE - 10'-0" W X 6'-0" H
10	MIRROR	MIRROR - CUSTOM SIZE - 20'-6" W X 6'-6" H
11	MIRROR	MIRROR - CUSTOM SIZE - 14'-0" W X 6'-6" H
12	MIRROR	BOBRICK SURFACE MOUNTED SANITARY NAPKIN DISPOSAL - B-270
13	SANITARY NAPKIN DISPOSAL	BOBRICK PAPER TOWEL DISPENSER - B-2620
14	PAPER TOWEL DISPENSER	BOBRICK SURFACE MOUNTED SOAP DISPENSER - B-2111
15	SHOWER SOAP DISH	BRADLEY CORP SOAP DISH - 940 OR 9402
16	VINYL SHOWER CURTAIN	BOBRICK SHOWER CURTAIN - B-204-2
17	MIRROR - FRAMED - 24" X 60"	BOBRICK CHANNEL FRAME MIRROR - B-165
18	SHOWER BENCH	90 Degree Bench
19	COAT HOOK	BOBRICK TOWEL PIN - B-677
20		
21		
22		
23		
24		
25		

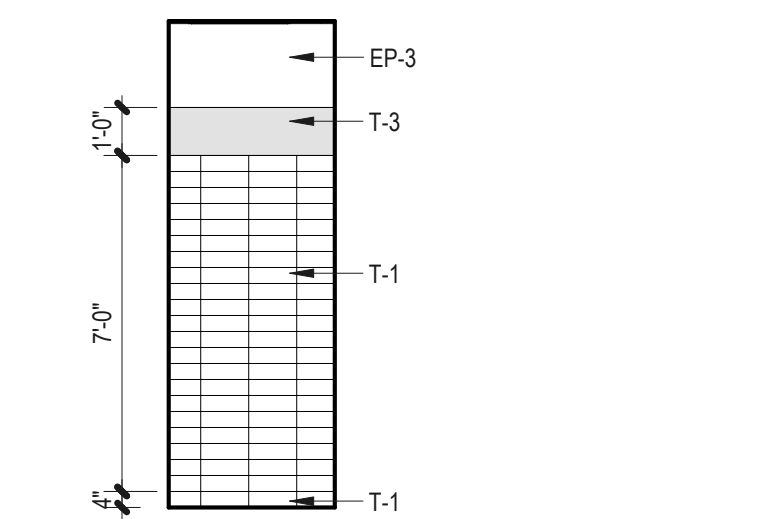


18 WOMEN TL2 - TYPICAL FINISHES
1/4" = 1'-0"

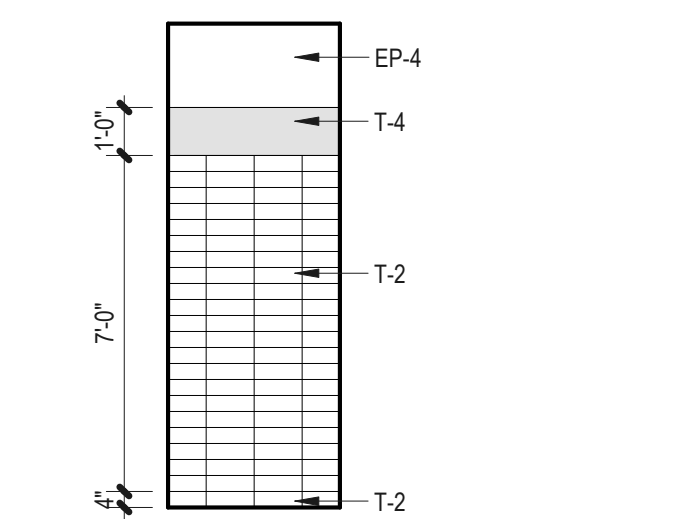


19 MEN TL2 - TYPICAL FINISHES
1/4" = 1'-0"

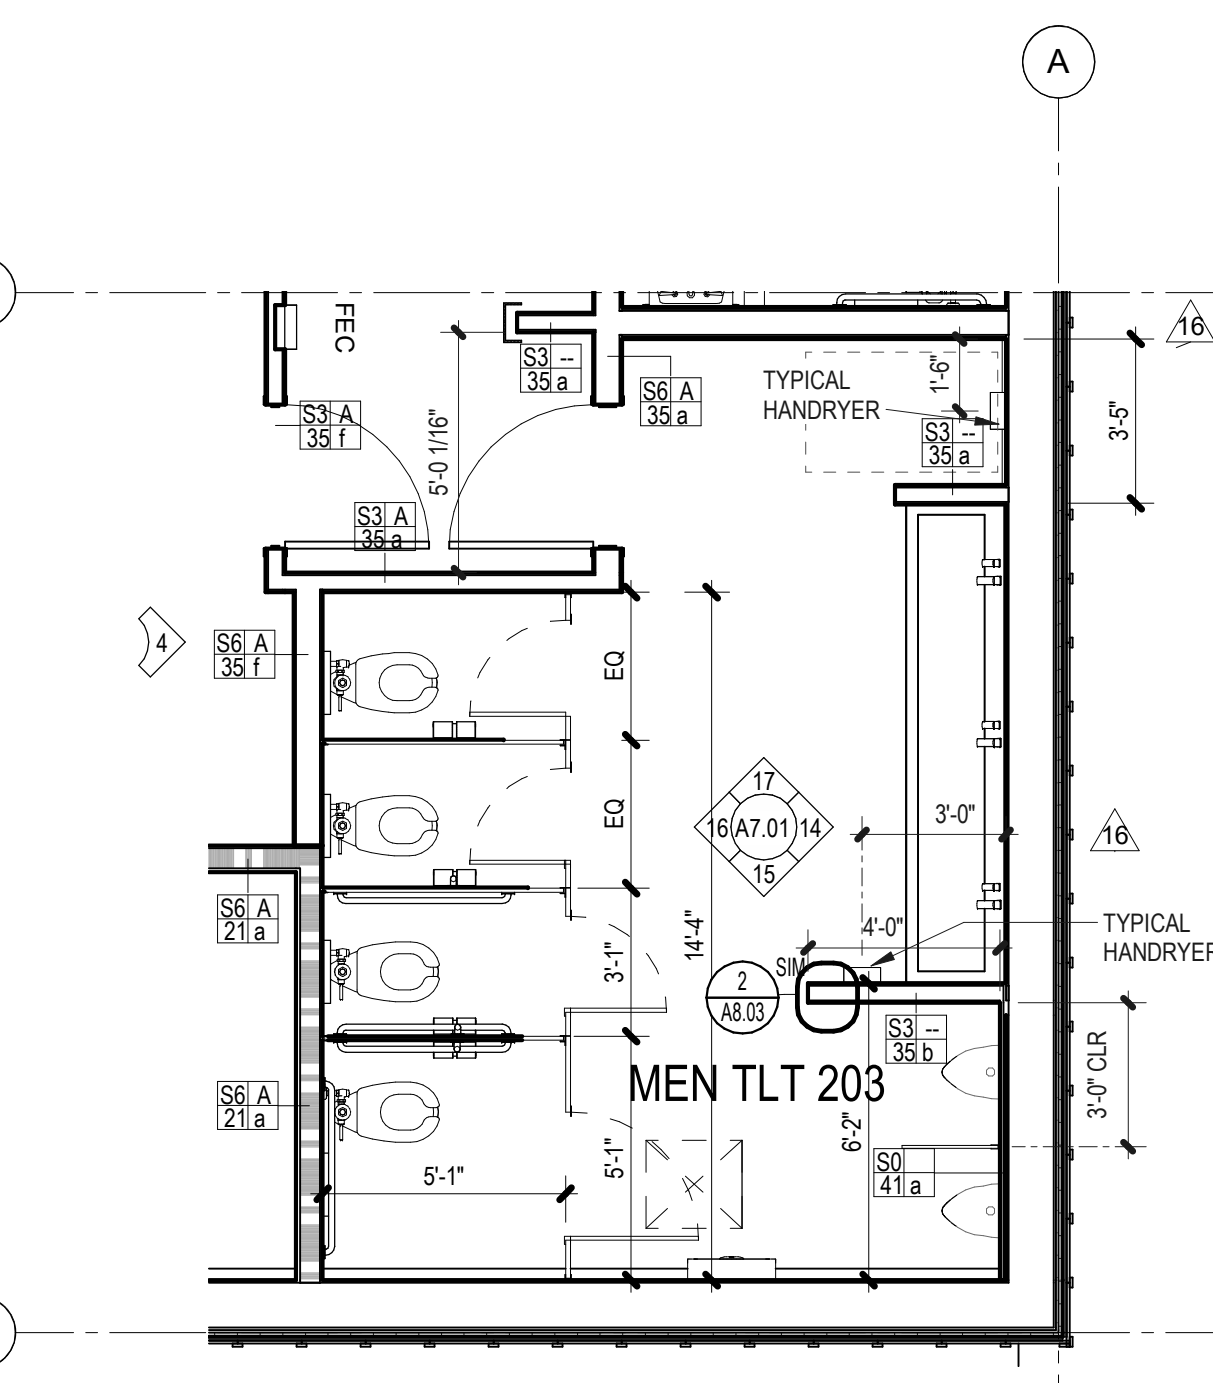


13 ENLARGED FLOOR PLAN - MEN TL203
1/4" = 1'-0"

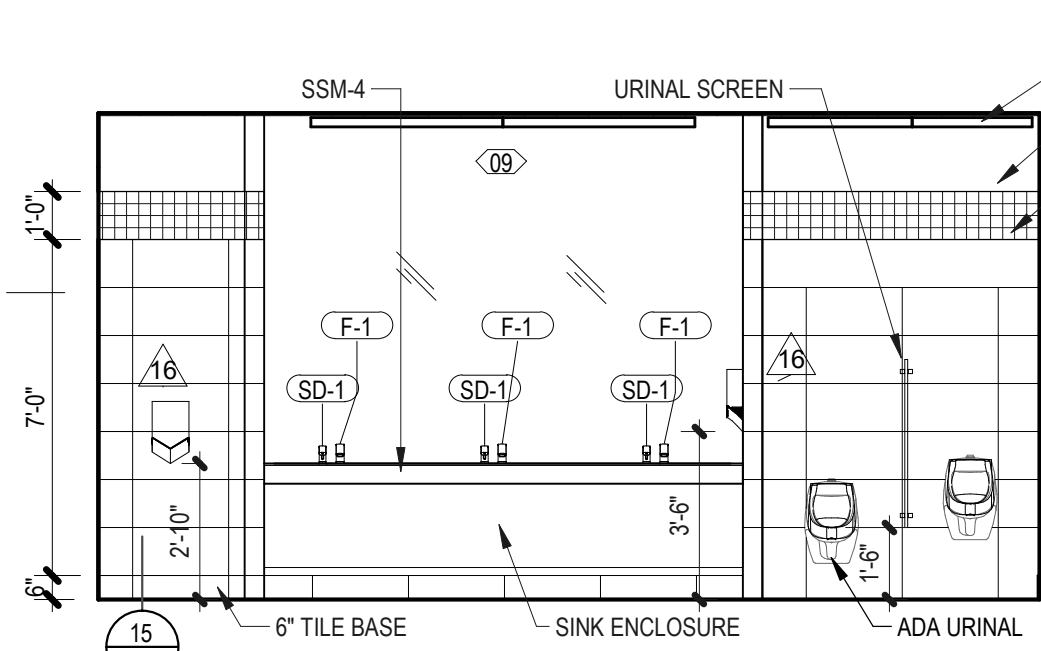


14 MEN TL203 NORTH
1/4" = 1'-0"

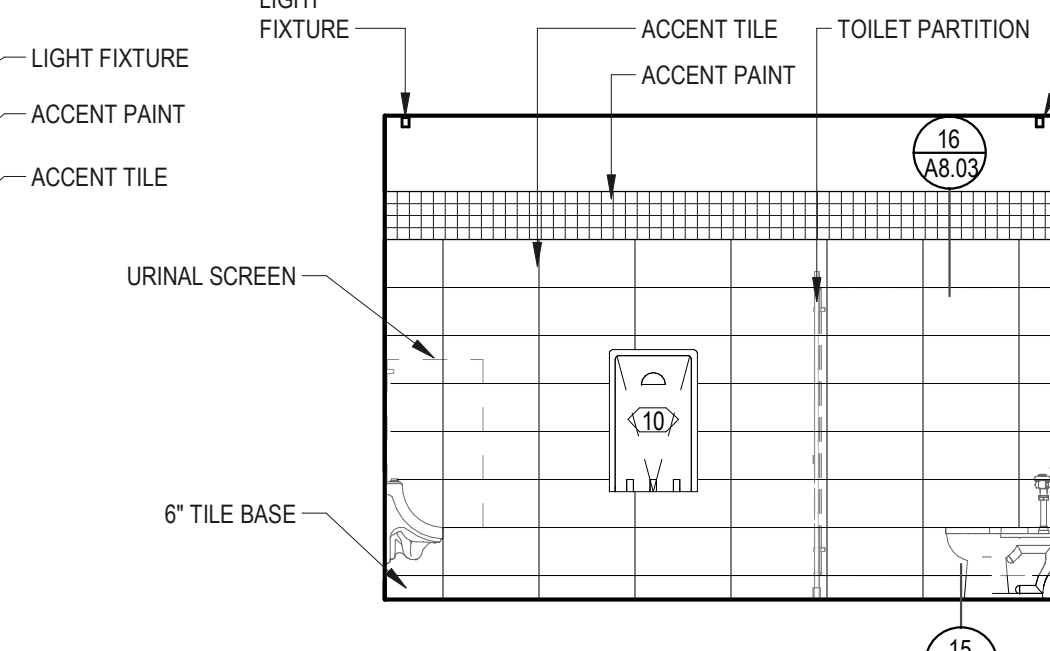

15 MEN TL203 EAST
1/4" = 1'-0"

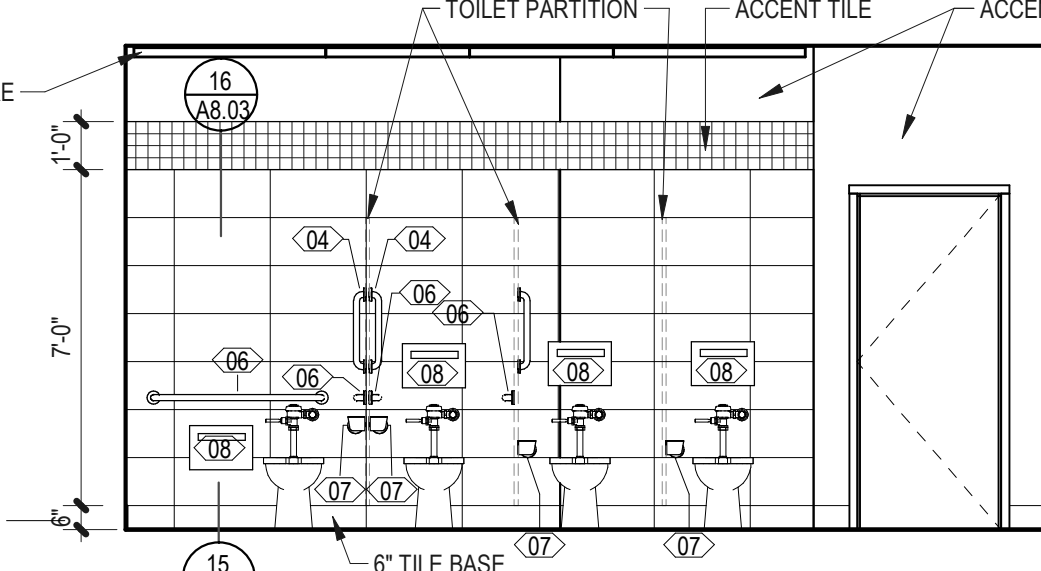


16 MEN TL203 SOUTH
1/4" = 1'-0"

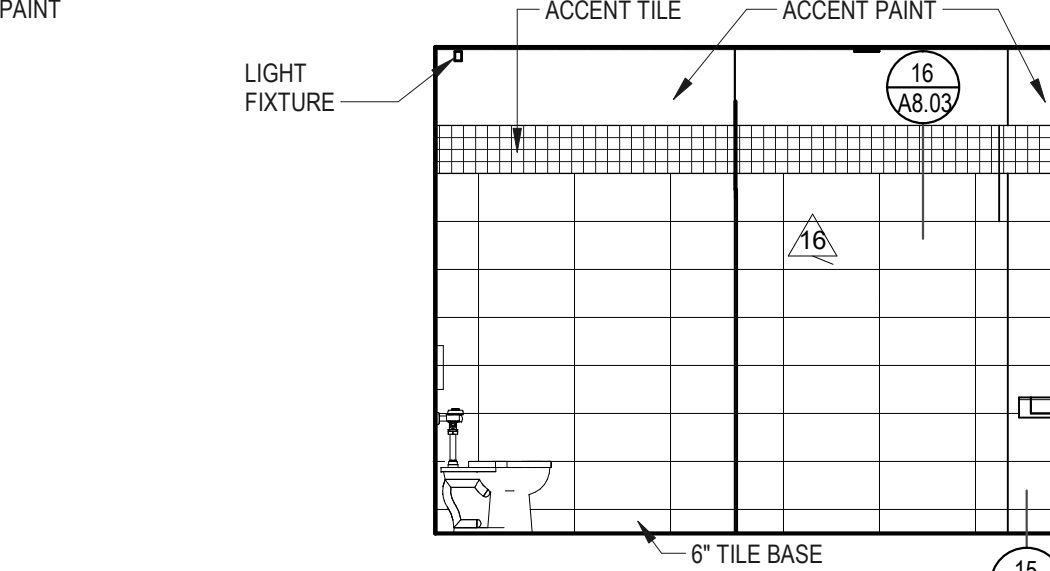


17 MEN TL203 WEST
1/4" = 1'-0"

ACCESSORY PLACEMENT

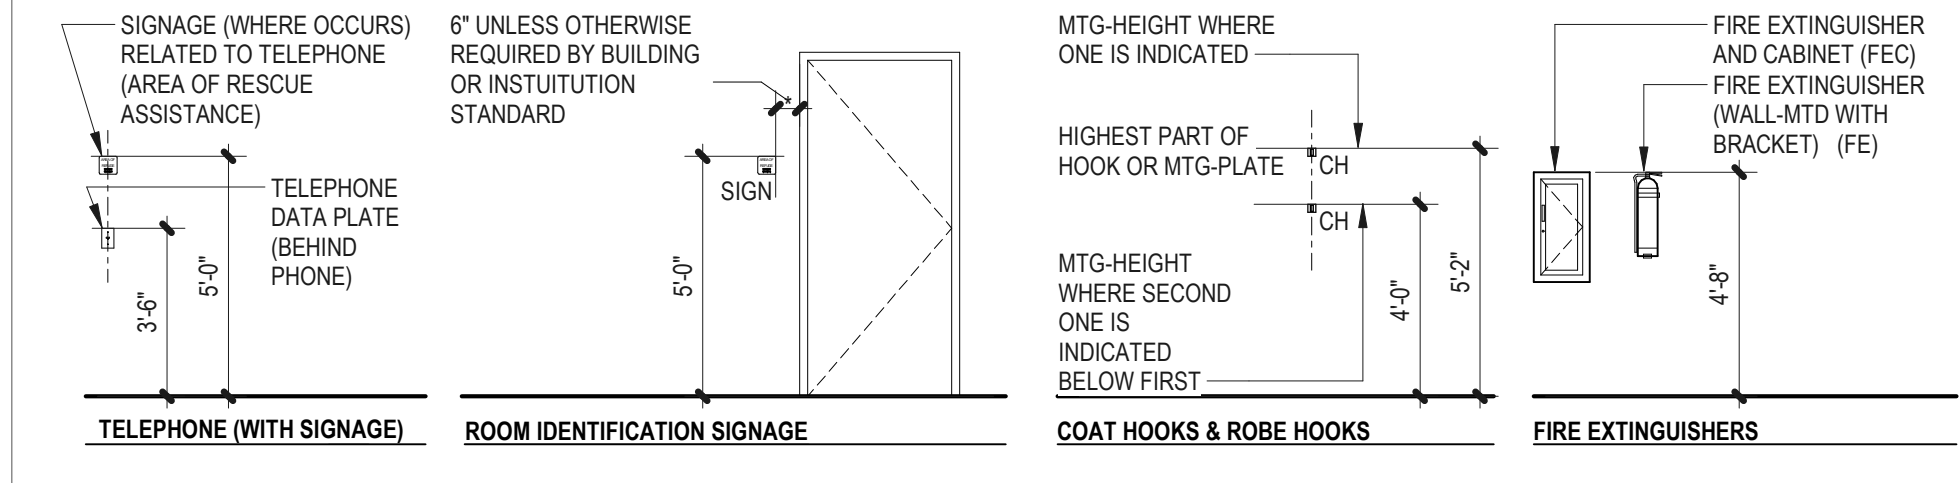

TOILETS AND DRINKING FOUNTAINS (AND WATER COOLERS) - TYPICAL CLEARANCES AND MOUNTING LOCATIONS

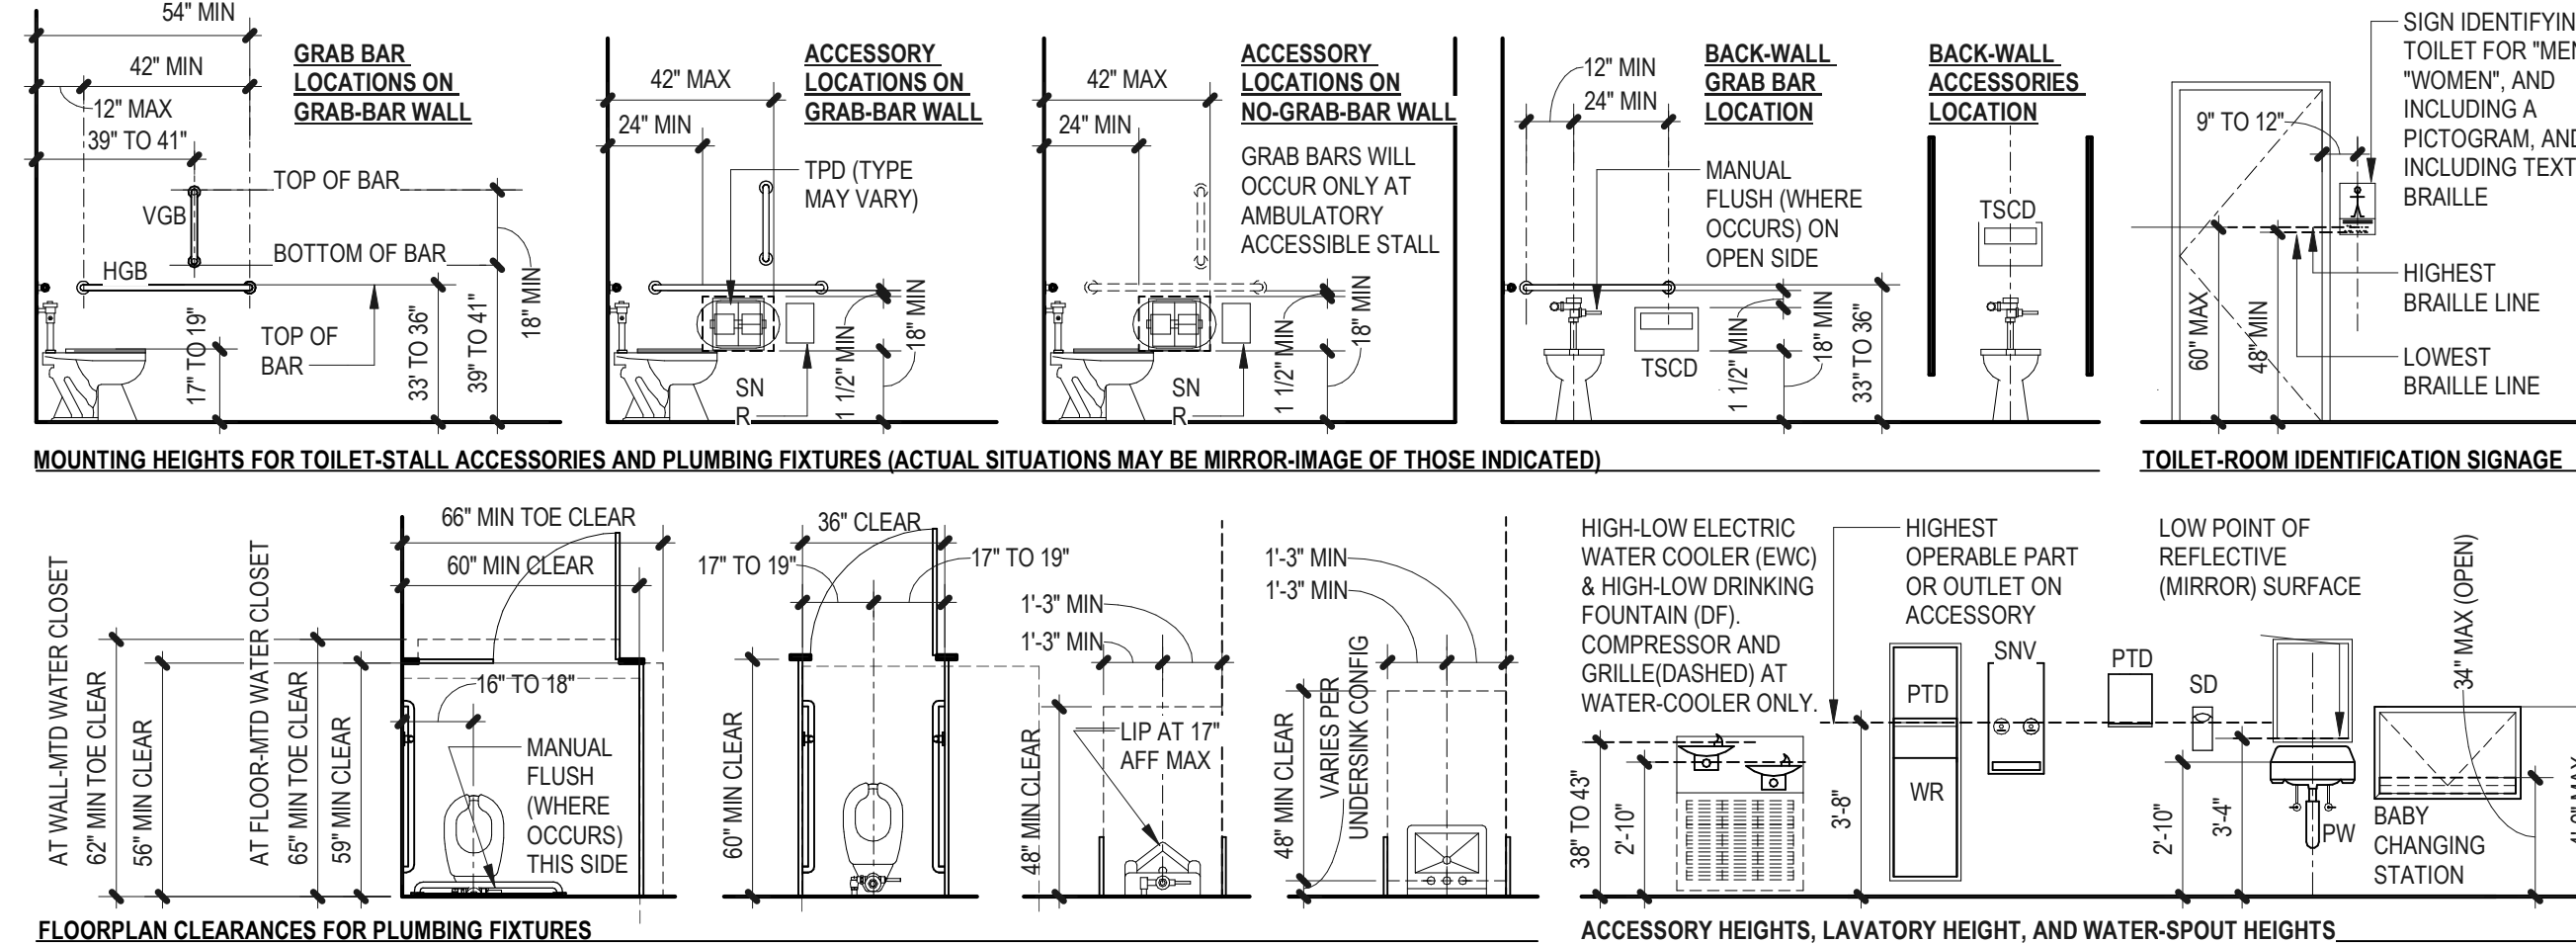

ISSUANCE No.	Description	Date
1	SITE AND FOUNDATION PERMIT SET	04/09/18
2	PH 2 DO SET	04/25/18
3	ADDENDUM 3	11/14/18
4	PH 2 PERMIT REVIEW 2019	01/04/19
5	PH 2 CCD 10	9/24/19
6	PH 2 CONFORM SET	10/14/19
7	PH 2 RECORD SET	06/02/20

PROJECT INFORMATION	17031
PROJECT NUMBER	DC
PROJECT LEAD	JLO
DRAWN BY	

SHEET NO





7512 TOTEM BEACH RD
TULALIP, WA 98271

PHASE 2 - BUILDING AND LANDSCAPING

ENLARGED PLANS AND ELEVATIONS - GATHERING HALL

[illegible]

PROJECT INFORMATION	
PROJECT NUMBER:	17031
PROJECT LEAD:	DC
DRAWN BY:	JLO

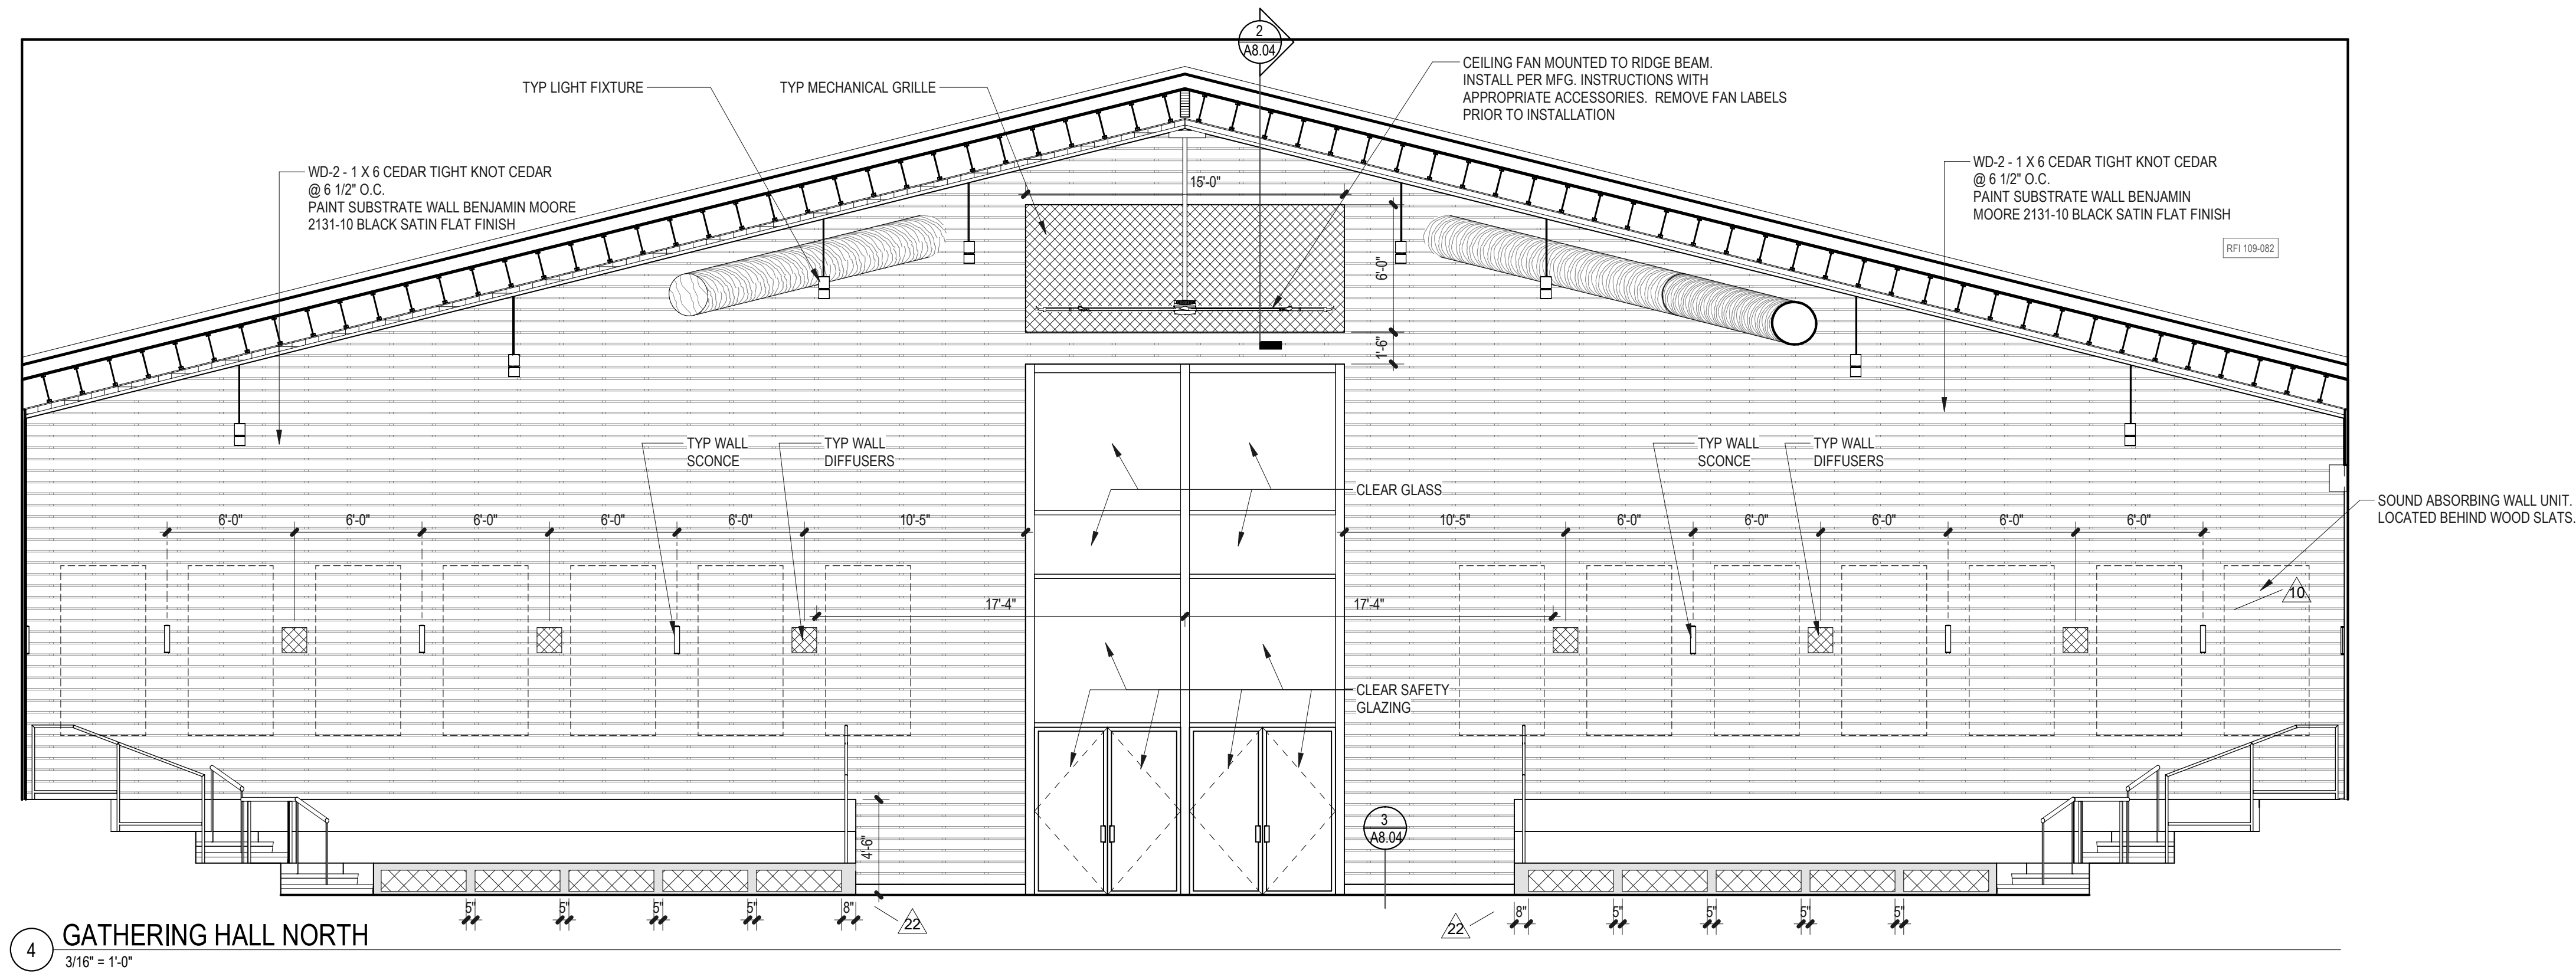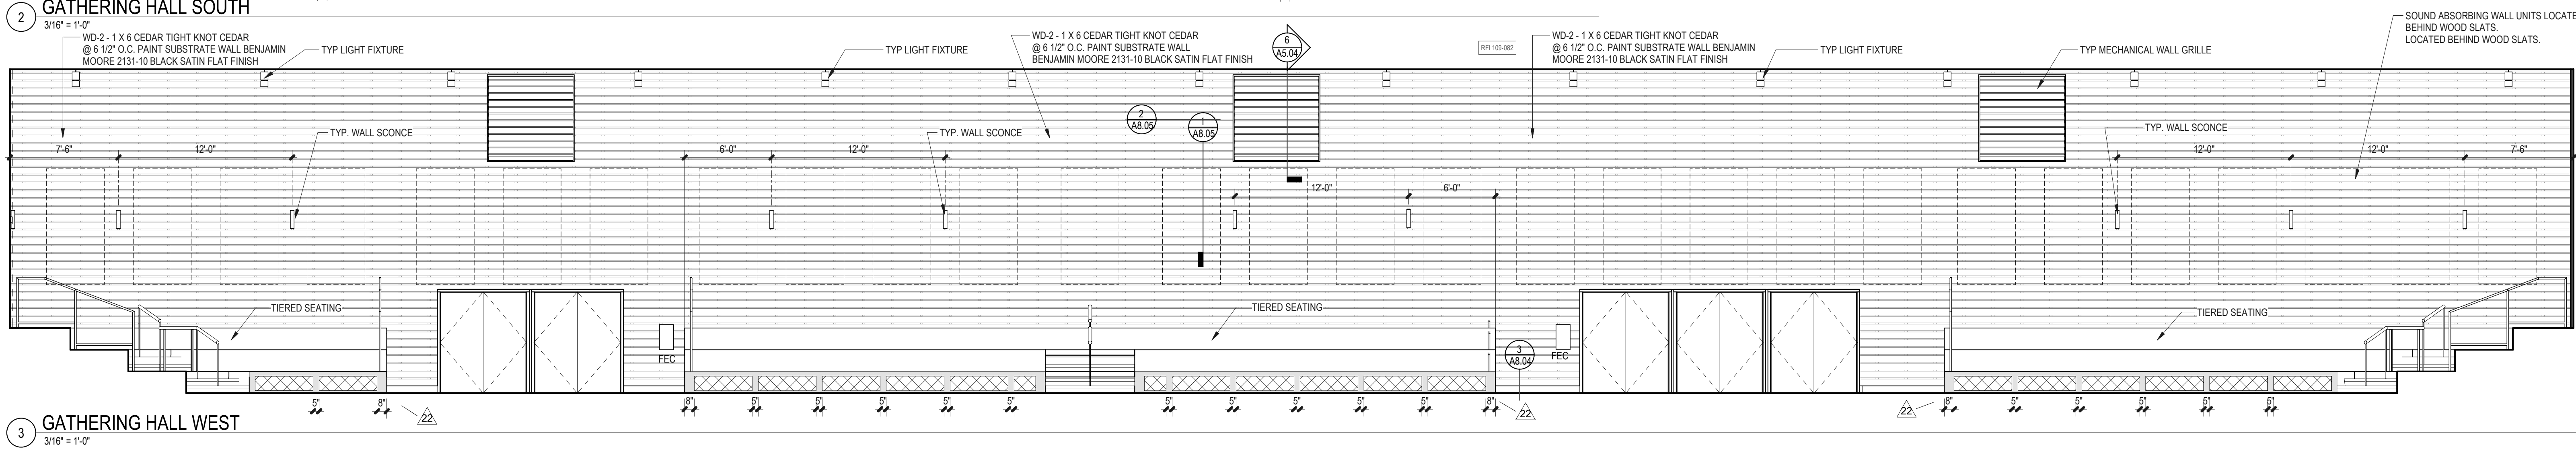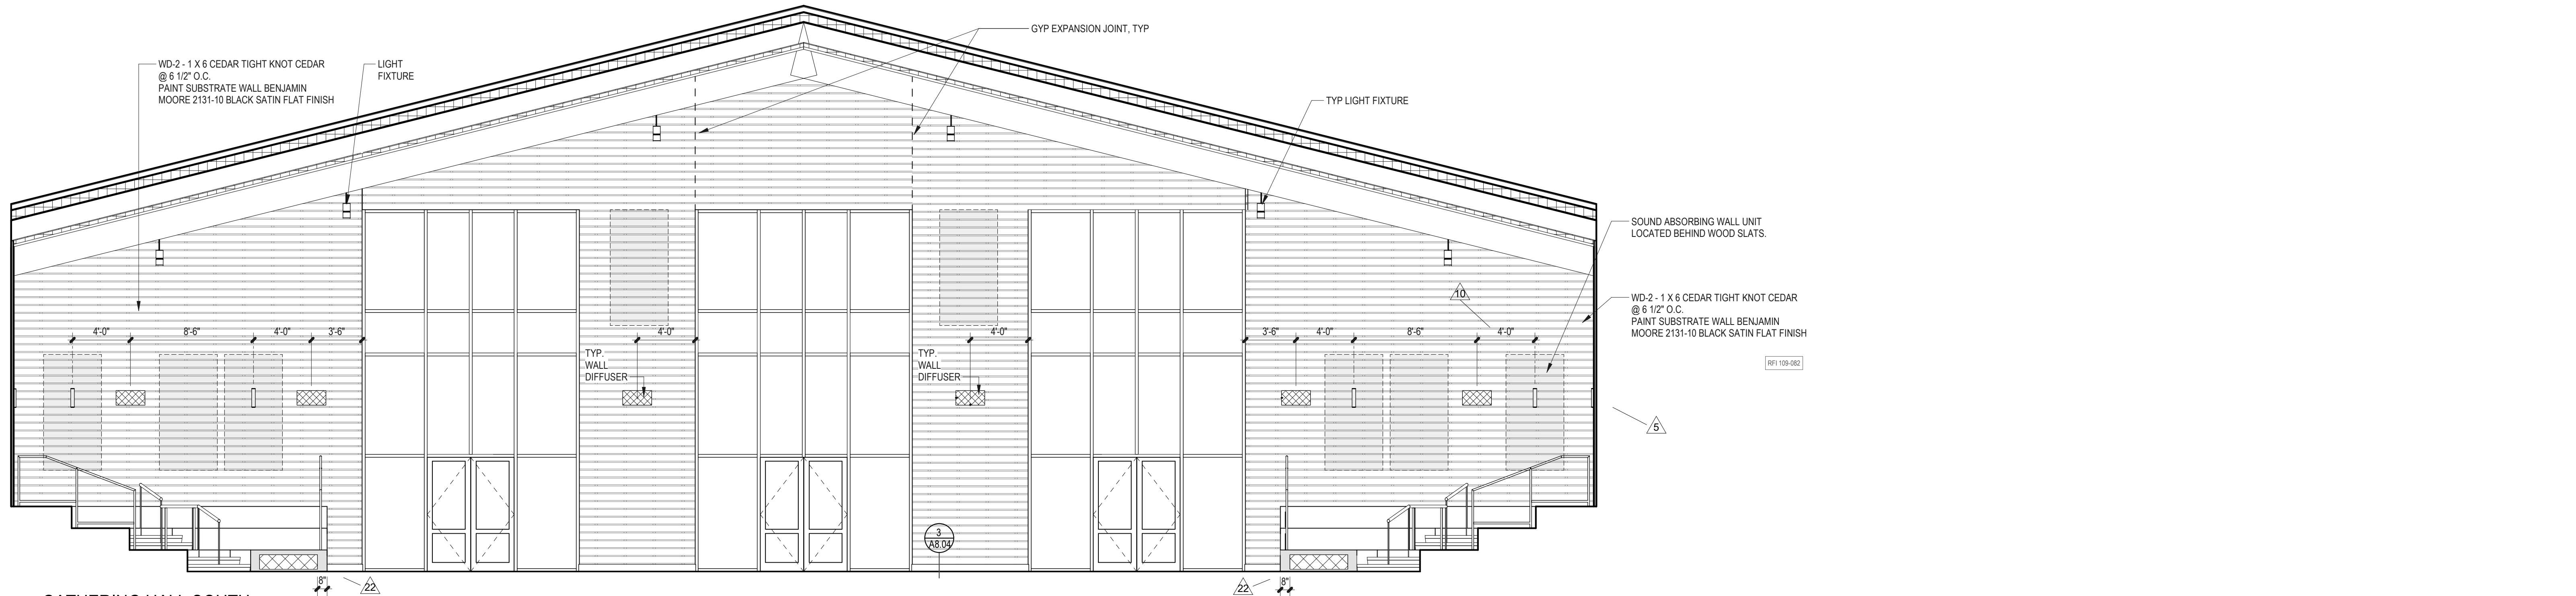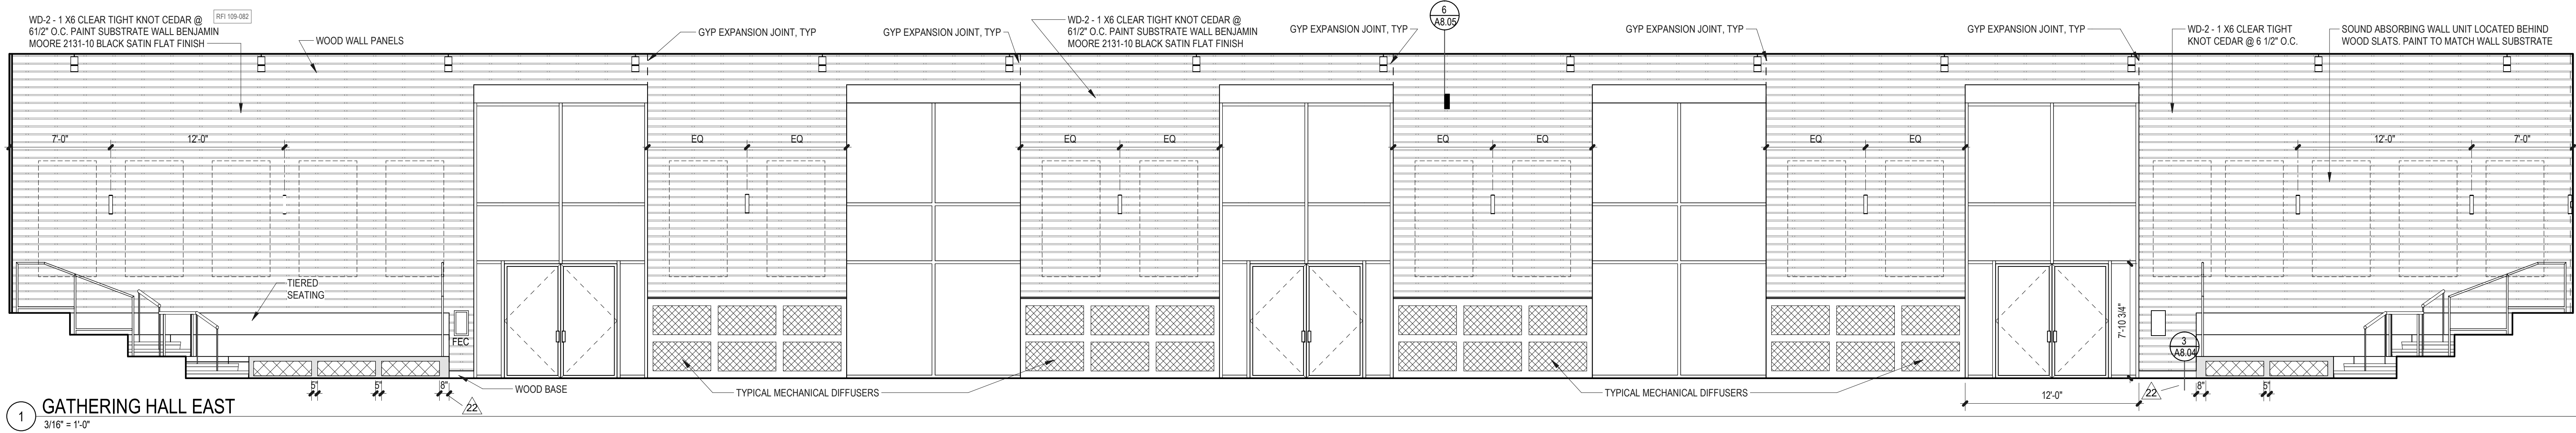

7512 TOTEM BEACH RD
TULALIP, WA 98271






**ENLARGED PLANS
AND INTERIOR
ELEVATIONS -
CORRIDORS AND
BUFFET**

[illegible]

PROJECT INFORMATION	
PROJECT NUMBER:	17031
PROJECT LEAD:	DC
DRAWN BY:	JLO

SHEET NO

A7.04

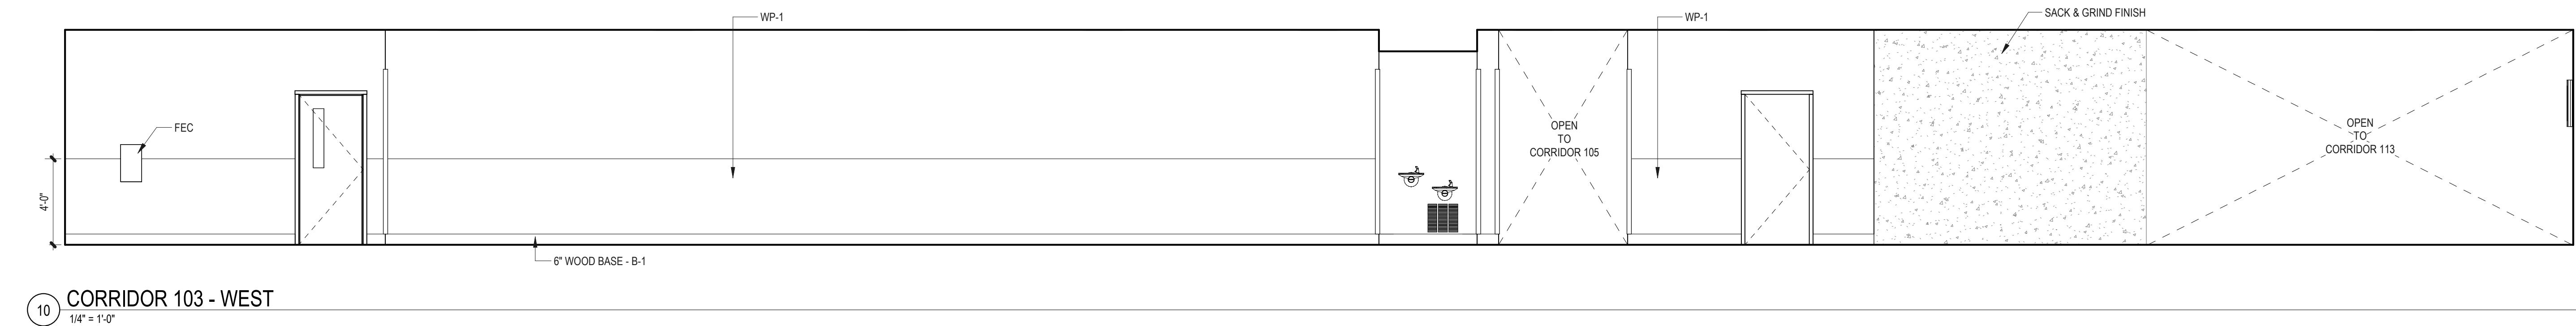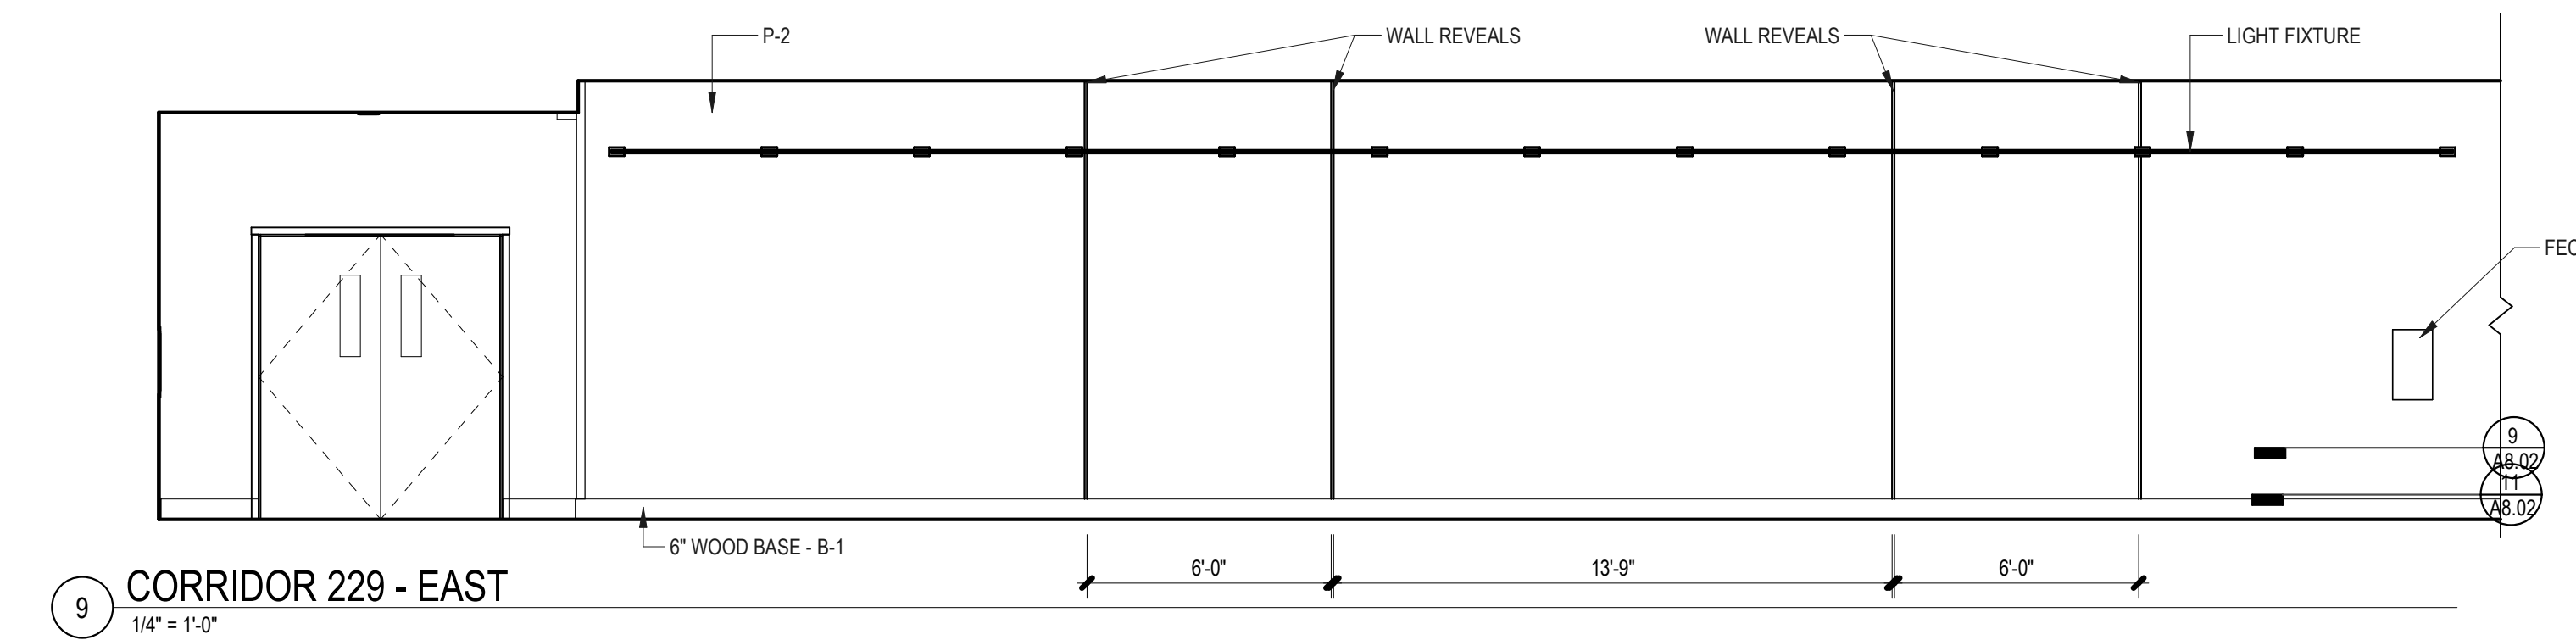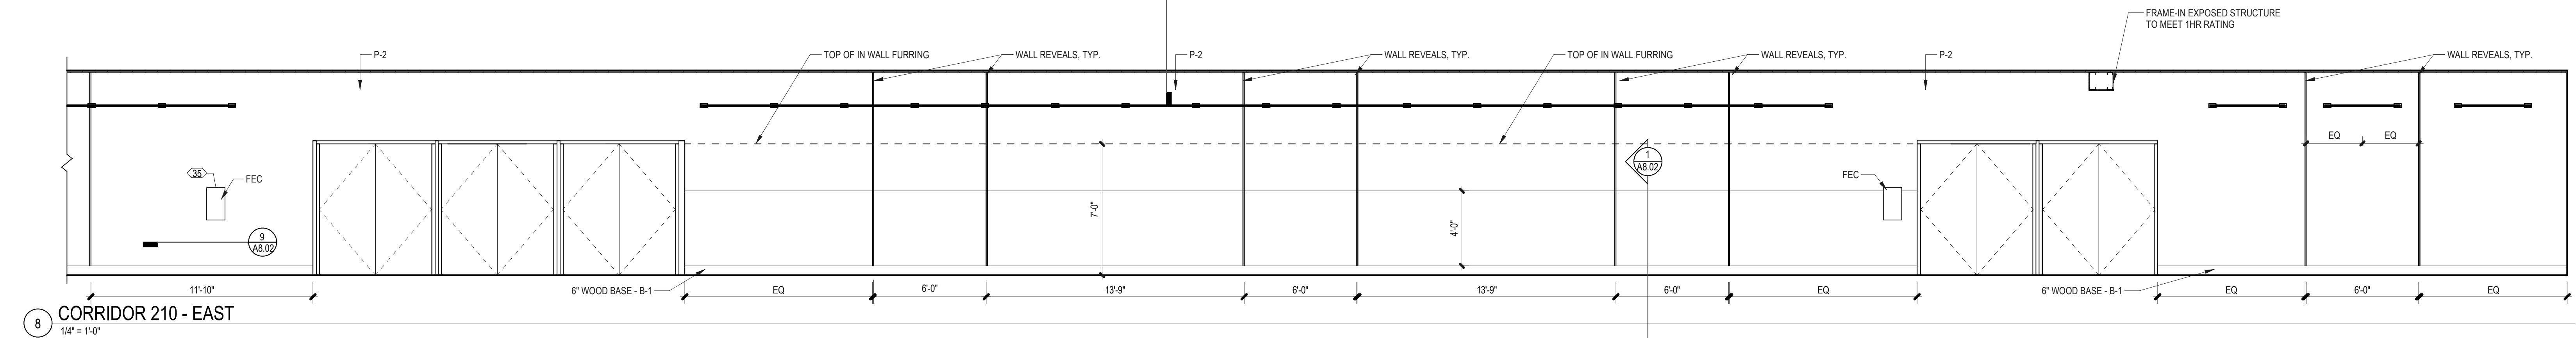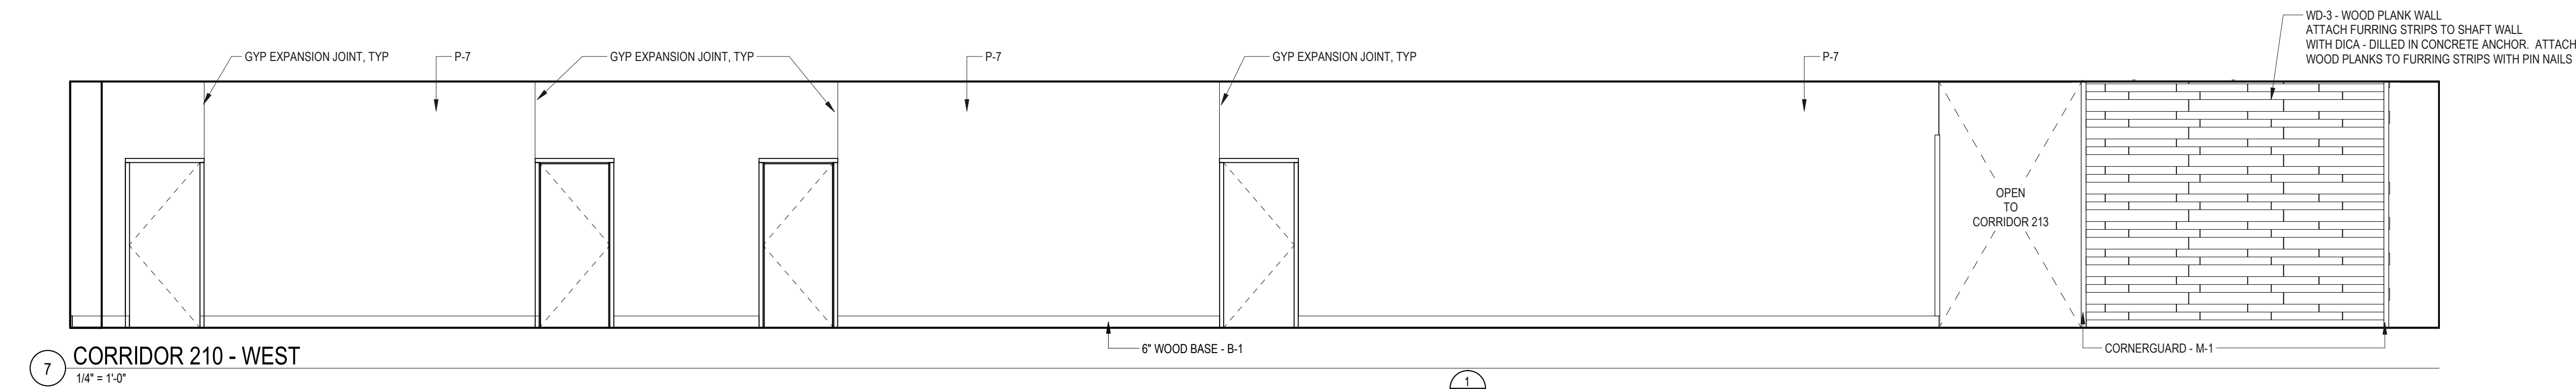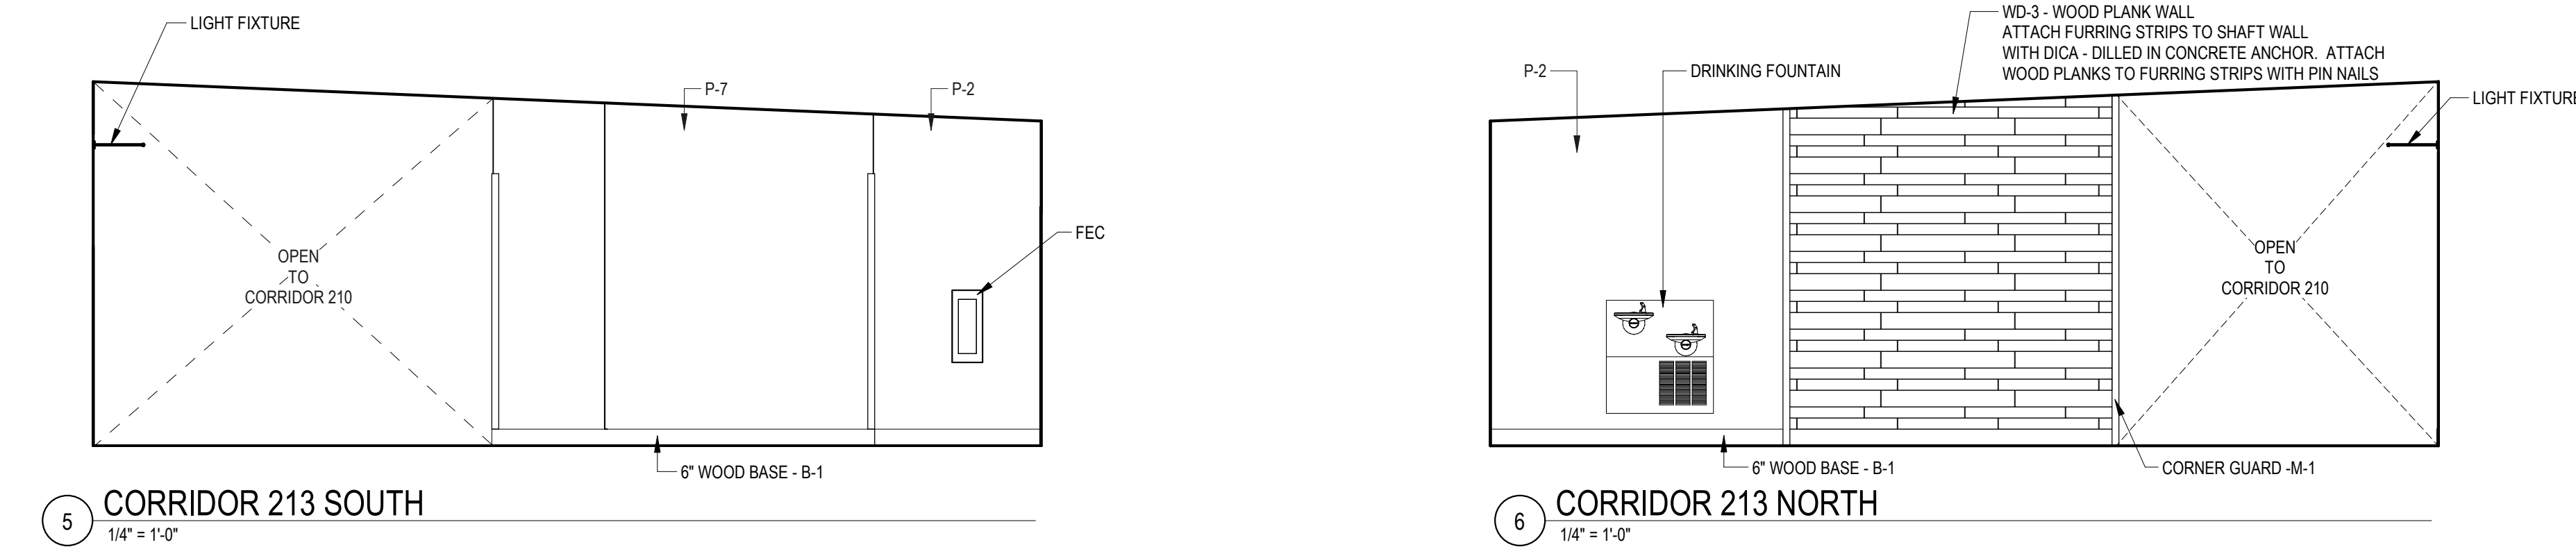



7512 TOTEM BEACH RD
TULALIP, WA 98271

ENLARGED PLANS AND INTERIOR ELEVATIONS - LOBBY

[illegible]

PROJECT INFORMATION	
PROJECT NUMBER:	17031
PROJECT LEAD:	DC
DRAWN BY:	JLO

SHEET NO

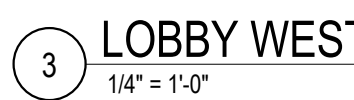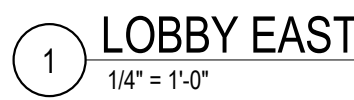

TULALIP TRIBES GATHERING HALL

7512 TOTEM BEACH RD
TULALIP, WA 98271

PHASE 2 - BUILDING AND LANDSCAPING


ENLARGED PLANS AND INTERIOR ELEVATIONS

[illegible]


PROJECT INFORMATION	
PROJECT NUMBER:	17031
PROJECT LEAD:	JLO
DRAWN BY:	JLO

SHEET NO


A7.06

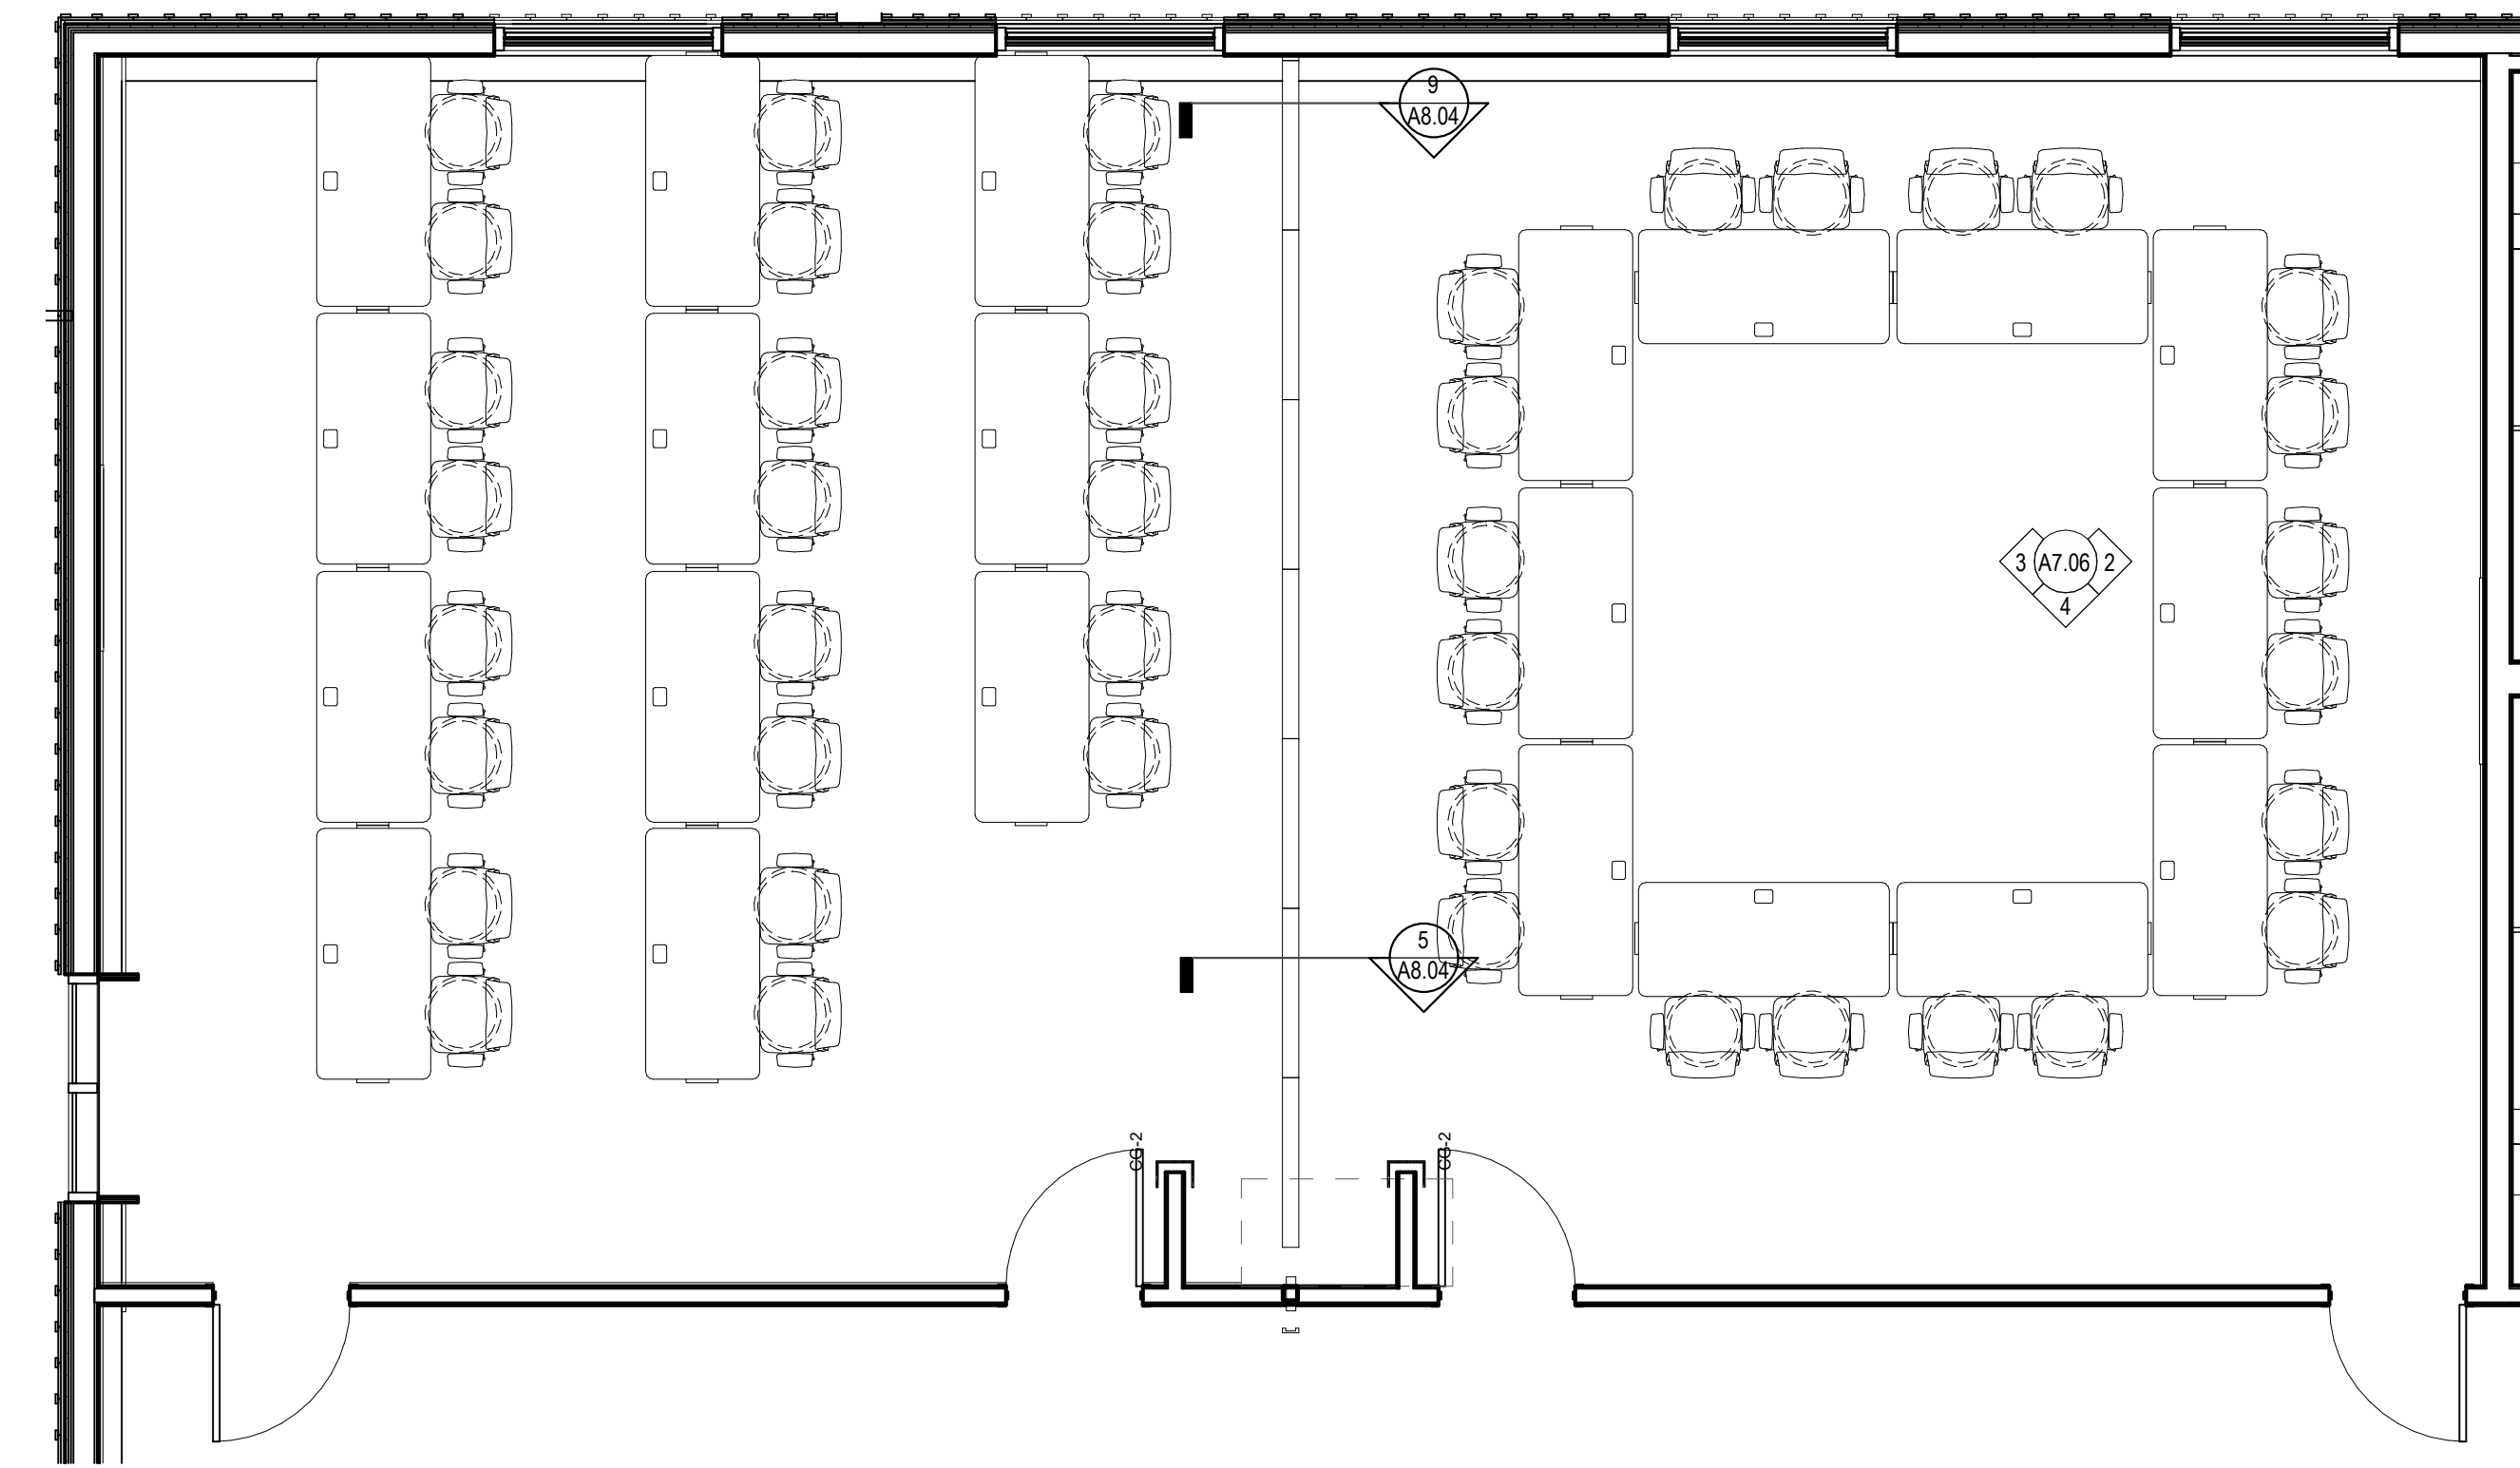


1 ENLARGED FLOOR PLAN - CONFERENCE ROOMS
1/4" = 1'-0"

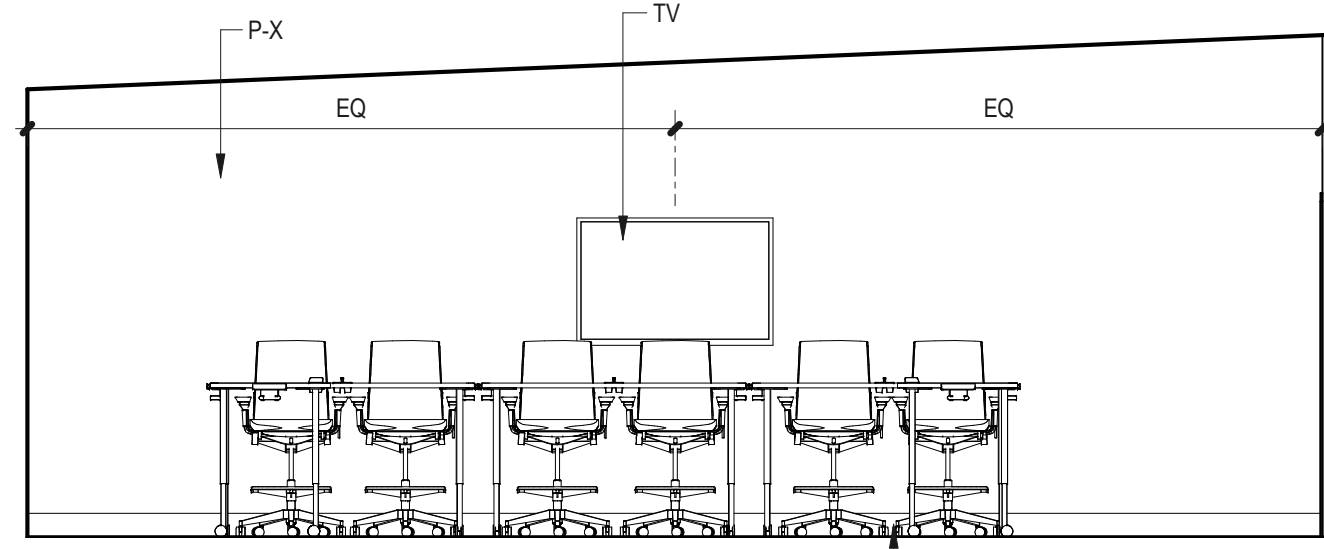


2 CONFERENCE ROOM 'A' - NORTH ELEV.
1/4" = 1'-0"

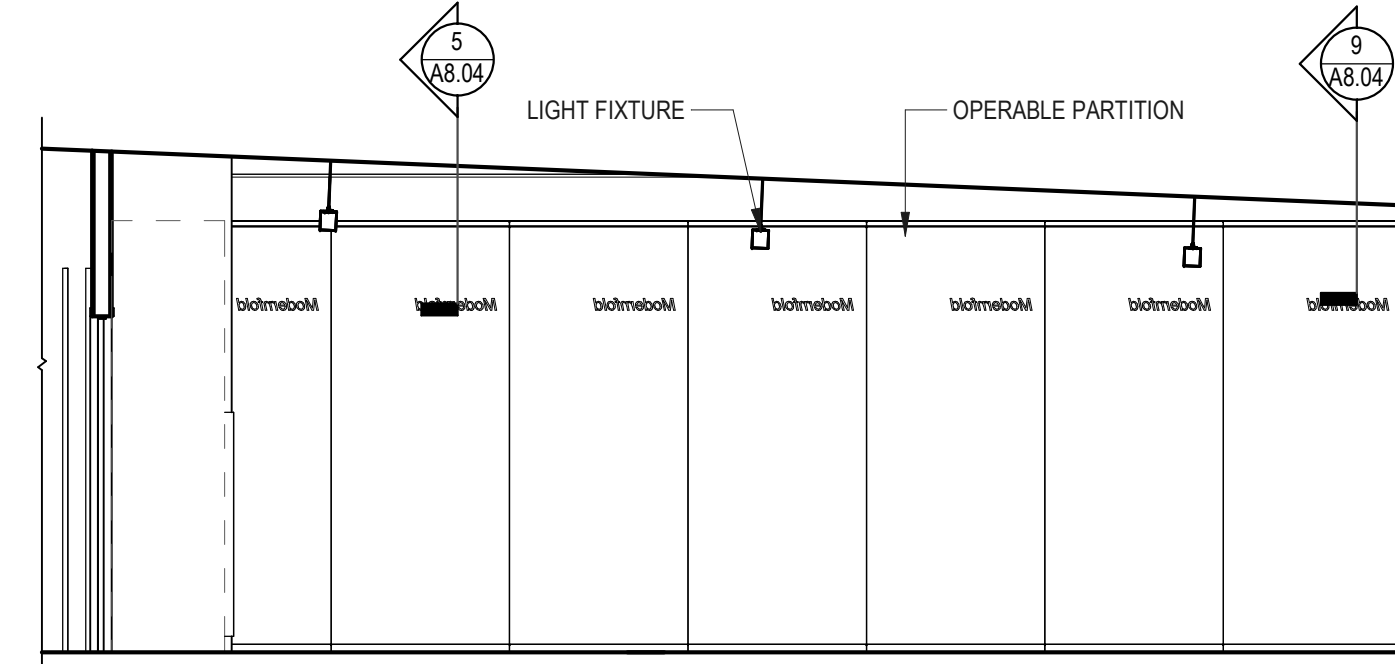


3 CONFERENCE ROOMS SOUTH ELEVATION
1/4" = 1'-0"

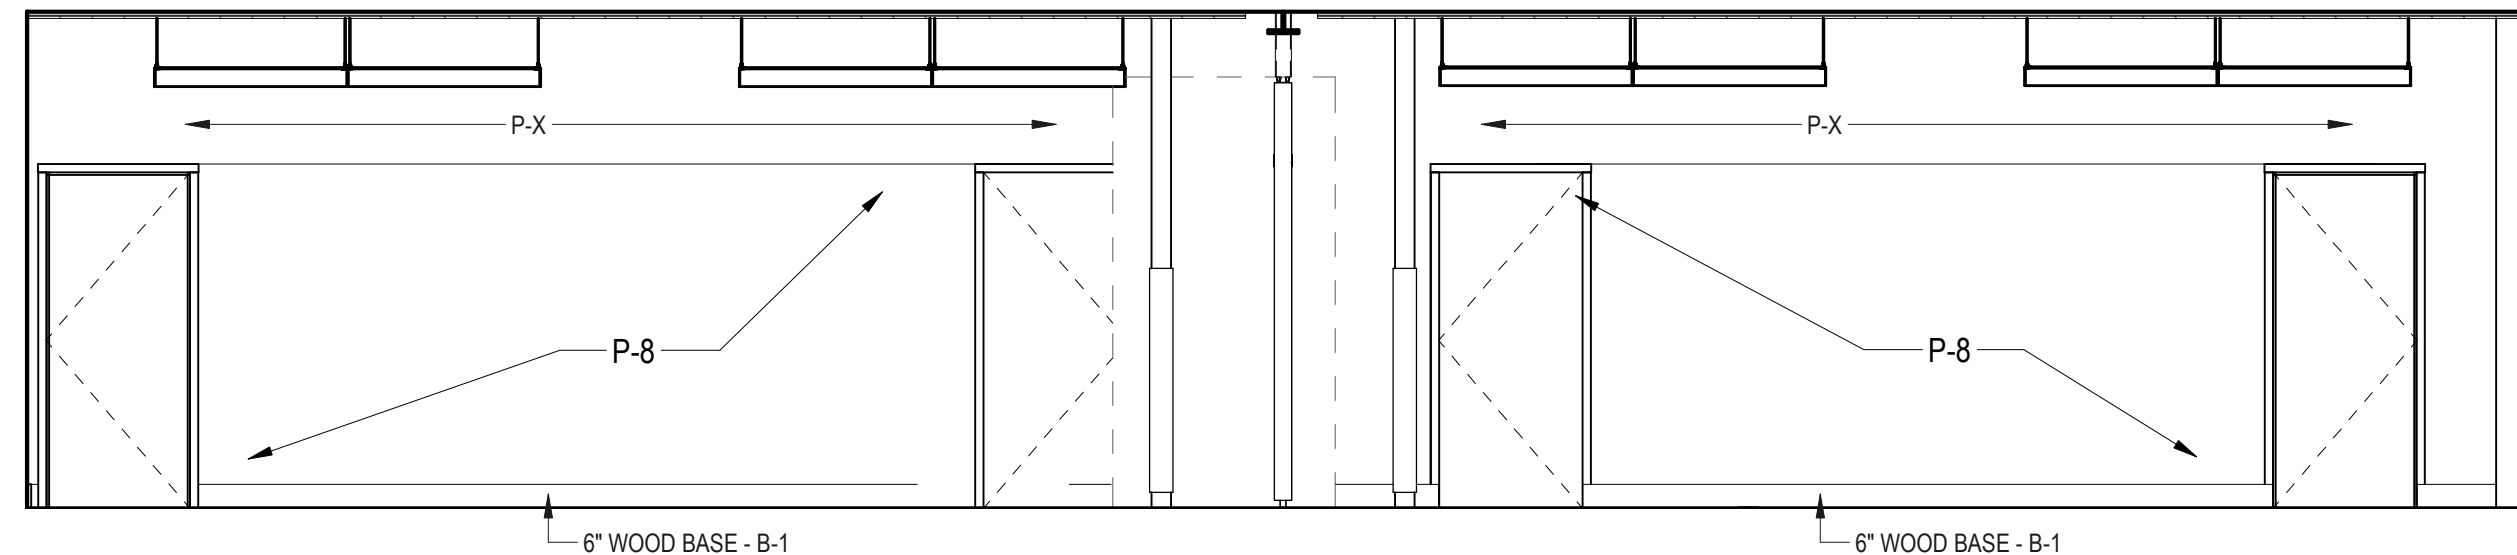


4 CONFERENCE ROOMS 'A' - EAST ELEV.
1/4" = 1'-0"

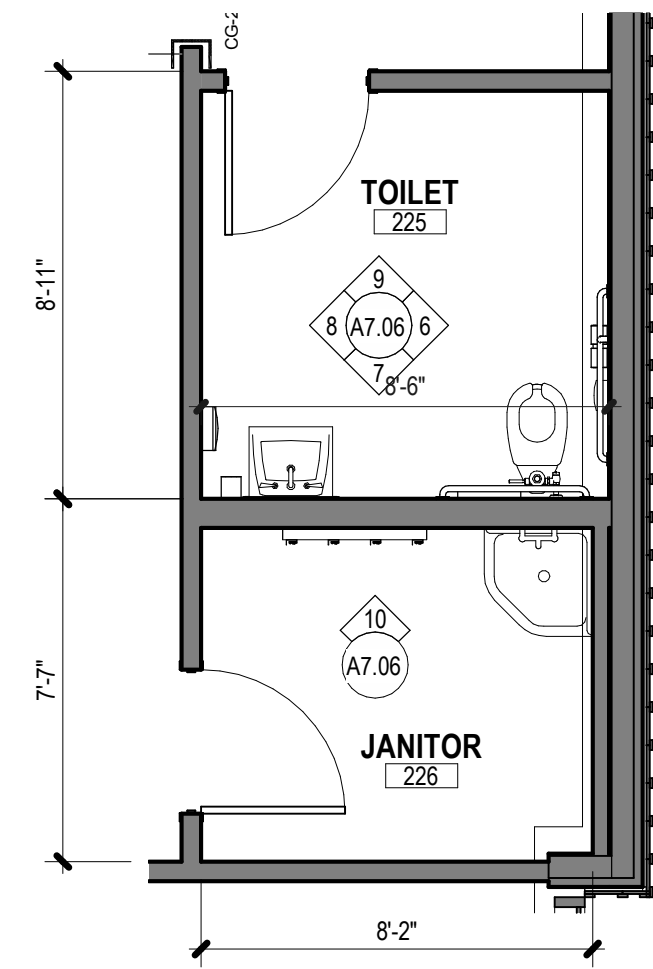


5 ENLARGED FLOOR PLAN - KIT TLT & JAN
1/4" = 1'-0"

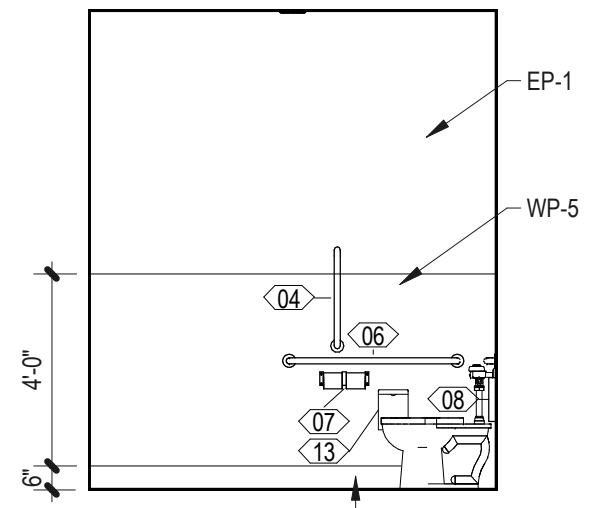


6 TOILET 225 - NORTH
1/4" = 1'-0"

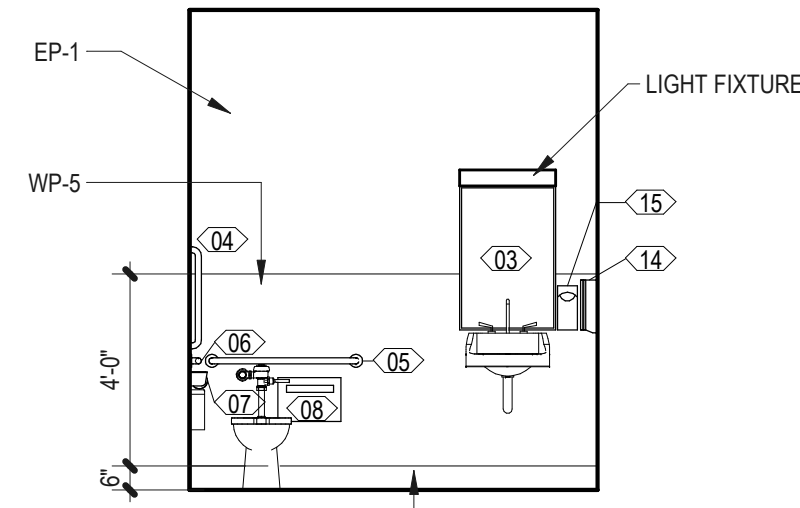


7 TOILET 225 - EAST
1/4" = 1'-0"

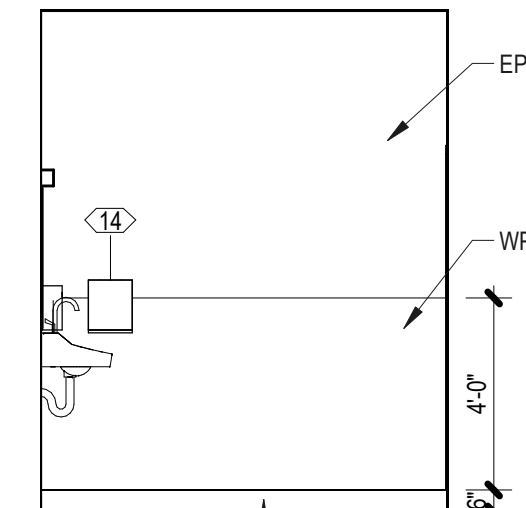


8 TOILET 225 - SOUTH
1/4" = 1'-0"

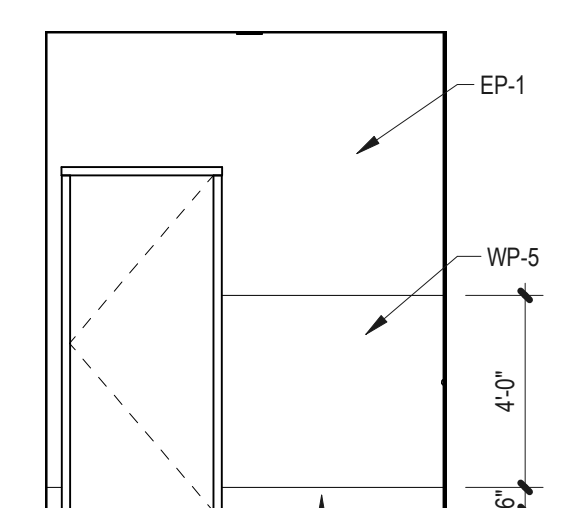


9 TOILET 225 - WEST
1/4" = 1'-0"

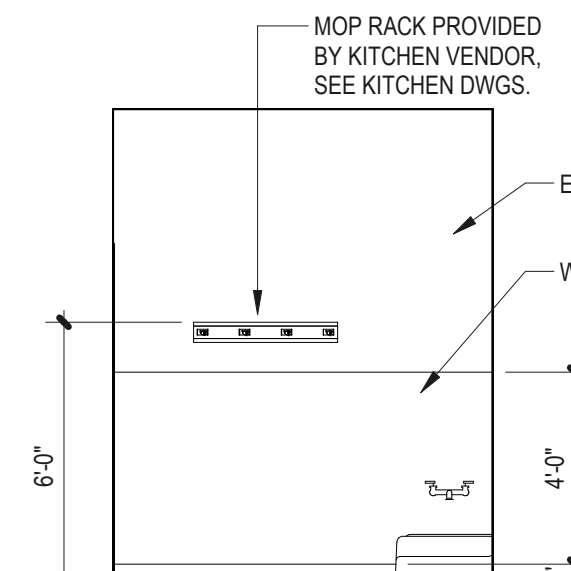


10 JANITOR 226 - WEST
1/4" = 1'-0"

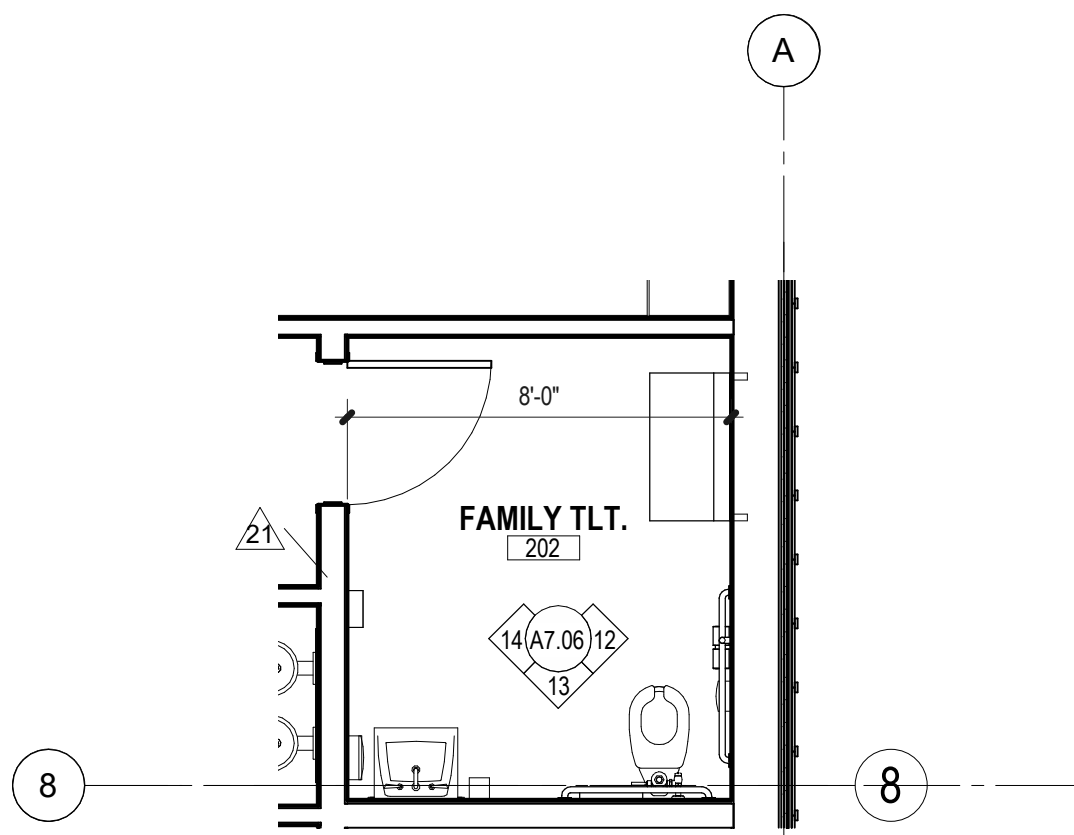


11 ENLARGED PLAN - FAMILY TOILET
1/4" = 1'-0"

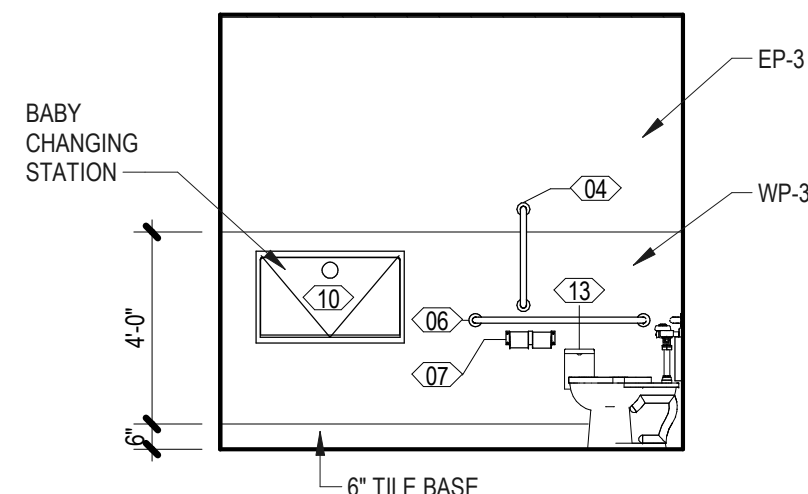


12 FAMILY TLT 202 - NORTH
1/4" = 1'-0"

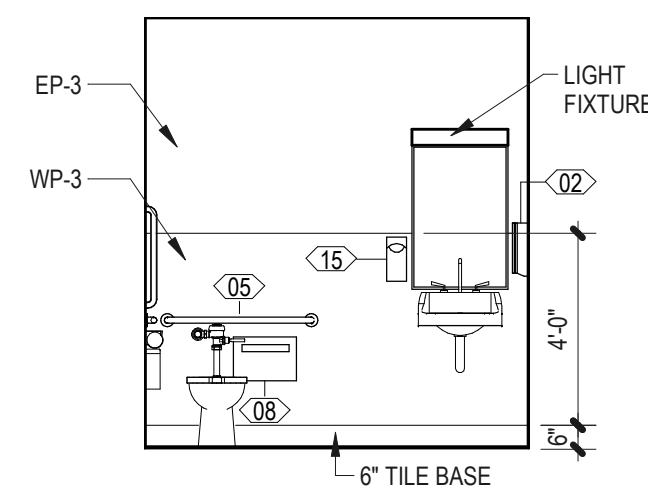

13 FAMILT TLT 202 - EAST
1/4" = 1'-0"

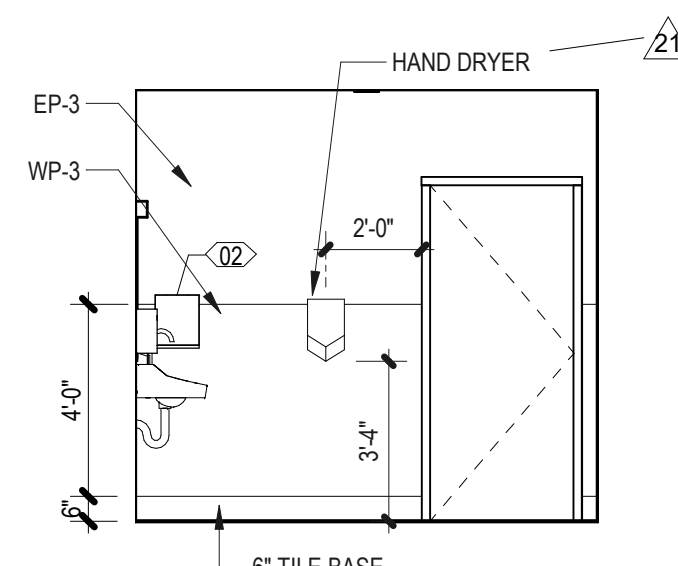

14 FAMILY TLT 202 - SOUTH
1/4" = 1'-0"

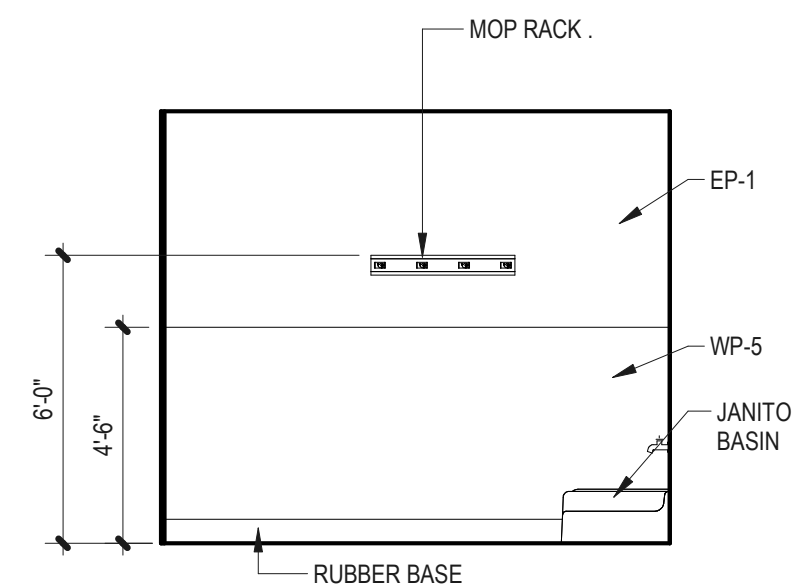

15 JANITOR 216 - NORTH
1/4" = 1'-0"

A8.01

7512 TOTEM BEACH RD
TULALIP, WA 98271

DETAILS

PROJECT INFORMATION	
PROJECT NUMBER:	17031
PROJECT LEAD:	DC
DRAWN BY:	MZ



PROJECT INFORMATION	
PROJECT NUMBER:	17031
PROJECT LEAD:	DC
DRAWN BY:	MZ




Exhibit J.2.4. Existing Solar Details



Existing Solar PV breaker. Located on the MDP.
 Breaker: 30A - 480V

Array installed just after building construction in 2021
 and integrated into the awning on the Southwest side.

Size approximately 22kW-DC

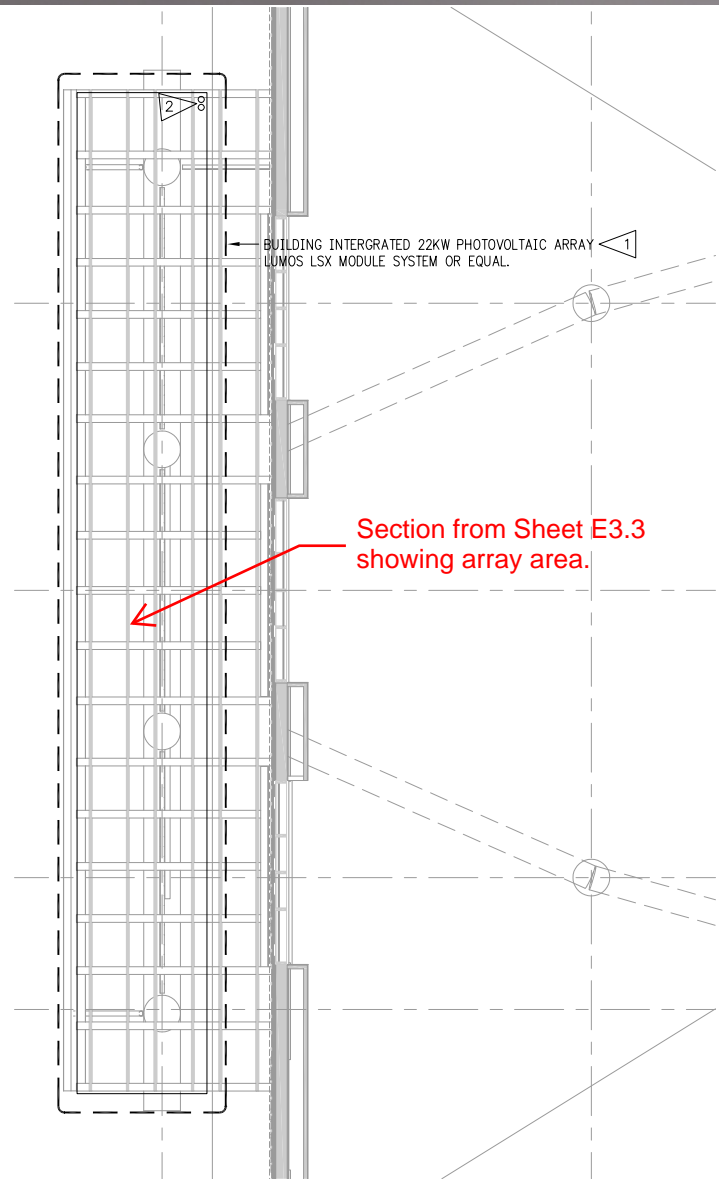



Existing Inverter: SolarEdge 20kW
24A - 480V

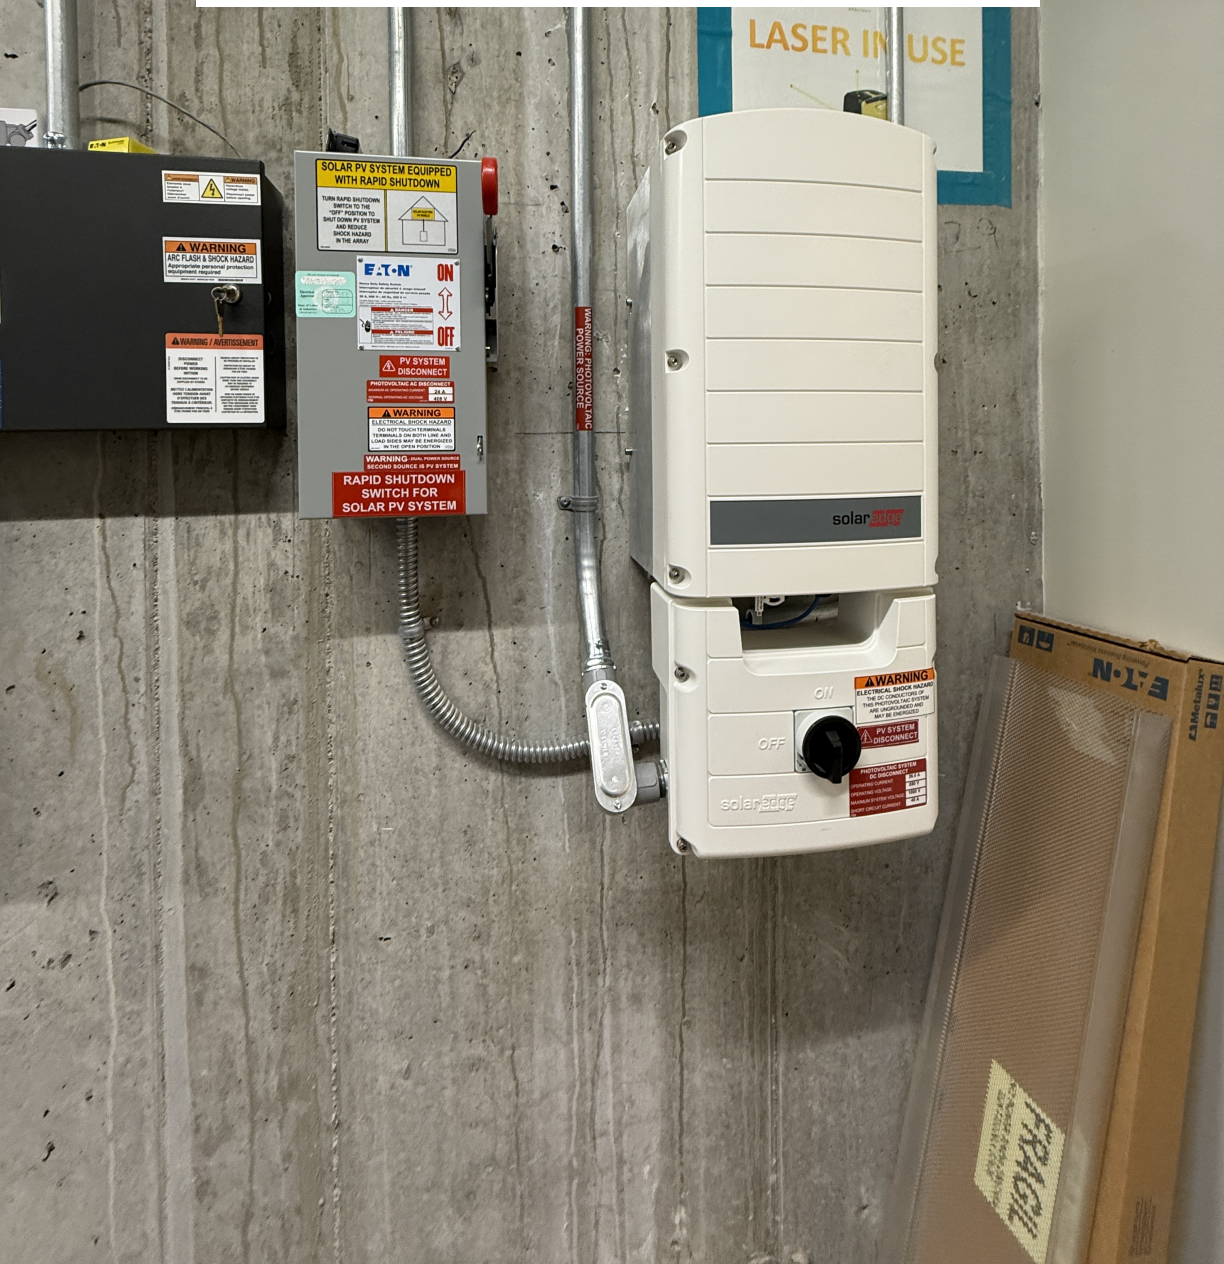


Exhibit J.2.5. Roof Profile

